
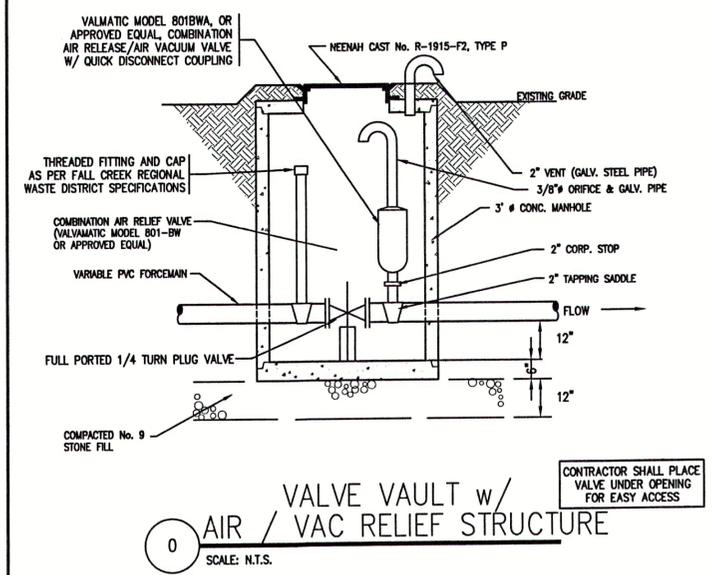


12
8-30

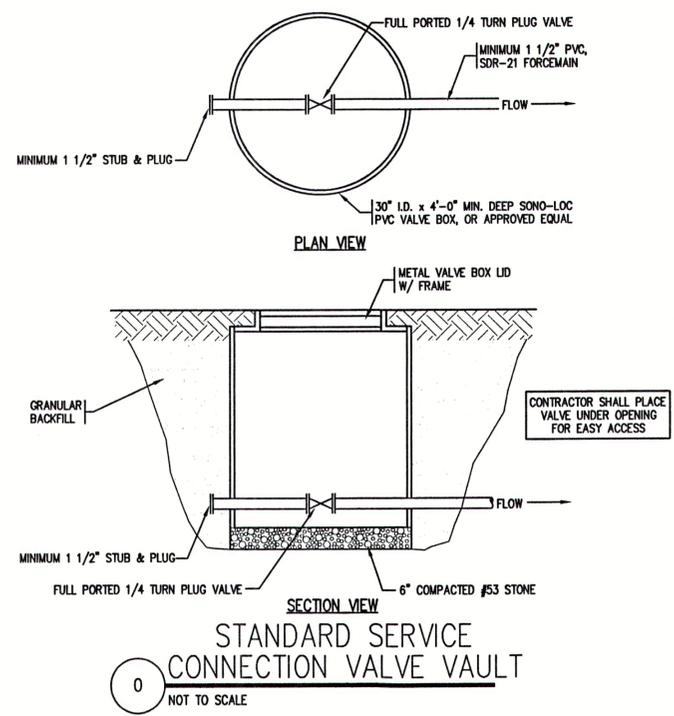

FILE NAME:	JP_D2-REC	PLOT SCALE:	1=1	PLOT DATE:	04/05
NO.	DATE	DESCRIPTION	BY		

TRIAD ASSOCIATES INC.
INDIANAPOLIS, INDIANA

APPROVED BY:
THOMAS M. SCHUBERT
REGISTERED PROFESSIONAL ENGINEER
No. 15614
STATE OF INDIANA
Thomas M. Schubert, P.E.

**RECORD DRAWING
APRIL 2001**

JEFFERSON PL., CO. RD. 600W & CO. RD. 675W FALL CREEK REGIONAL WASTE DISTRICT			
LIFT STATION AND FORCEMAIN DETAILS			
DRAWN BY:	DATE	PROJECT No.	SHEET No.
DAP	04/12/98	98008A	20
DESIGNED BY:	D.A. Pauling		20
CHECKED BY:	James W. Frazell, P.E.		OF