

FALL CREEK REGIONAL WASTE DISTRICT

DIVISION 'C'

SHEET No. 50a

INDEX MA-4

106+00

107+00


108+00

109+00

110+00

111+00

112+00

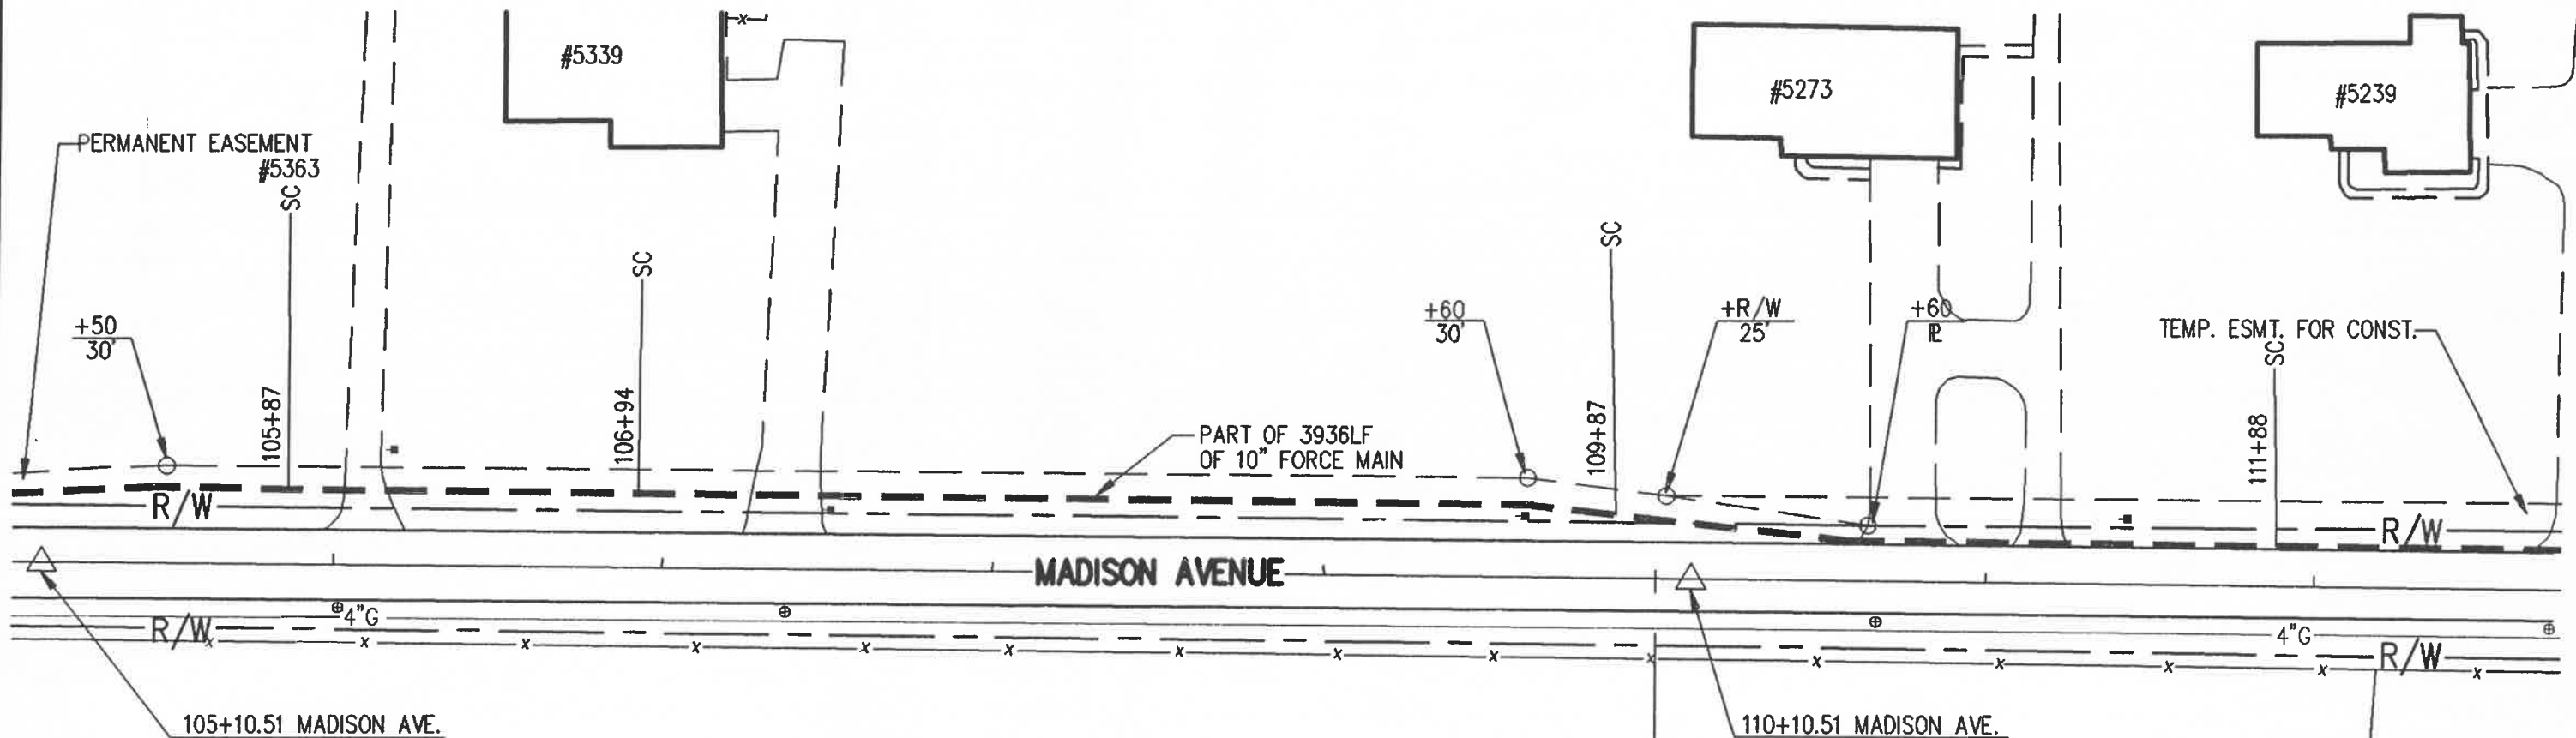

LEGEND

---	EASEMENT LIMITS	W	WATERLINE LOCATION
- - -	RIGHT-OF-WAY LIMITS	G	GAS LINE LOCATION
- - - - -	FORCE MAIN LOCATION	T	UNDERGROUND TELEPHONE
=====	SANITARY SEWER LOCATION	x x x	FENCE LINE
=====	STORM SEWER LOCATION	x	LIGHT POLE
—SC	SANITARY SERVICE CONNECTION	▪	POWER POLE

AS-BUILT INFORMATION

SCALE: 1" = 50'





TRIAD
ASSOCIATES
INC.
INDIANAPOLIS, INDIANA

FALL CREEK REGIONAL WASTE DISTRICT

DIVISION 'C'

SHEET No. 50b

INDEX MA-4

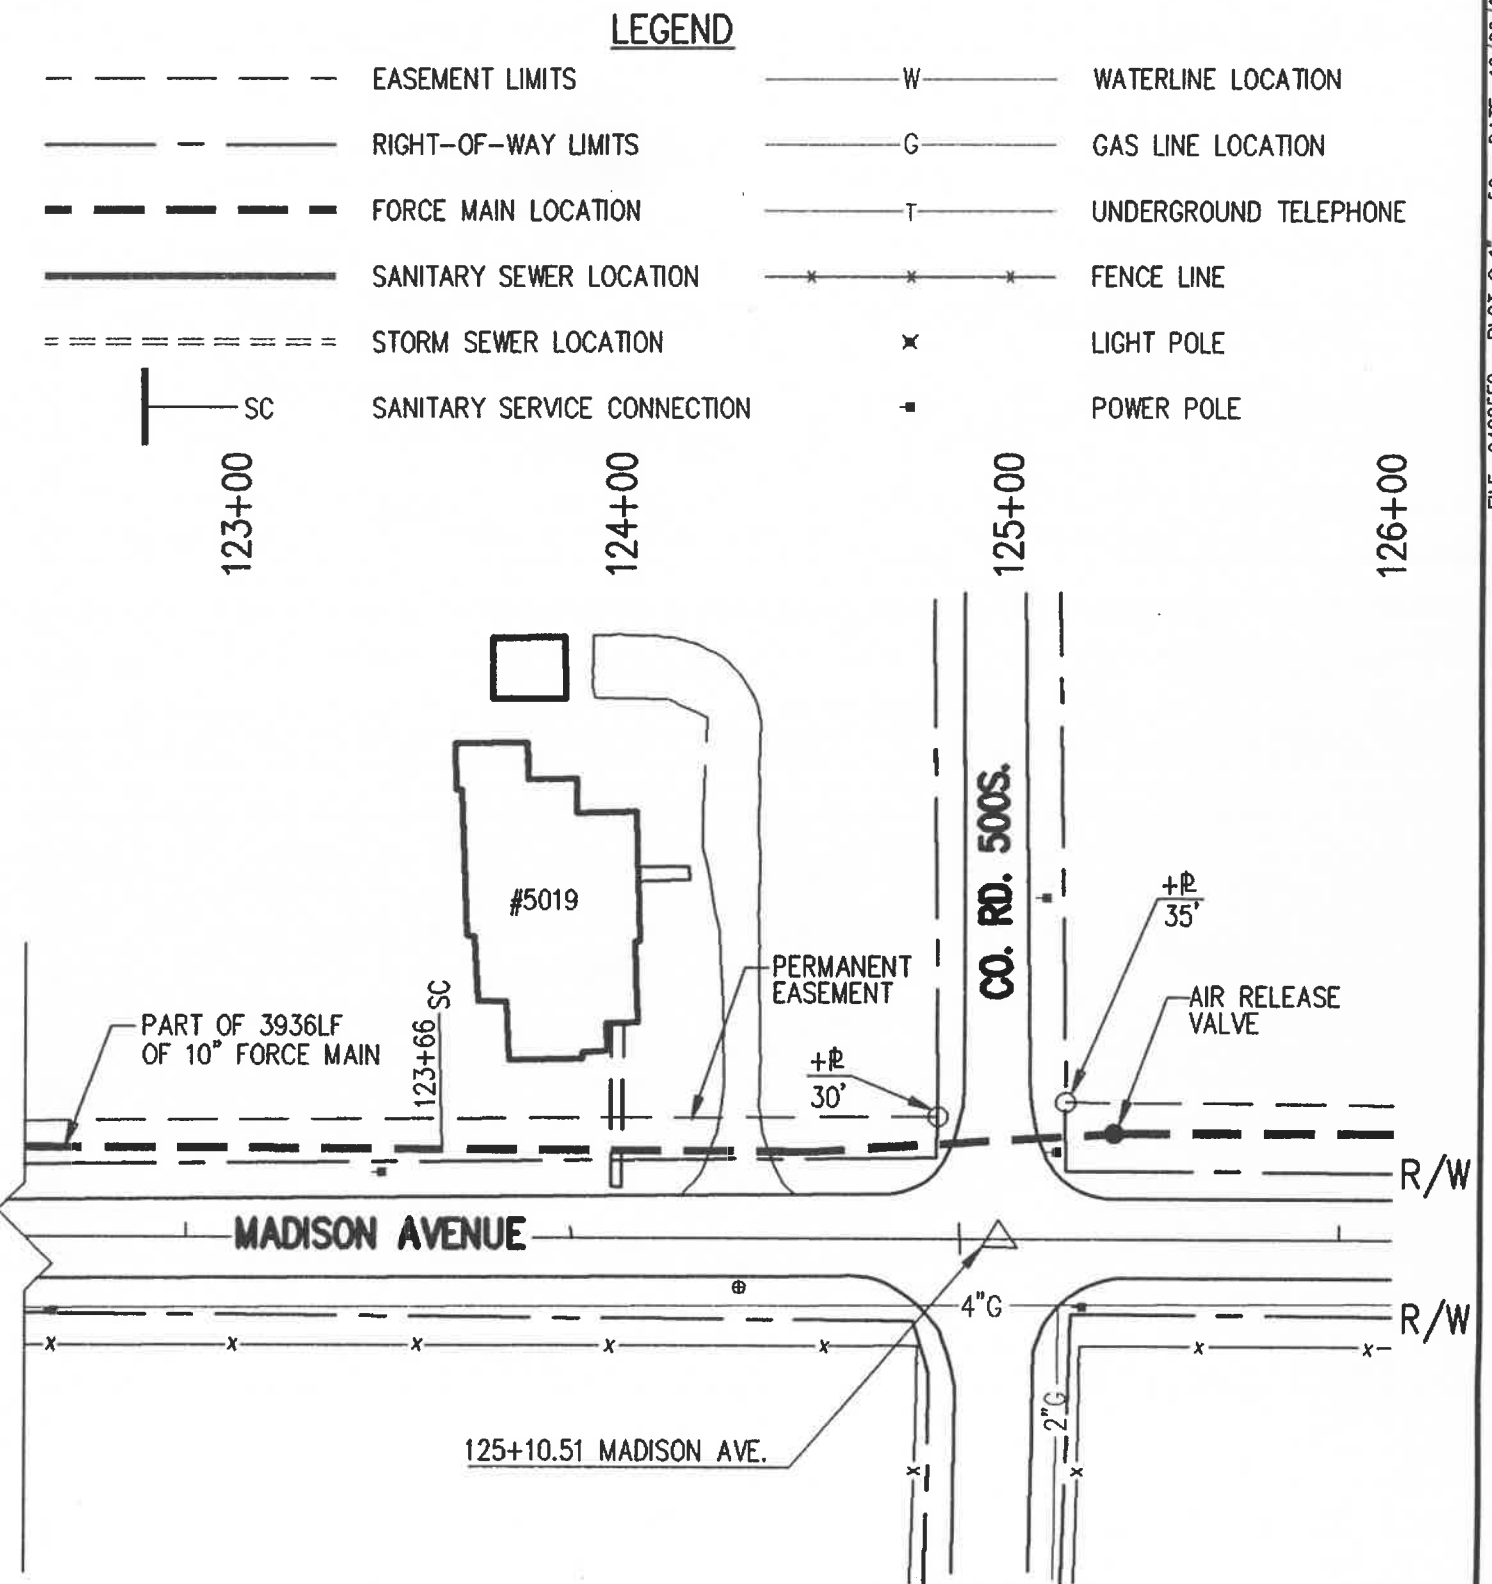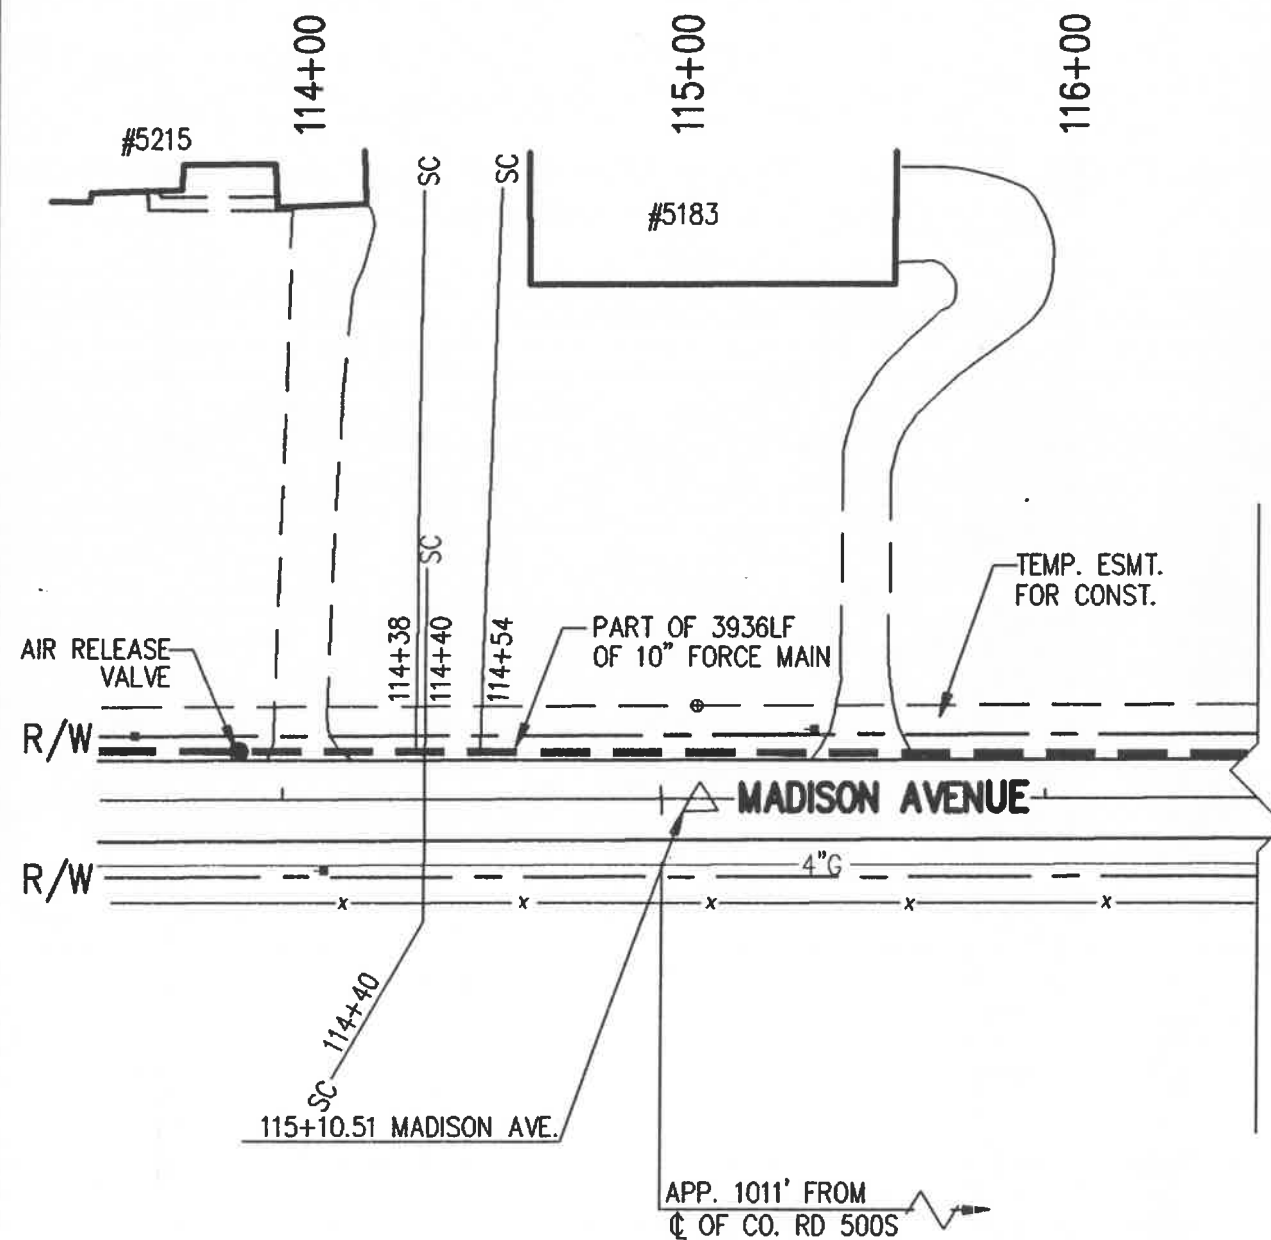

LEGEND

---	EASEMENT LIMITS	W	WATERLINE LOCATION
- - -	RIGHT-OF-WAY LIMITS	G	GAS LINE LOCATION
---	FORCE MAIN LOCATION	T	UNDERGROUND TELEPHONE
---	SANITARY SEWER LOCATION	x x x	FENCE LINE
==	STORM SEWER LOCATION	x	LIGHT POLE
SC	SANITARY SERVICE CONNECTION	■	POWER POLE

AS-BUILT INFORMATION

SCALE: 1" = 50'



TRIAD
ASSOCIATES
INC.
INDIANAPOLIS, INDIANA

FALL CREEK REGIONAL
WASTE DISTRICT


DIVISION 'C'

SHEET No. 51

INDEX MA-4

LEGEND

---	EASEMENT LIMITS	W	WATERLINE LOCATION
- - -	RIGHT-OF-WAY LIMITS	G	GAS LINE LOCATION
---	FORCE MAIN LOCATION	T	UNDERGROUND TELEPHONE
---	SANITARY SEWER LOCATION	* * *	FENCE LINE
==	STORM SEWER LOCATION	x	LIGHT POLE
SC	SANITARY SERVICE CONNECTION	+	POWER POLE

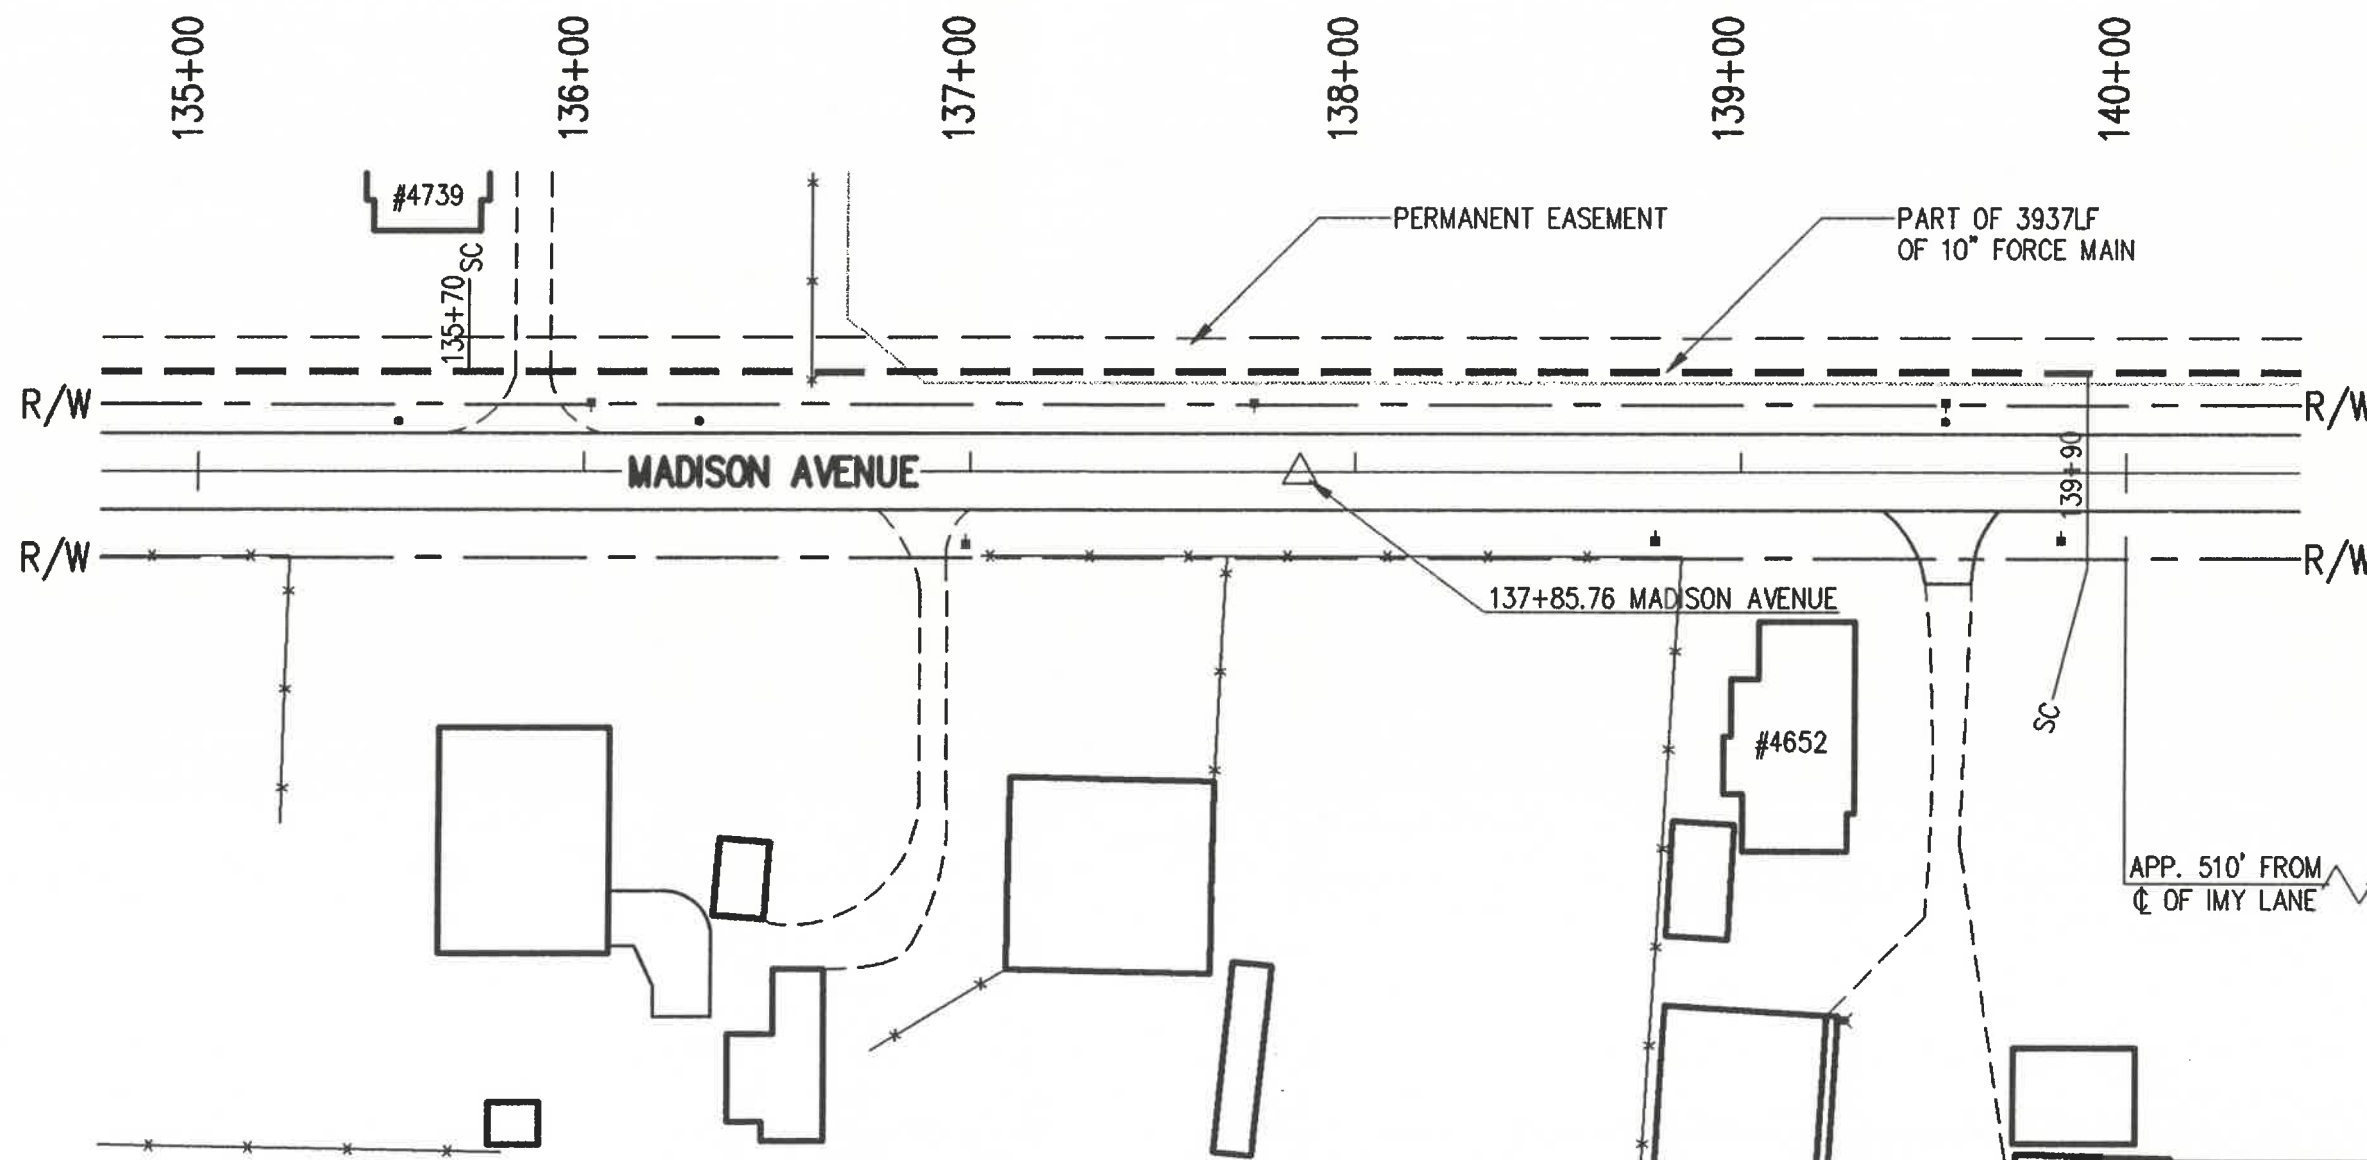

AS-BUILT INFORMATION

SCALE: 1" = 50'



TRIAD
ASSOCIATES
INC.
INDIANAPOLIS, INDIANA