

FALL CREEK REGIONAL
WASTE DISTRICT
DIVISION 'C'
SHEET No. 50a

INDEX MA-4

106+00

107+00


108+00

109+00

110+00

111+00

112+00

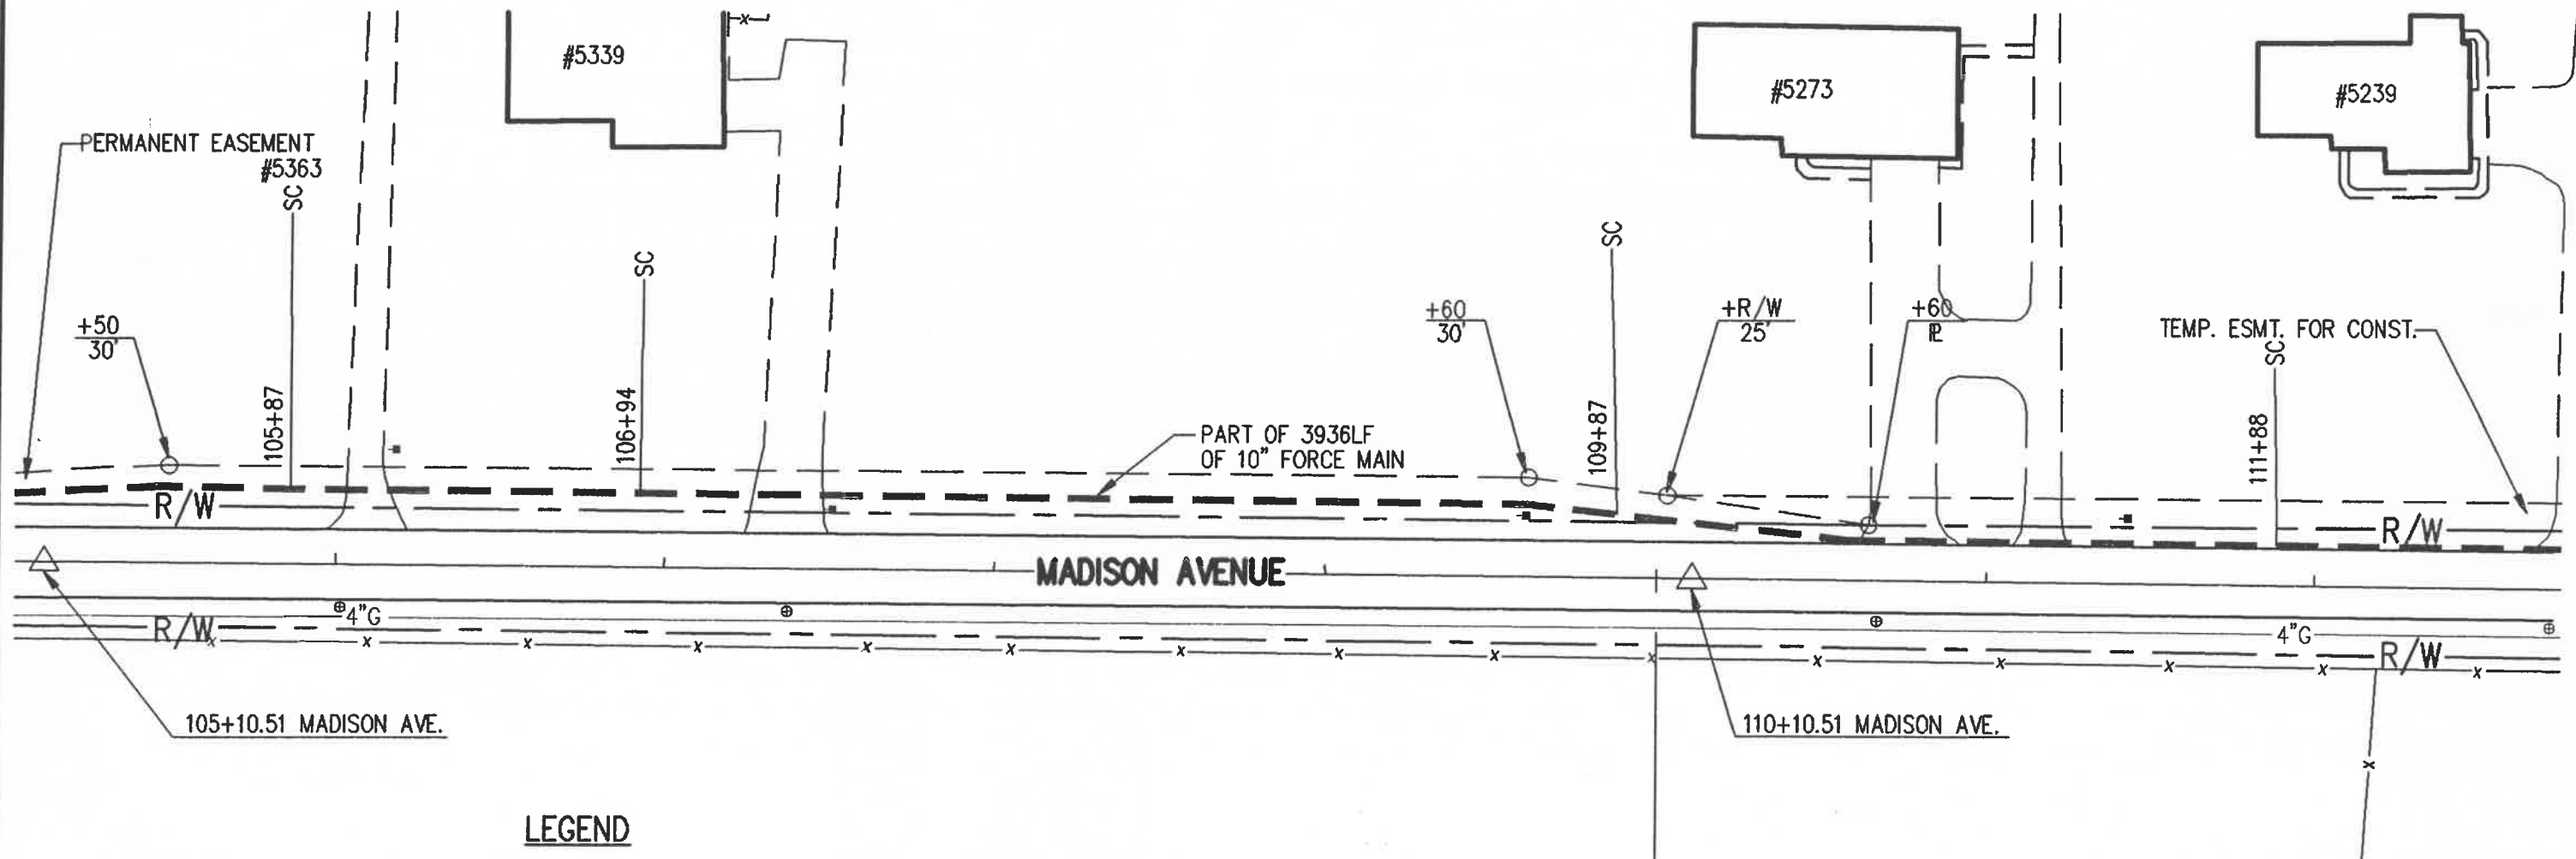

LEGEND

---	EASEMENT LIMITS	W	WATERLINE LOCATION
- - -	RIGHT-OF-WAY LIMITS	G	GAS LINE LOCATION
- - - - -	FORCE MAIN LOCATION	T	UNDERGROUND TELEPHONE
---	SANITARY SEWER LOCATION	x x x	FENCE LINE
= = = = =	STORM SEWER LOCATION	x	LIGHT POLE
—SC	SANITARY SERVICE CONNECTION	■	POWER POLE

AS-BUILT INFORMATION

SCALE: 1" = 50'



TRIAD
ASSOCIATES
INC.
INDIANAPOLIS, INDIANA