

**FALL CREEK REGIONAL  
WASTE DISTRICT**


**DIVISION 'C'**

SHEET No. 51

INDEX MA-4

**LEGEND**

|       |                             |       |                       |
|-------|-----------------------------|-------|-----------------------|
| ---   | EASEMENT LIMITS             | W     | WATERLINE LOCATION    |
| - - - | RIGHT-OF-WAY LIMITS         | G     | GAS LINE LOCATION     |
| ---   | FORCE MAIN LOCATION         | T     | UNDERGROUND TELEPHONE |
| ---   | SANITARY SEWER LOCATION     | * * * | FENCE LINE            |
| ==    | STORM SEWER LOCATION        | x     | LIGHT POLE            |
| —SC   | SANITARY SERVICE CONNECTION | +     | POWER POLE            |

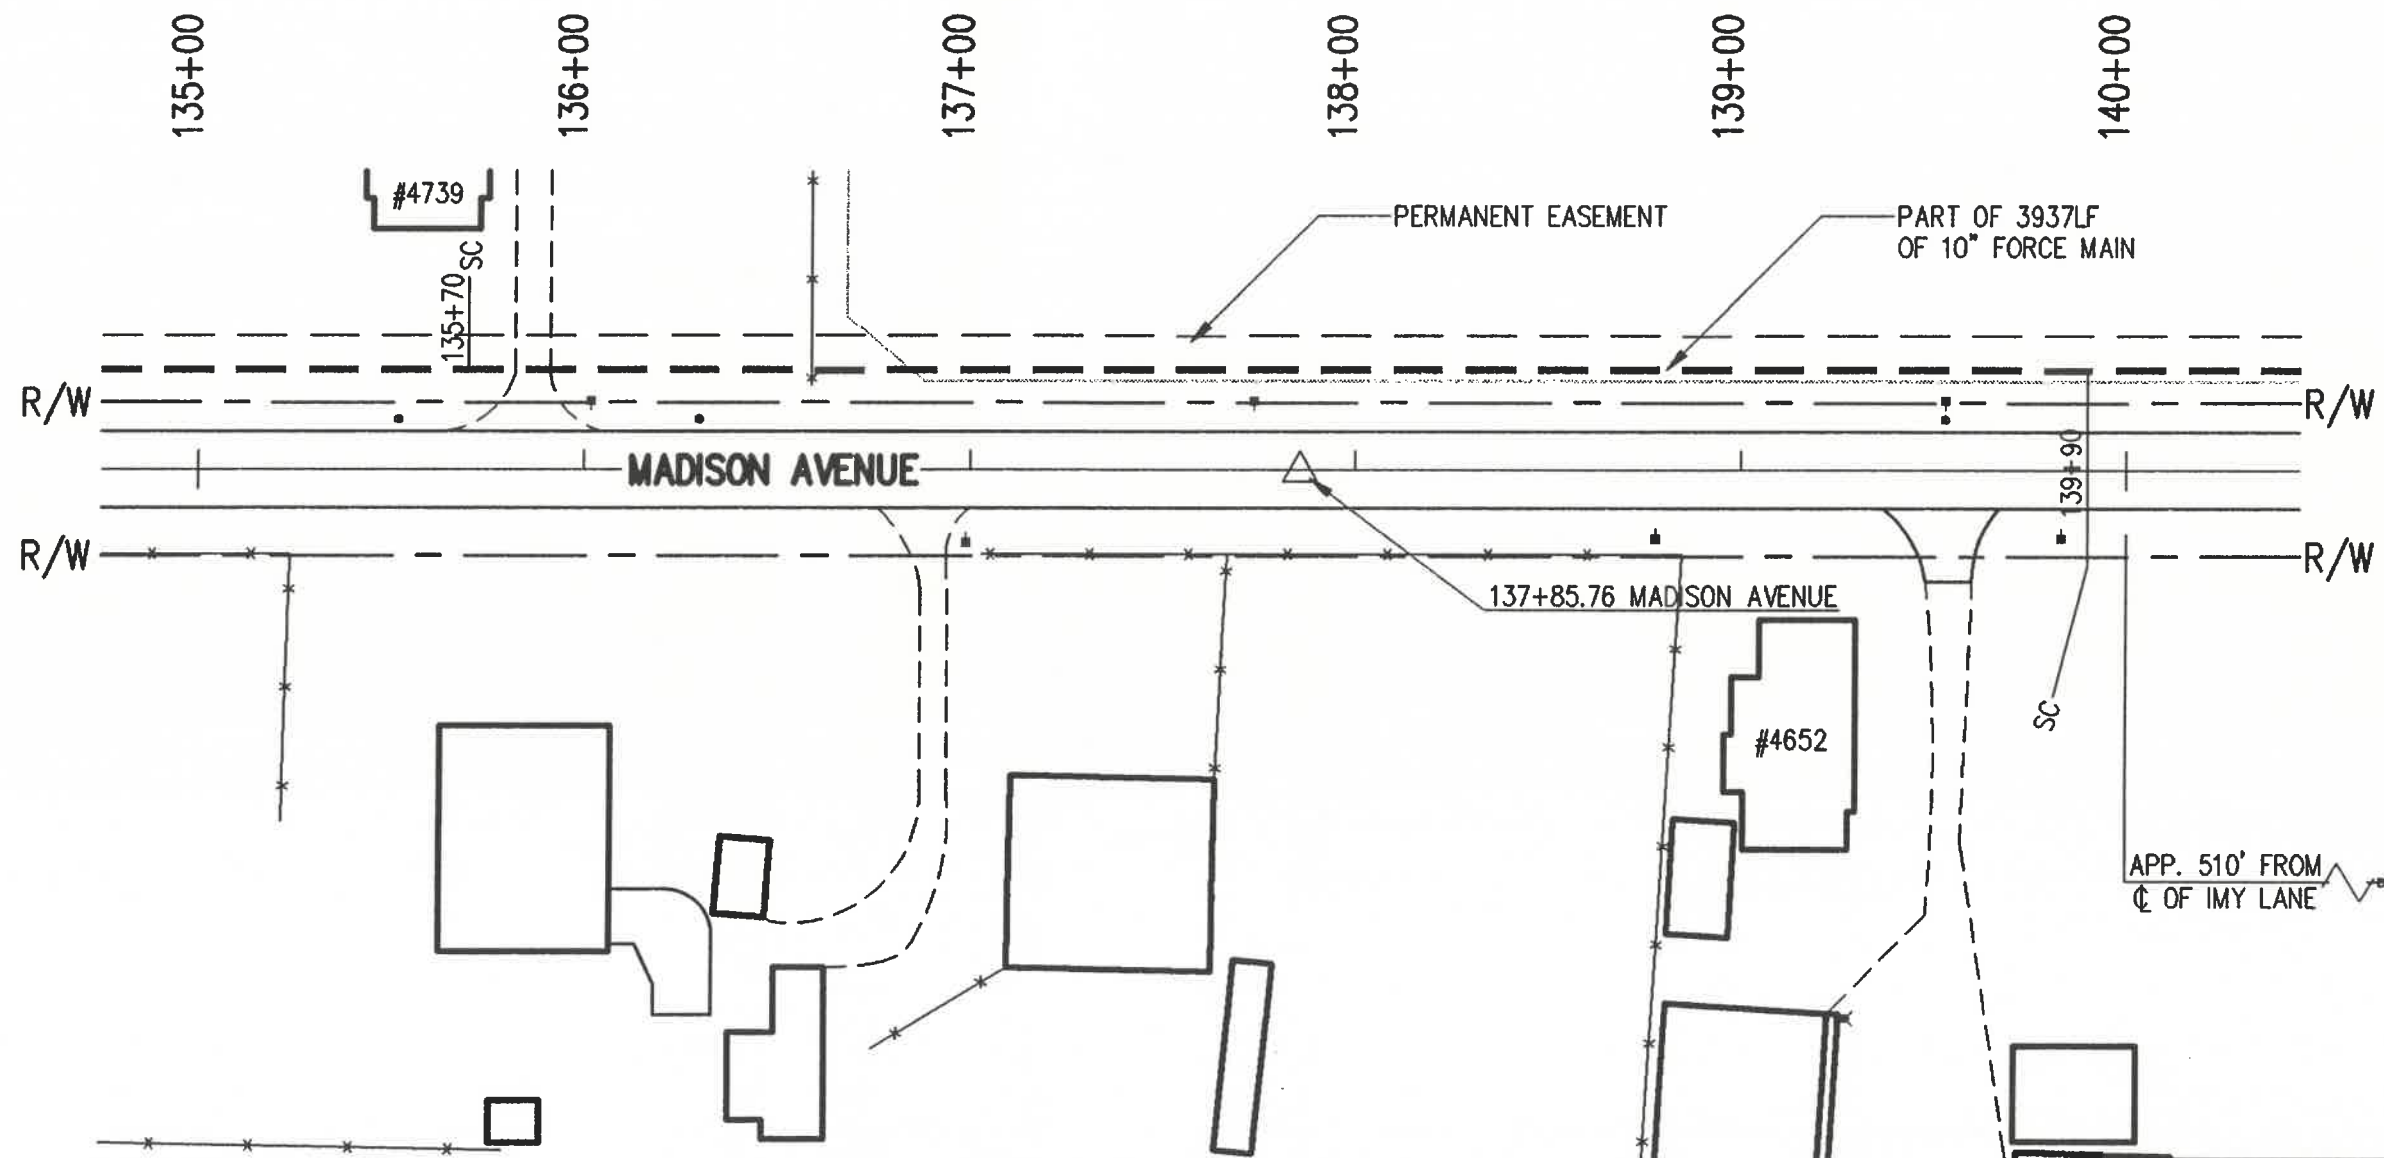

**AS-BUILT INFORMATION**

SCALE: 1" = 50'



**TRIAD  
ASSOCIATES  
INC.**

INDIANAPOLIS, INDIANA