


EXISTING		PROPOSED	
	EASEMENT LINE		
	SETBACK LINE		
	CENTERLINE		
	SWALE / FLOWLINE		
	CURB UNDERDRAIN		
	SANITARY SEWER		
	STORM SEWER		
	STORM CULVERT		
	WATER MAIN		
	SANITARY MANHOLE		
	STORM MANHOLE		
	STORM INLET		
	STORM END SECTION		
	FIRE HYDRANT		
	PROFILED PIPELINE		
EX	- EXISTING		
INV	- INVERT ELEVATION		
MH	- MANHOLE		
PVC	- POLYVINYL CHLORIDE PIPE		
TC	- TOP OF CASTING GRADE		
	- PERMANENT SEEDING / SODDING		
	- TEMPORARY "DROP INLET PROTECTION BASKET"		
	- SILT FENCE		
	- CONSTRUCTION LIMITS		

THE DESIGN AND CONSTRUCTION SHALL COMPLY WITH ALL ADA REQUIREMENTS.

NOTES:

1. ADDITIONAL EROSION CONTROL MEASURES MAY BE REQUIRED.
2. THERE SHALL BE NO DIRT, DEBRIS OR STORAGE OF MATERIALS IN THE STREET.
3. GEOTEXTILE FABRIC SHALL BE PLACED UNDER STONE LAYER OF THE CONSTRUCTION ENTRANCE.
4. ALL PORTABLE TOILETS MUST BE ANCHORED TO PREVENT SPILLS.
5. WHERE EXISTING DRAIN TILES OR FIELD TILES ARE ENCOUNTERED WHERE APPLICATION INTERCEPT EXISTING TILES AND TIE THEM INTO THE STORM SYSTEM.

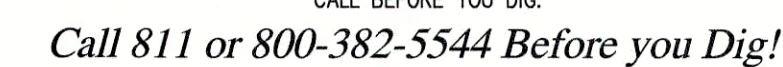

A horizontal graphic scale bar with tick marks at 0', 50', 100', and 150'.

(IN FEET)

ORIGINATING BENCHMARK: INDOT 48-G-0055
A BRONZE PLATE IN THE NORTH END OF THE EAST
SIDEWALK OF CR 650 W BRIDGE (STR I69-15-05323, NBI
39070) OVER I-69; ALSO 18 FEET SOUTH OF THE NORTH
END OF THE BRIDGE.
ELEV = 880.30 (NGVD 29)
ELEV = 879.87 (NAVD 88)



TBM #1
SOUTHWEST UPPER BONNET BOLT
50 FEET SOUTH OF CL 800 SOUTH & 15 FEET WEST OF
CL 650 WEST
ELEV = 870.36 (NAVD 88)

TBM #2
SOUTHWEST UPPER BONNET BOLT
670 FEET SOUTH OF CL 800 SOUTH & 15 FEET WEST OF
CL 650 WEST
ELEV = 866.74 (NAVD 88)


TBM #3
SOUTHWEST UPPER BONNET BOLT
1665 FEET SOUTH OF CL 800 SOUTH & 17 FEET WEST OF
CL 650 WEST
ELEV = 866.25 (NAVD 88)

TBM #4
SOUTHWEST UPPER BONNET BOLT
1290 FEET NORTH OF CL FALL CREEK DRIVE & 17 FEET
WEST OF CL 650 WEST
ELEV = 864.08 (NAVD 88)

VERTICAL SCALE: 1" = 5'
HORIZONTAL SCALE: 1" = 50'

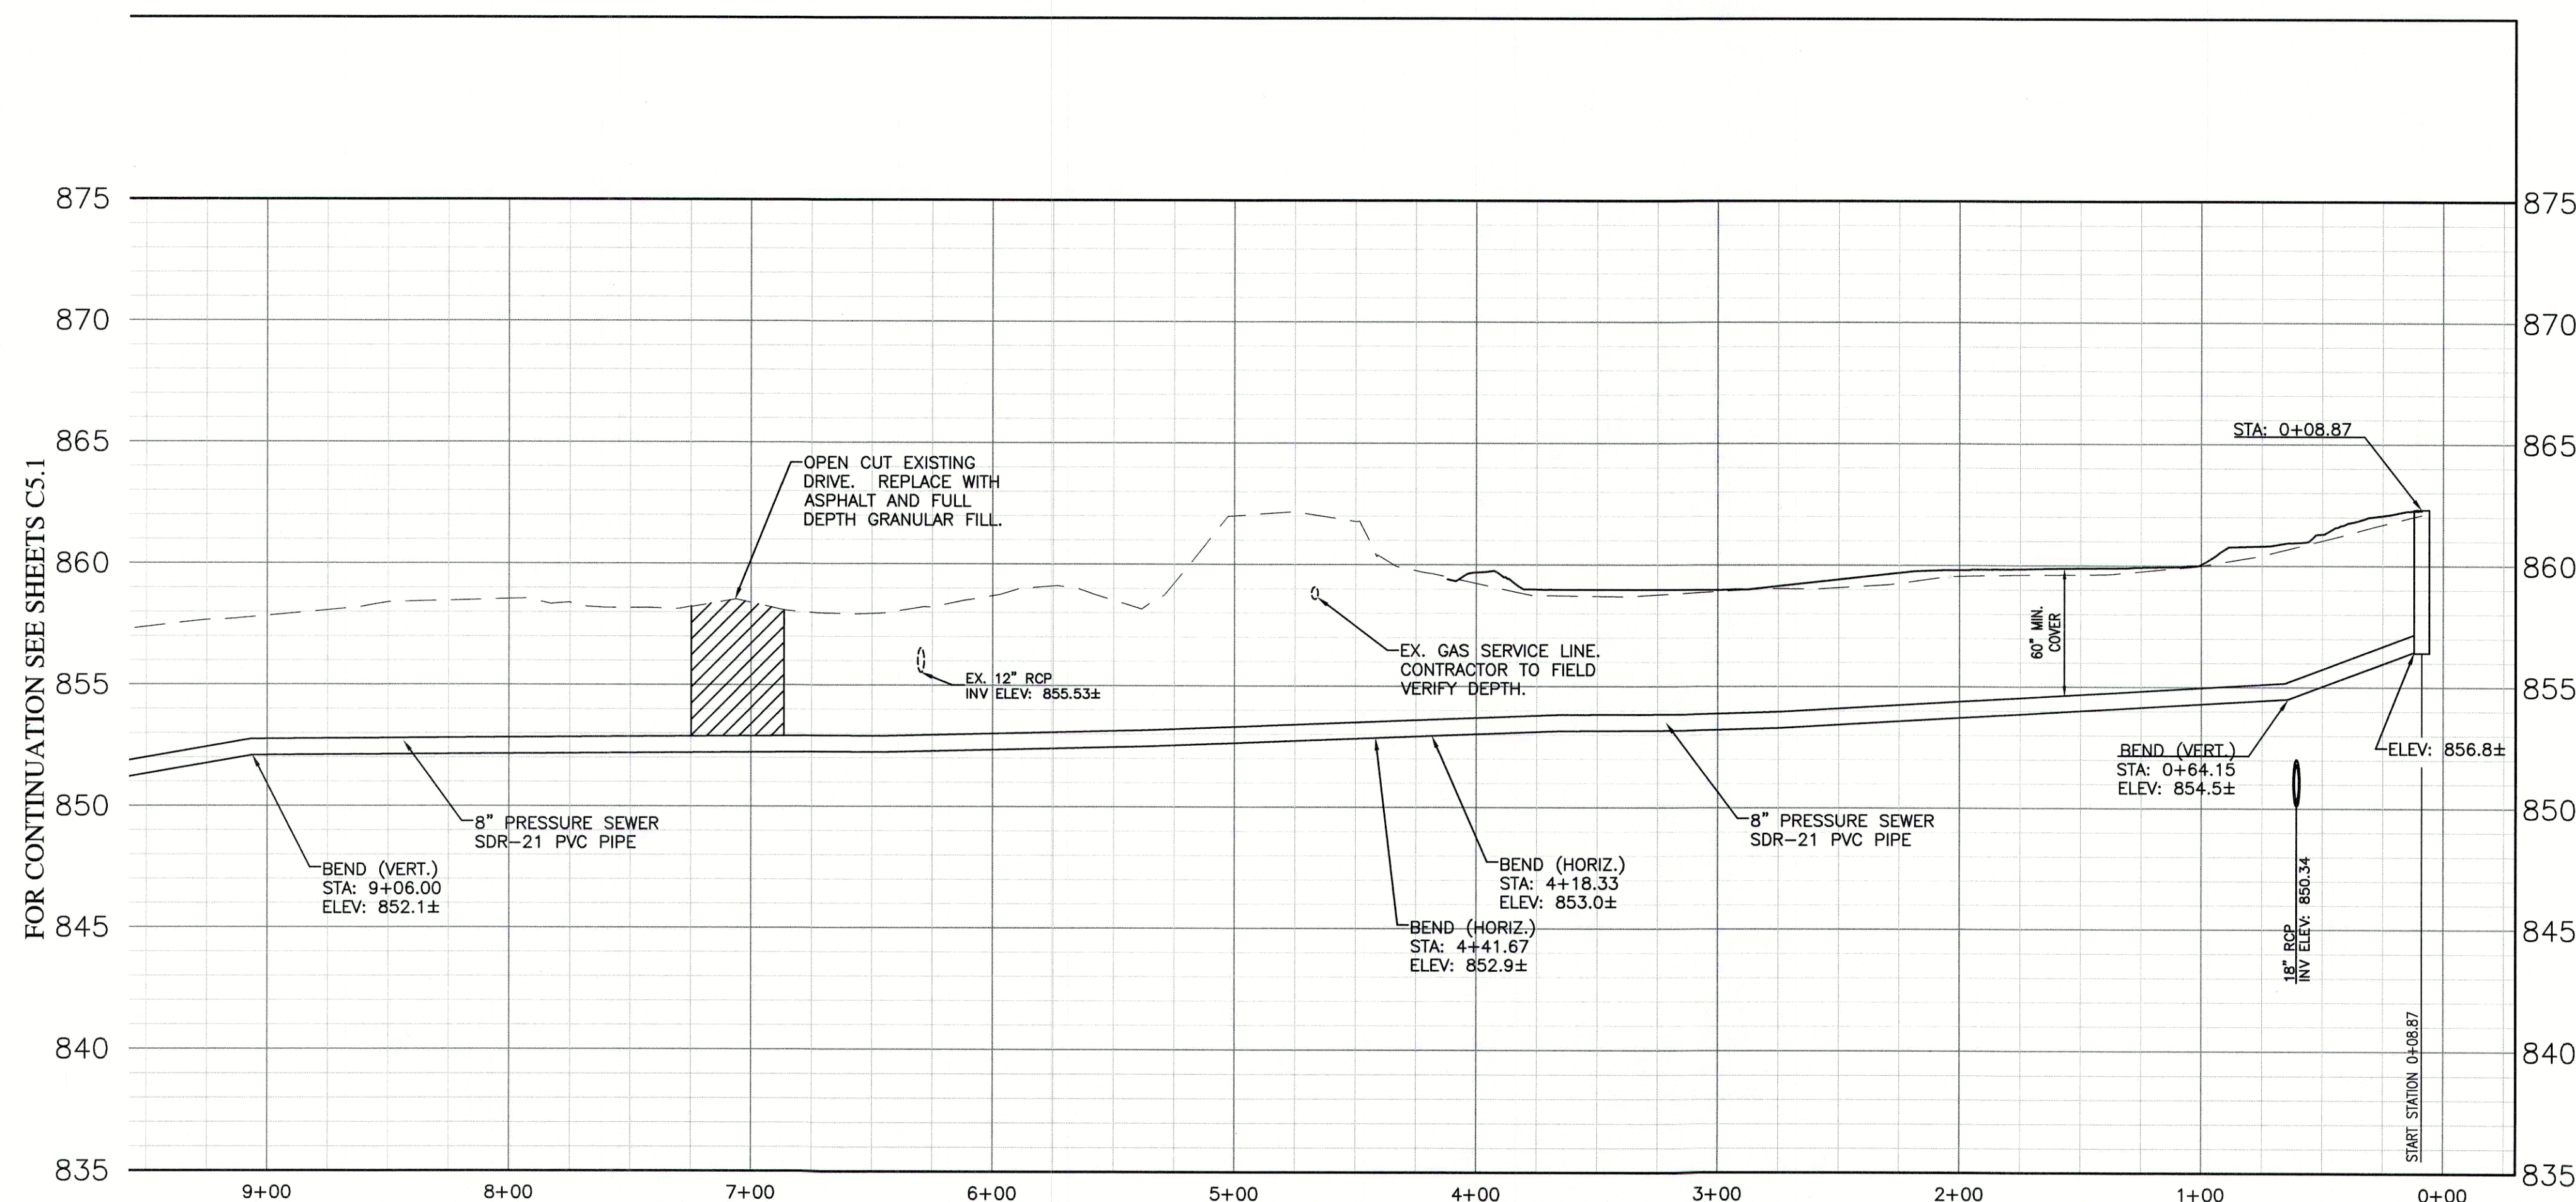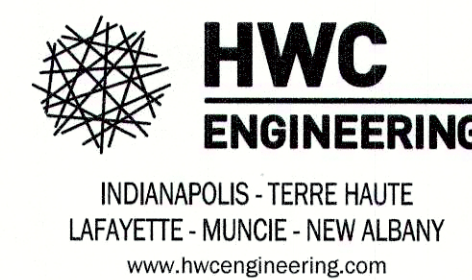[illegible]

MAPLE TRAILS
SECTION 1
FORCEMAIN PLAN AND PROFILE

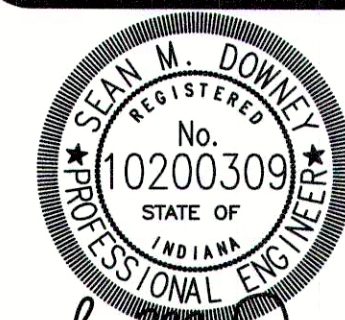

DRAWN BY TD	JOB NUMBER 2017-095-A
CHECKED BY SD	
DATE FEBRUARY 12, 2018	
SCALE AS SHOWN	
SHEET	

C5.0

FORCEMAIN PLAN AND PROFILE