


REVISIONS		
DATE	DESCRIPTION	BY
03/23/18	REVISED PER FORWD REVIEW COMMENTS	DC



MAPLE TRAILS  
SECTION 1  
PROPOSED LIFT STATION PLAN AND  
SECTION

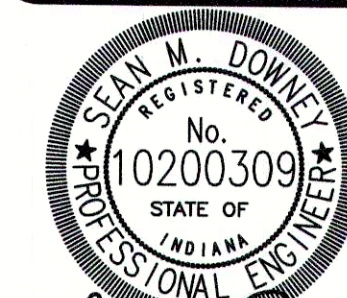

DRAWN BY	TD
CHECKED BY	SD
DATE	FEBRUARY 12, 2018
SCALE	AS SHOWN
SHEET	

C5.2  
PROPOSED LIFT STATION  
PLAN AND SECTION