



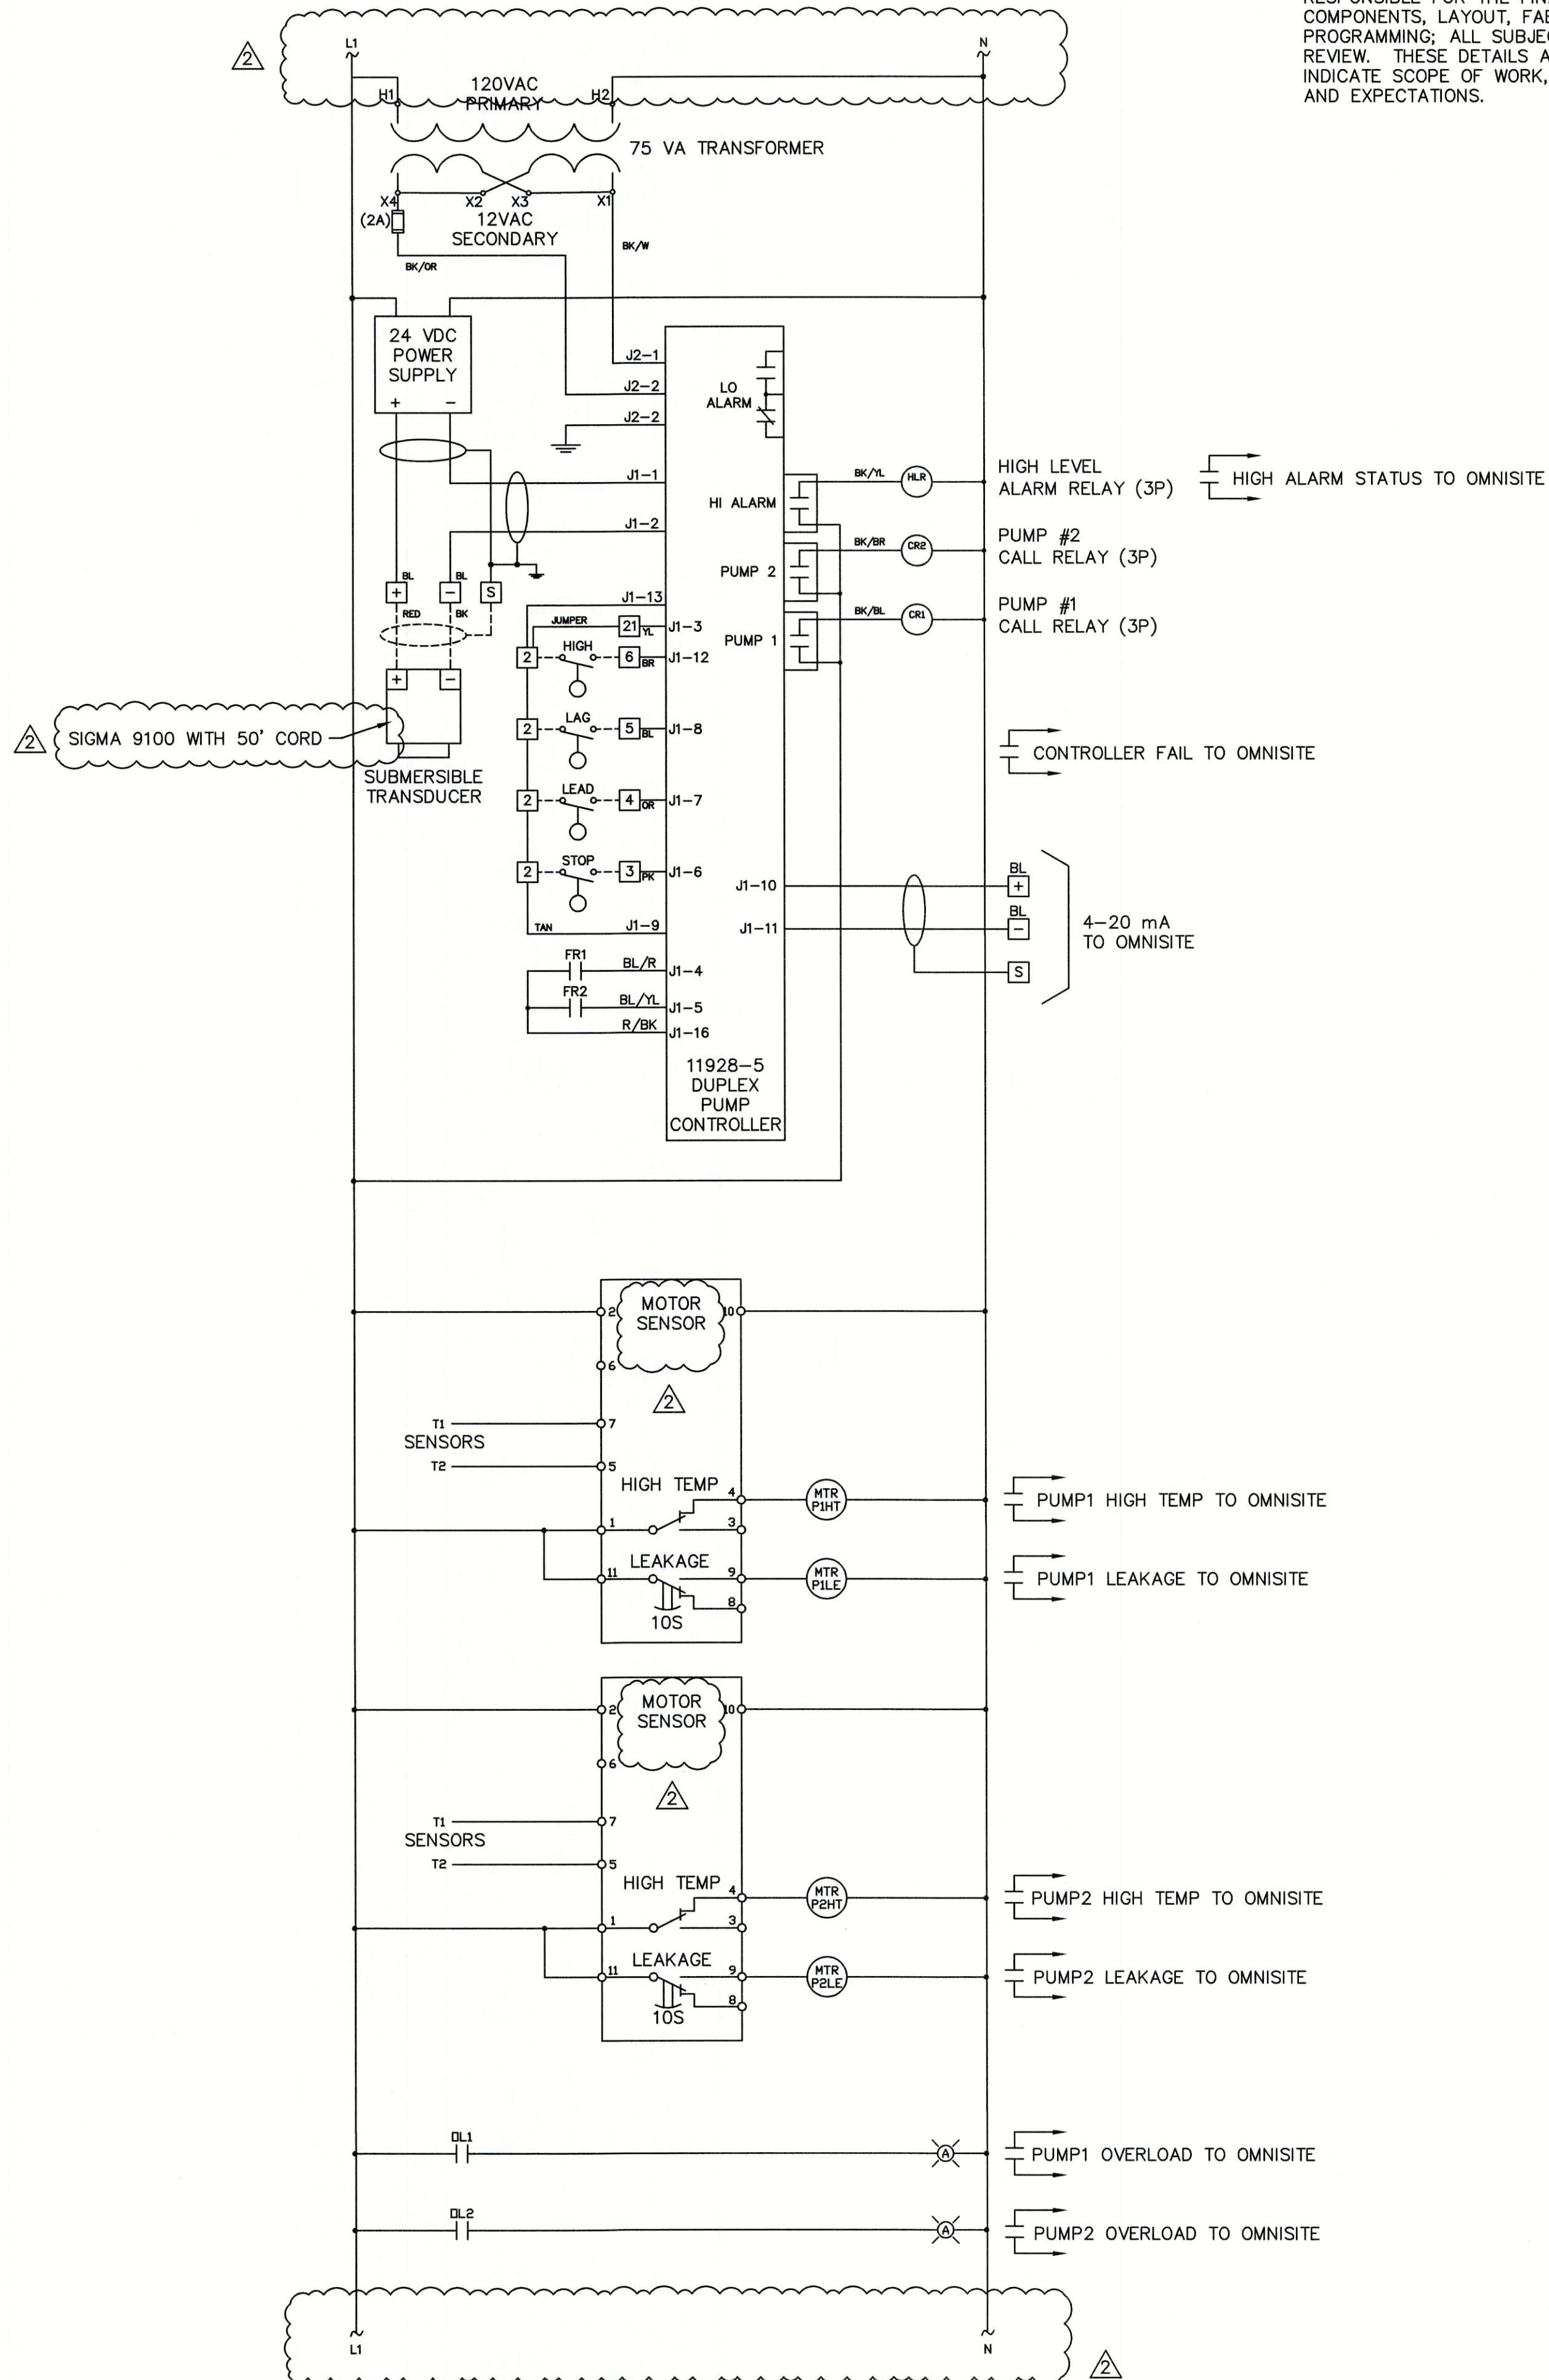


REVISIONS

DATE	DESCRIPTION	BY
3/23/18	FORWD REVIEW	EKZ

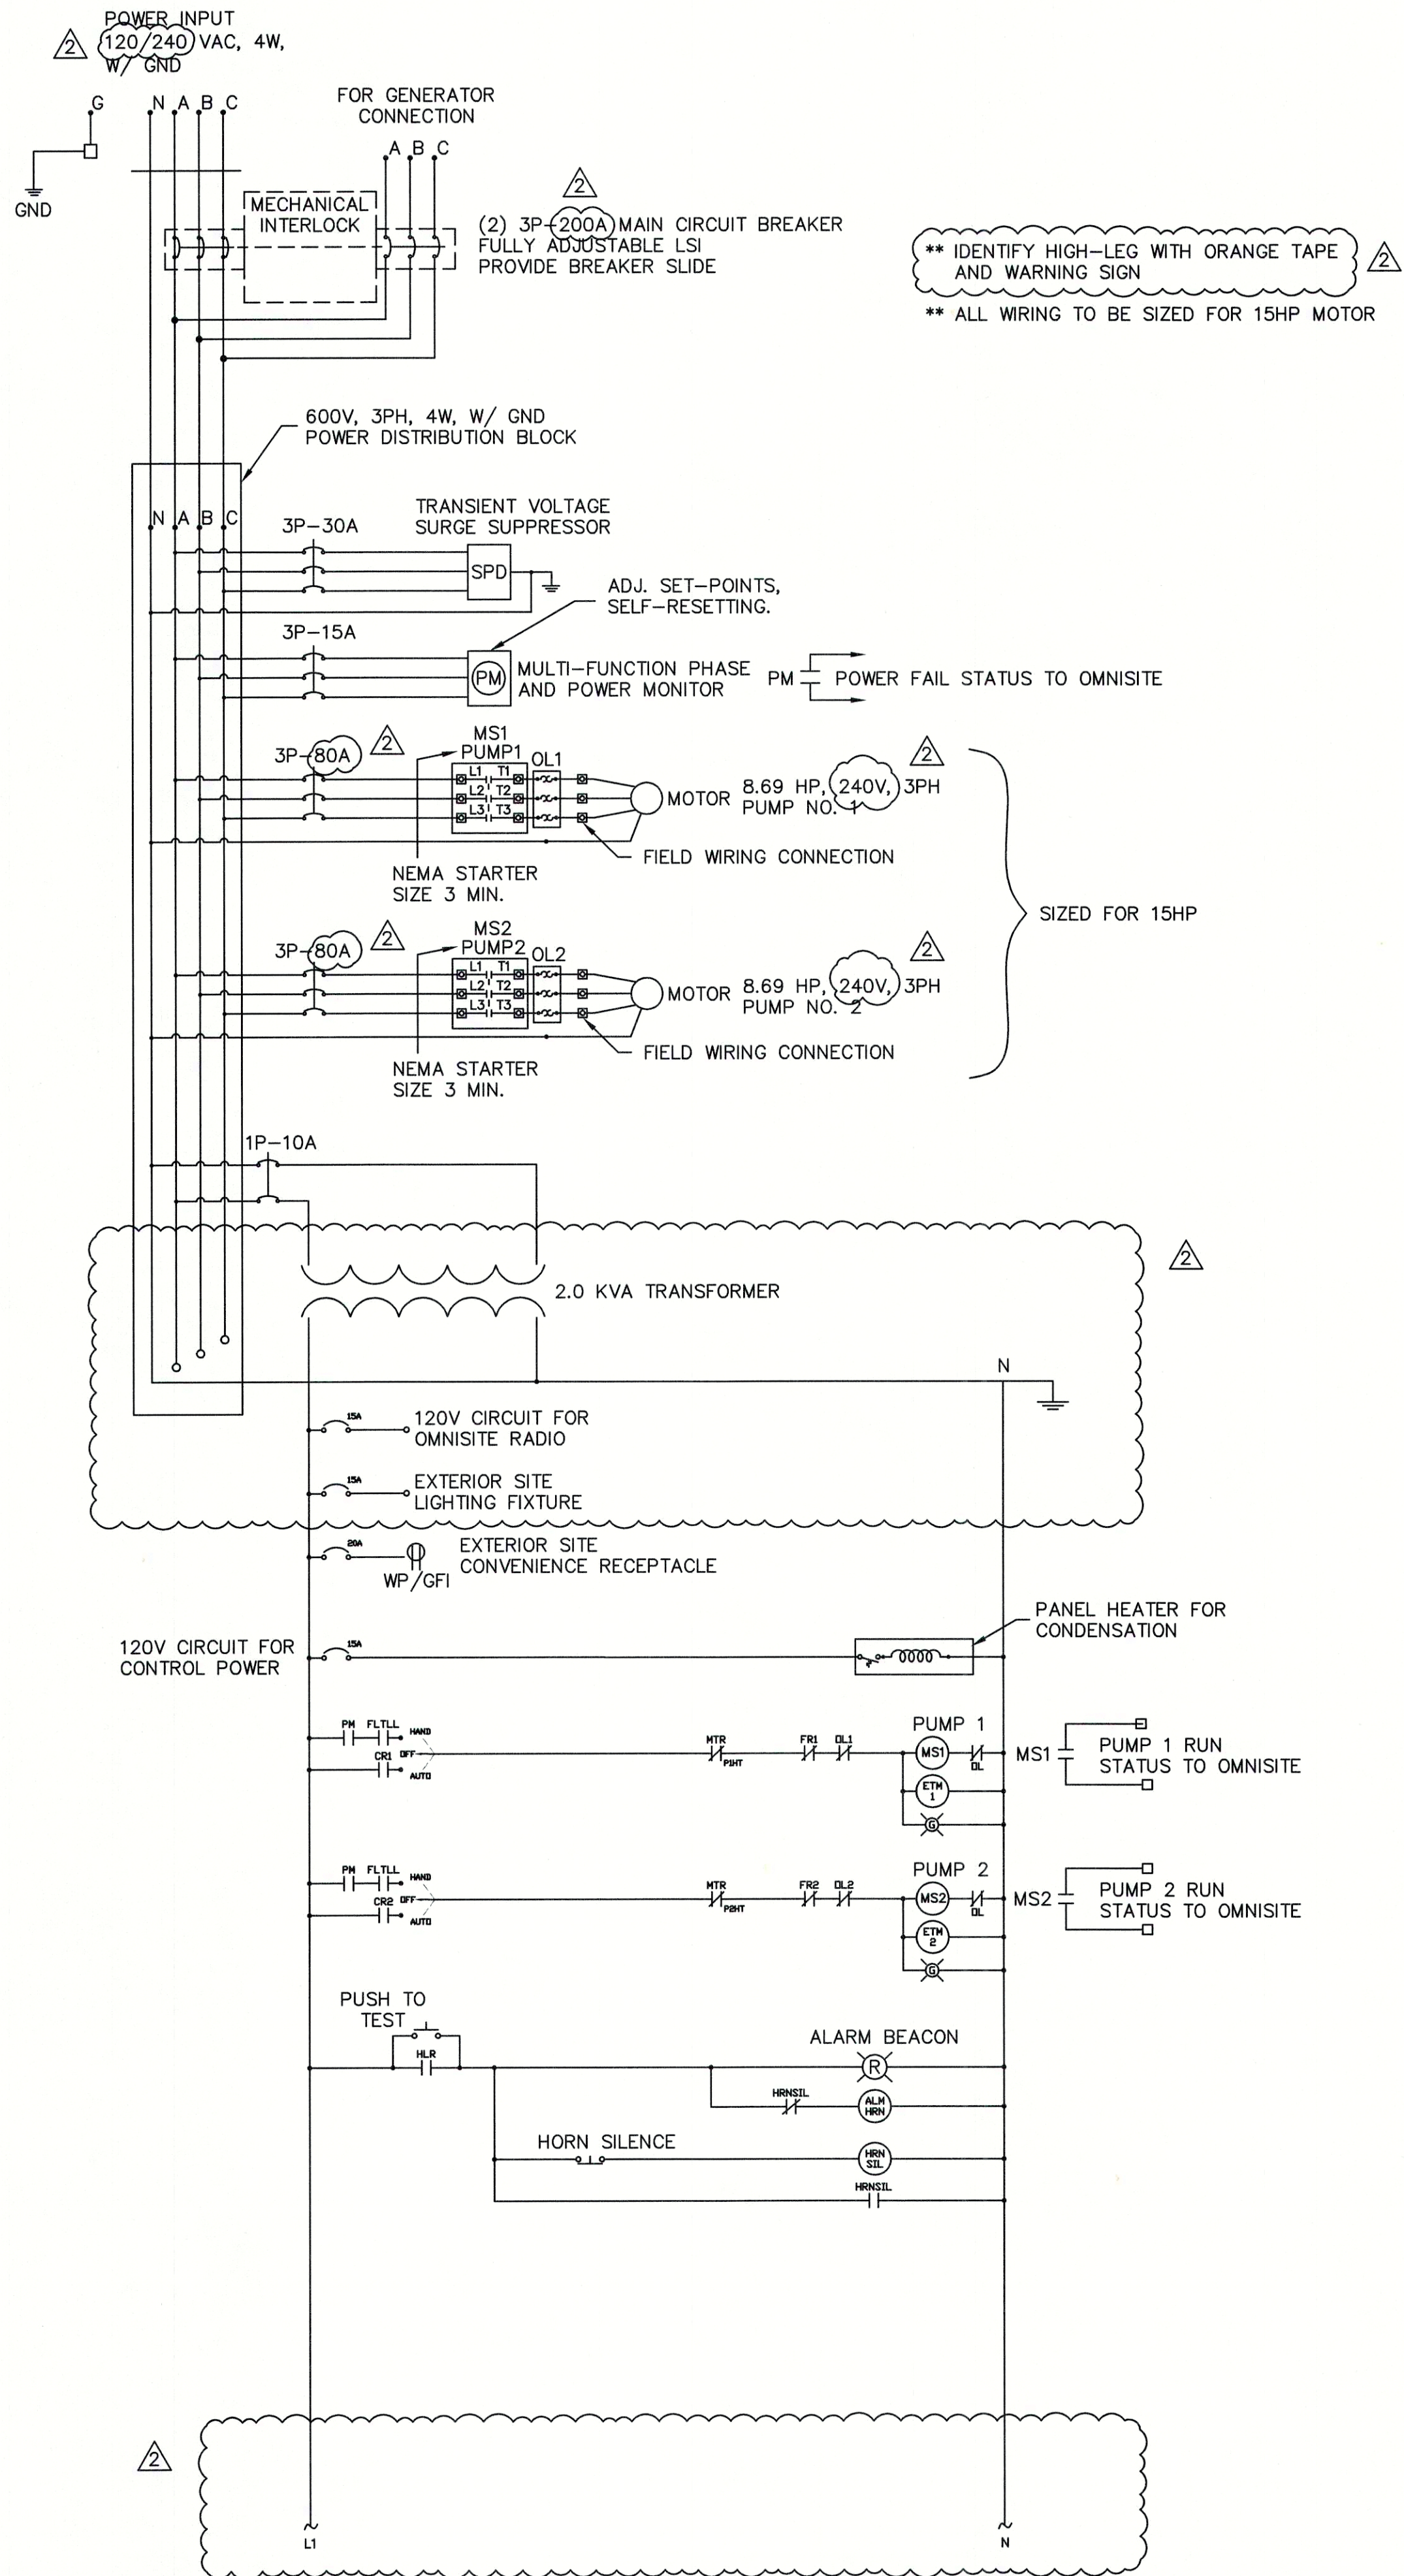

SIMS-DURKIN ASSOCIATES
ENGINEERING COMPANY
1545 COUNTRY CLUB ROAD INDIANAPOLIS, INDIANA 46234
PHONE: (317)209-4035 WEBSITE: WWW.SIMS-DURKIN.COM

MAPLE TRAILS SECTION 1 LIFT STATION - NEW PUMP CONTROL PANEL WIRING DETAILS

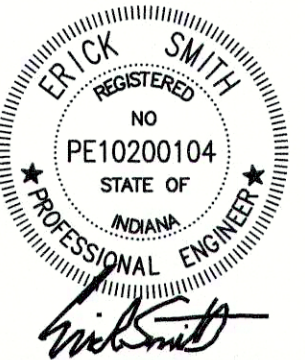

DRAWN BY EKZ	JOB NUMBER 2017-095-A
CHECKED BY ES	
DATE FEBRUARY 15, 2018	
SCALE AS SHOWN	
SHEET	

C5.6

NEW PUMP CONTROL
PANEL WIRING DETAILS