


ORIGINATING BENCHMARK: INDOT 48-G-0055
A BRONZE PLATE IN THE NORTH END OF THE EAST
SIDEWALK OF CR 650 W BRIDGE (STR 169-15-05323, NBI
39070) OVER I-69; ALSO 18 FEET SOUTH OF THE NORTH
END OF THE BRIDGE.
ELEV = 880.30 (NGVD 29)
ELEV = 879.87 (NAVD 88)

TBM #1
SOUTHWEST UPPER BONNET BOLT
50 FEET SOUTH OF CL 800 SOUTH & 15 FEET WEST OF
CL 650 WEST
ELEV = 870.36 (NAVD 88)


TBM #2
SOUTHWEST UPPER BONNET BOLT
670 FEET SOUTH OF CL 800 SOUTH & 15 FEET WEST OF
CL 650 WEST
ELEV = 866.74 (NAVD 88)

TBM #3
SOUTHWEST UPPER BONNET BOLT
1665 FEET SOUTH OF CL 800 SOUTH & 17 FEET WEST OF
CL 650 WEST
ELEV = 866.25 (NAVD 88)

TBM #4
SOUTHWEST UPPER BONNET BOLT
1290 FEET NORTH OF CL FALL CREEK DRIVE & 17 FEET
WEST OF CL 650 WEST
ELEV = 864.08 (NAVD 88)

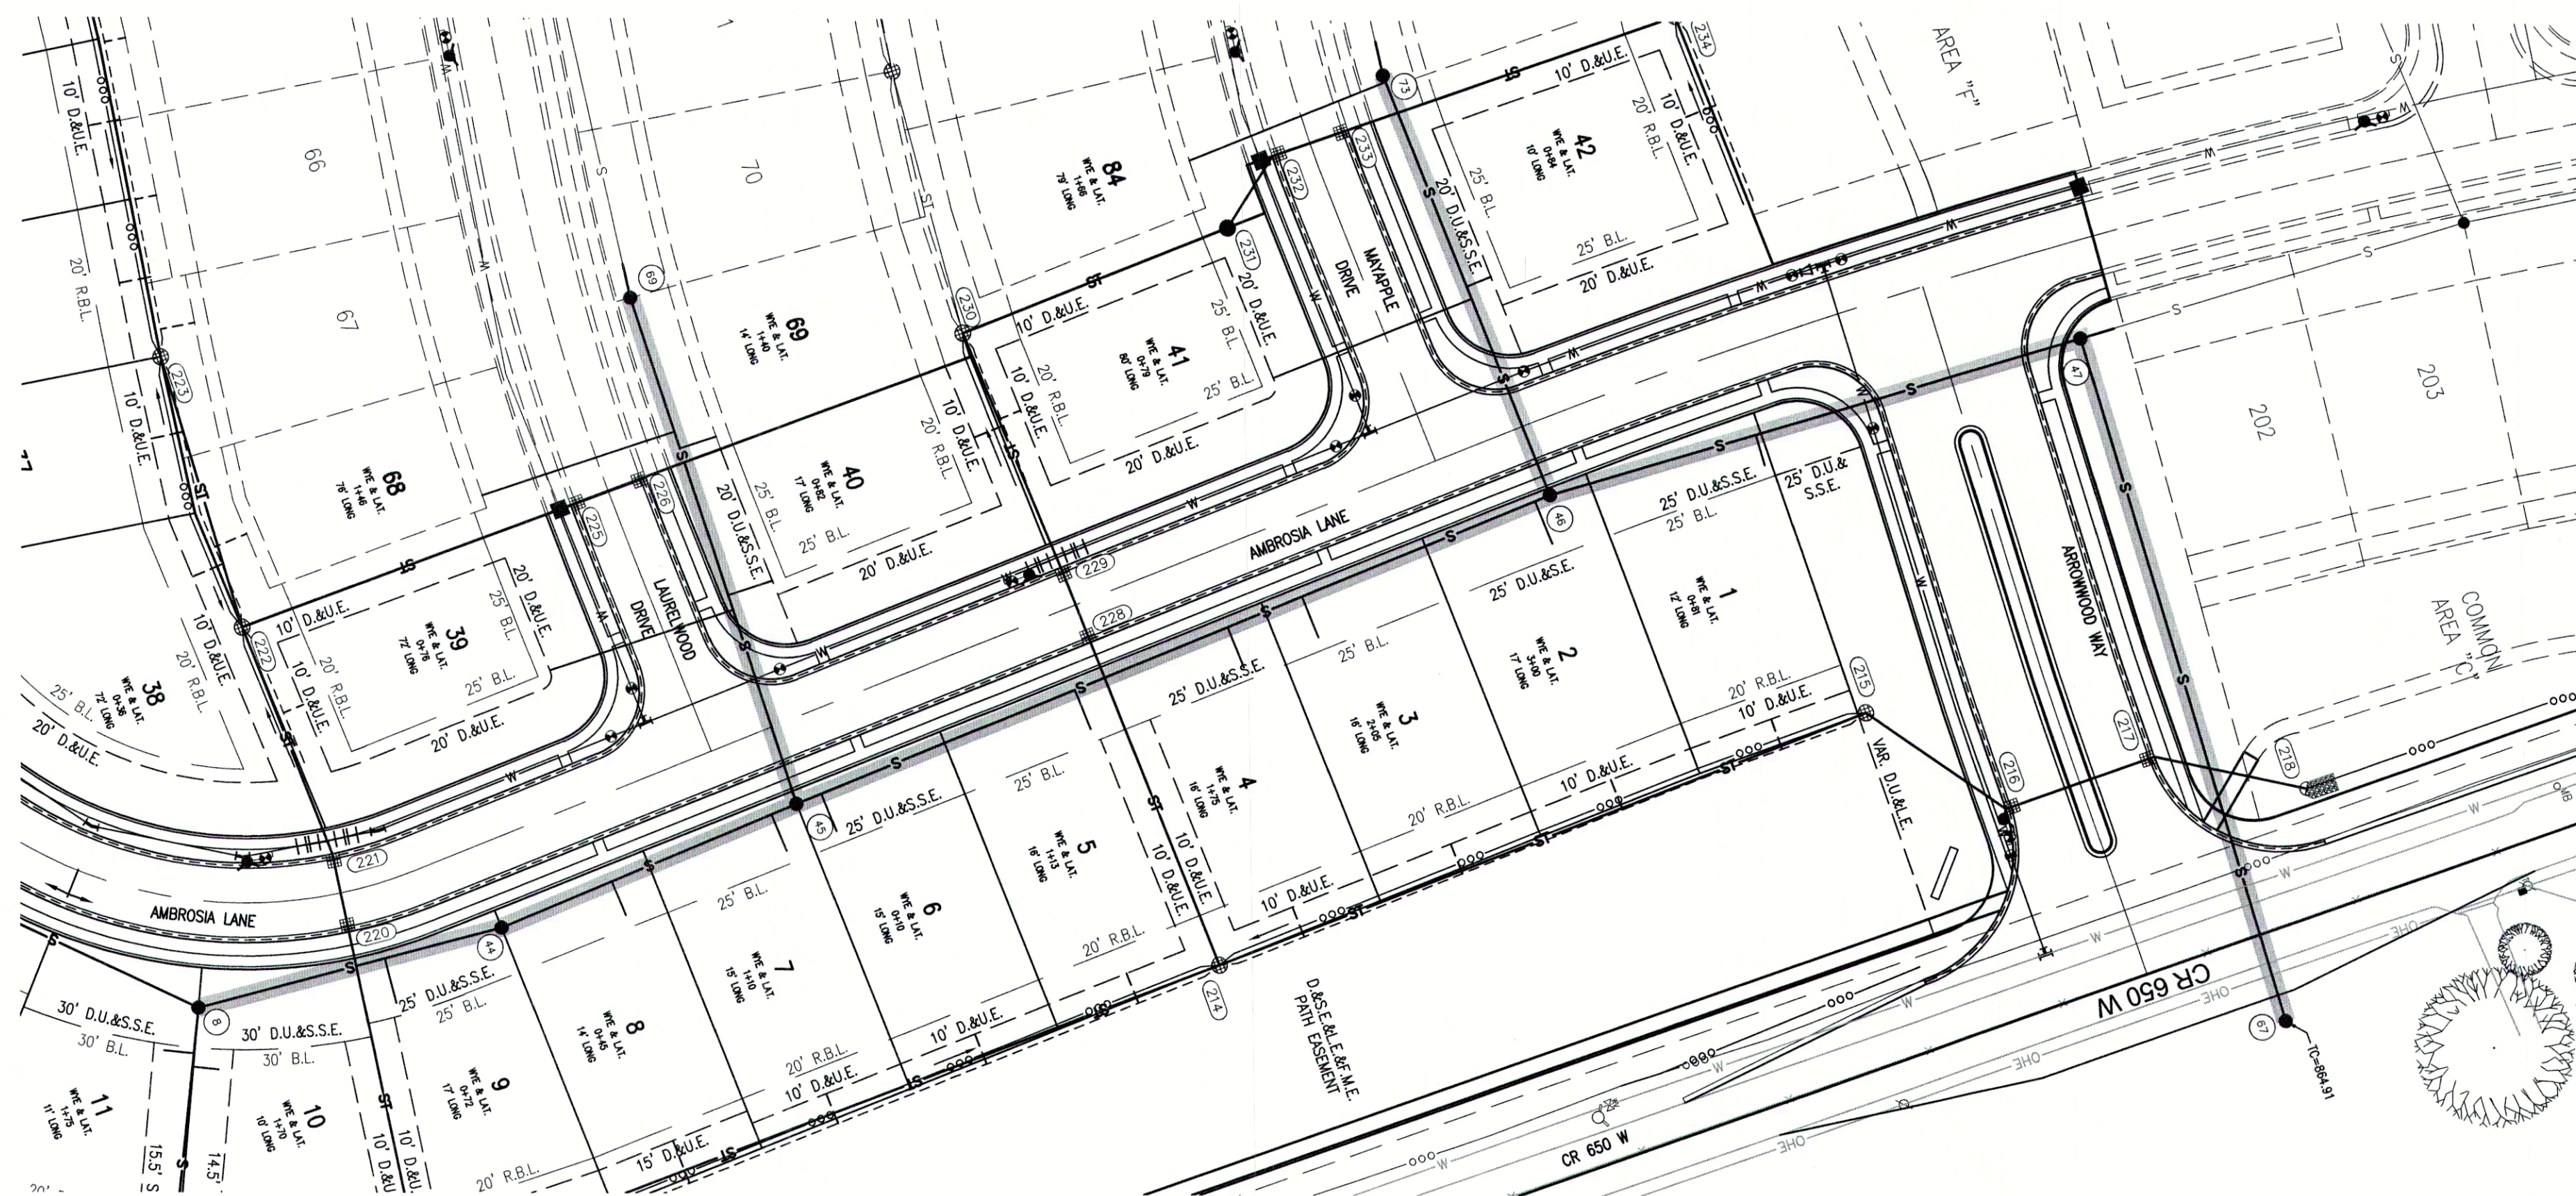


CALL BEFORE YOU DIG.
Call 811 or 800-382-5544 Before you Dig!

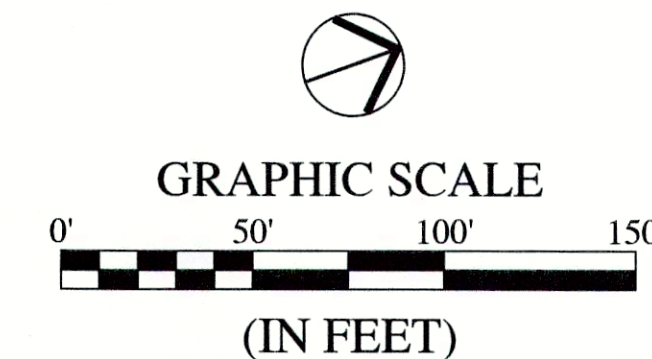

EXISTING			PROPOSED	
		RIGHT-OF-WAY LINE		
		EASEMENT LINE		
		SETBACK LINE		
		CENTERLINE		
		SWALE / FLOWLINE		
		CURB UNDERDRAIN		
		SANITARY SEWER		
		STORM SEWER		
		STORM CULVERT		
		WATER MAIN		
		SANITARY MANHOLE		
		STORM MANHOLE		
		STORM INLET		
		STORM END SECTION		
		FIRE HYDRANT		
		PROFILED PIPELINE		
EX	-	EXISTING		
INV	-	INVERT ELEVATION		
MH	-	MANHOLE		
PVC	-	POLYVINYL CHLORIDE PIPE		
TC	-	TOP OF CASTING GRADE		

VERTICAL SCALE: 1" = 5'
HORIZONTAL SCALE: 1" = 50'

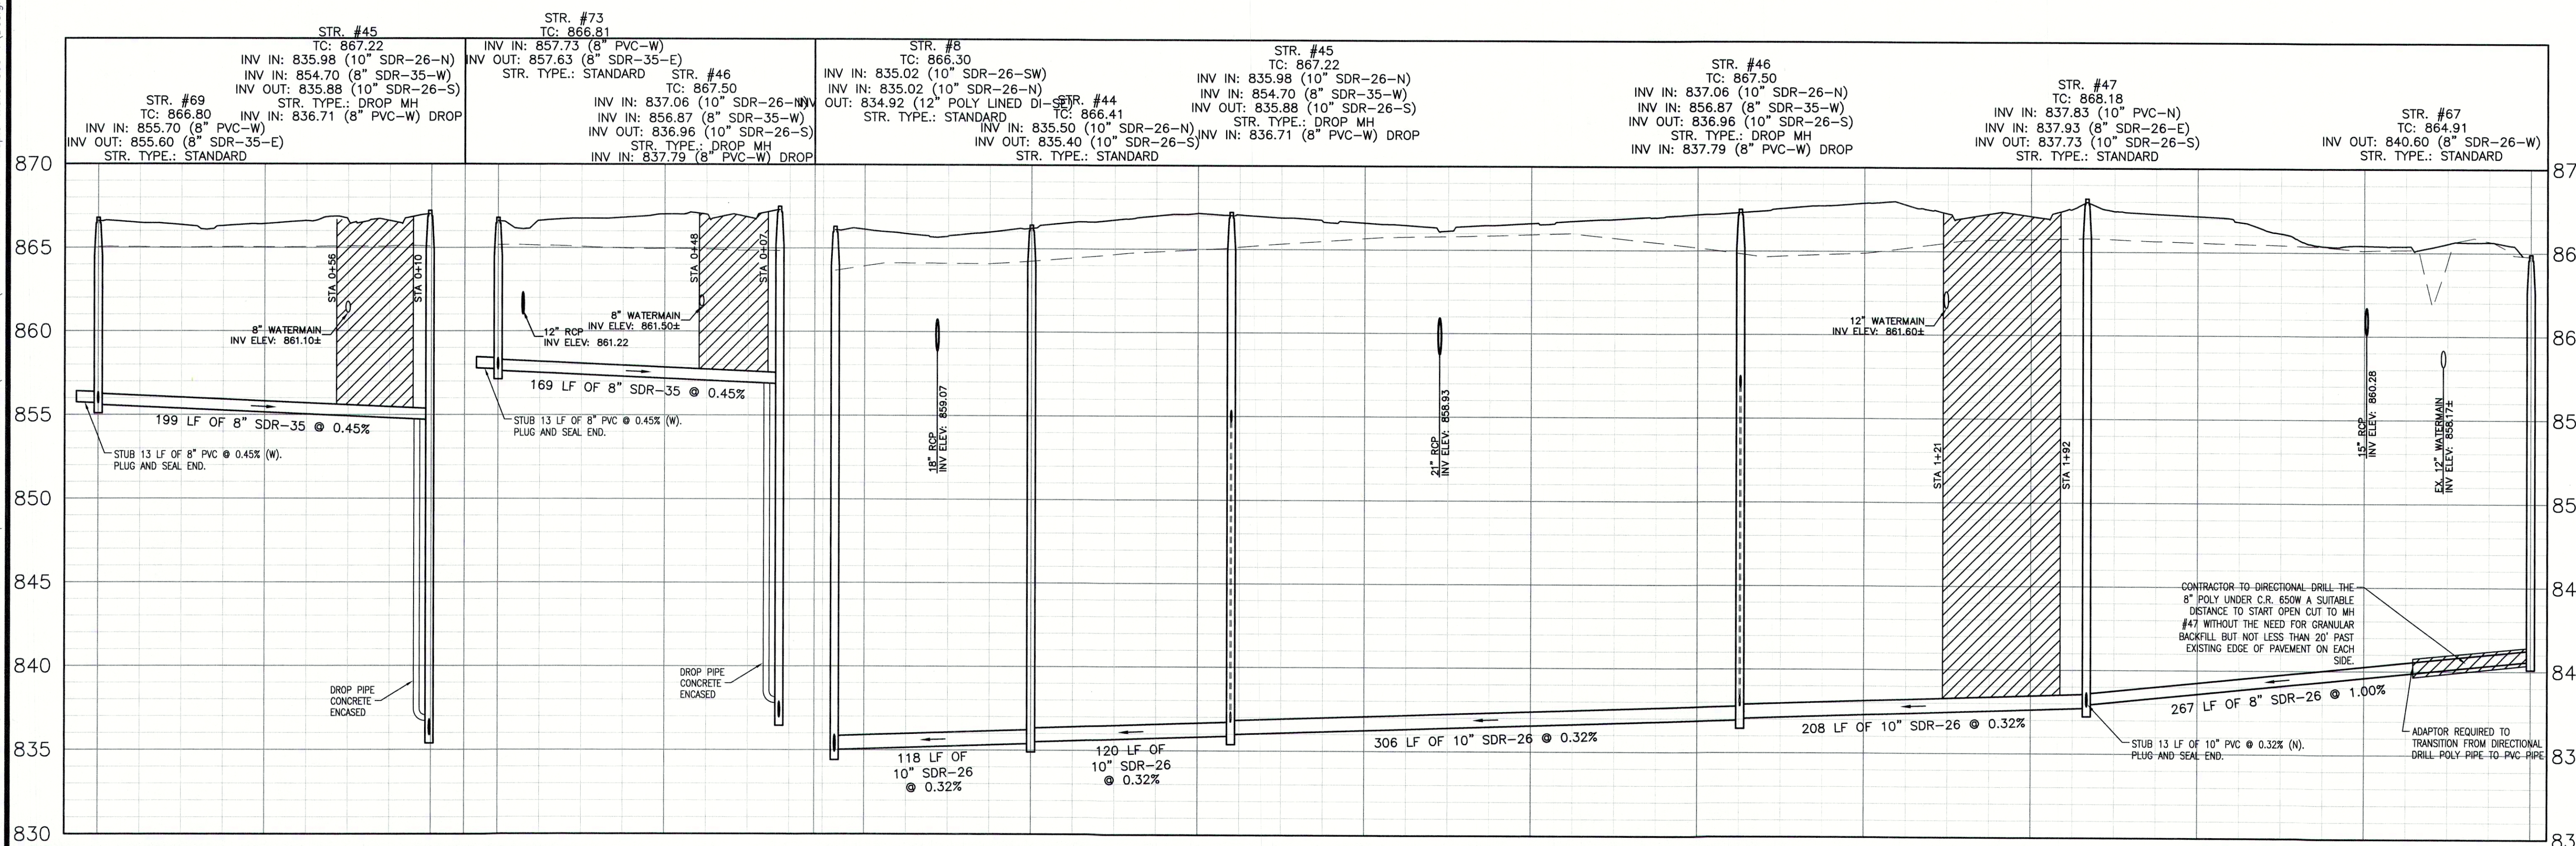


DATE	DESCRIPTION	BY
03/23/18	REVISED PER FCRWD REVIEW COMMENTS	DC



INDIANAPOLIS - TERRE HAUTE
LAFAYETTE - MUNCIE - NEW ALBANY
www.hwcengineering.com

MAPLE TRAILS SECTION 1 SANITARY SEWER PLAN & PROFILE

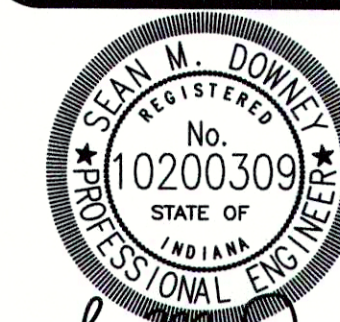

DRAWN BY TD	JOB NUMBER 2017-095-A
CHECKED BY SD	
DATE FEBRUARY 12, 2018	
SCALE AS SHOWN	
SHEET	

C4.0

SANITARY SEWER PLAN & PROFILE