



ORIGINATING BENCHMARK: INDOT 48-G-0055
A BRONZE PLATE IN THE NORTH END OF THE EAST
SIDEWALK OF CR 650 W BRIDGE (STR 169-15-05323, NB
39070) OVER I-69; ALSO 18 FEET SOUTH OF THE NORTH
END OF THE BRIDGE.
ELEV = 880.30 (NGVD 29)
ELEV = 879.87 (NAVD 88)



TBM #1
SOUTHWEST UPPER BONNET BOLT
50 FEET SOUTH OF CL 800 SOUTH & 15 FEET WEST OF
CL 650 WEST
ELEV = 870.36 (NAVD 88)

TBM #2
SOUTHWEST UPPER BONNET BOLT
670 FEET SOUTH OF CL 800 SOUTH & 15 FEET WEST OF
CL 650 WEST
ELEV = 866.74 (NAVD 88)


TBM #3
SOUTHWEST UPPER BONNET BOLT
1665 FEET SOUTH OF CL 800 SOUTH & 17 FEET WEST C
CL 650 WEST
ELEV = 866.25 (NAVD 88)

TBM #4
SOUTHWEST UPPER BONNET BOLT
1290 FEET NORTH OF CL FALL CREEK DRIVE & 17 FEET
WEST OF CL 650 WEST
ELEV' = 864.08 (NAVD 88)

EXISTING		PROPOSED	
	RIGHT-OF-WAY LINE		RIGHT-OF-WAY LINE
	EASEMENT LINE		EASEMENT LINE
	SETBACK LINE		SETBACK LINE
	CENTERLINE		CENTERLINE
	SWALE / FLOWLINE		SWALE / FLOWLINE
	CURB UNDERDRAIN		CURB UNDERDRAIN
	SANITARY SEWER		SANITARY SEWER
	STORM SEWER		STORM SEWER
	STORM CULVERT		STORM CULVERT
	WATER MAIN		WATER MAIN
	SANITARY MANHOLE		SANITARY MANHOLE
	STORM MANHOLE		STORM MANHOLE
	STORM INLET		STORM INLET
	STORM END SECTION		STORM END SECTION
	FIRE HYDRANT		FIRE HYDRANT
	PROFILED PIPELINE		PROFILED PIPELINE
EX	- EXISTING		
INV	- INVERT ELEVATION		
MH	- MANHOLE		
PVC	- POLYVINYL CHLORIDE PIPE		
TC	- TOP OF CASTING GRADE		

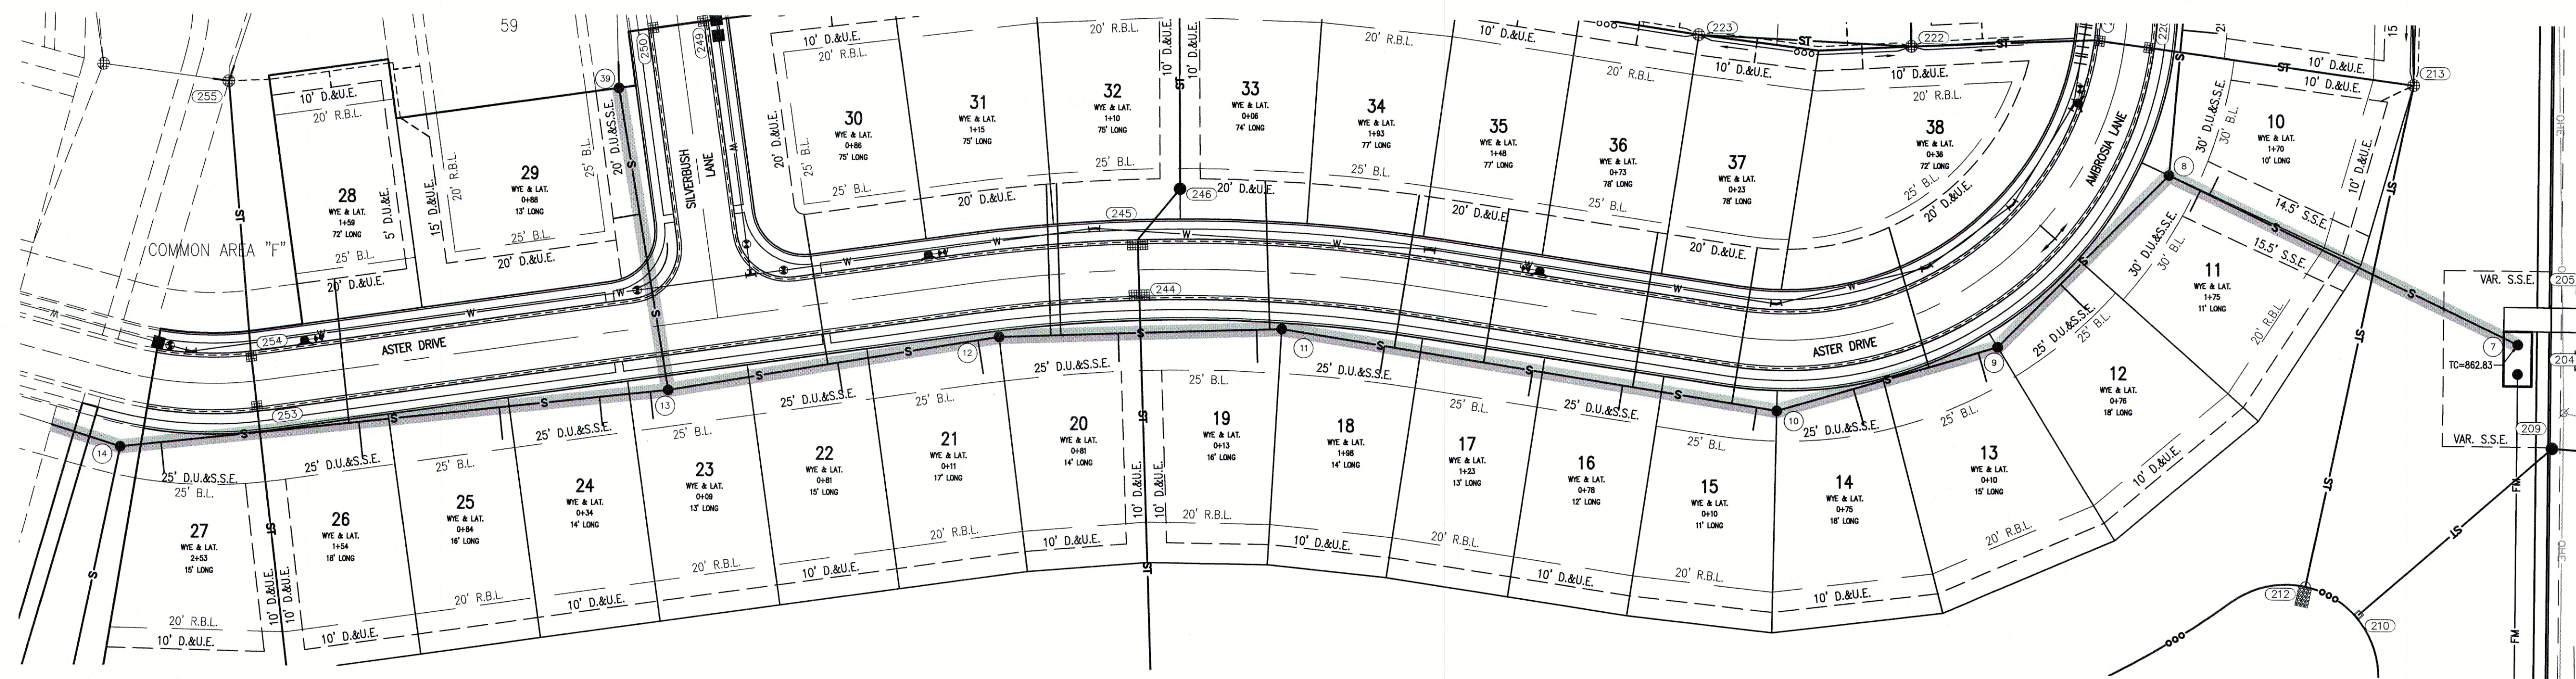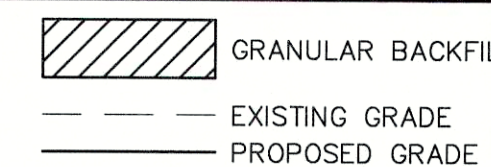


VERTICAL SCALE: 1" = 5'
HORIZONTAL SCALE: 1" = 50'

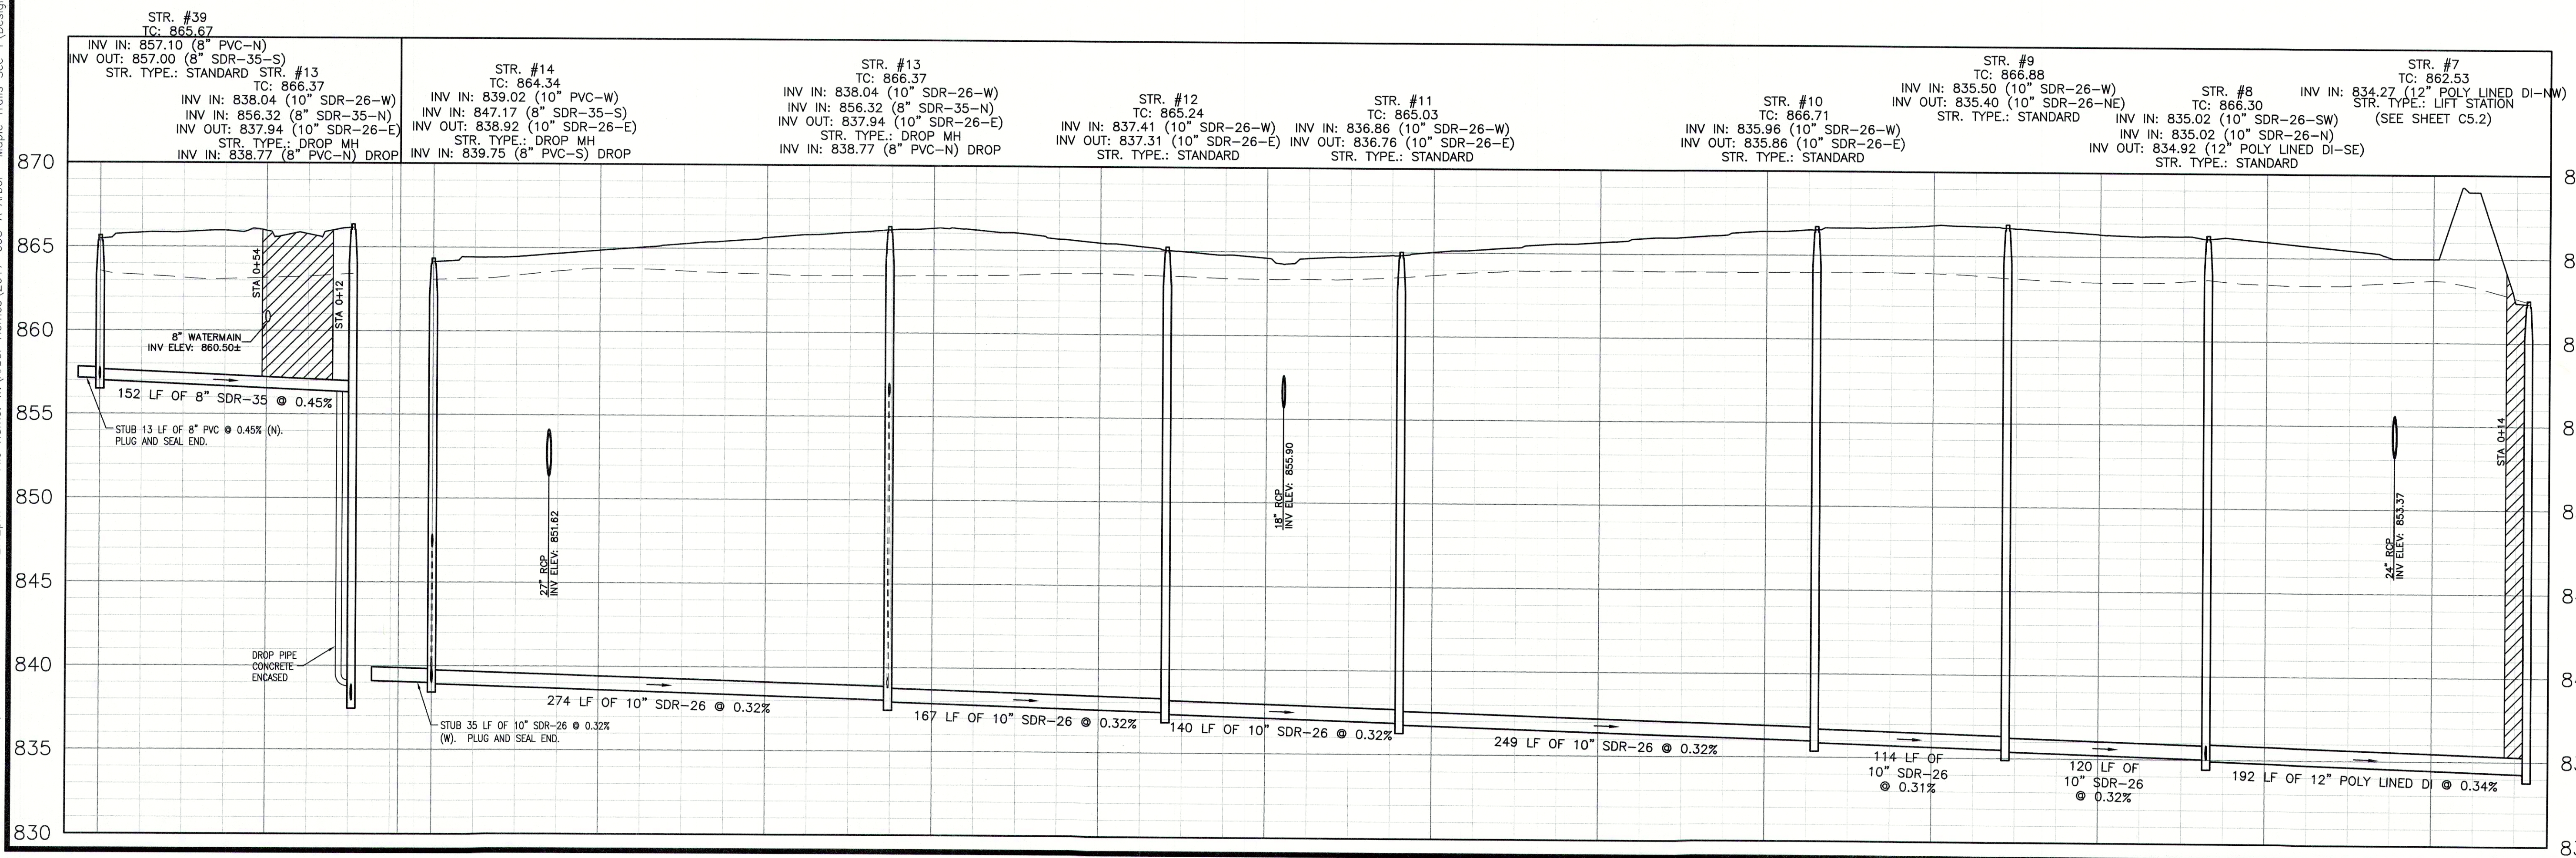

DATE	DESCRIPTION	BY
03/23/18	REVISED PER FCRWD REVIEW COMMENTS	DC



MAPLE TRAILS
SECTION 1
SANITARY SEWER PLAN & PROFILE

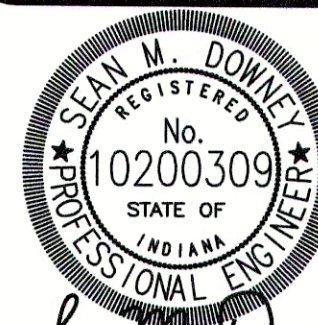

DRAWN BY	TD
CHECKED BY	SD
DATE	FEBRUARY 12, 2018
SCALE	AS SHOWN
SHEET	

C4.1

SANITARY SEWER PLANT PROFILE

© 201