

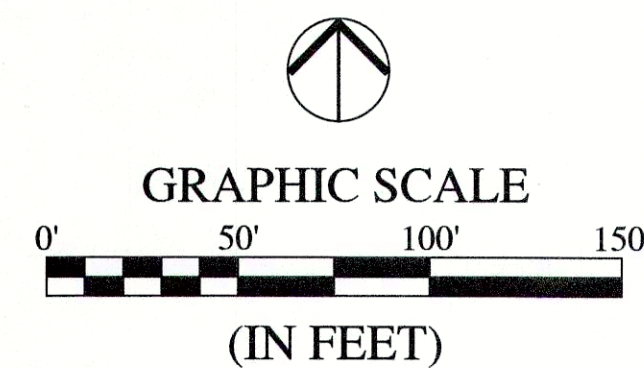


TBM #4
SOUTHWEST UPPER BONNET BOLT
1290 FEET NORTH OF CL FALL CREEK DRIVE & 17 FEET
WEST OF CL 650 WEST
ELEV = 864.08 (NAVD 88)

VERTICAL SCALE: 1" = 5'
HORIZONTAL SCALE: 1" = 50'

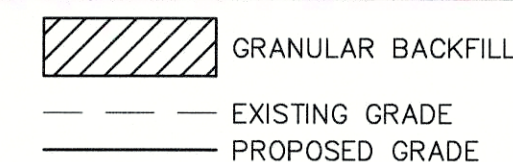

MAPLE TRAILS
SECTION 1
SANITARY SEWER PLAN & PROFILE

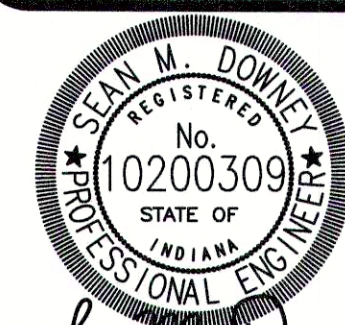

DRAWN BY TD	JOB NUMBER 2017-095-A
CHECKED BY SD	
DATE FEBRUARY 12, 2018	
SCALE AS SHOWN	
SHEET	

C4.2

SANITARY SEWER PLAN PROFILE