


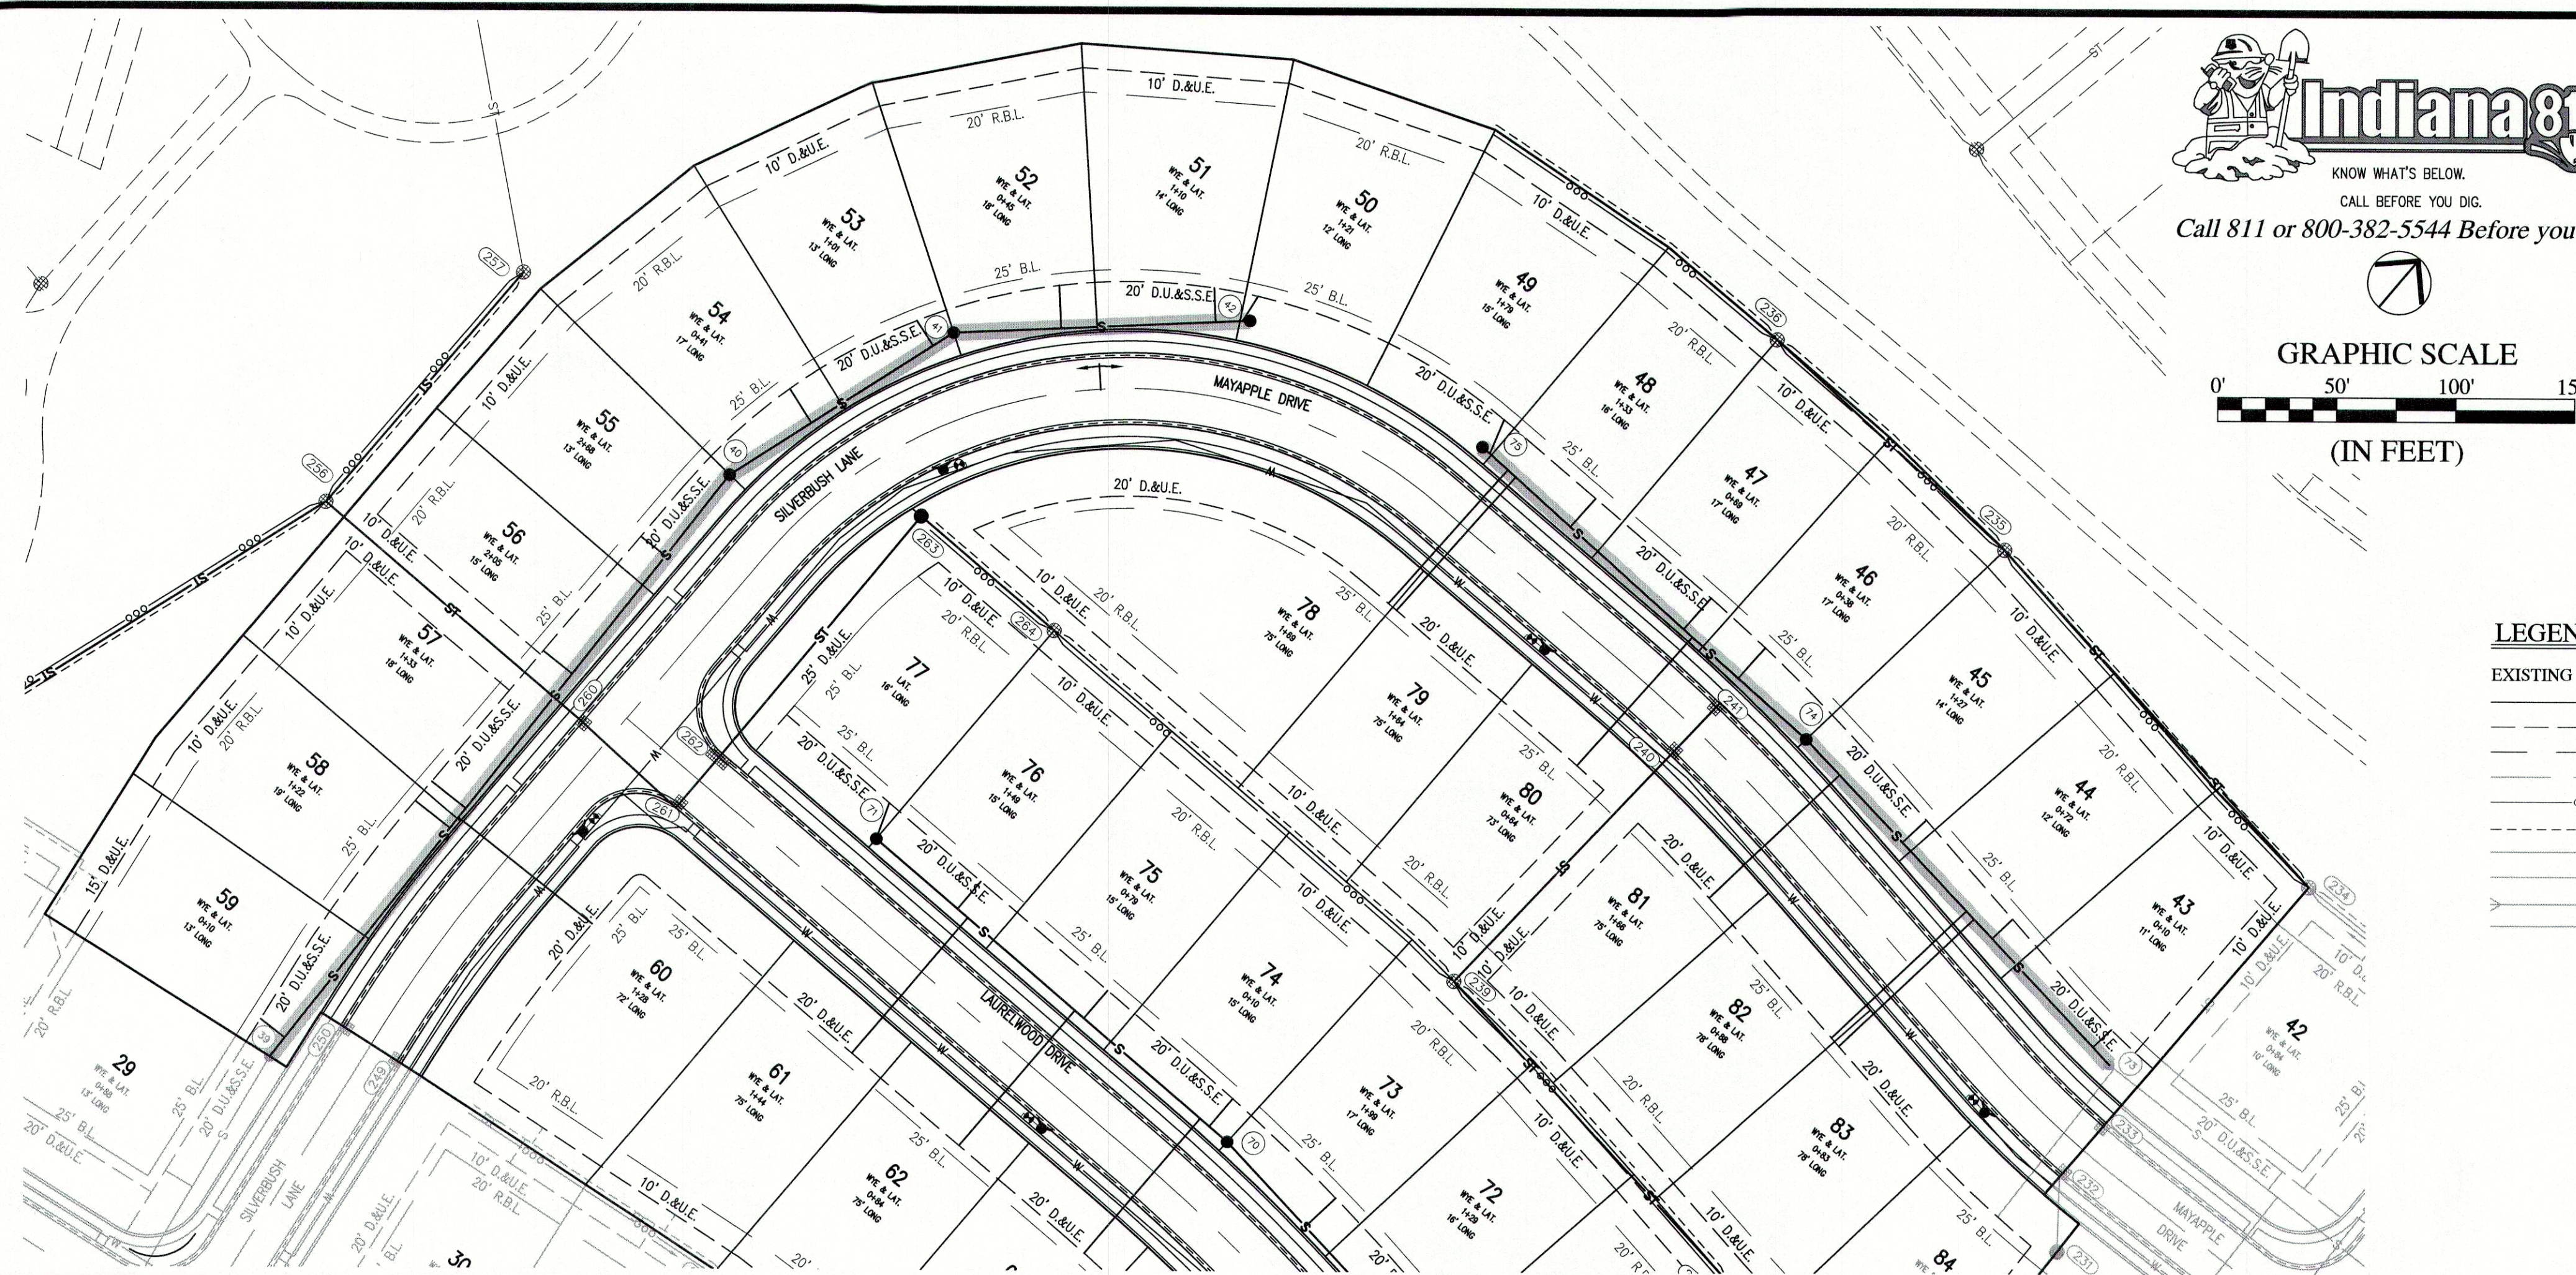

BENCHMARK INFORMATION:

ORIGINATING BENCHMARK: INDOT 48-6 OF 5555
A BRIDGE PLATE IN THE NORTH END OF THE
SIDEWALK OF CR 650 W BRIDGE (STR 809-15-05323, NBI
39070) OVER I-69. ALSO 18 FEET SOUTH OF THE NORTH
END OF THE BRIDGE.
ELEV = 860.36 (INVD 29)
ELEV = 879.87 (NAVD 88)

TBM #1
SOUTHWEST UPPON BONNET BOLT
50 FEET SOUTH OF CL 800 SOUTH & 15 FEET WEST OF
CL 650 WEST
ELEV = 870.36 (NAVD 88)


TBM #2
SOUTHWEST UPPON BONNET BOLT
60 FEET SOUTH OF CL 800 SOUTH & 15 FEET WEST OF
CL 650 WEST
ELEV = 866.74 (NAVD 88)

TBM #3
SOUTHWEST UPPON BONNET BOLT
165 FEET SOUTH OF CL 800 SOUTH & 17 FEET WEST OF
CL 650 WEST
ELEV = 866.25 (NAVD 88)

TBM #4
SOUTHWEST UPPON BONNET BOLT
1250 FEET NORTH OF CL FALL CREEK DRIVE & 17 FEET
WEST OF CL 650 WEST
ELEV = 864.08 (NAVD 88)

[illegible]

MAPLE TRAILS
SECTION 2
SANITARY SEWER PLAN & PROFILE

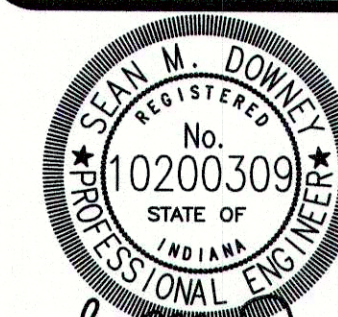

DRAWN BY TD	JOB NUMBER 2017-095-B
CHECKED BY SD	
DATE AUGUST 7, 2018	
SCALE AS SHOWN	
SHEET	

C4.0

SANITARY SEWER PLAN &
PROFILE

© 2018

SANITARY PROFILE

VERTICAL SCALE: 1" = 5'
HORIZONTAL SCALE: 1" = 50'

