
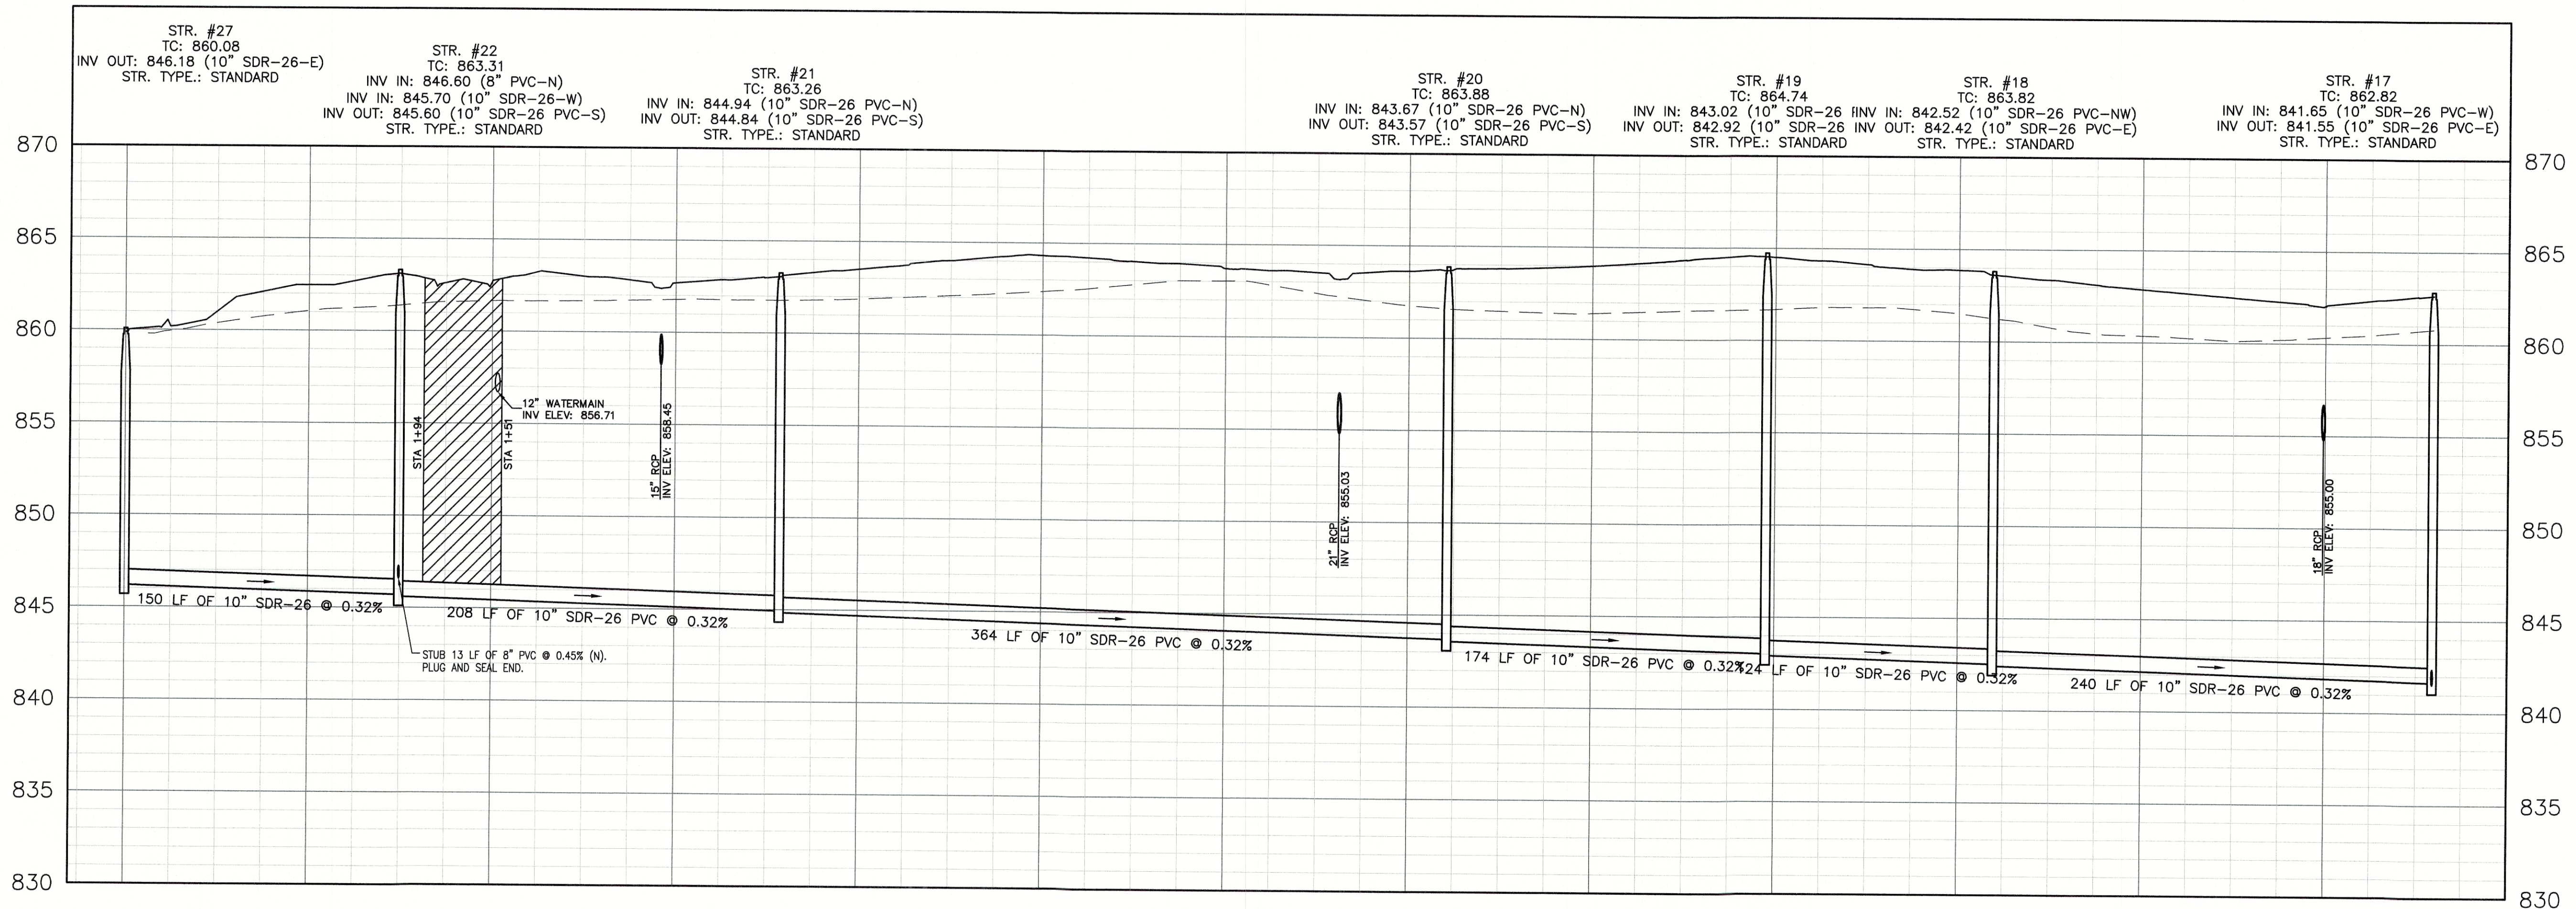


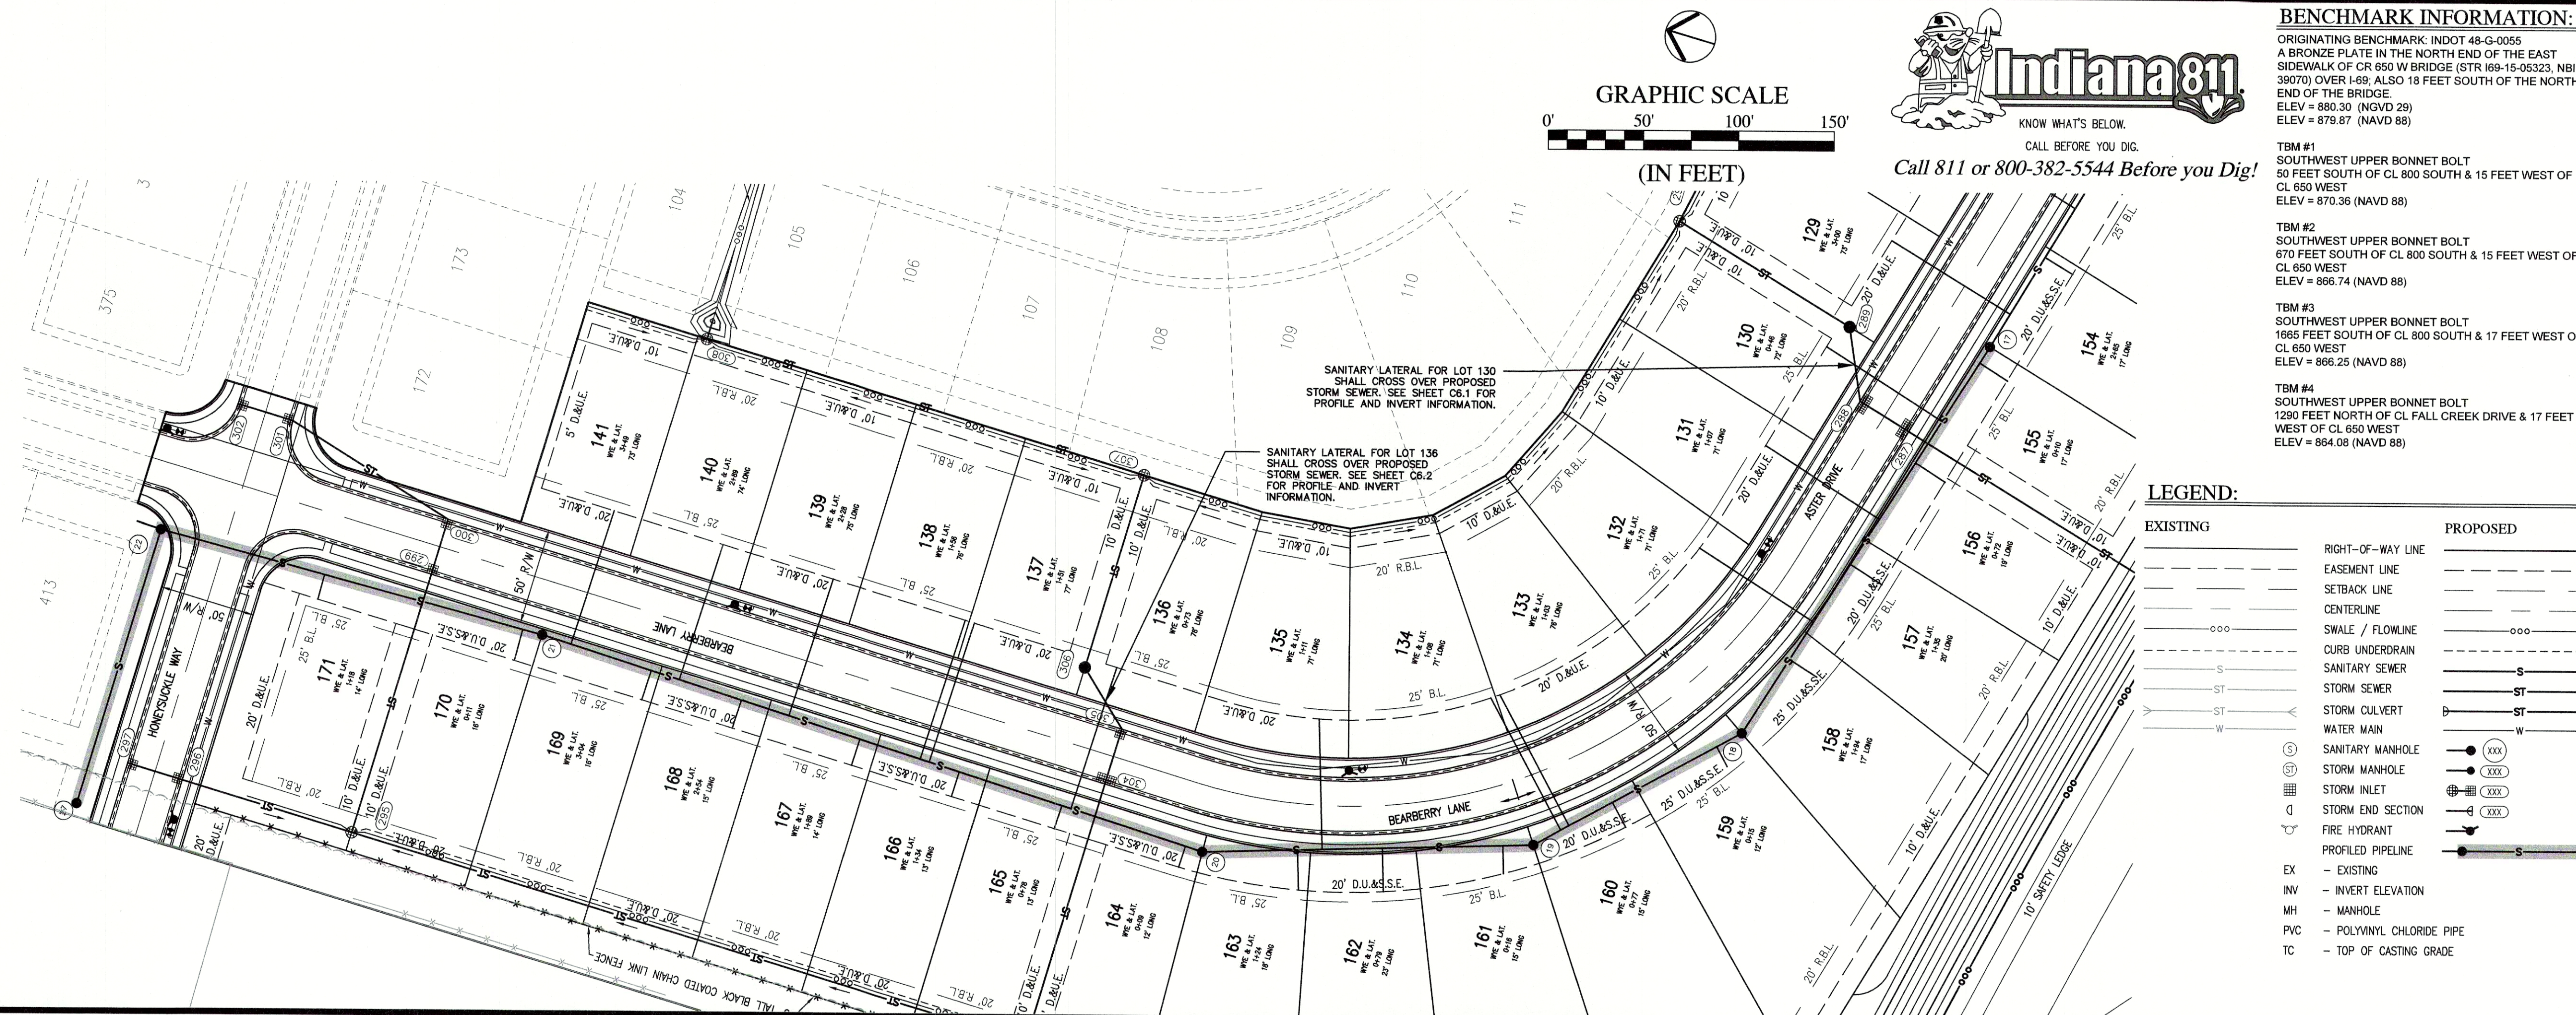

REVISIONS

DATE	DESCRIPTION	BY

HWC ENGINEERING
INDIANAPOLIS - TERRE HAUTE
LAFAYETTE - MUNICE - NEW ALBANY
www.hwcengineering.com

MAPLE TRAILS SECTION 4 SANITARY SEWER PLAN & PROFILE

PROFESSIONAL ENGINEER
K. Christopher K. Kichner
No. 11400758
STATE OF INDIANA
NOT A NOTARIAL ACT

DRAWN BY: TD/TS/GM
CHECKED BY: KE
DATE: APRIL 16, 2020
SCALE: AS SHOWN
SHEET: C4.1

JOB NUMBER: 2017-095-D

C4.1
SANITARY SEWER PLAN & PROFILE

© 2020