


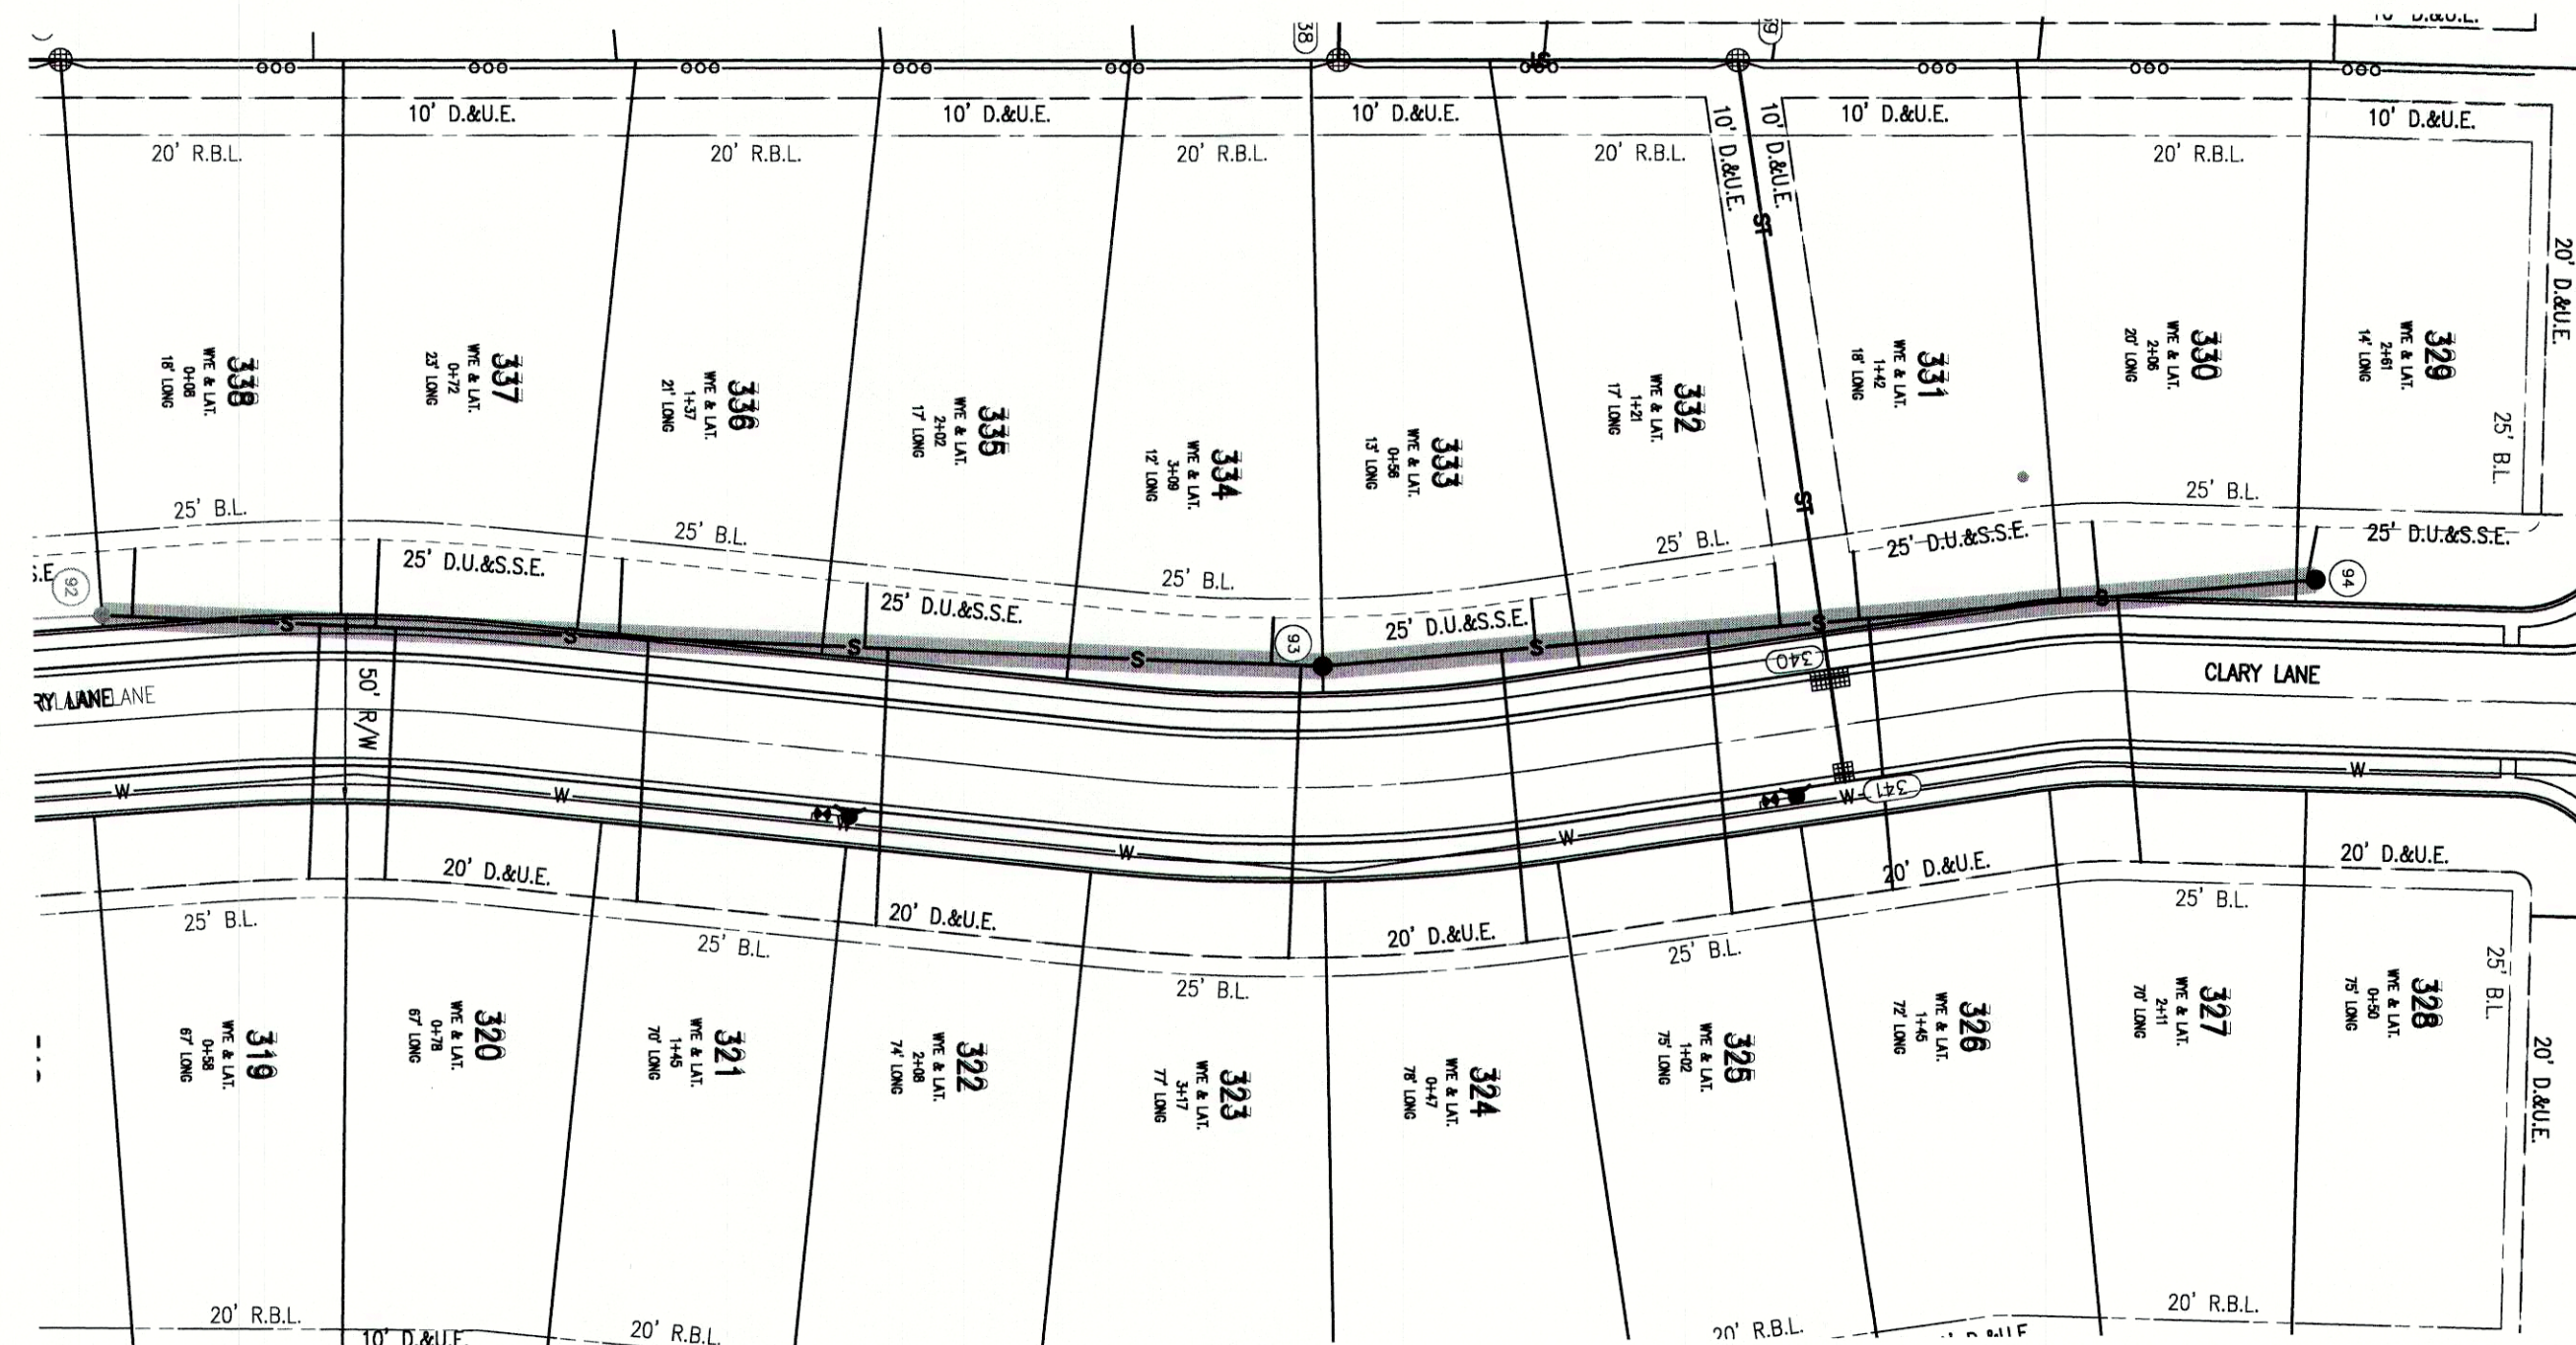

LEGEND:			
EXISTING			PROPOSED
_____		RIGHT-OF-WAY LINE	_____
_____		EASEMENT LINE	_____
_____		SETBACK LINE	_____
_____		CENTERLINE	_____
— o o o —		SWALE / FLOWLINE	— o o o —
- - - - -		CURB UNDERDRAIN	_____
— S —		SANITARY SEWER	— S —
— ST —		STORM SEWER	— ST —
— ST —		STORM CULVERT	— ST —
— W —		WATER MAIN	— W —
⊙		SANITARY MANHOLE	● (XXX)
⊙		STORM MANHOLE	● (XXX)
⊙		STORM INLET	⊙ (XXX)
⊙		STORM DRAIN SECTION	⊙ (XXX)
⊙		FIRE HYDRANT	⊙
—		PROFILED PIPELINE	— S —
EX		— EXISTING	
INV		— INVERT ELEVATION	
MH		— MANHOLE	
PVC		— POLYVINYL CHLORIDE PIPE	
TC		— TOP OF CASTING GRADE	

BENCHMARK INFORMATION:

ORIGINATING BENCHMARK: INDOT 48-G-0055
A BRONZE PLATE IN THE NORTH END OF THE EAST
SIDEWALK OF CR 650 W BRIDGE (STR I69-15-05323, NB
39070) OVER I-69; ALSO 18 FEET SOUTH OF THE NORTH
END OF THE BRIDGE.
ELEV = 880.30 (NGVD 29)
ELEV = 879.87 (NAVD 88)

TBM #1
SOUTHWEST UPPER BONNET BOLT
50 FEET SOUTH OF CL 800 SOUTH & 15 FEET WEST OF
CL 650 WEST
ELEV = 870.36 (NAVD 88)

TBM #2
SOUTHWEST UPPER BONNET BOLT
670 FEET SOUTH OF CL 800 SOUTH & 15 FEET WEST C
CL 650 WEST
ELEV = 866.74 (NAVD 88)

TBM #3
SOUTHWEST UPPER BONNET BOLT
1665 FEET SOUTH OF CL 800 SOUTH & 17 FEET WEST
CL 650 WEST
ELEV = 866.25 (NAVD 88)


TBM #4
SOUTHWEST UPPER BONNET BOLT
1290 FEET NORTH OF CL FALL CREEK DRIVE & 17 FEET
WEST OF CL 650 WEST
ELEV = 864.08 (NAVD 88)

 GRANULAR BACKFILL
 - - - - - EXISTING GRADE
 ————— PROPOSED GRADE

SANITARY PROFILE

VERTICAL SCALE: 1" = 5'
HORIZONTAL SCALE: 1" = 50'

PVC GRAVITY SEWER PIPE AND FITTINGS MUST, AT A MINIMUM, BE INSTALLED IN ACCORDANCE WITH THE DIRECTIONS CONTAINED IN ASTM D 2321 AND FOLLOW CURRENT FCRWD STANDARDS.

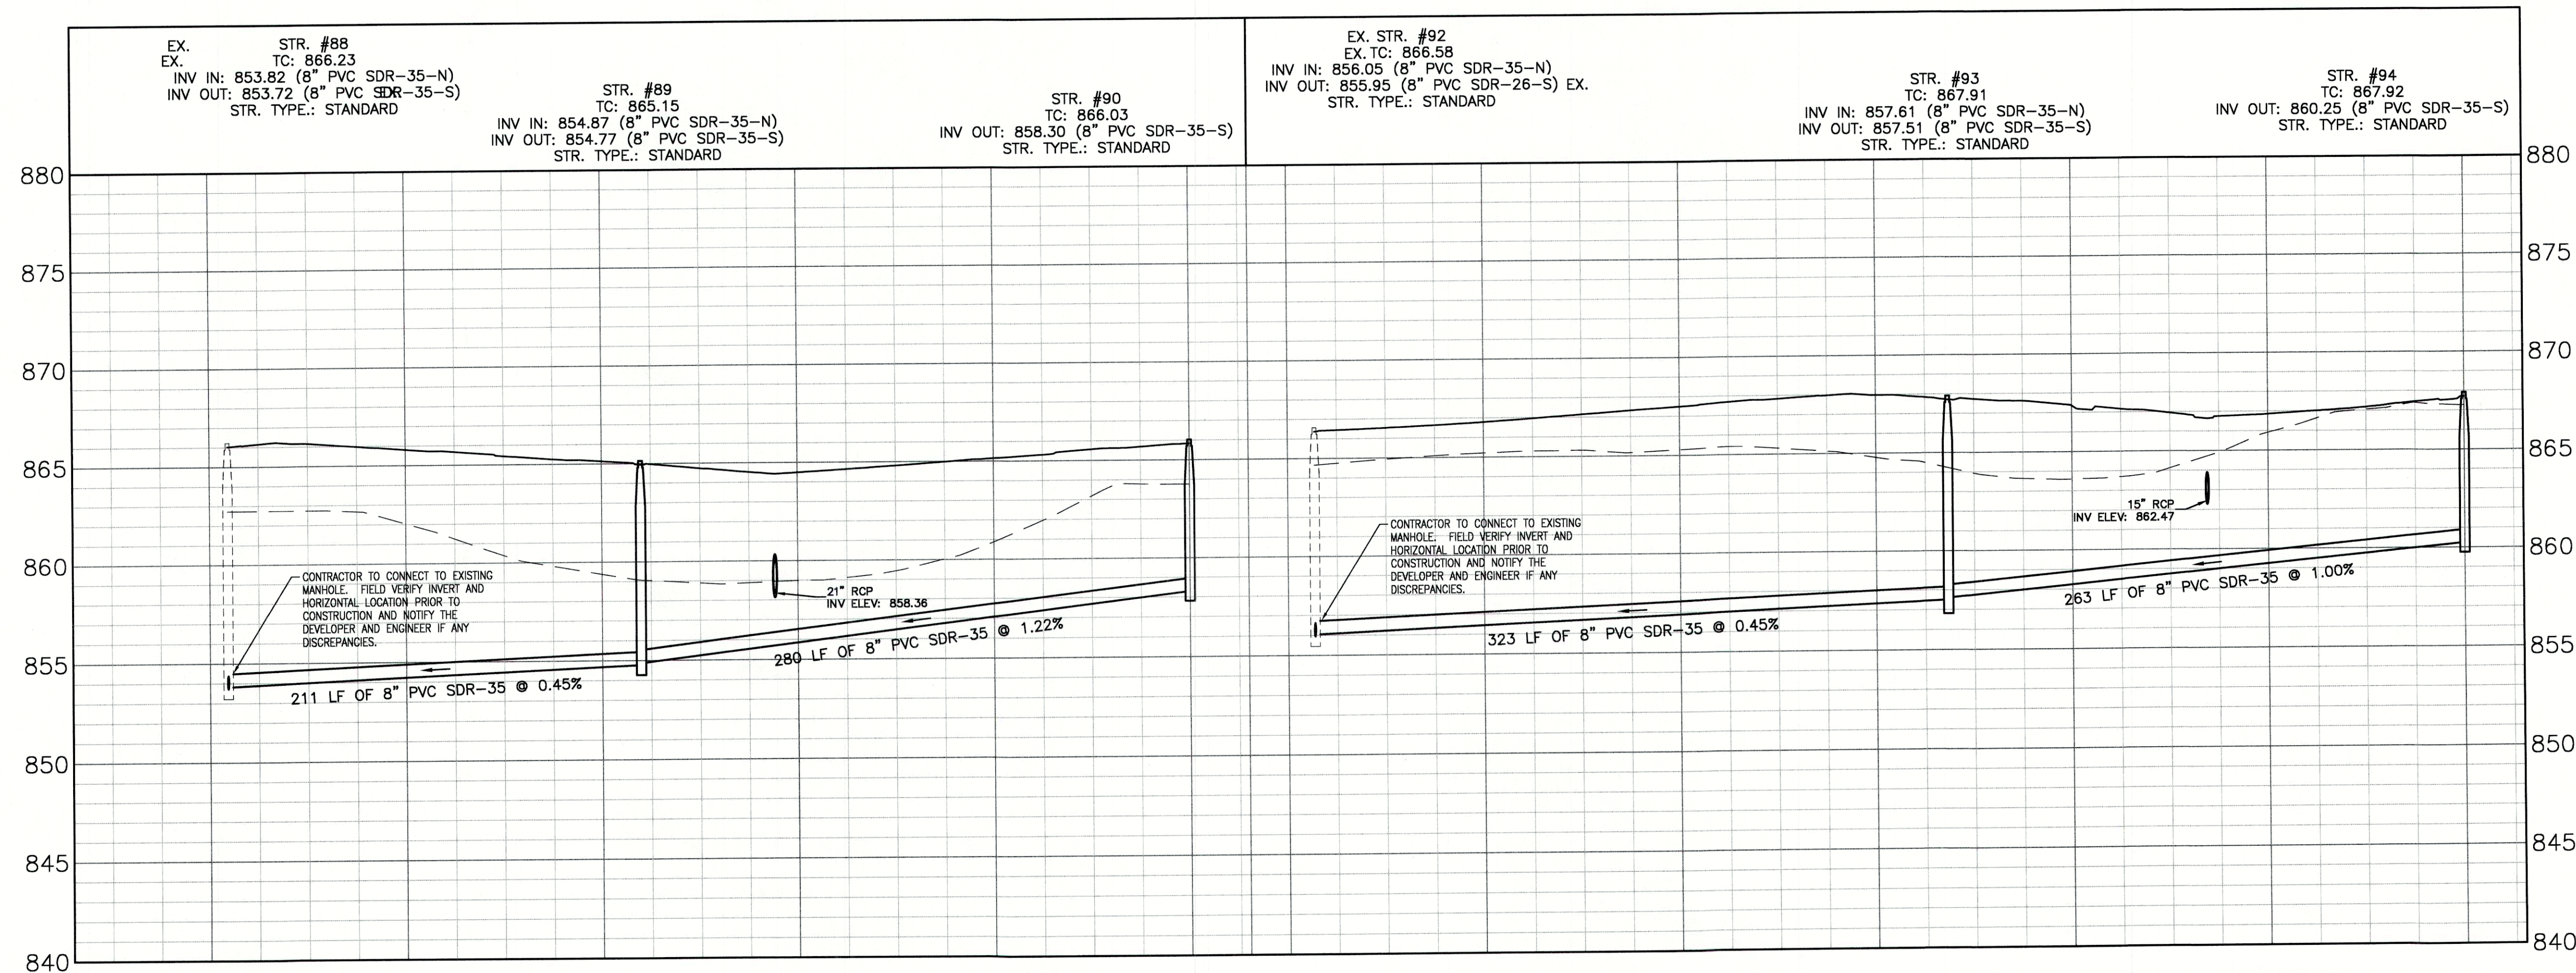[illegible]

MAPLE TRAILS SECTION 6 INGALLS, INDIANA SANITARY SEWER PLAN & PROFILE

Kristopher K. Eichhorn

DRAWN BY TD/GM	JOB NUMBER 2017-095-E
CHECKED BY KE	
DATE SEPTEMBER 17, 2021	
SCALE AS SHOWN	
SHEET	

C4.2

SANITARY SEWER PLAN & PROFILE