




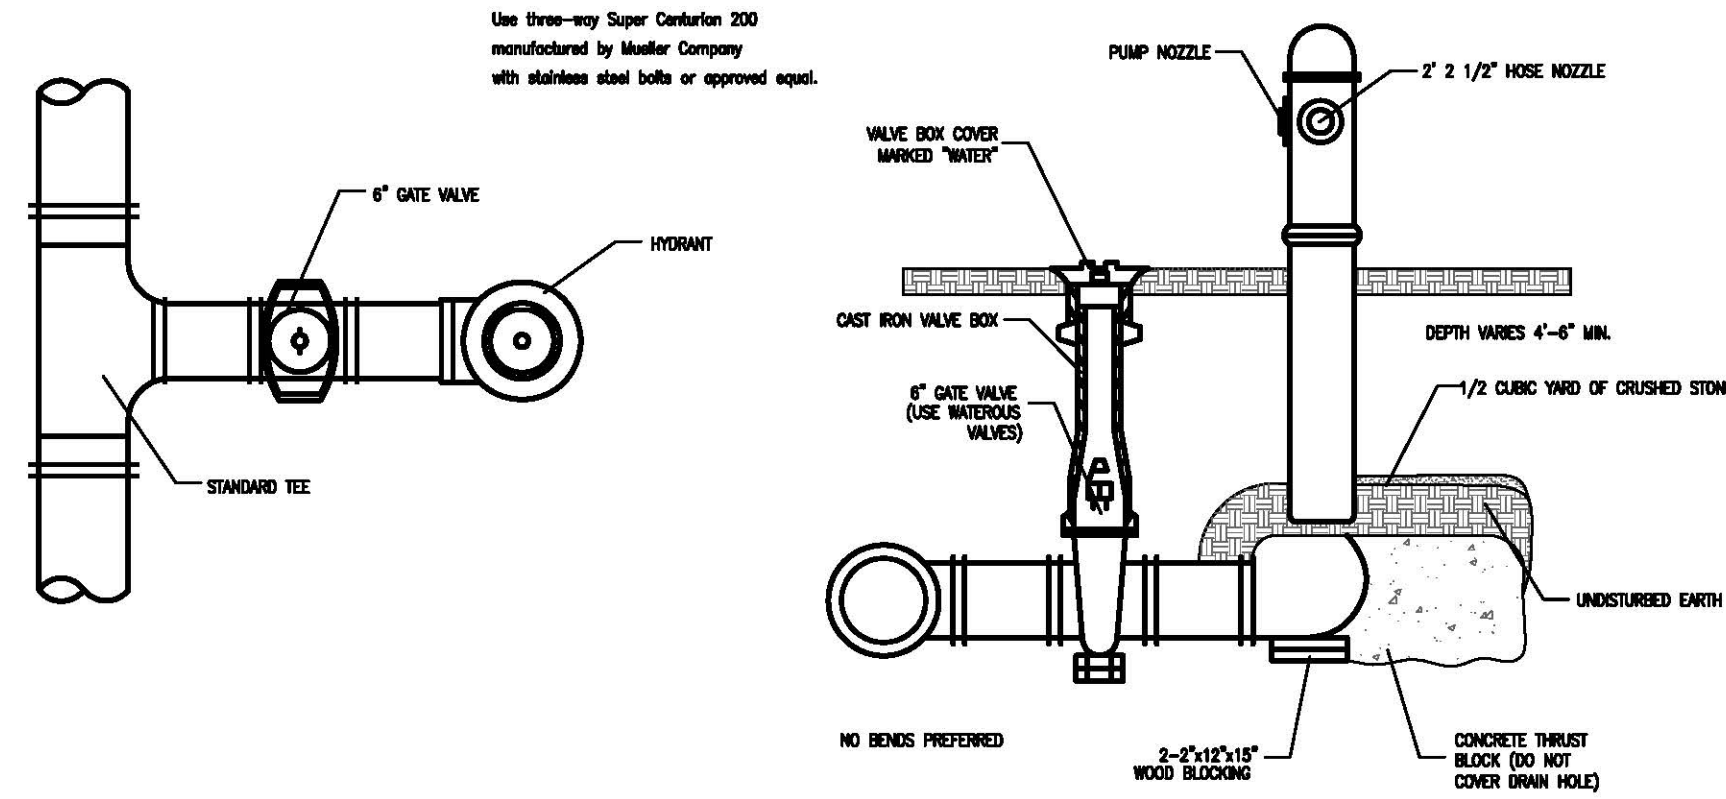


FIRE HYDRANT ASSEMBLY DETAIL
NOT TO SCALE

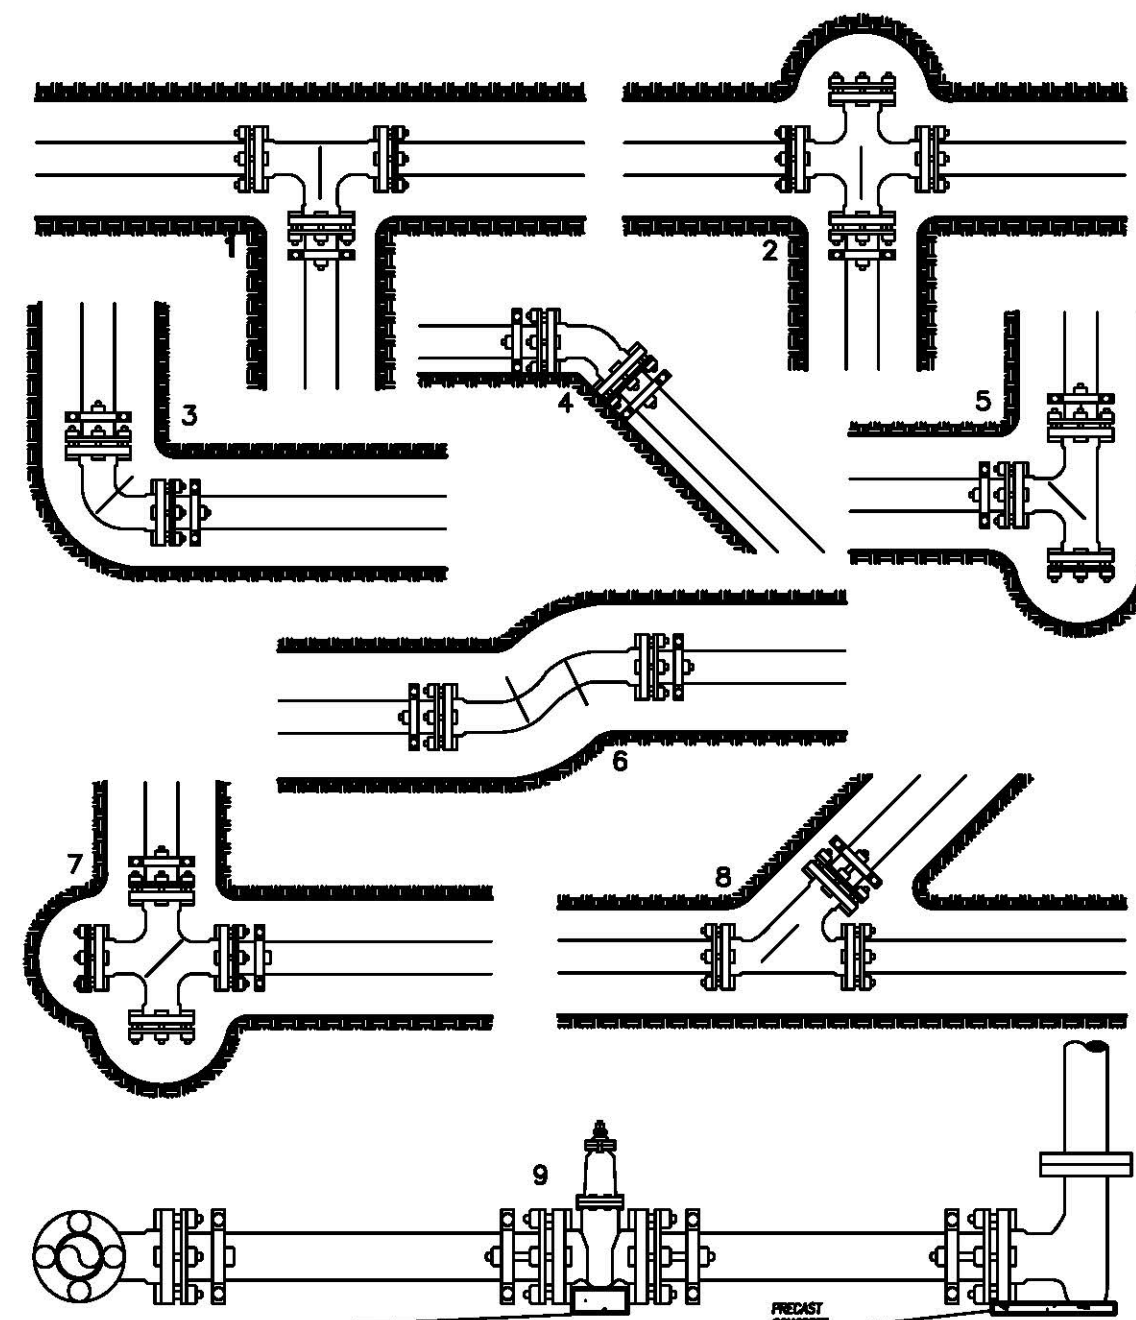

RESTRAINING JOINT DETAILS
NOT TO SCALE

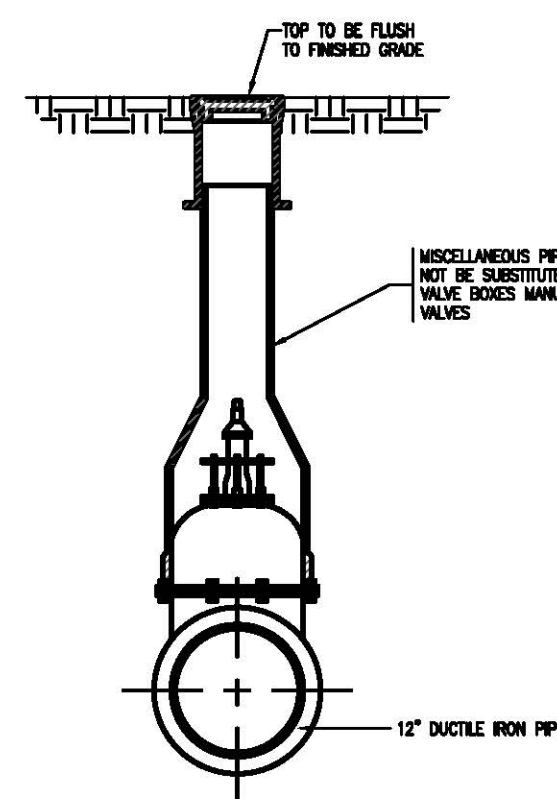


VALVE BOX SECTION
NOT TO SCALE

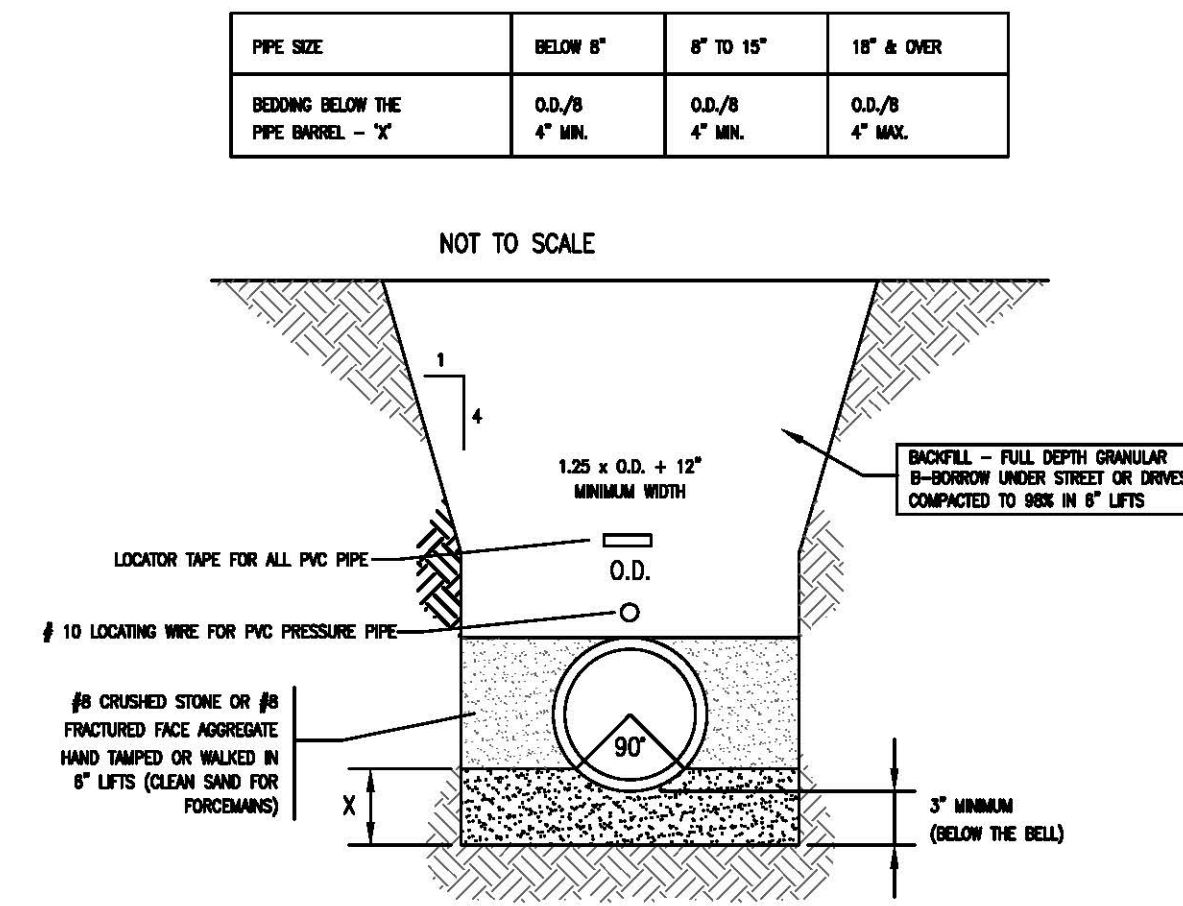

NOTE:
ALL PVC GRAVITY PIPING SHOWN ON PLANS
SHALL BE BACKFILLED WITH #8 STONE
MATERIAL TO 12" ABOVE BOTTOM OF PIPE.
(USE CLEAN SAND FOR PVC FORCE MAINS)



TYPICAL TRENCH AND
PIPE BEDDING DETAIL
NOT TO SCALE

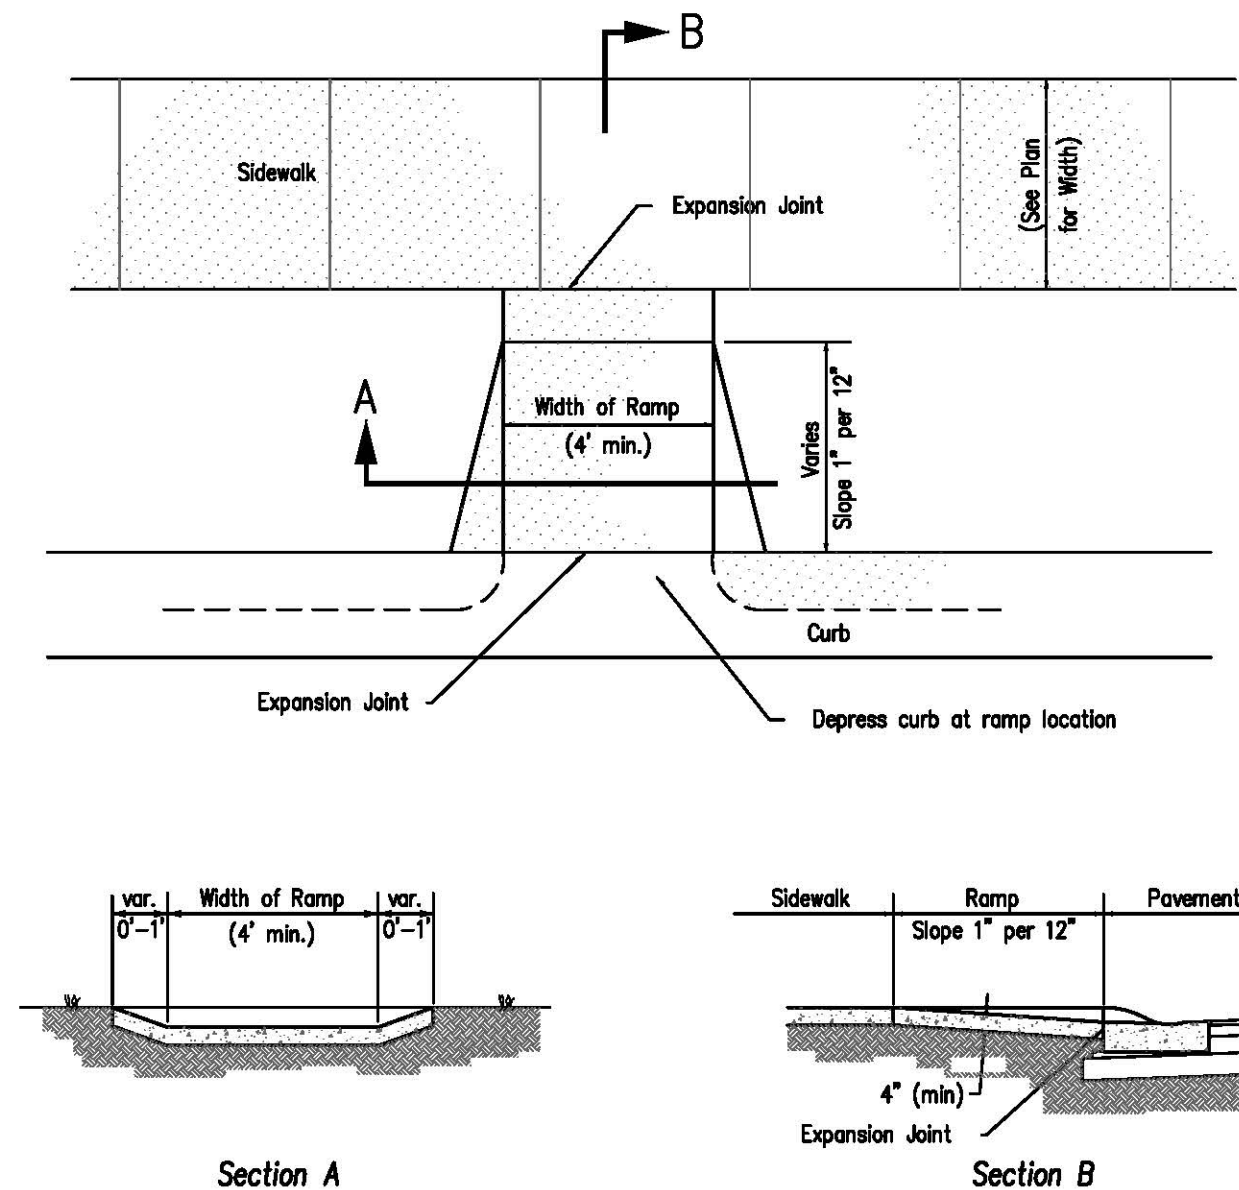


Section A

Section B

Handicap Ramp Detail
nbs

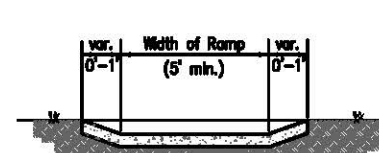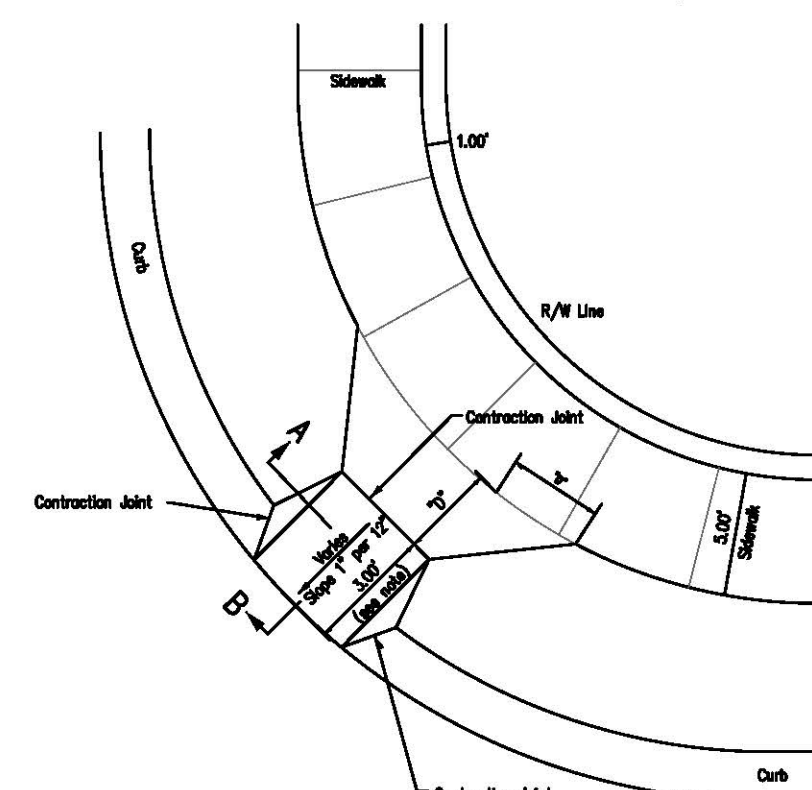


Section A

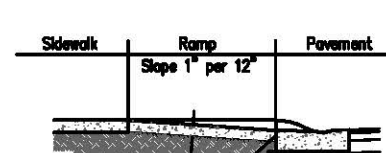


Section B

Handicap Ramp Detail
nbs

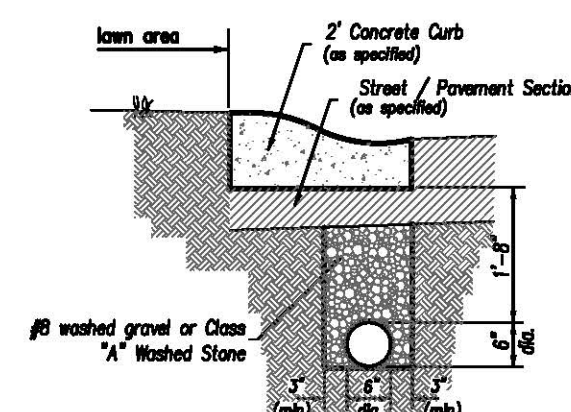


Installation of underdrain shall conform to section 773 of the Indiana Department of Transportation Standard Specifications (latest edition).
Underdrains shall be installed only after final grading and compaction of the subgrade is complete.
If Line Stabilization is applied to the subgrade, the underdrain shall be installed after the stabilization is complete.
Any combination of underdrain backfill shall be removed prior to the installation of the pavement's aggregate base.
Underdrains shall not be installed until utilities located beneath the underdrain are installed (i.e. watermain, water service (if installed as a part of the watermain), storm sewers, sanitary sewers and laterals, etc.)


Pipe Underdrain

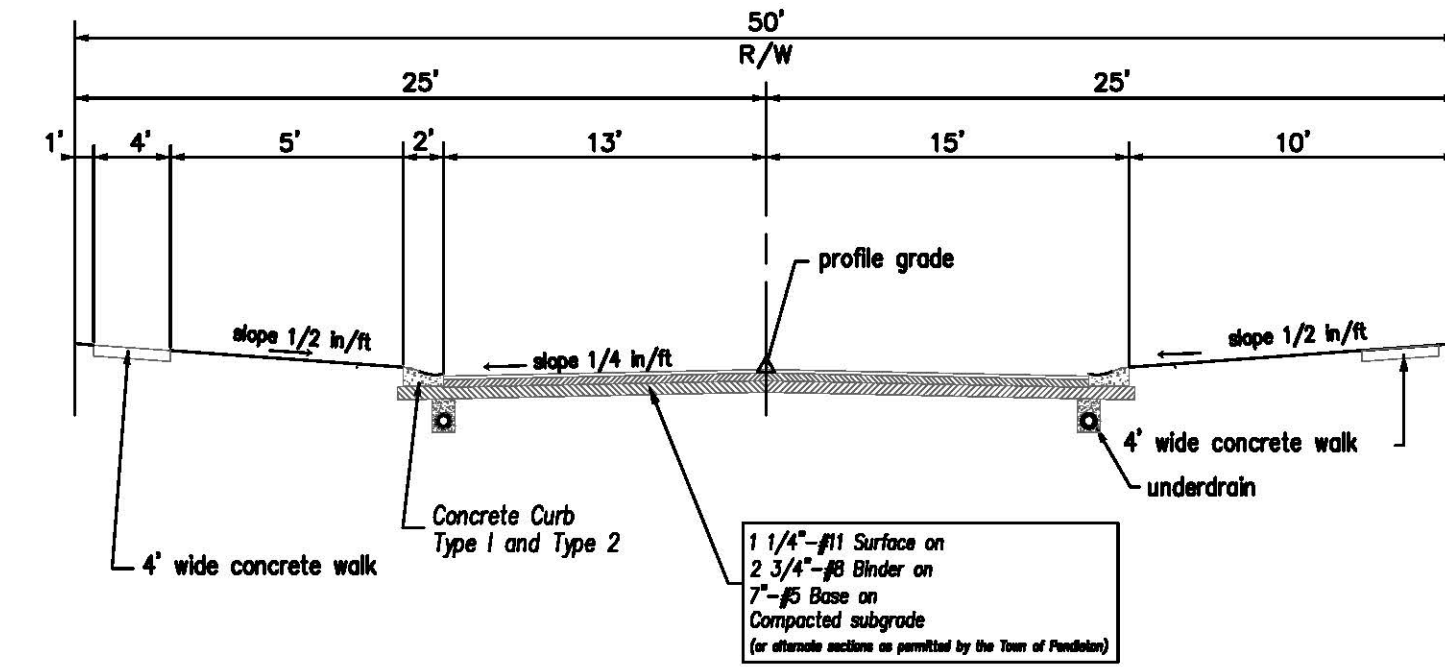


Typical Neighborhood Collector Street Section
Town of Pendleton

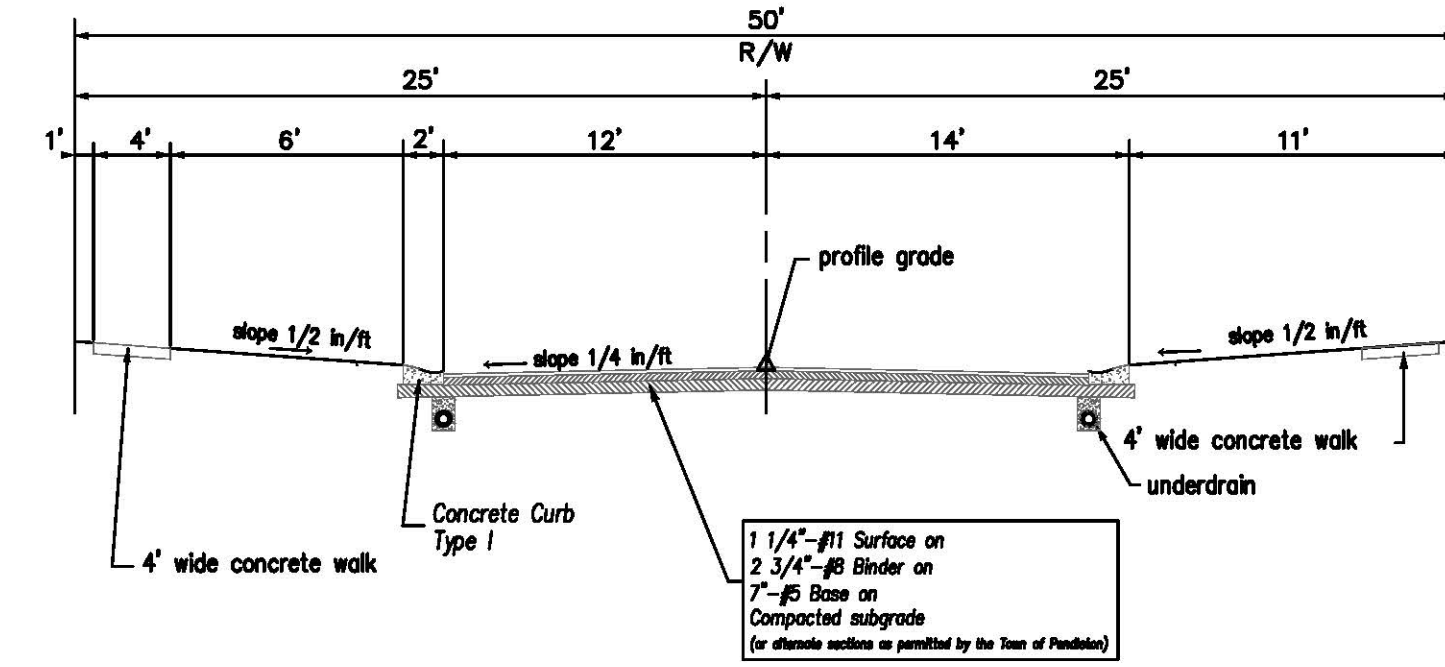


Typical Secondary Collector Street Section
Town of Pendleton

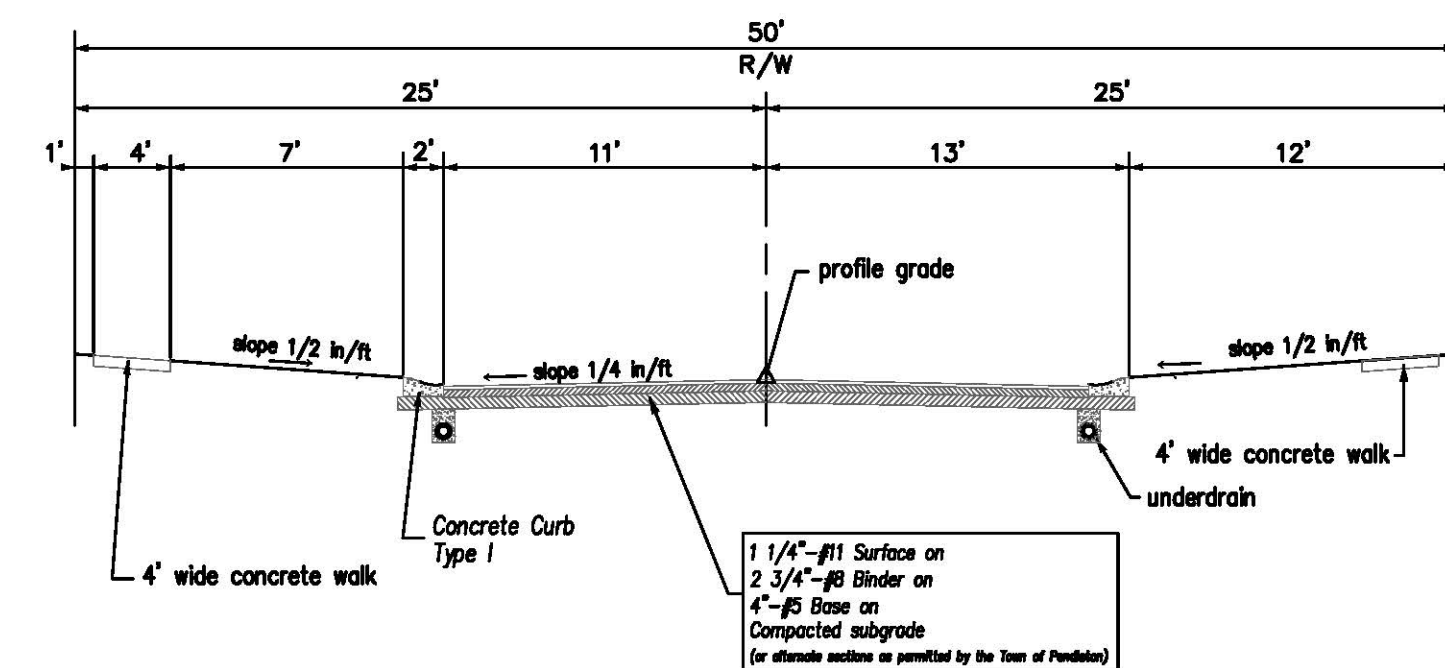


Typical Local Street Section
Town of Pendleton

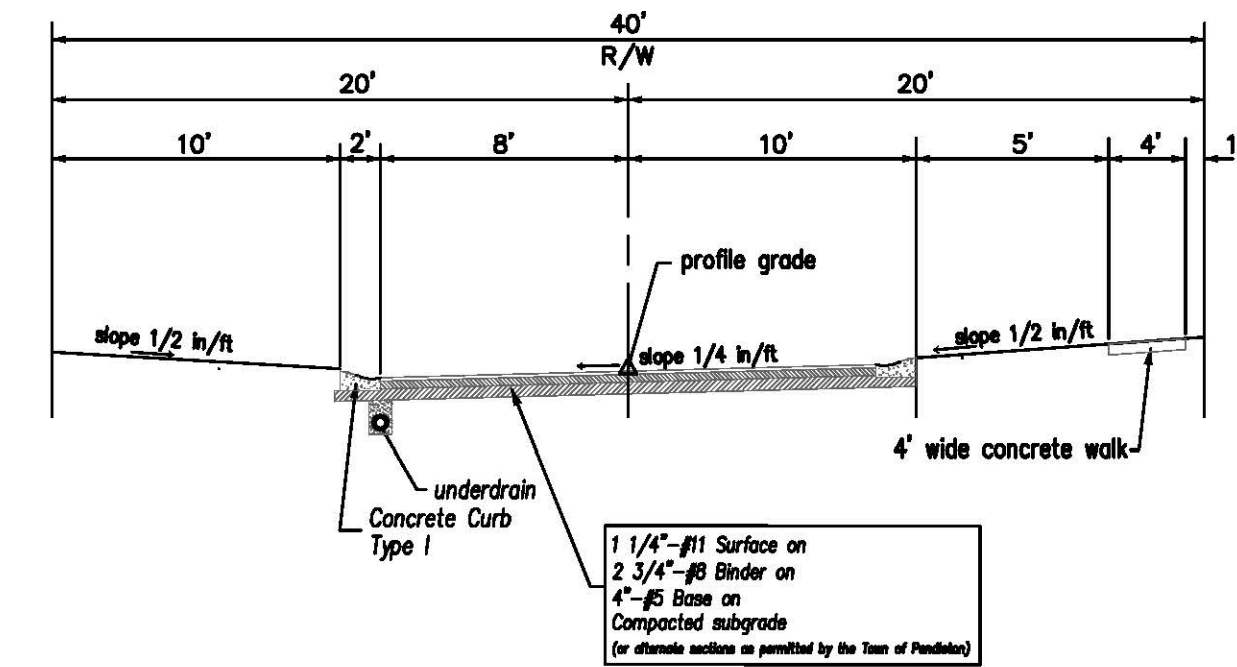


Typical Cul-de-sac Street Section
Town of Pendleton

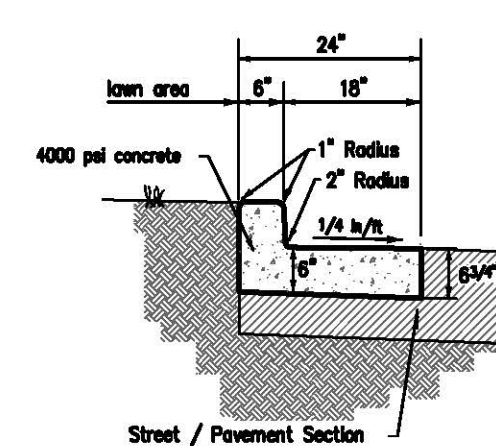

Combined Curb & Gutter
Type II

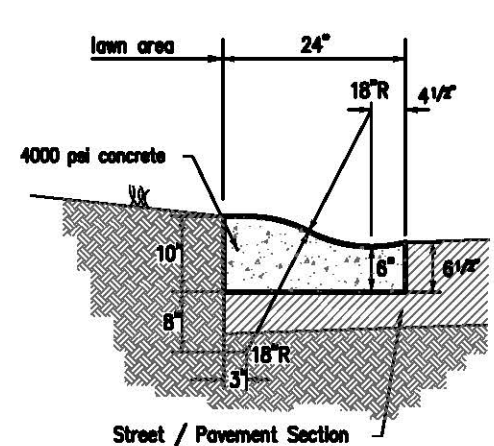

Combined Curb & Gutter
Type I

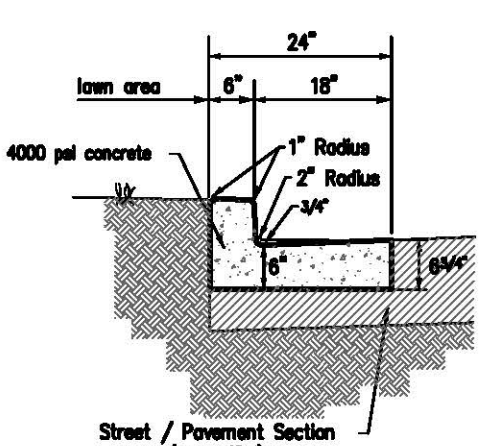

Combined Curb & Gutter
Type II

North

Scale: none

Pendleton Land Company, LLC
9449 Priority Way West Drive
Suite 120
Indianapolis, Indiana 46240
Tel: 317.765.2083 Fax: 317.765.2088
email: pendletonland@comcast.net

MapleWood at Huntzinger Farms
Section 2
Town of Pendleton, Madison County, Indiana

Standard Detail
Street / Waterline

Revision
Revised per comments of client, remove pond, modify storm system (Sta Series 100-300).

Date
6/12/2006

Sheet Title

Sheet No.
17
of 20 Sheets