
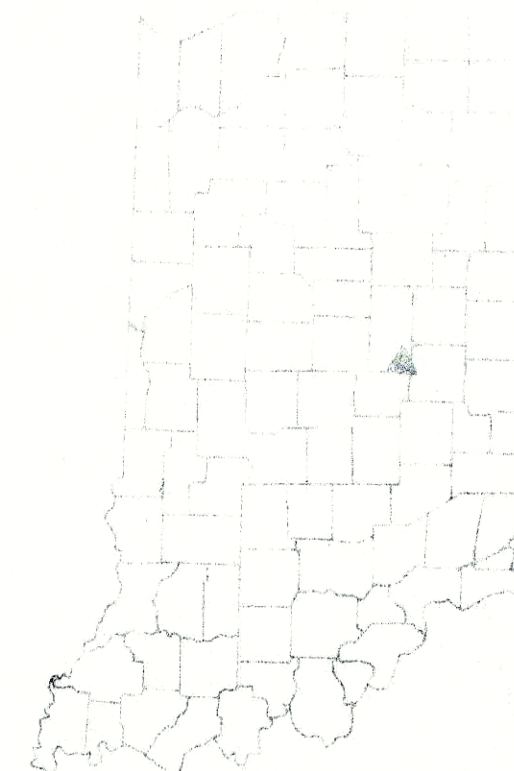


MARKLEVILLE, INDIANA

WASTEWATER FACILITIES

DIVISION A - COLLECTION SYSTEM

DIVISION B - INTERCEPTOR SYSTEM

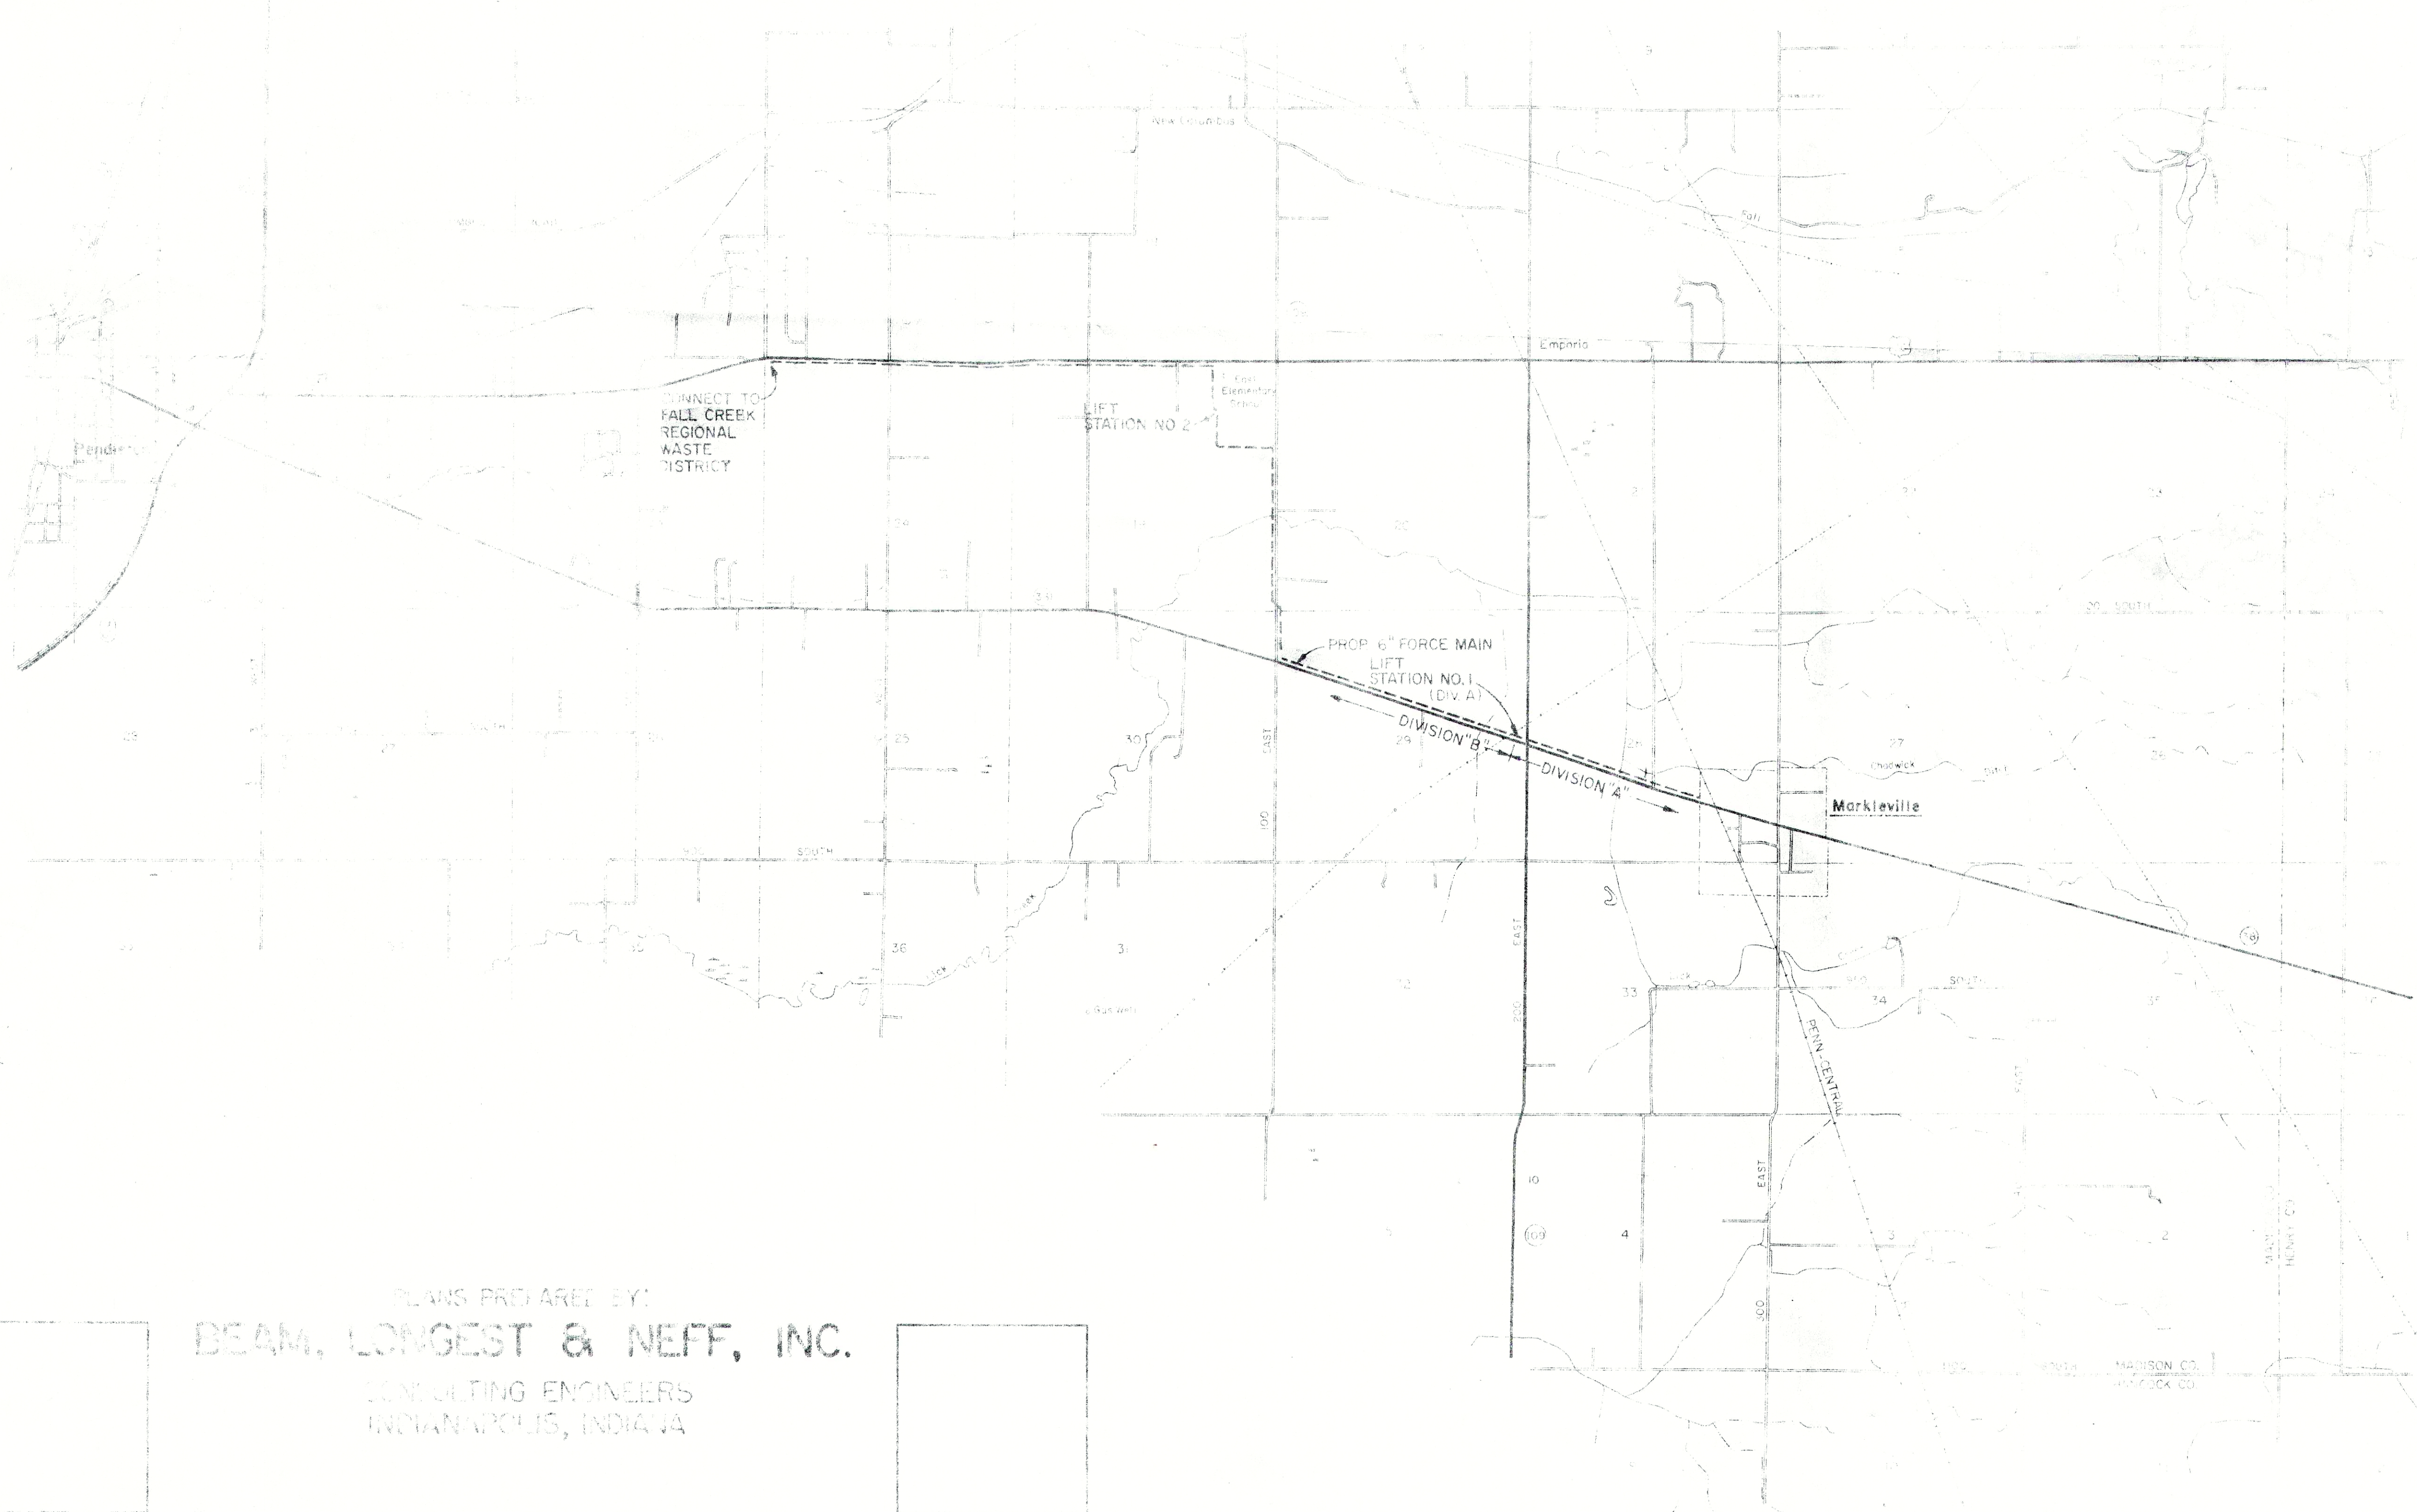

LOCATION OF SECTION INDICATED=▲

PLANS PROVIDED BY:
BEAM, LONGEST & NEFF, INC.

CONSULTING ENGINEERS
 INDIANAPOLIS, INDIANA

APPROVED BY BOARD OF TRUSTEES

Sally Austin

TOWN CLERK, PRESIDENT, WBS, SALLY AUSTIN

Doris A. Neal

TOWNSHIP MEMBER, MR. DAVIS A. NEAL

Everett H. Heston

TOWNSHIP MEMBER, MR. EVERETT HESTON

Jennie C. Huntington

TOWNSHIP MEMBER, MRS. JENNIE C. HUNTINGTON

RECORD DRAWING

12-23-61