


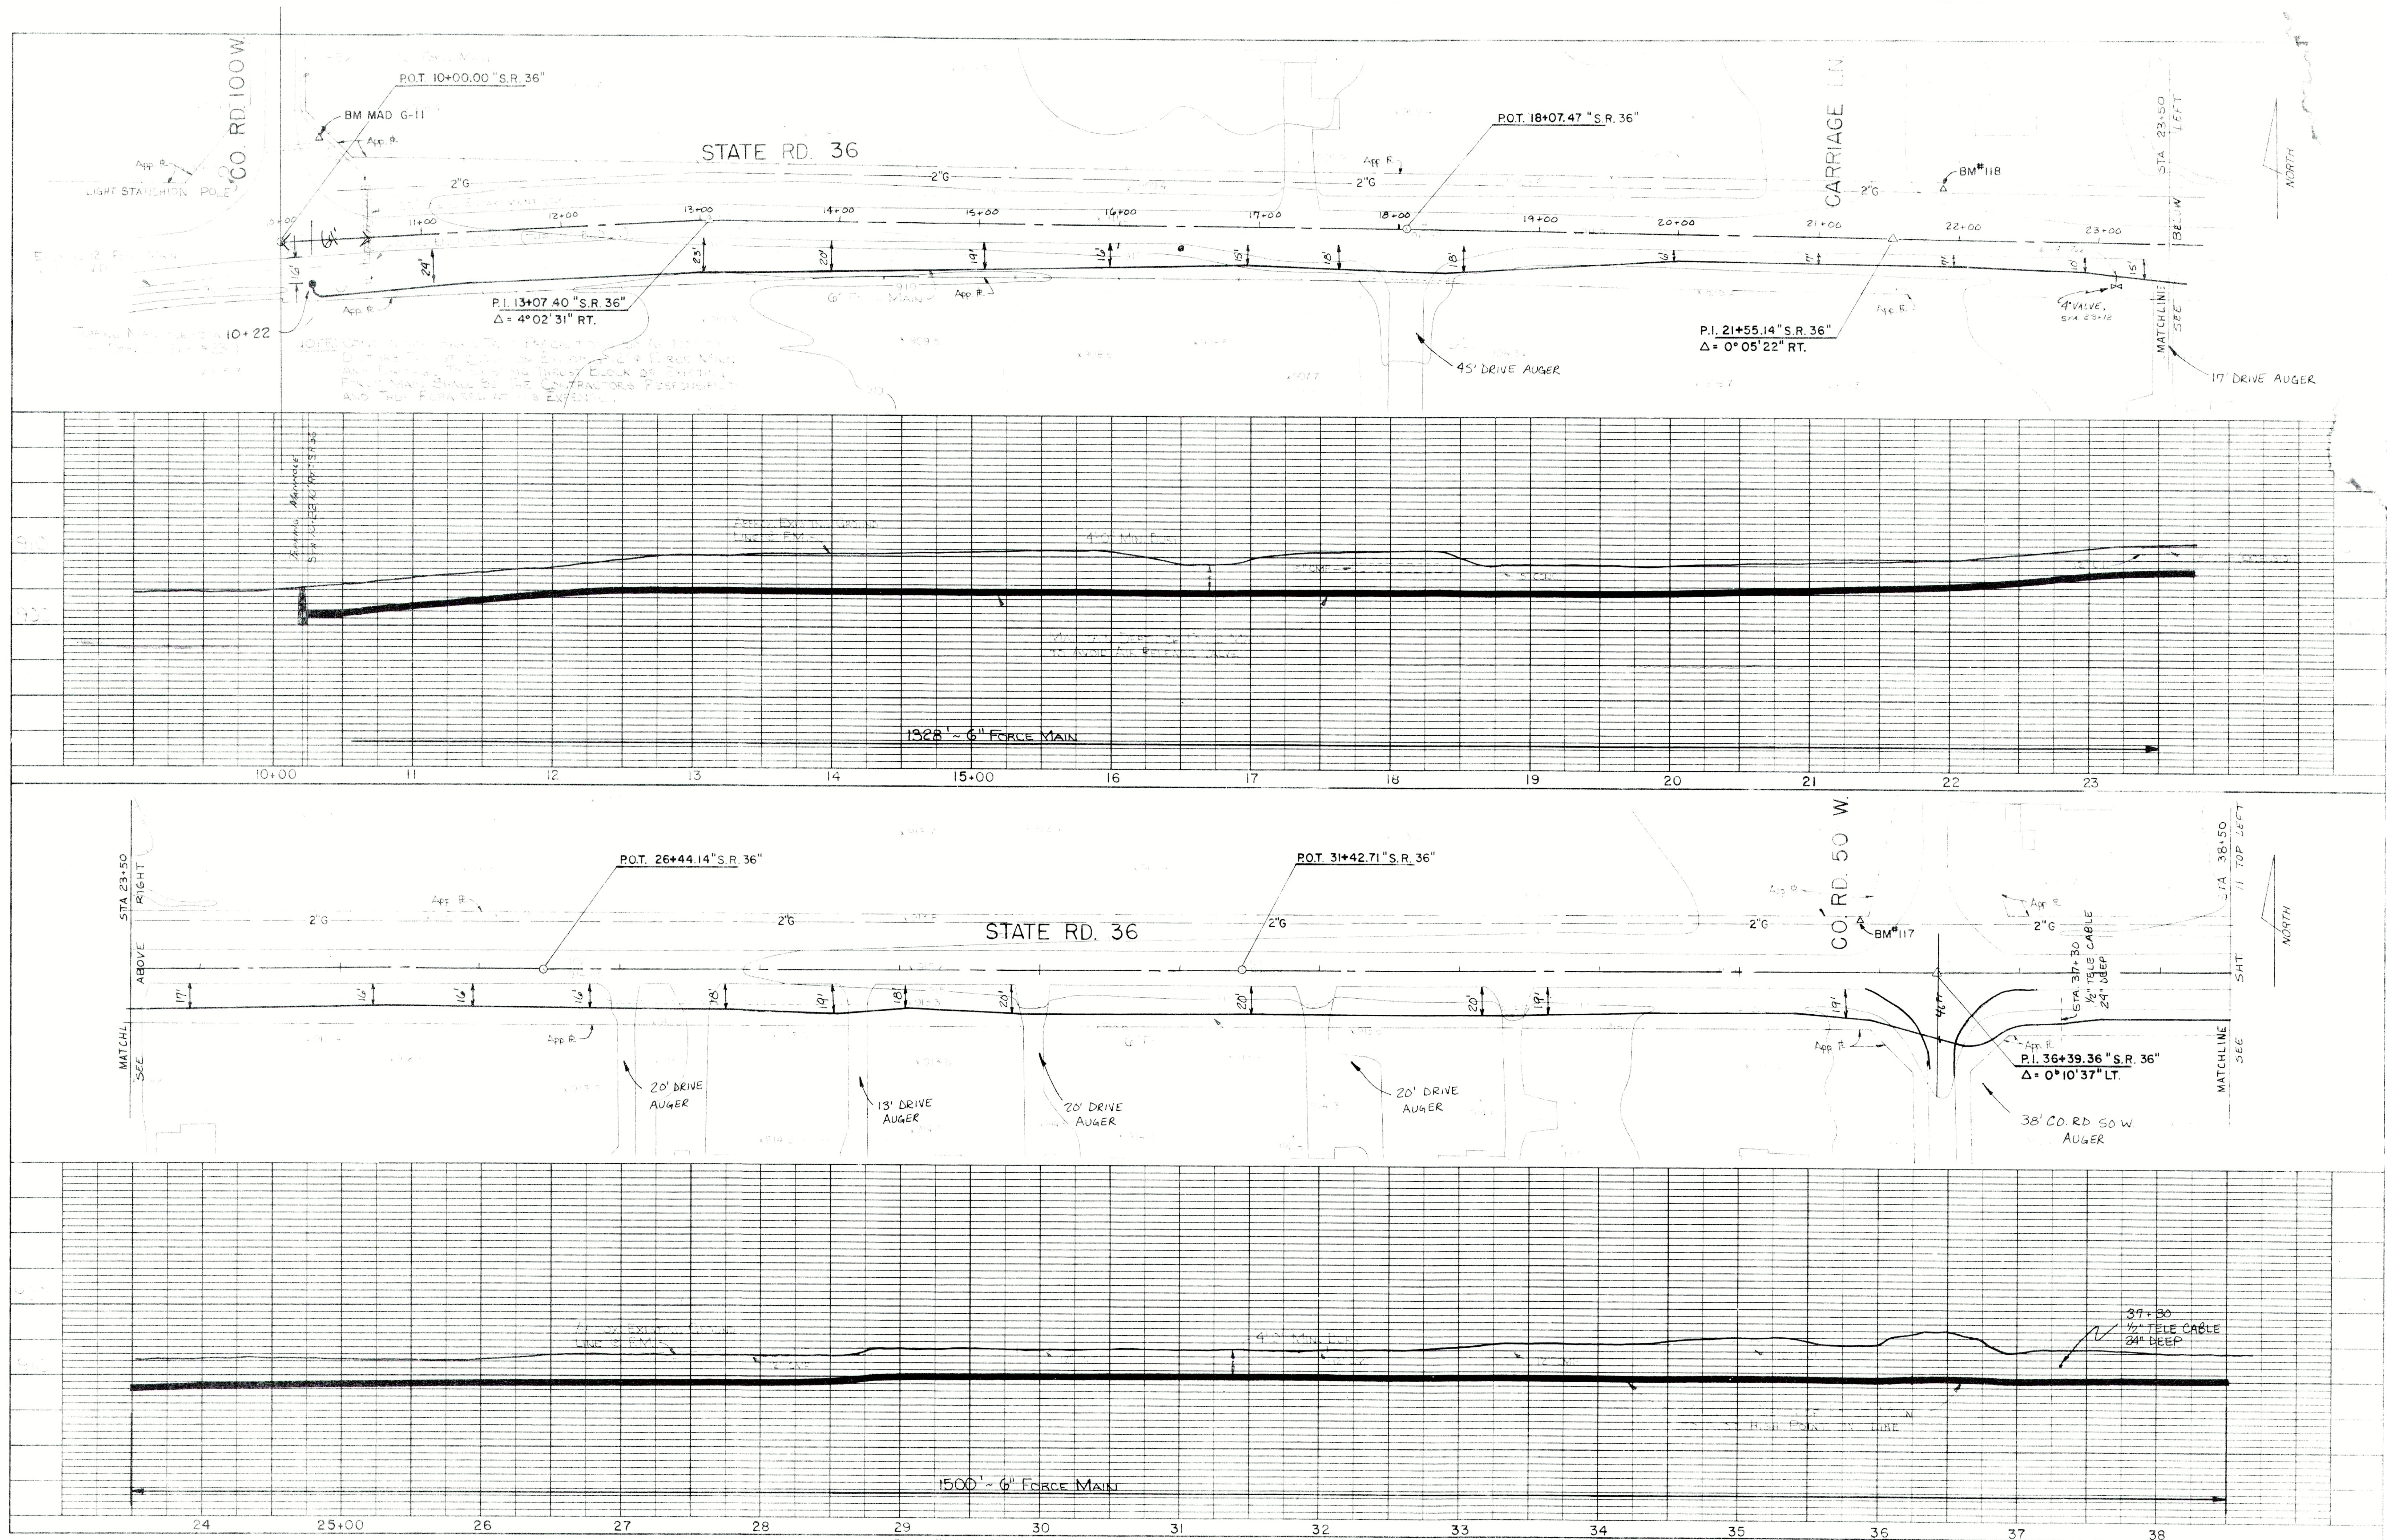

State Highway 10 - 10+00 - 23+50 - State Road 36 - Elev. 107.87
 BM G-11 - Tablot at Northwest Corner of State Road 36
 and County Road 100 West

BM 118 - Station 36+39.36 - State Road 36 - Elev. 112.91
 (Note: The above datum is Northwest Corner of
 State Road 36 and County Road 50 West)

BM 117 - Station 31+42.71 - State Road 36 - Elev. 112.91
 (Note: The above datum is Northwest Corner of
 State Road 36 and County Road 50 West)

RECORD DRAWING

STATE ROAD 36

MARKLEVILLE PLAN & PROFILE

BEAM, LONGEST & NEFF, INC.
 1000 N. 10th St., Markleville, Ind. 46051

10