


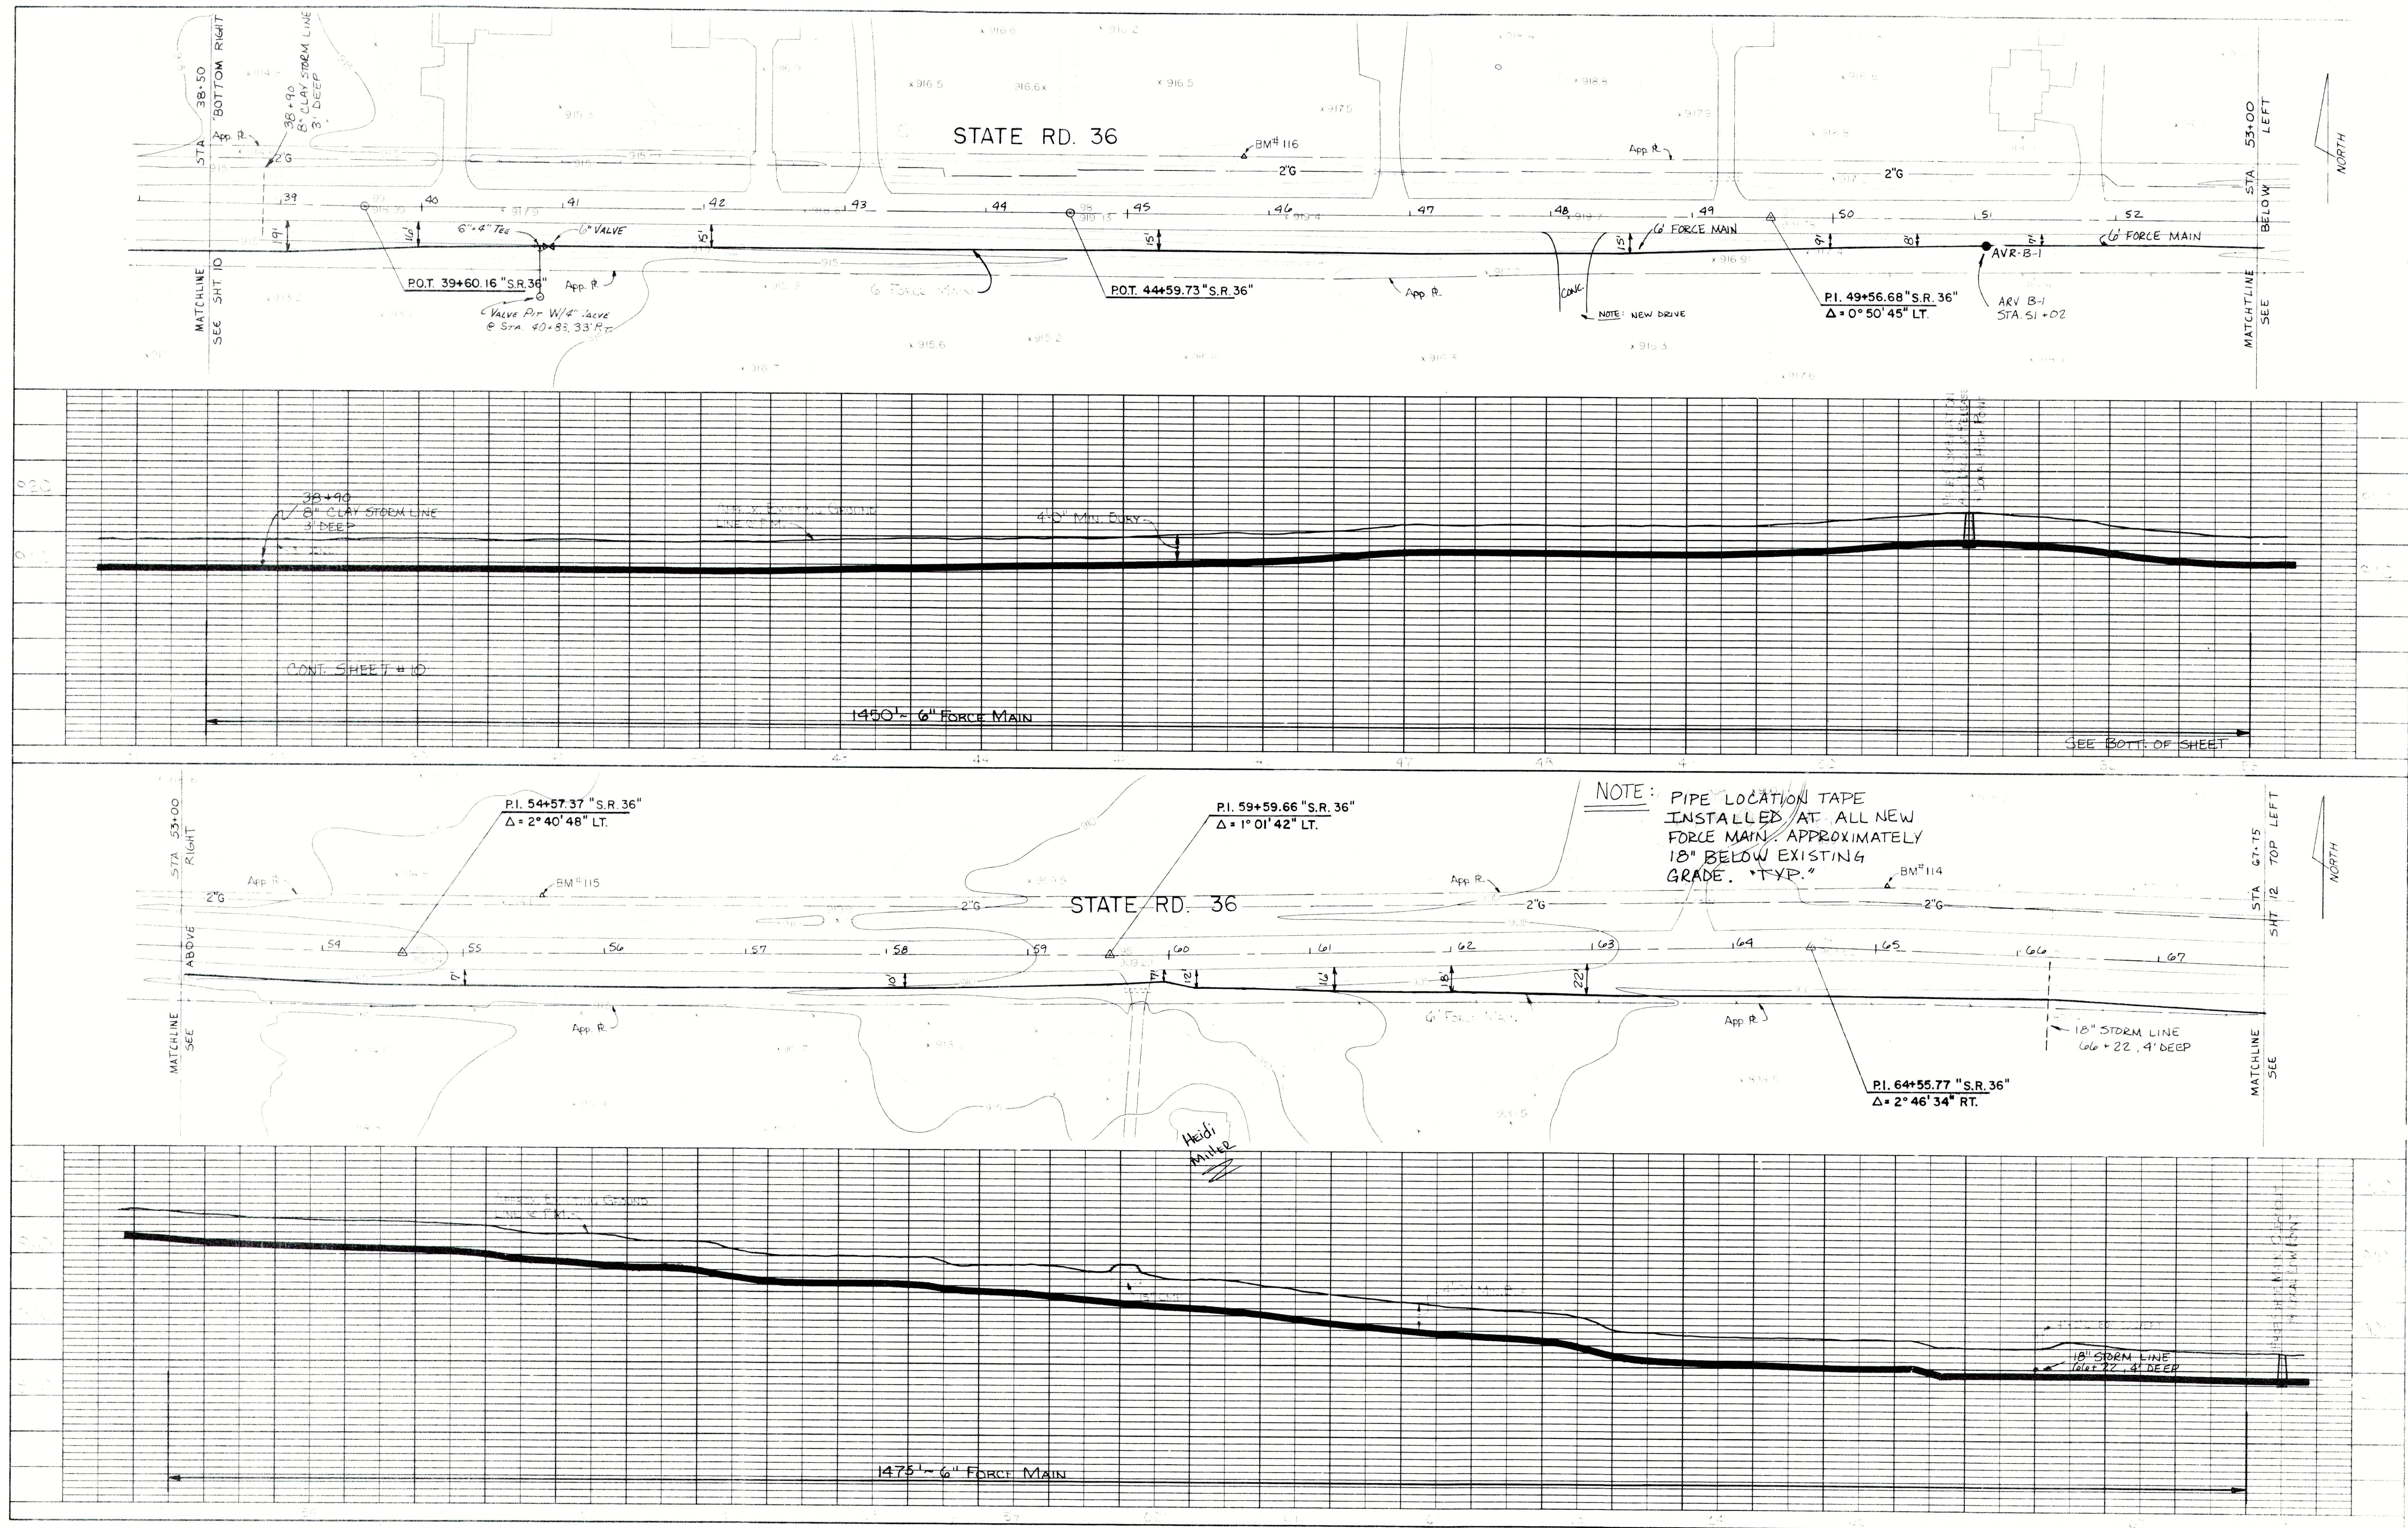

BM 116 45+77.5, 39.5' LT. State Road 36 - Elev. 917.80
 Mine Spike in Power Pole on North Side of
 State Road 36 West of Millbrook No. 240A

BM 115 54+57.37, 37.5' LT. State Road 36 - Elev. 914.27
 Mine Spike in Power Pole on North Side of
 State Road 36 West of Millbrook No. 240A

BM 114 64+55.77, 34.5' RT. State Road 36 - Elev. 914.27
 Mine Spike in Power Pole on North Side of
 State Road 36 West of Millbrook No. 240A

NOTE: Construction will end when the road is closed. All
 work shall be done in accordance with the plans and
 specifications. The contractor shall be responsible for
 obtaining all necessary permits and approvals. MAY
 1994

RECORD DRAWING

STATE ROAD 36			
MARKLEVILLE PLAN & PROFILE			
DATE: 11-10-94	BY: BEAM, LONGEST & NEFF, INC.	11	
EXT: 11-10-94	CONSULTING ENGINEER		
INDIANAPOLIS, IN 46204		DIVISION B	