


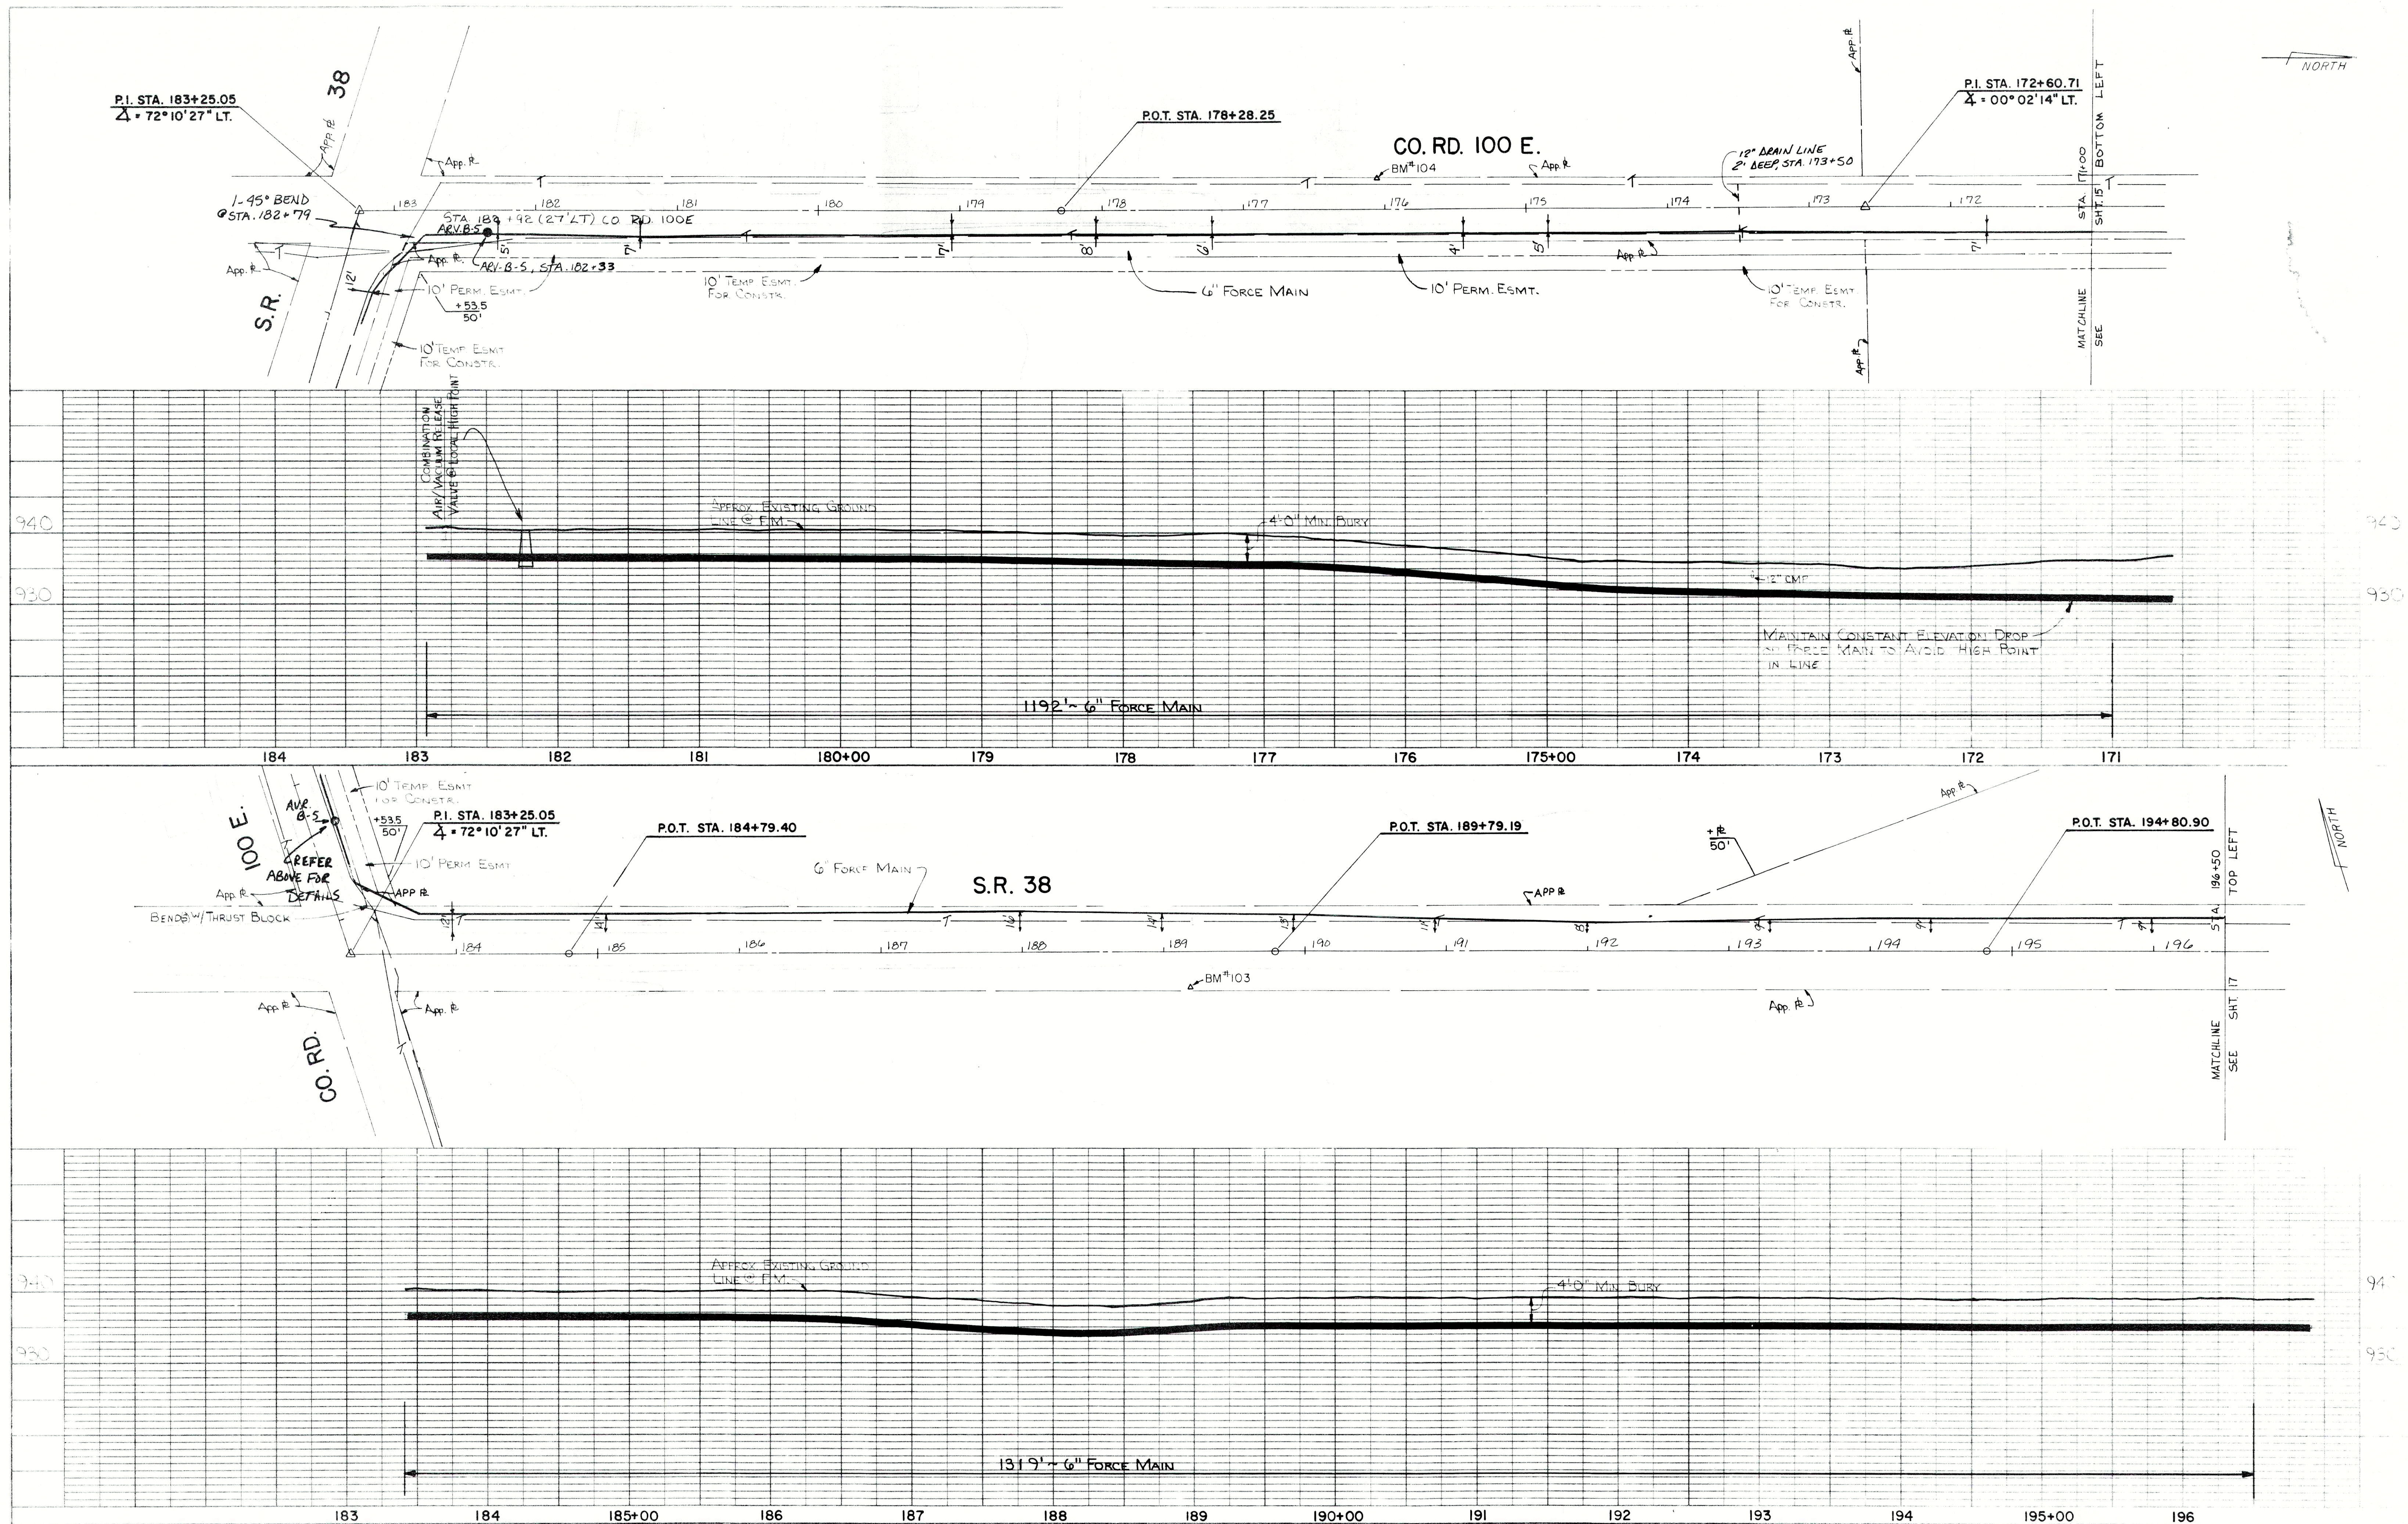

NOTE: Contractor will encounter unmarked utilities (i.e.: Gas, Water, Telephone and Electric Mains and Services for each building). Utilities not encountered MAY be subject to a credit to the Owner.

BM 104 176+10, 21.5' Rt. County Road 100 East - Elev. 937.77
 Mine Spike in Power Pole on West Side of County Road 100 East at V.R. Smith Property
 BM 103 191+18, 28' Rt. State Road 38 - Elev. 939.85
 Mine Spike in Power Pole on North Side of State Road 38, East of Flag No. 67

CO. RD. 100 E. AND S.R. 38
MARKLEVILLE PLAN & PROFILE

RECORD DRAWING