

MISCELLANEOUS ASBUILTS (MA)

<u>Index No.</u>	<u>Description</u>	<u>Status</u>
MA 1	Reformatory Road	Complete
MA 2	4425 Fall Creek Road (House 13)	Complete
MA 3	Dairy Barn	Complete
MA 4	Madison Avenue	Complete
MA 5	Colonial, Orleans, White Hall	Complete
MA 6	SR 38 and Woodrow Dr.	Complete
MA 7	US 36 (Earl Davis) - Markelville	Need Tracings
MA 8	Jim Craig Property	Complete
MA 9	SR 67 (Car Lot)	Complete
MA 10	US 36 (West of CR 150 West)	Triad needs to field locate and addresses
SA 8	EAST STREET.	Complete

FALL CREEK REGIONAL WASTE DISTRICT

DIVISION 'C'

SHEET No. 68

INDEX MA-5


KEYNOTES

- (A) MH #340
T.C. = 902.70
INV.(N) = 897.26
- (B) MH #339
T.C. = 902.18
INV.(S) = 896.57
INV.(E) = 896.06
- (C) CAPPED END
INV.(N) = 898.44

LEGEND

---	EASEMENT LIMITS	W	WATERLINE LOCATION
- - -	RIGHT-OF-WAY LIMITS	G	GAS LINE LOCATION
---	FORCE MAIN LOCATION	T	UNDERGROUND TELEPHONE
---	SANITARY SEWER LOCATION	* * *	FENCE LINE
==	STORM SEWER LOCATION	x	LIGHT POLE
SC	SANITARY SERVICE CONNECTION	-	POWER POLE

LATERAL DEPTH FROM GRADE
PLUG DISTANCE FROM MAIN

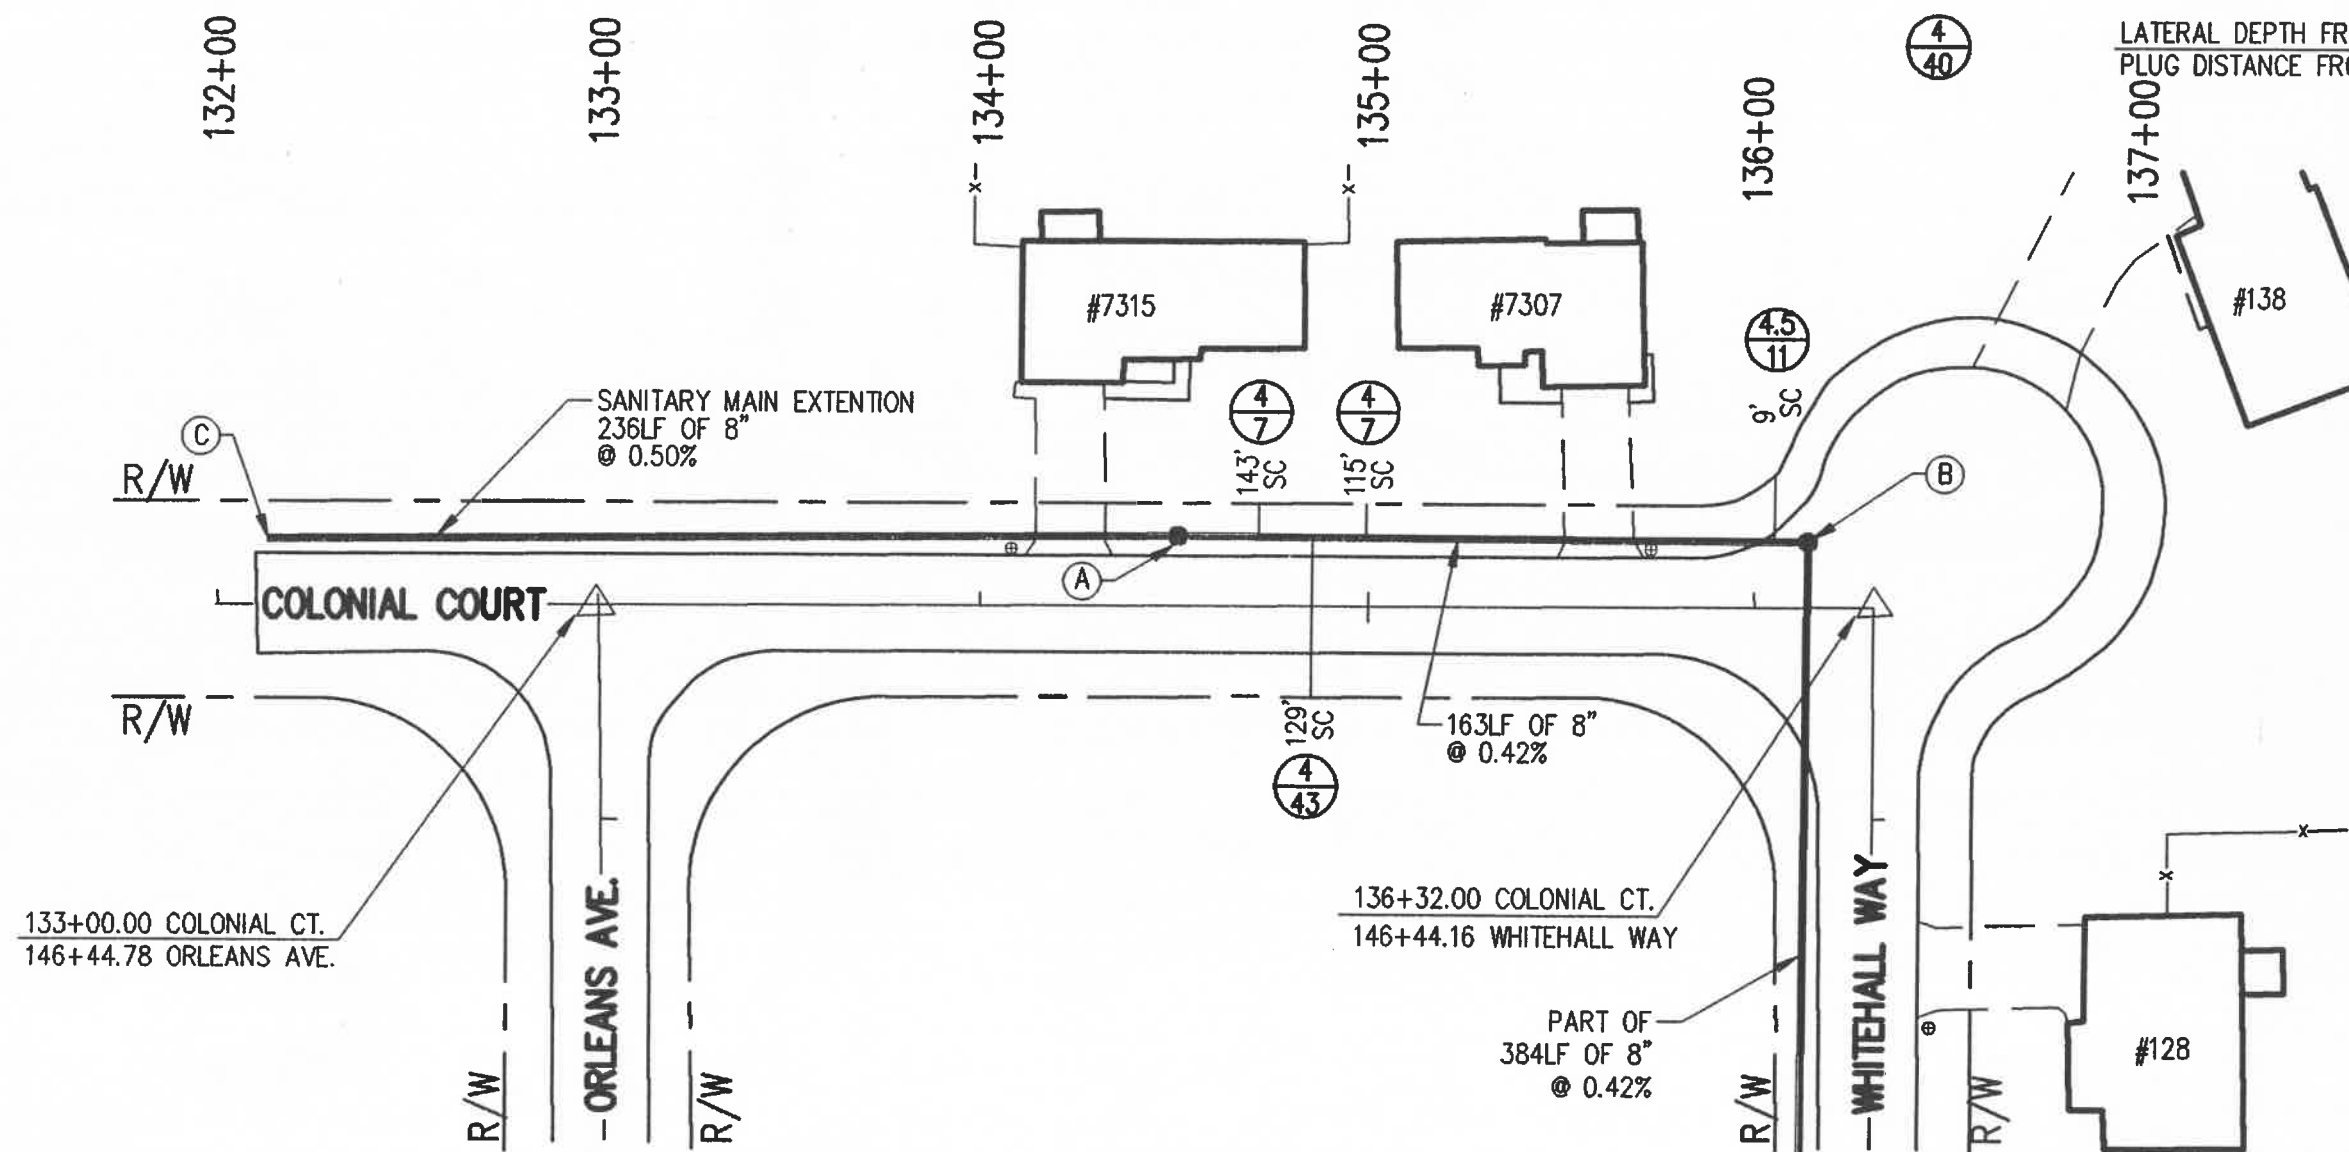

AS-BUILT INFORMATION

SCALE: 1" = 50'



**TRIAD
ASSOCIATES
INC.**

INDIANAPOLIS, INDIANA



FALL CREEK REGIONAL WASTE DISTRICT

DIVISION 'C'

SHEET No. 24

INDEX MA-6

LEGEND


---	EASEMENT LIMITS	W	WATERLINE LOCATION
- - -	RIGHT-OF-WAY LIMITS	G	GAS LINE LOCATION
---	FORCE MAIN LOCATION	T	UNDERGROUND TELEPHONE
---	SANITARY SEWER LOCATION	* * *	FENCE LINE
==	STORM SEWER LOCATION	x	LIGHT POLE
SC	SANITARY SERVICE CONNECTION	-	POWER POLE

4
40

LATERAL DEPTH FROM GRADE
PLUG DISTANCE FROM MAIN

KEYNOTES

- (A) MH #166
T.C. = 880.74
INV.(N) = 876.70
- (B) MH #165A
T.C. = 883.75
INV.(N) = 876.16
INV.(S&W) = 876.24
- (C) MH #165B
T.C. = 884.94
INV.(E) = 876.98

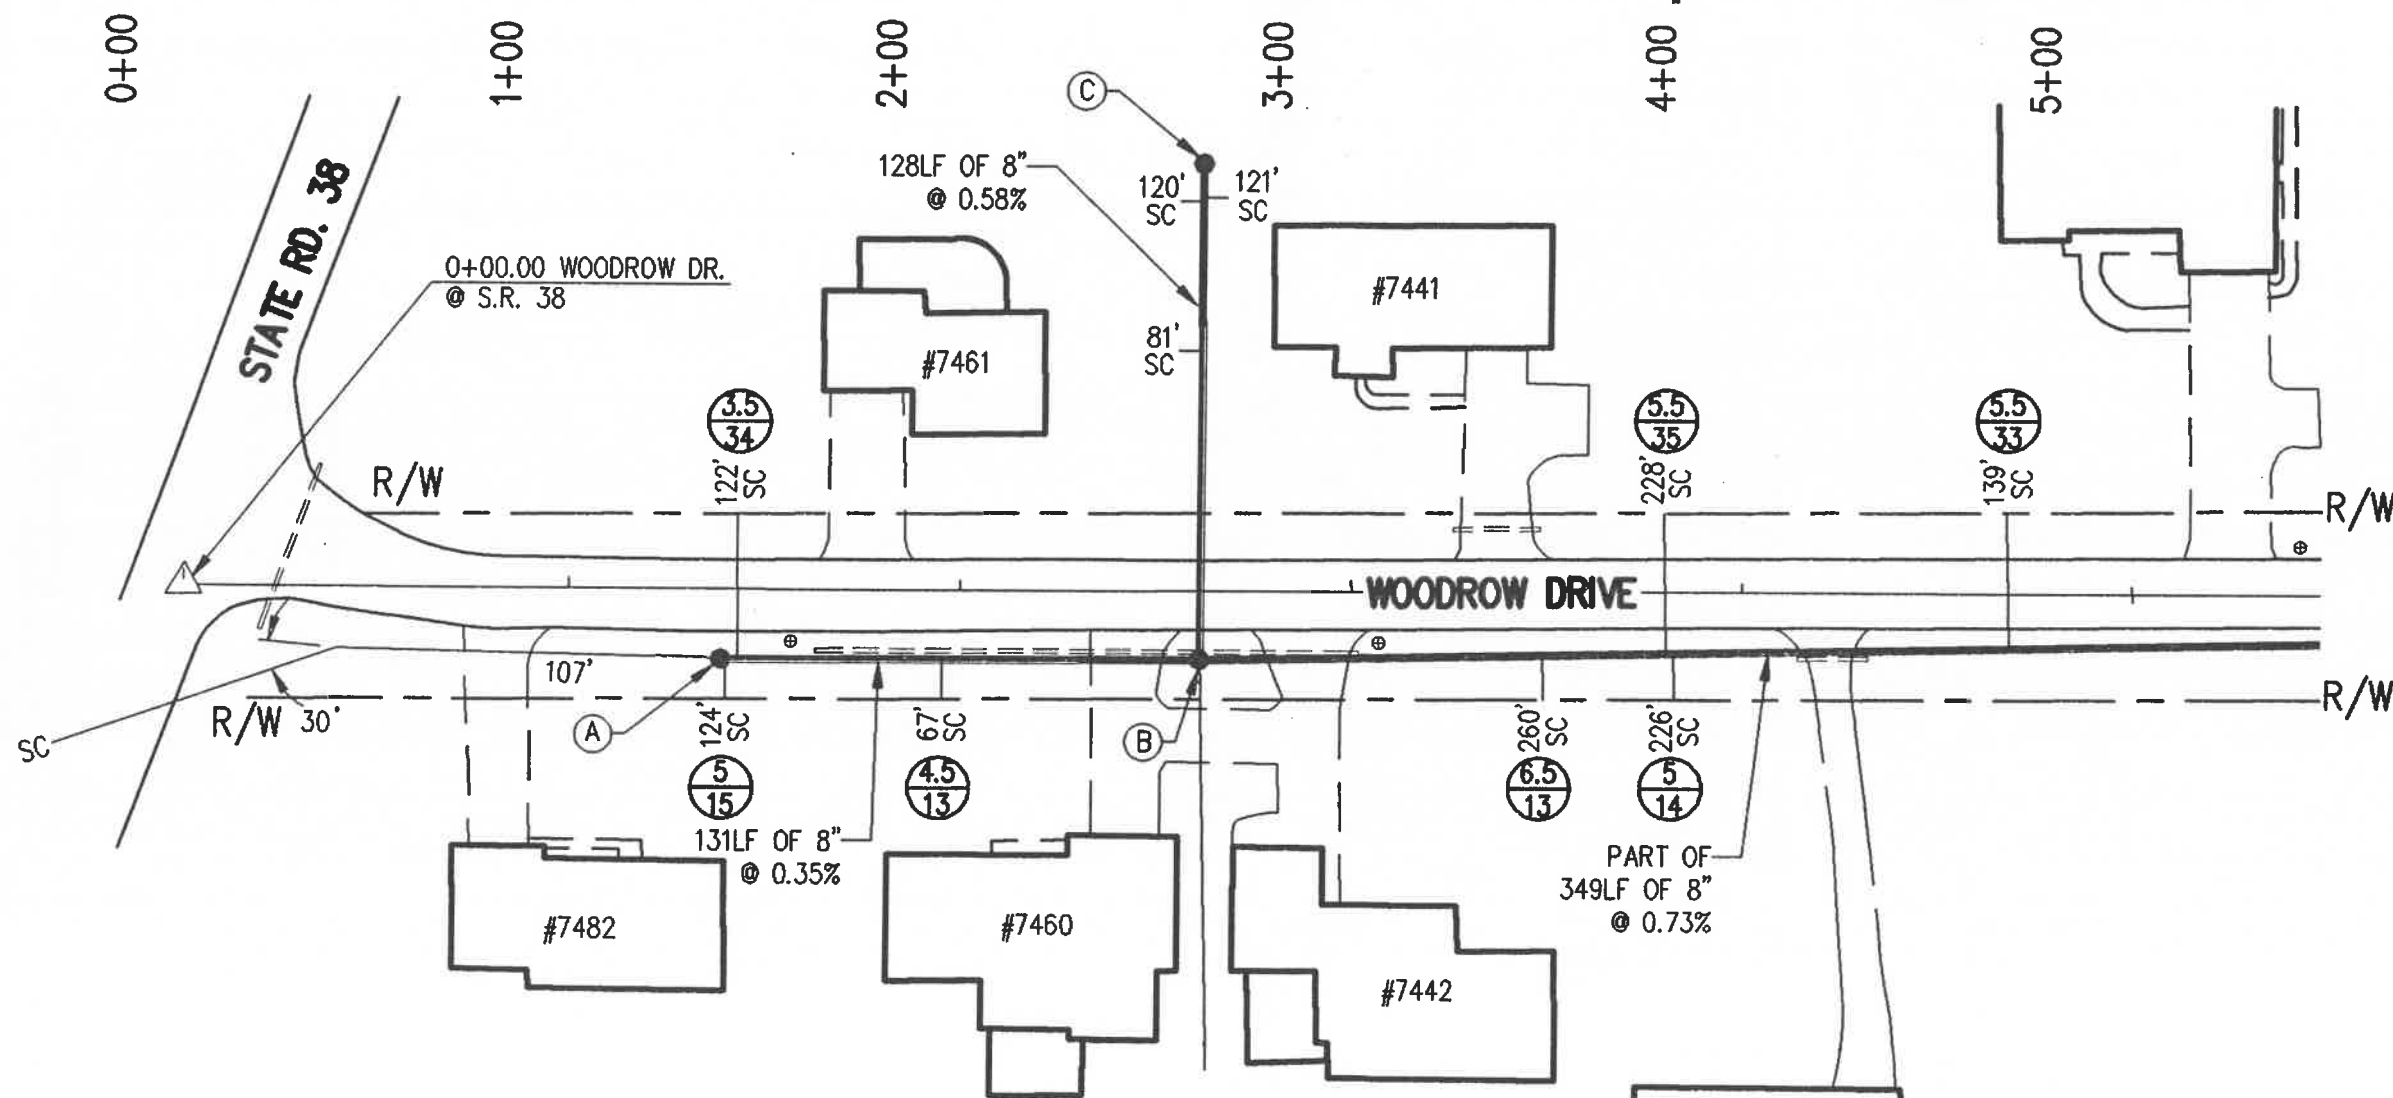

AS-BUILT INFORMATION


SCALE: 1" = 50'



TRIAD
ASSOCIATES
INC.
INDIANAPOLIS, INDIANA

FALL CREEK REGIONAL
WASTE DISTRICT
DIVISION 'A' & DIVISION 'B'
SHEET No. 58d

INDEX MA-8

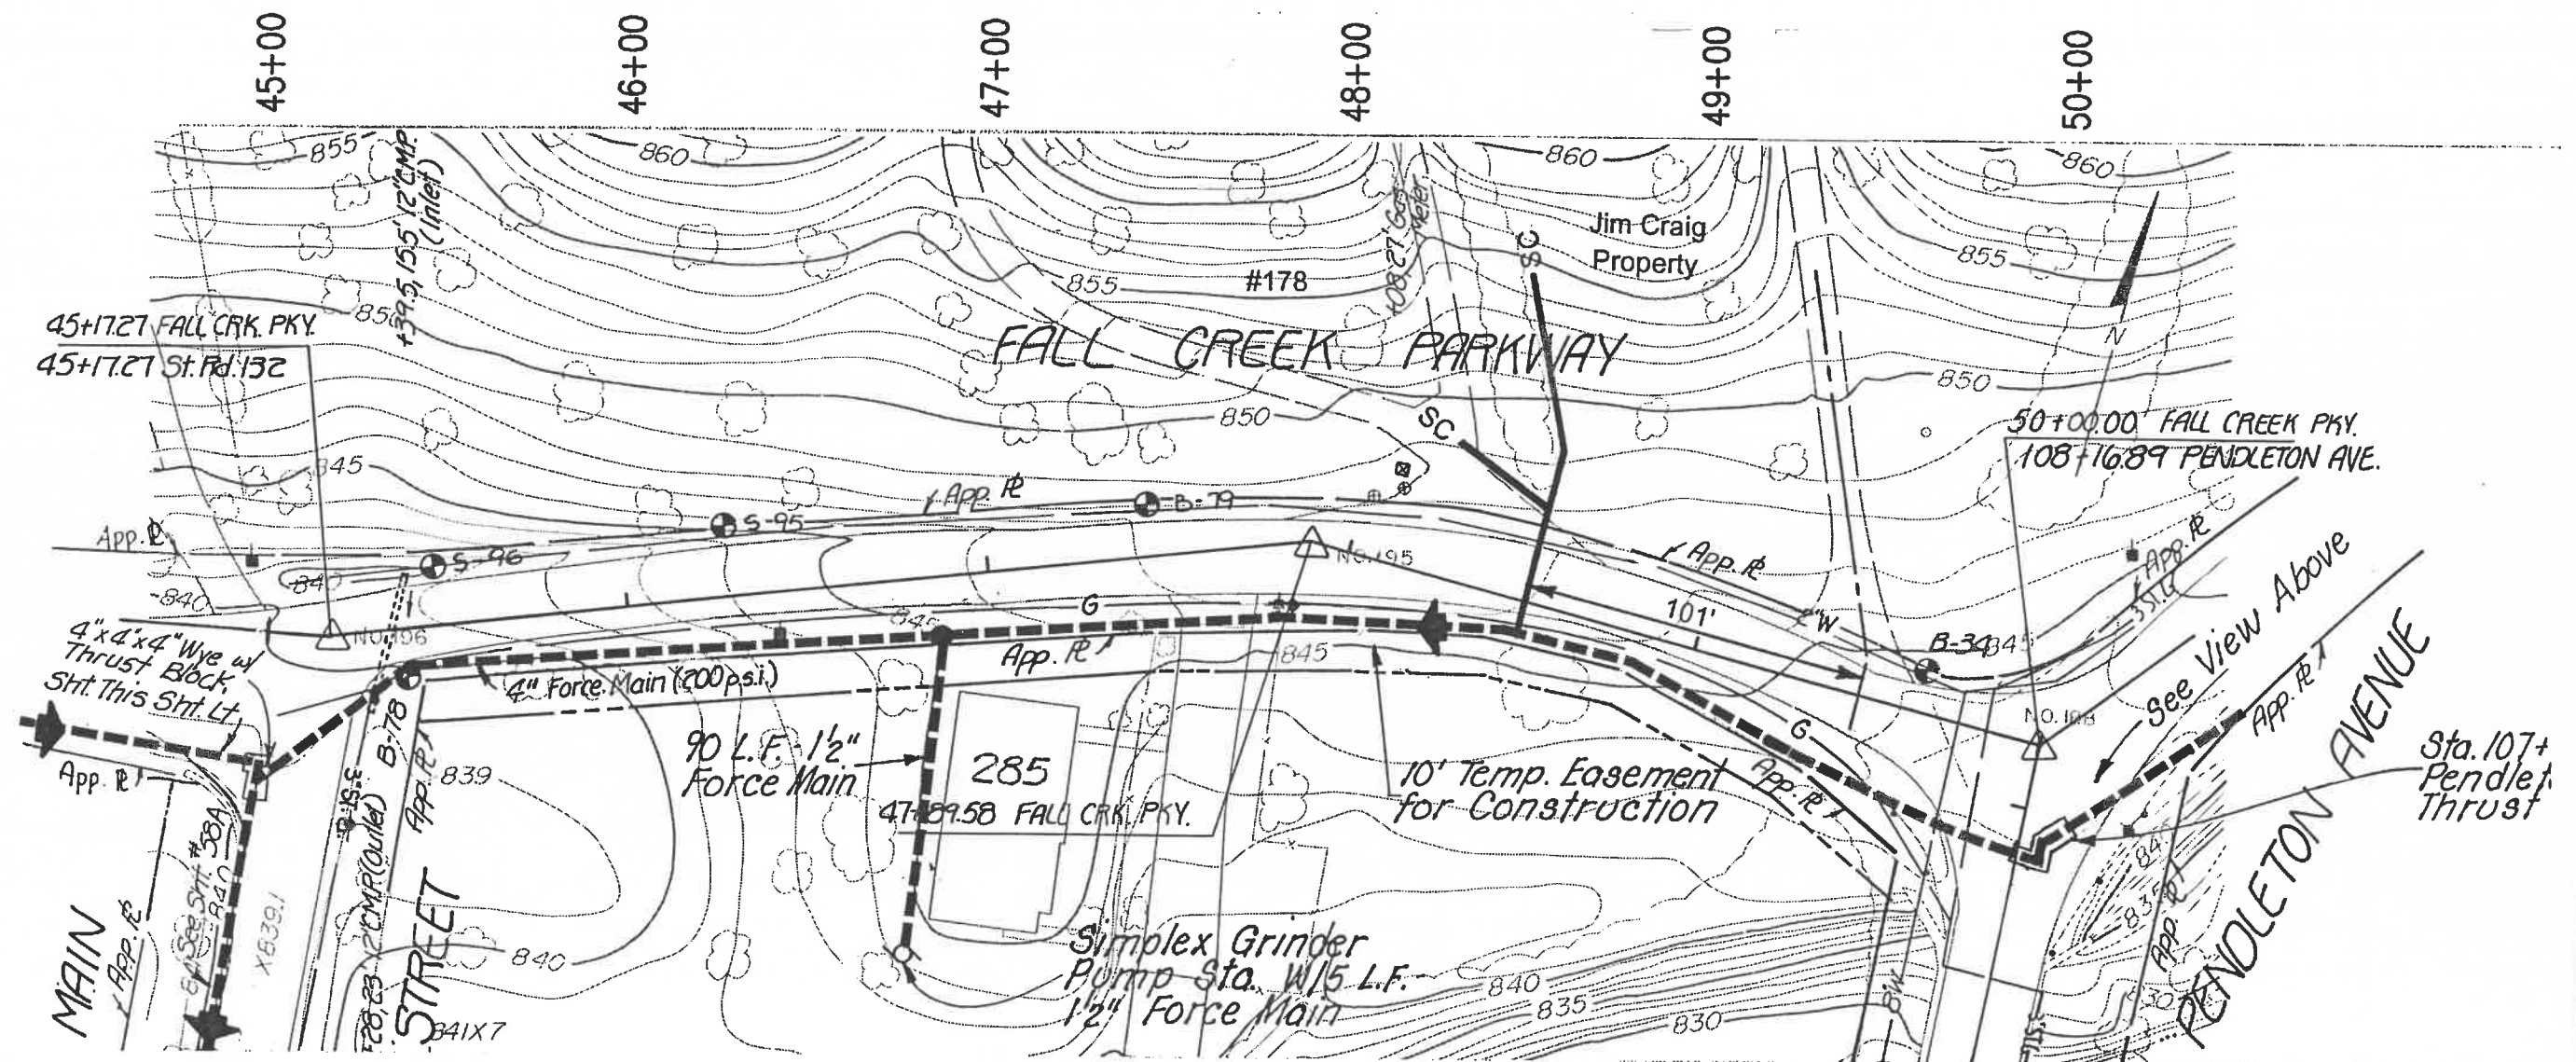

AS-BUILT INFORMATION

SCALE: 1" = 50'



TRIAD
ASSOCIATES
INC.

INDIANAPOLIS, INDIANA




FALL CREEK REGIONAL
WASTE DISTRICT

DIVISION 'C'

SHEET No. 20a

INDEX MA-9

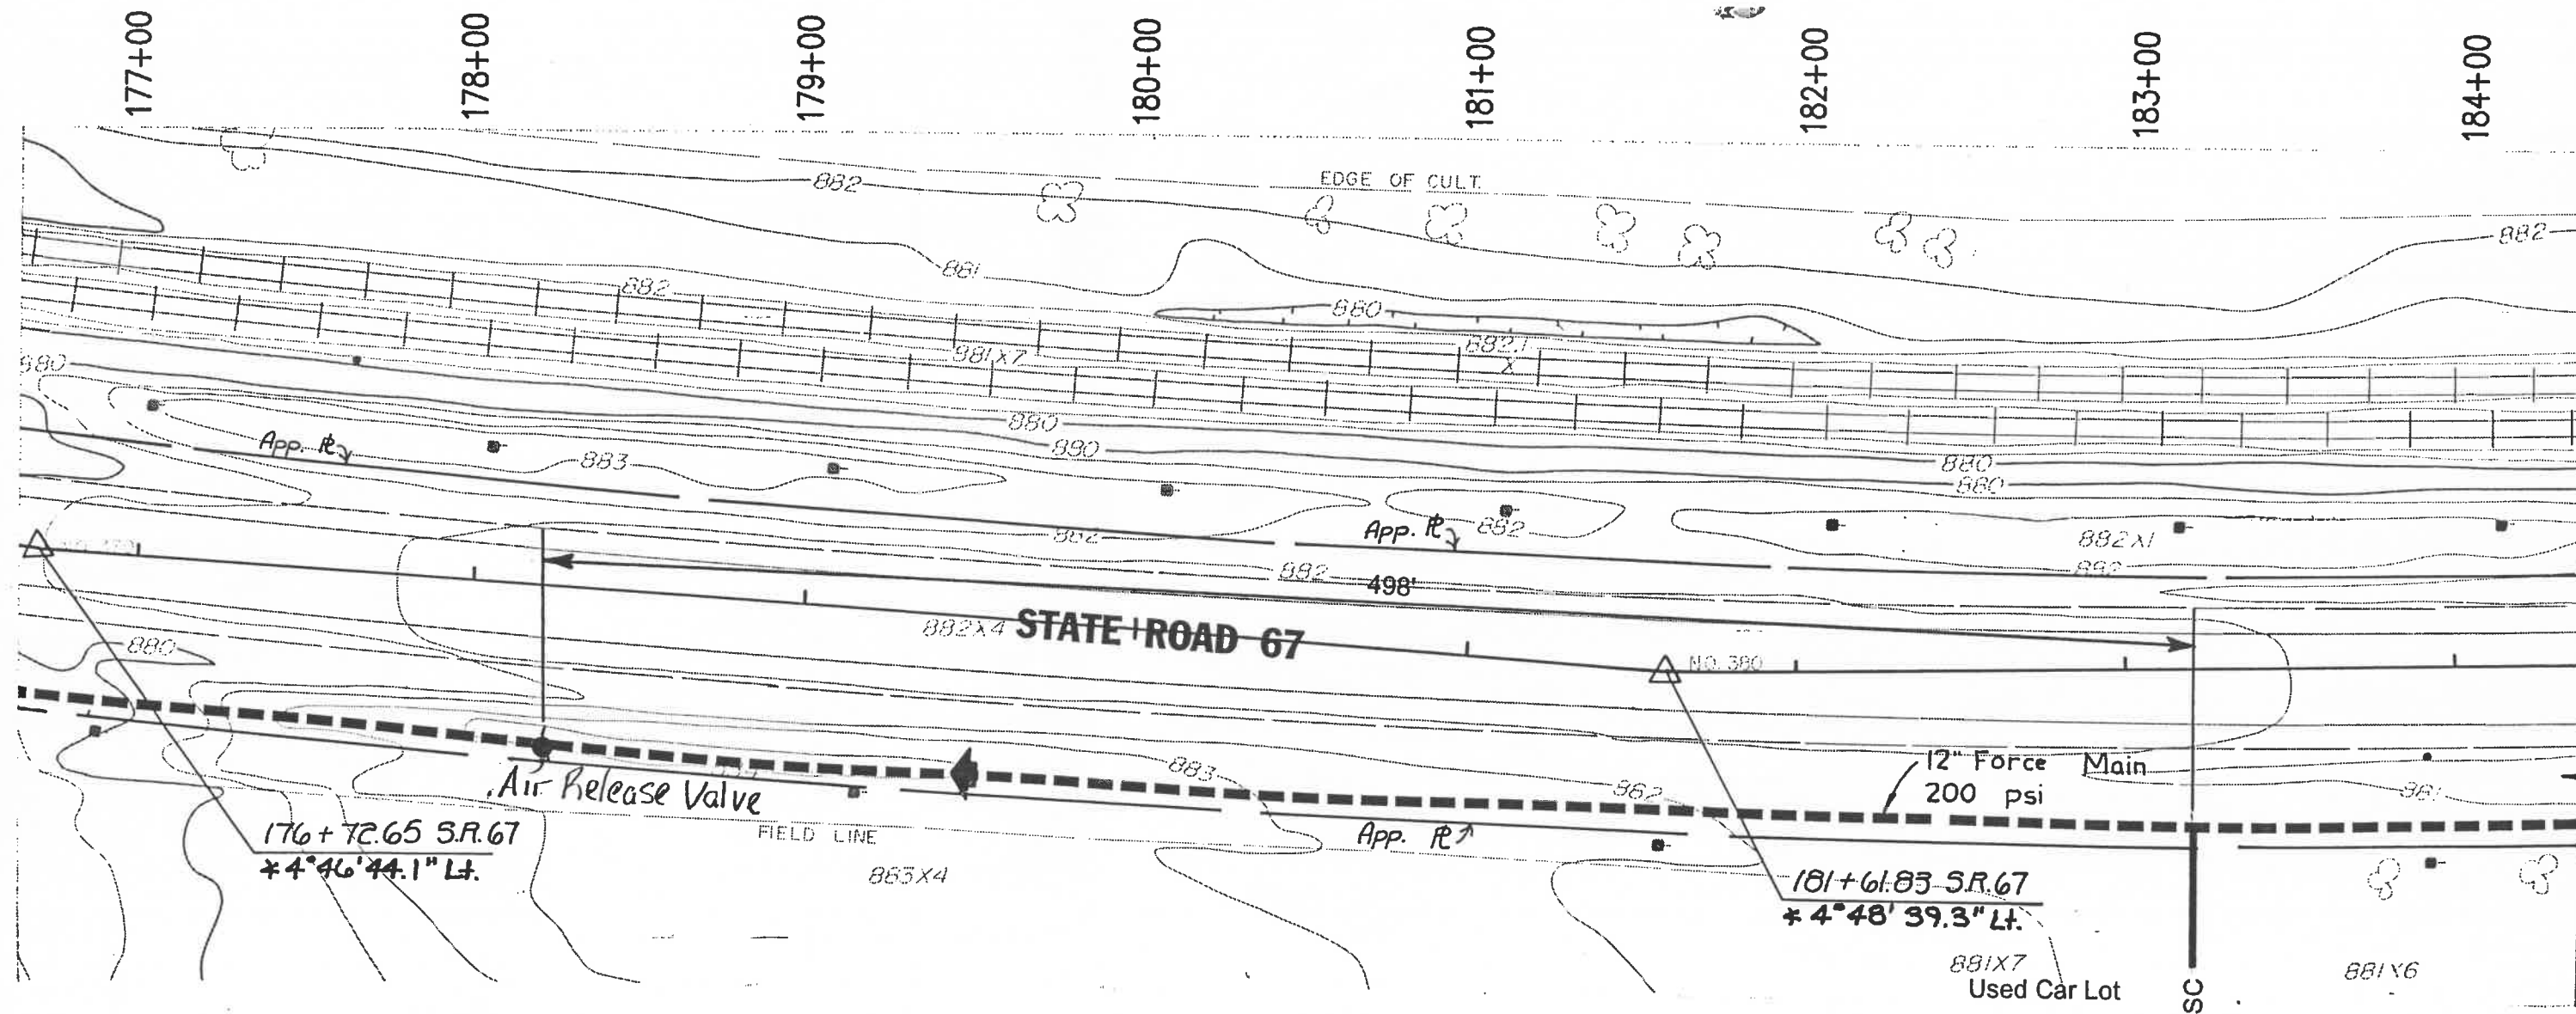

AS-BUILT INFORMATION

SCALE: 1" = 50'



NORTH

TRIAD
ASSOCIATES
INC.

INDIANAPOLIS, INDIANA




FALL CREEK REGIONAL
WASTE DISTRICT
EAST STREET AND
PENDLETON ROAD

INDEX SA-8

KEYNOTES

- (A) MH #62
TC = 867.14
INV. = 858.94
(B) MH #62A
TC = 866.98
INV. = 860.38
(C) CO #62B
TC = 868.60

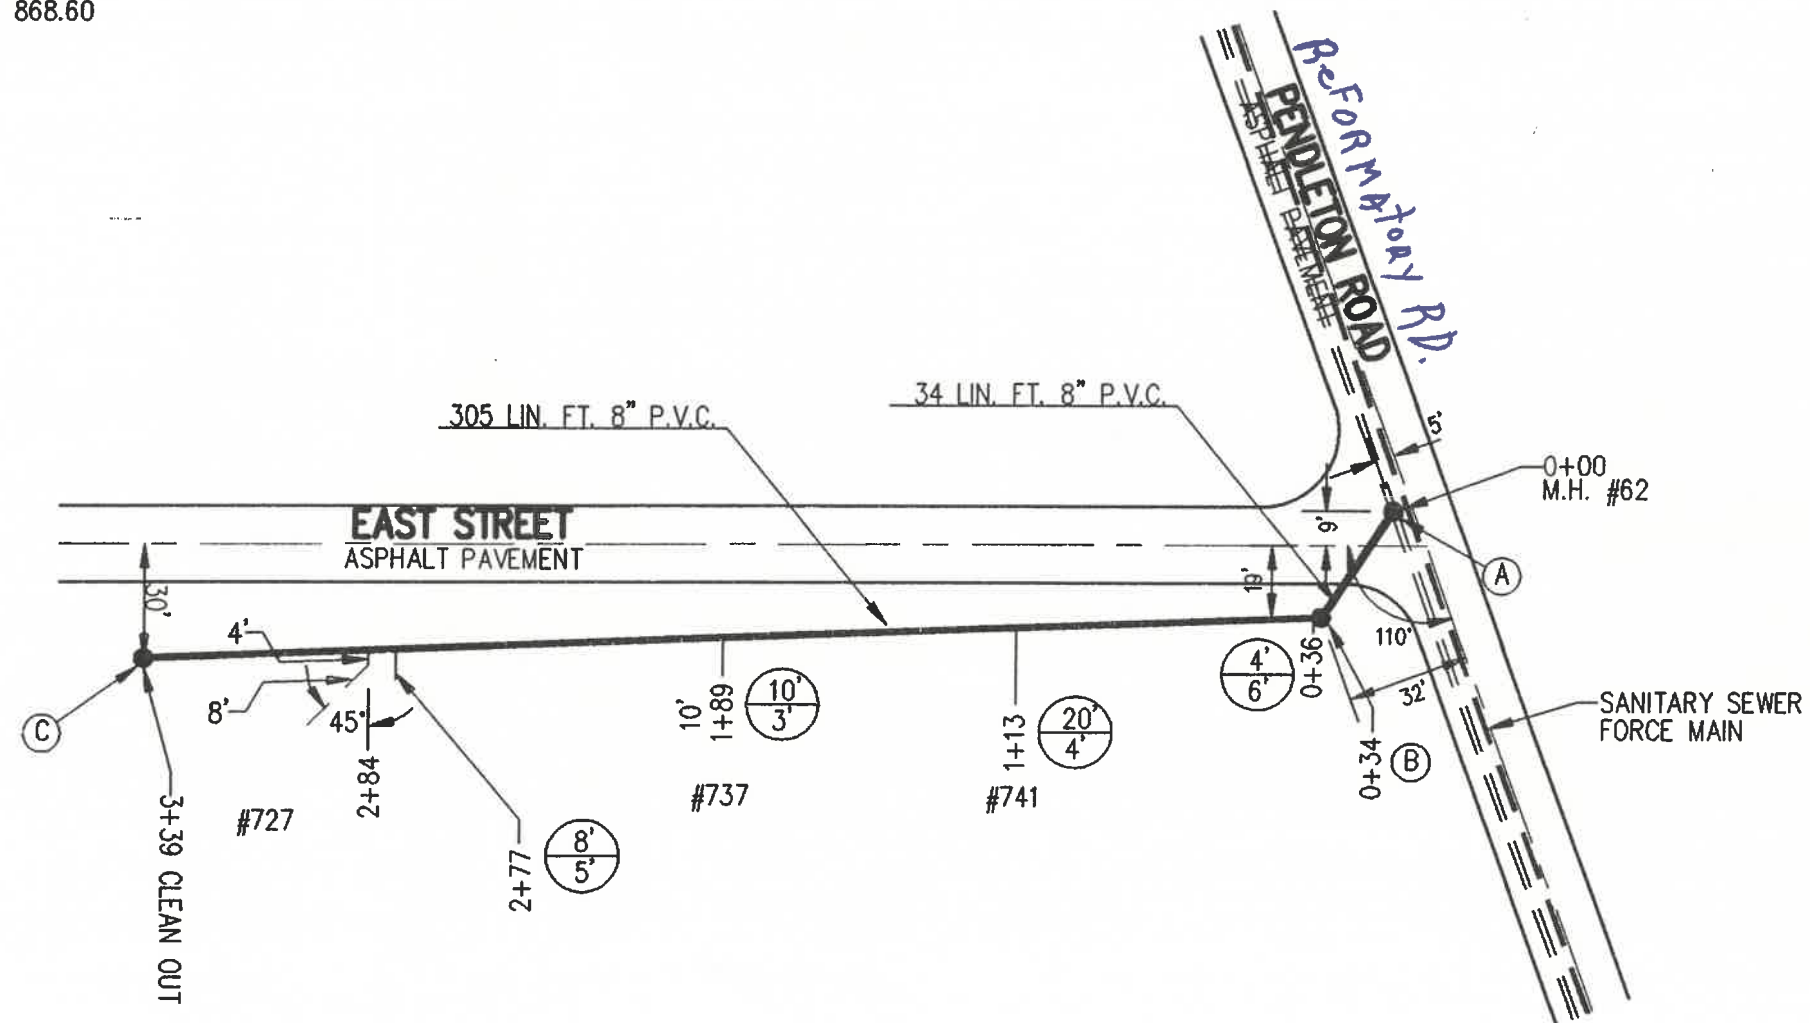

LEGEND

---	EASEMENT LIMITS	W	WATERLINE LOCATION
- - -	RIGHT-OF-WAY LIMITS	G	GAS LINE LOCATION
- - - - -	FORCE MAIN LOCATION	T	UNDERGROUND TELEPHONE
=====	SANITARY SEWER LOCATION	* * *	FENCE LINE
=====	STORM SEWER LOCATION	x	LIGHT POLE
---SC	SANITARY SERVICE CONNECTION	■	POWER POLE

AS-BUILT INFORMATION

SCALE: 1" = 50'



TRIAD
ASSOCIATES
INC.
INDIANAPOLIS, INDIANA

FALL CREEK REGIONAL
WASTE DISTRICT
DIVISION 'A' & DIVISION 'B'
SHEET No. 36a

INDEX MA-1

97+00

98+00

99+00


100+00

101+00

102+00

103+00

104+00

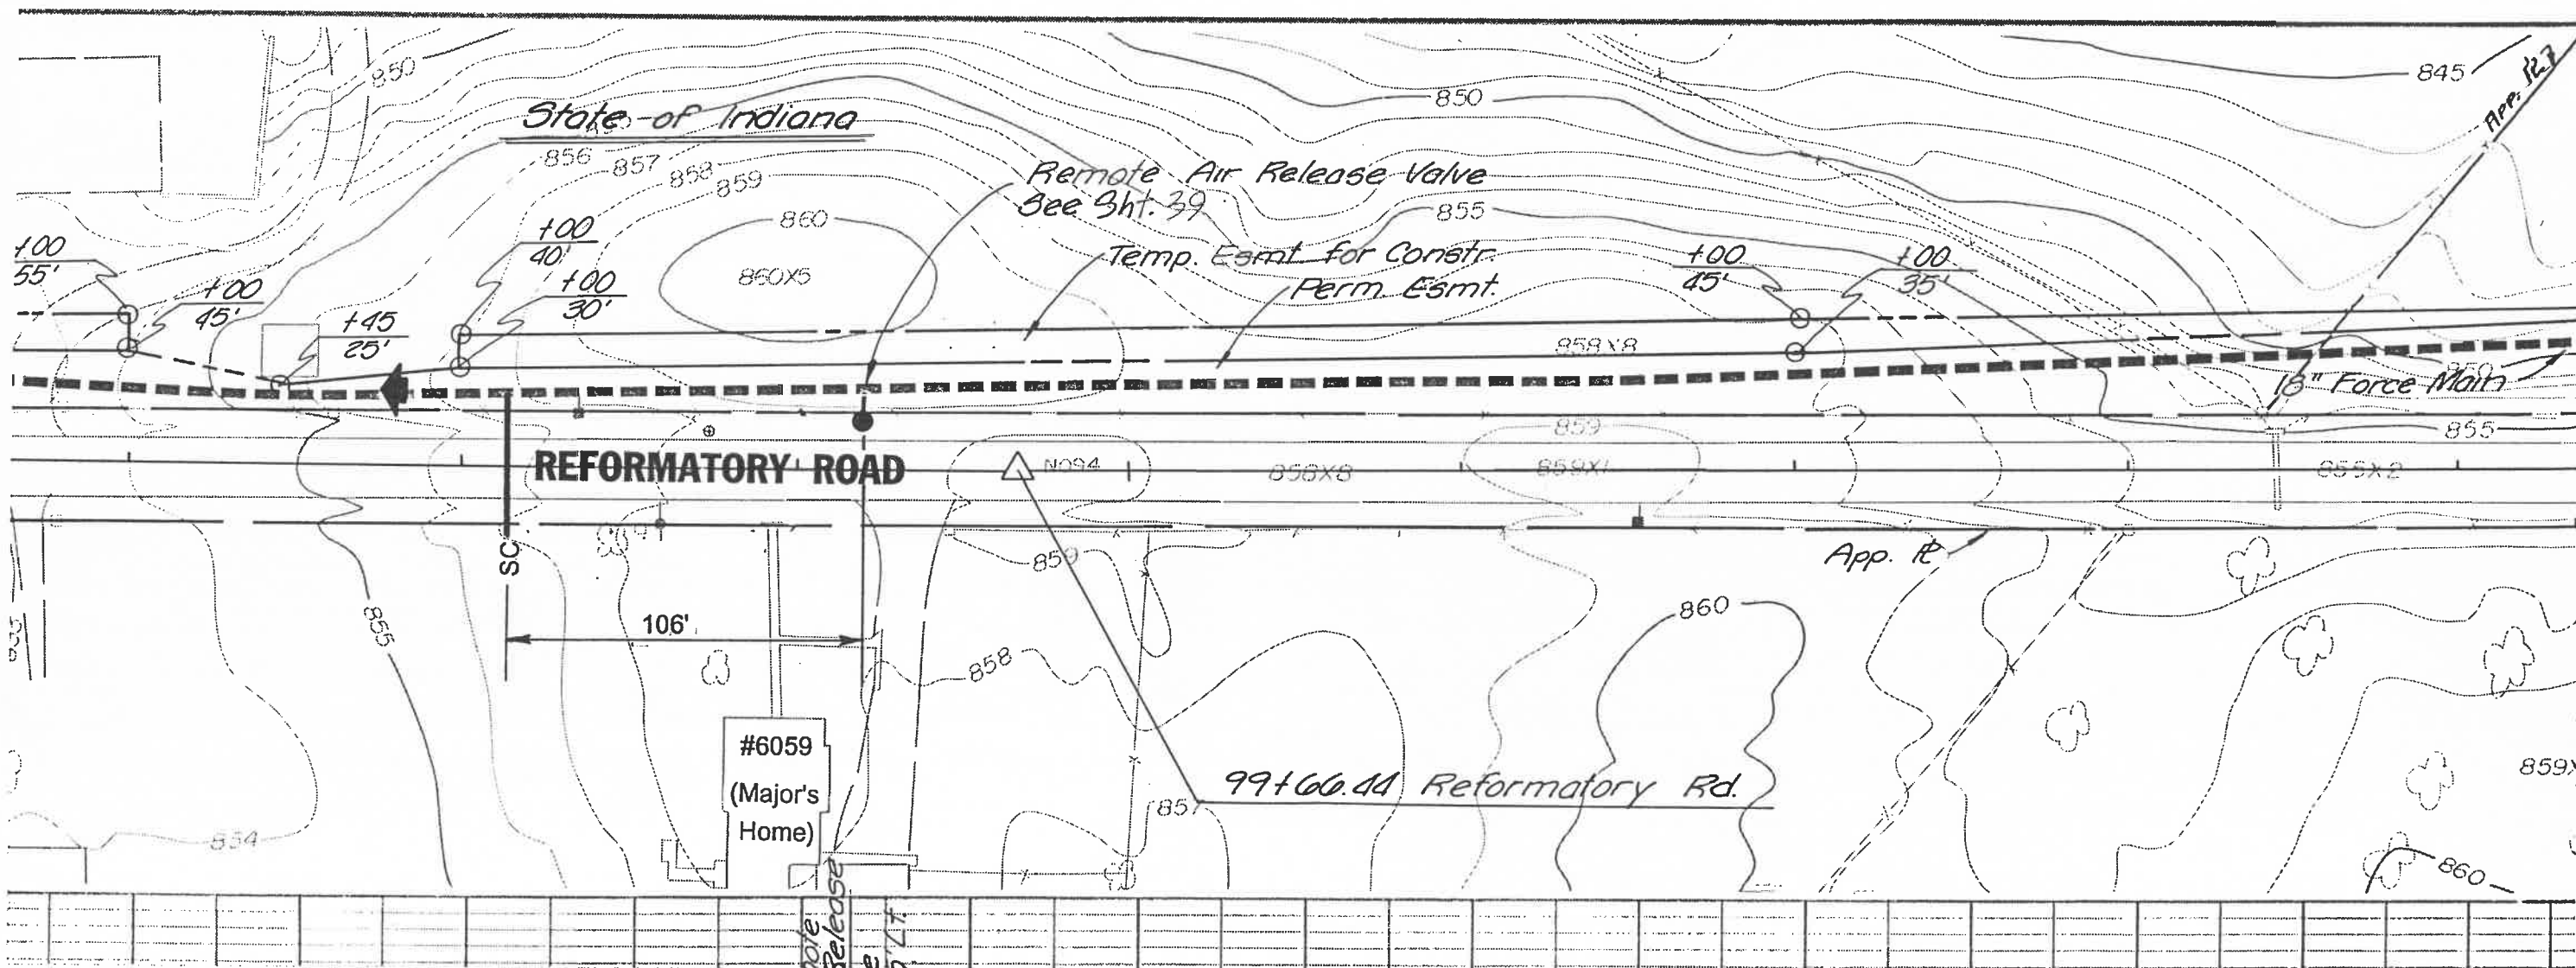

AS-BUILT INFORMATION

SCALE: 1" = 50'



NORTH


TRIAD
ASSOCIATES
INC.

INDIANAPOLIS, INDIANA



SHEET No. 36b

INDEX MA-1

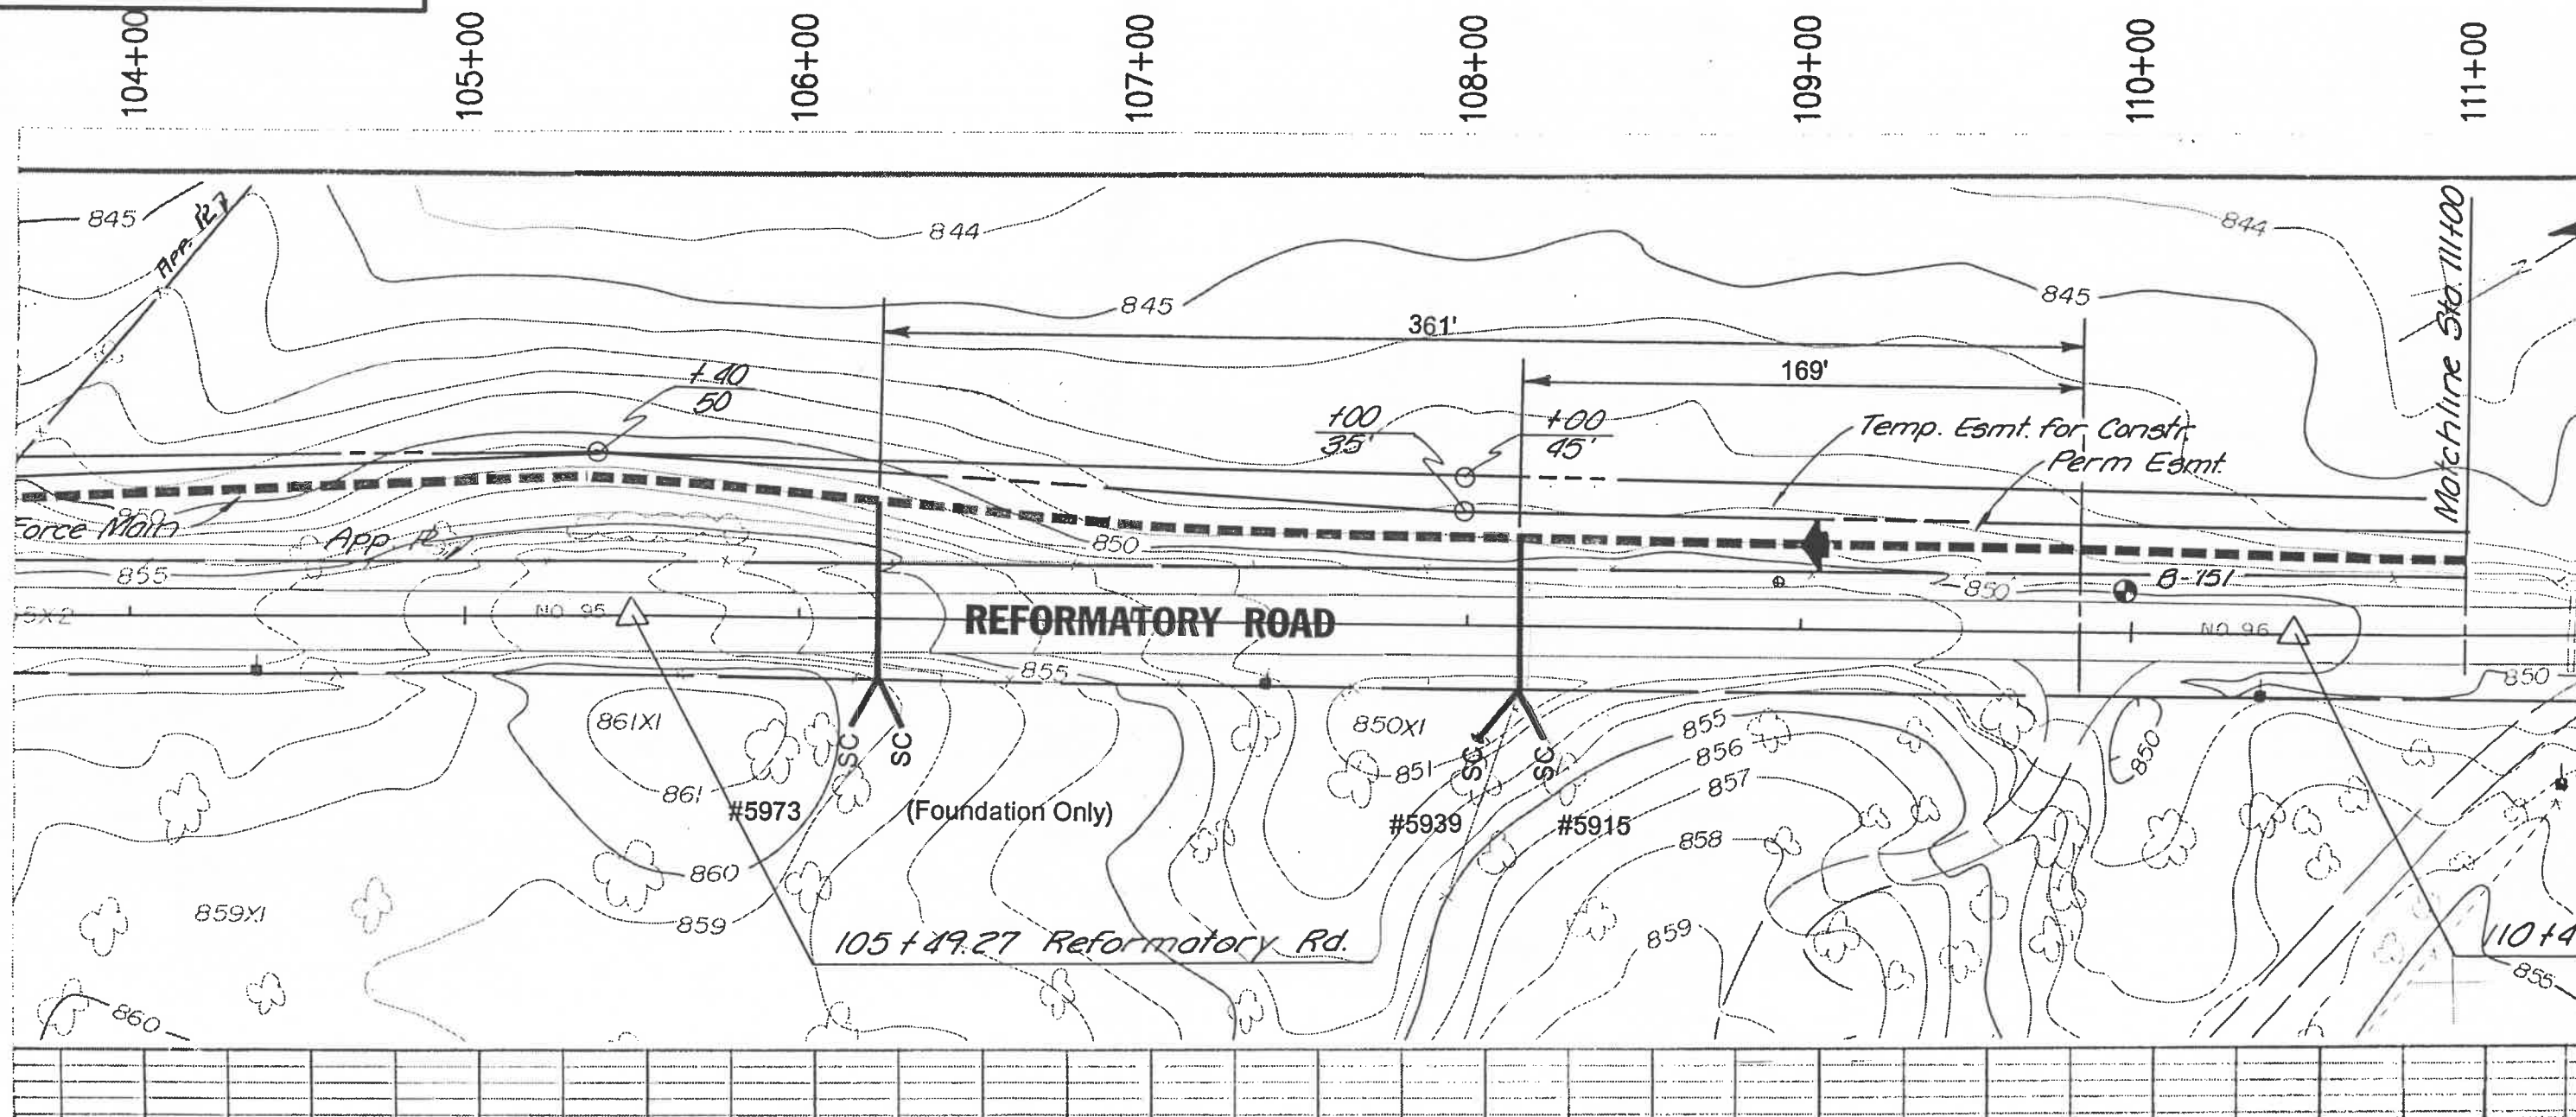

SCALE: 1" = 50'



**TRIAD
ASSOCIATES
INC.**

INDIANAPOLIS, INDIANA



FALL CREEK REGIONAL
WASTE DISTRICT
DIVISION 'A' & DIVISION 'B'
SHEET No. 36d

INDEX MA-1

119+00

120+00

121+00


122+00

123+00

124+00

125+00

126+00

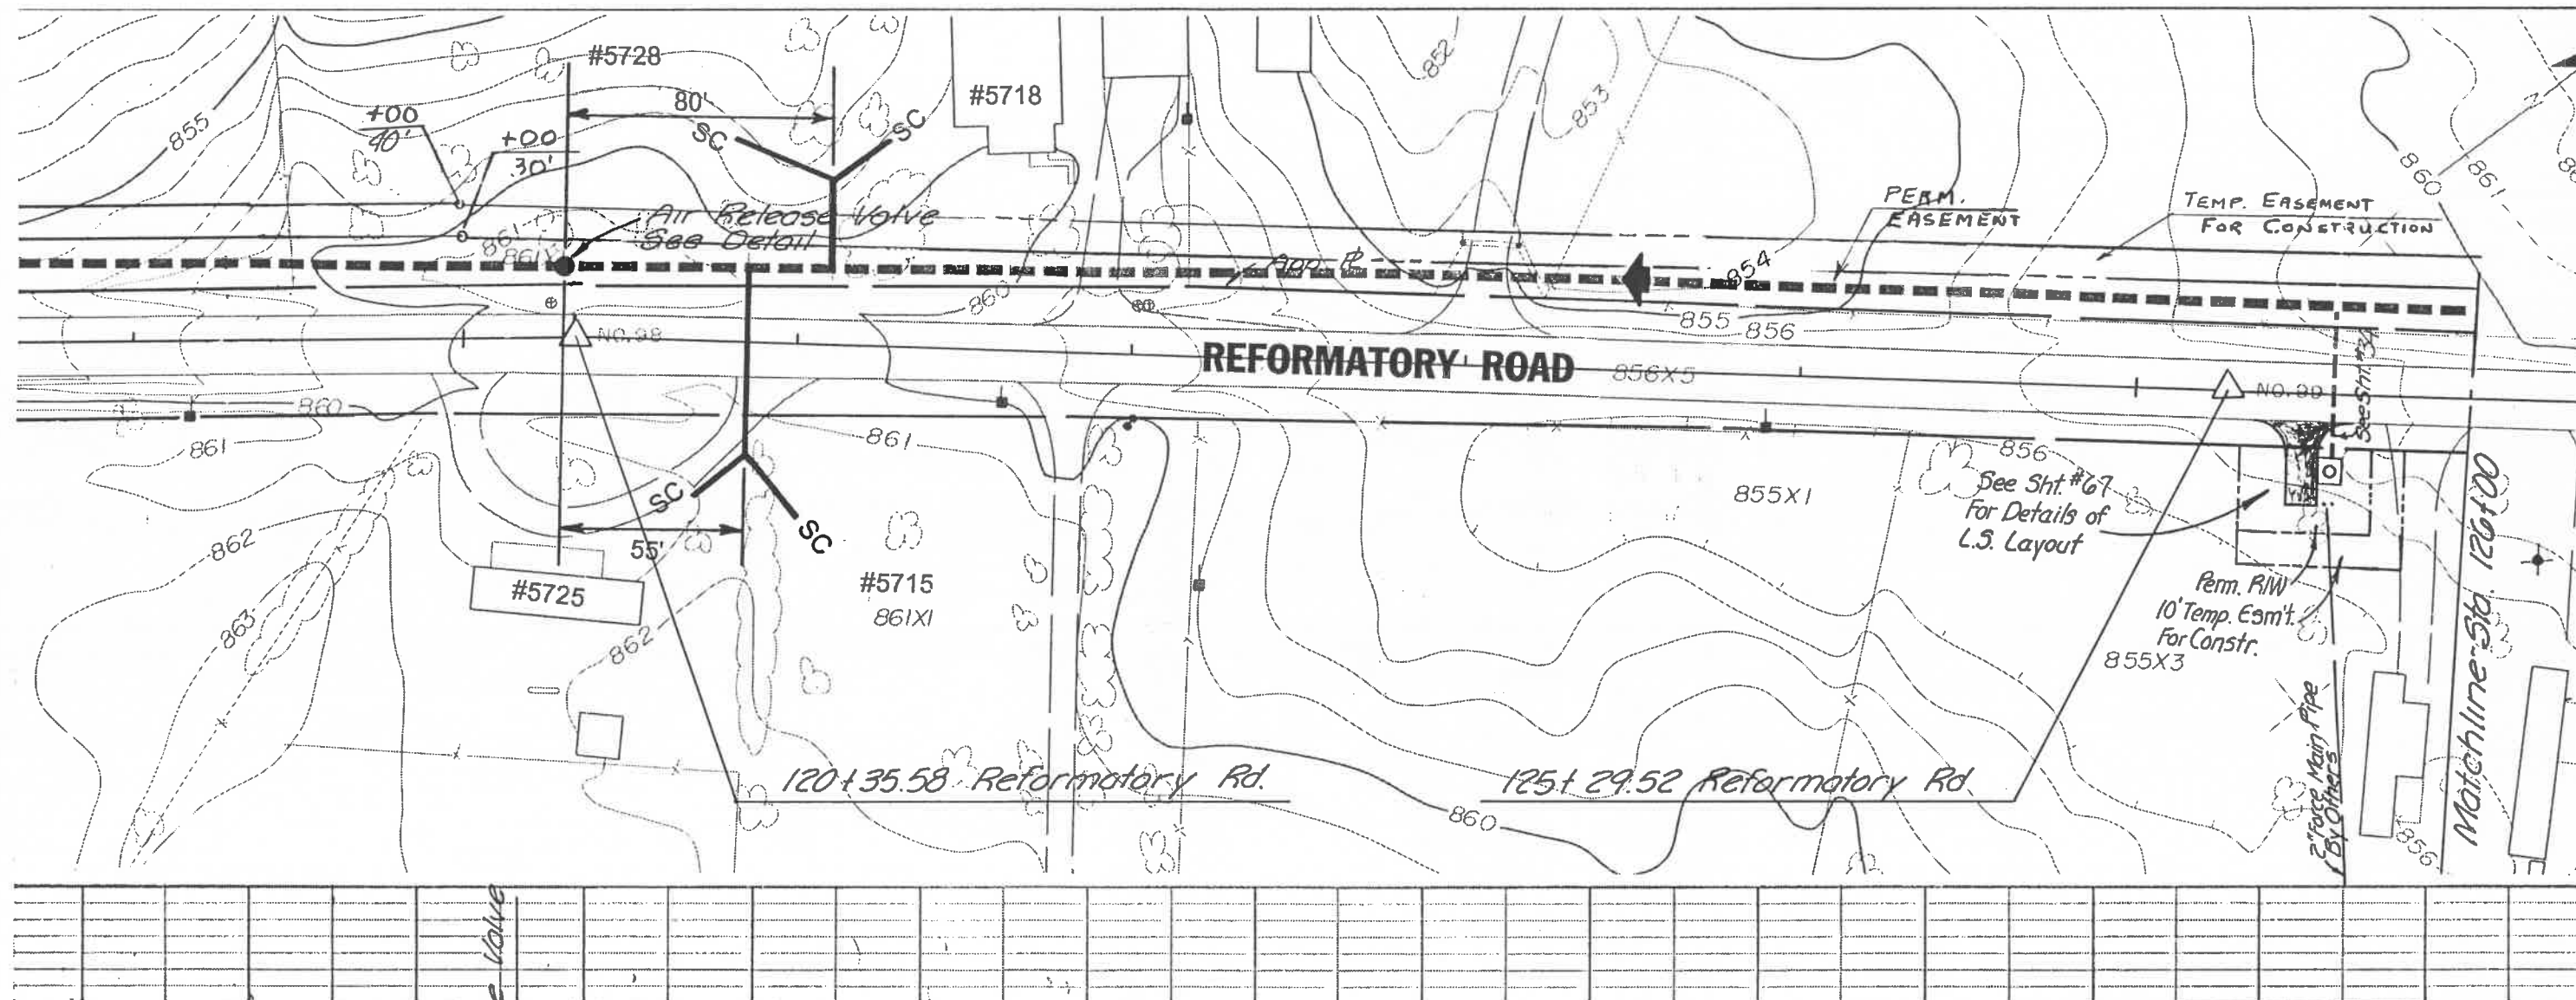

AS-BUILT INFORMATION

SCALE: 1" = 50'



TRIAD
ASSOCIATES
INC.

INDIANAPOLIS, INDIANA




FALL CREEK REGIONAL
WASTE DISTRICT
DIVISION 'A' & DIVISION 'B'
SHEET No. 37

INDEX MA-1

LEGEND

---	EASEMENT LIMITS	W	WATERLINE LOCATION
- - -	RIGHT-OF-WAY LIMITS	G	GAS LINE LOCATION
- - - - -	FORCE MAIN LOCATION	T	UNDERGROUND TELEPHONE
=====	SANITARY SEWER LOCATION	* * *	FENCE LINE
=====	STORM SEWER LOCATION	x	LIGHT POLE
SC	SANITARY SERVICE CONNECTION	■	POWER POLE

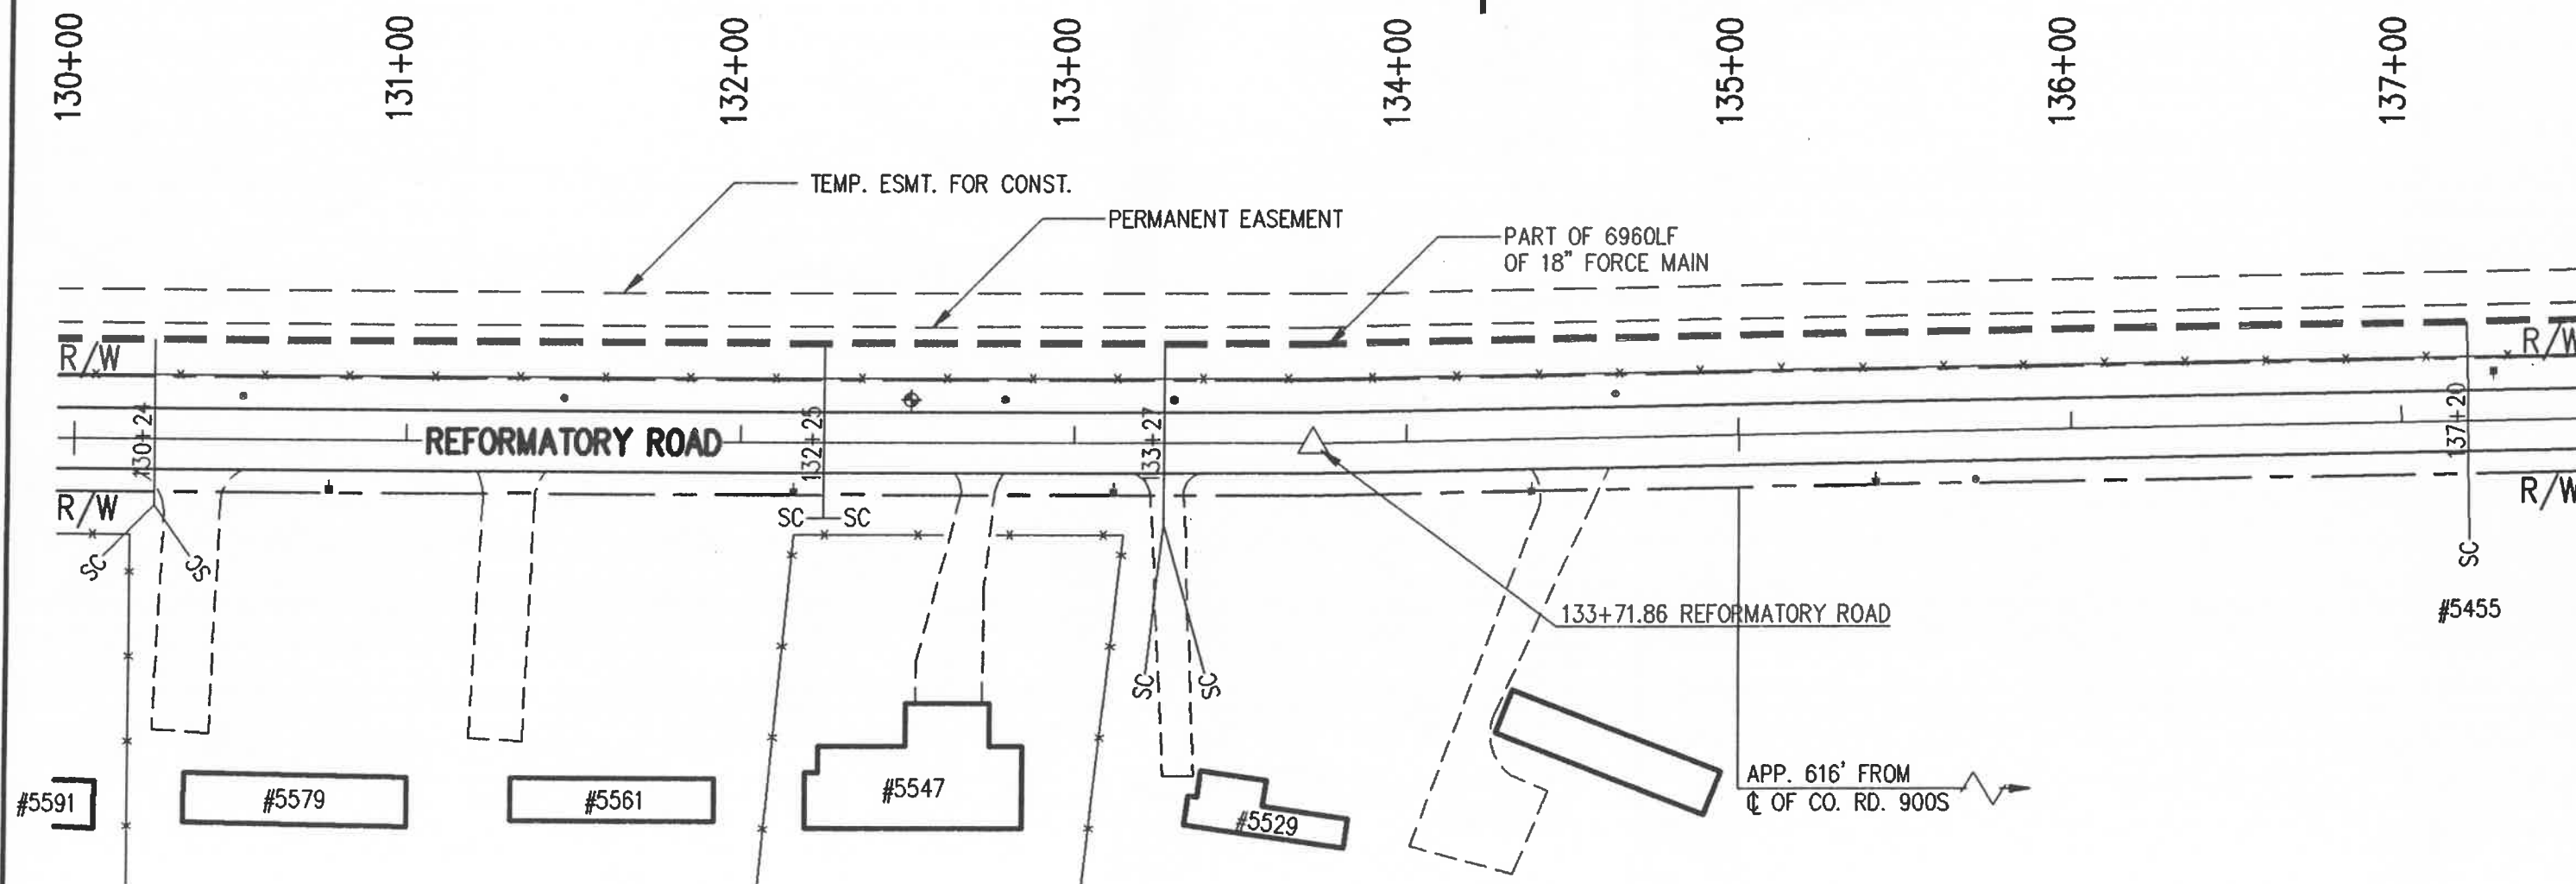

AS-BUILT INFORMATION

SCALE: 1" = 50'




TRIAD
ASSOCIATES
INC.
INDIANAPOLIS, INDIANA



FALL CREEK REGIONAL
WASTE DISTRICT
DIVISION 'A' & DIVISION 'B'
SHEET No. 37A

INDEX MA-1

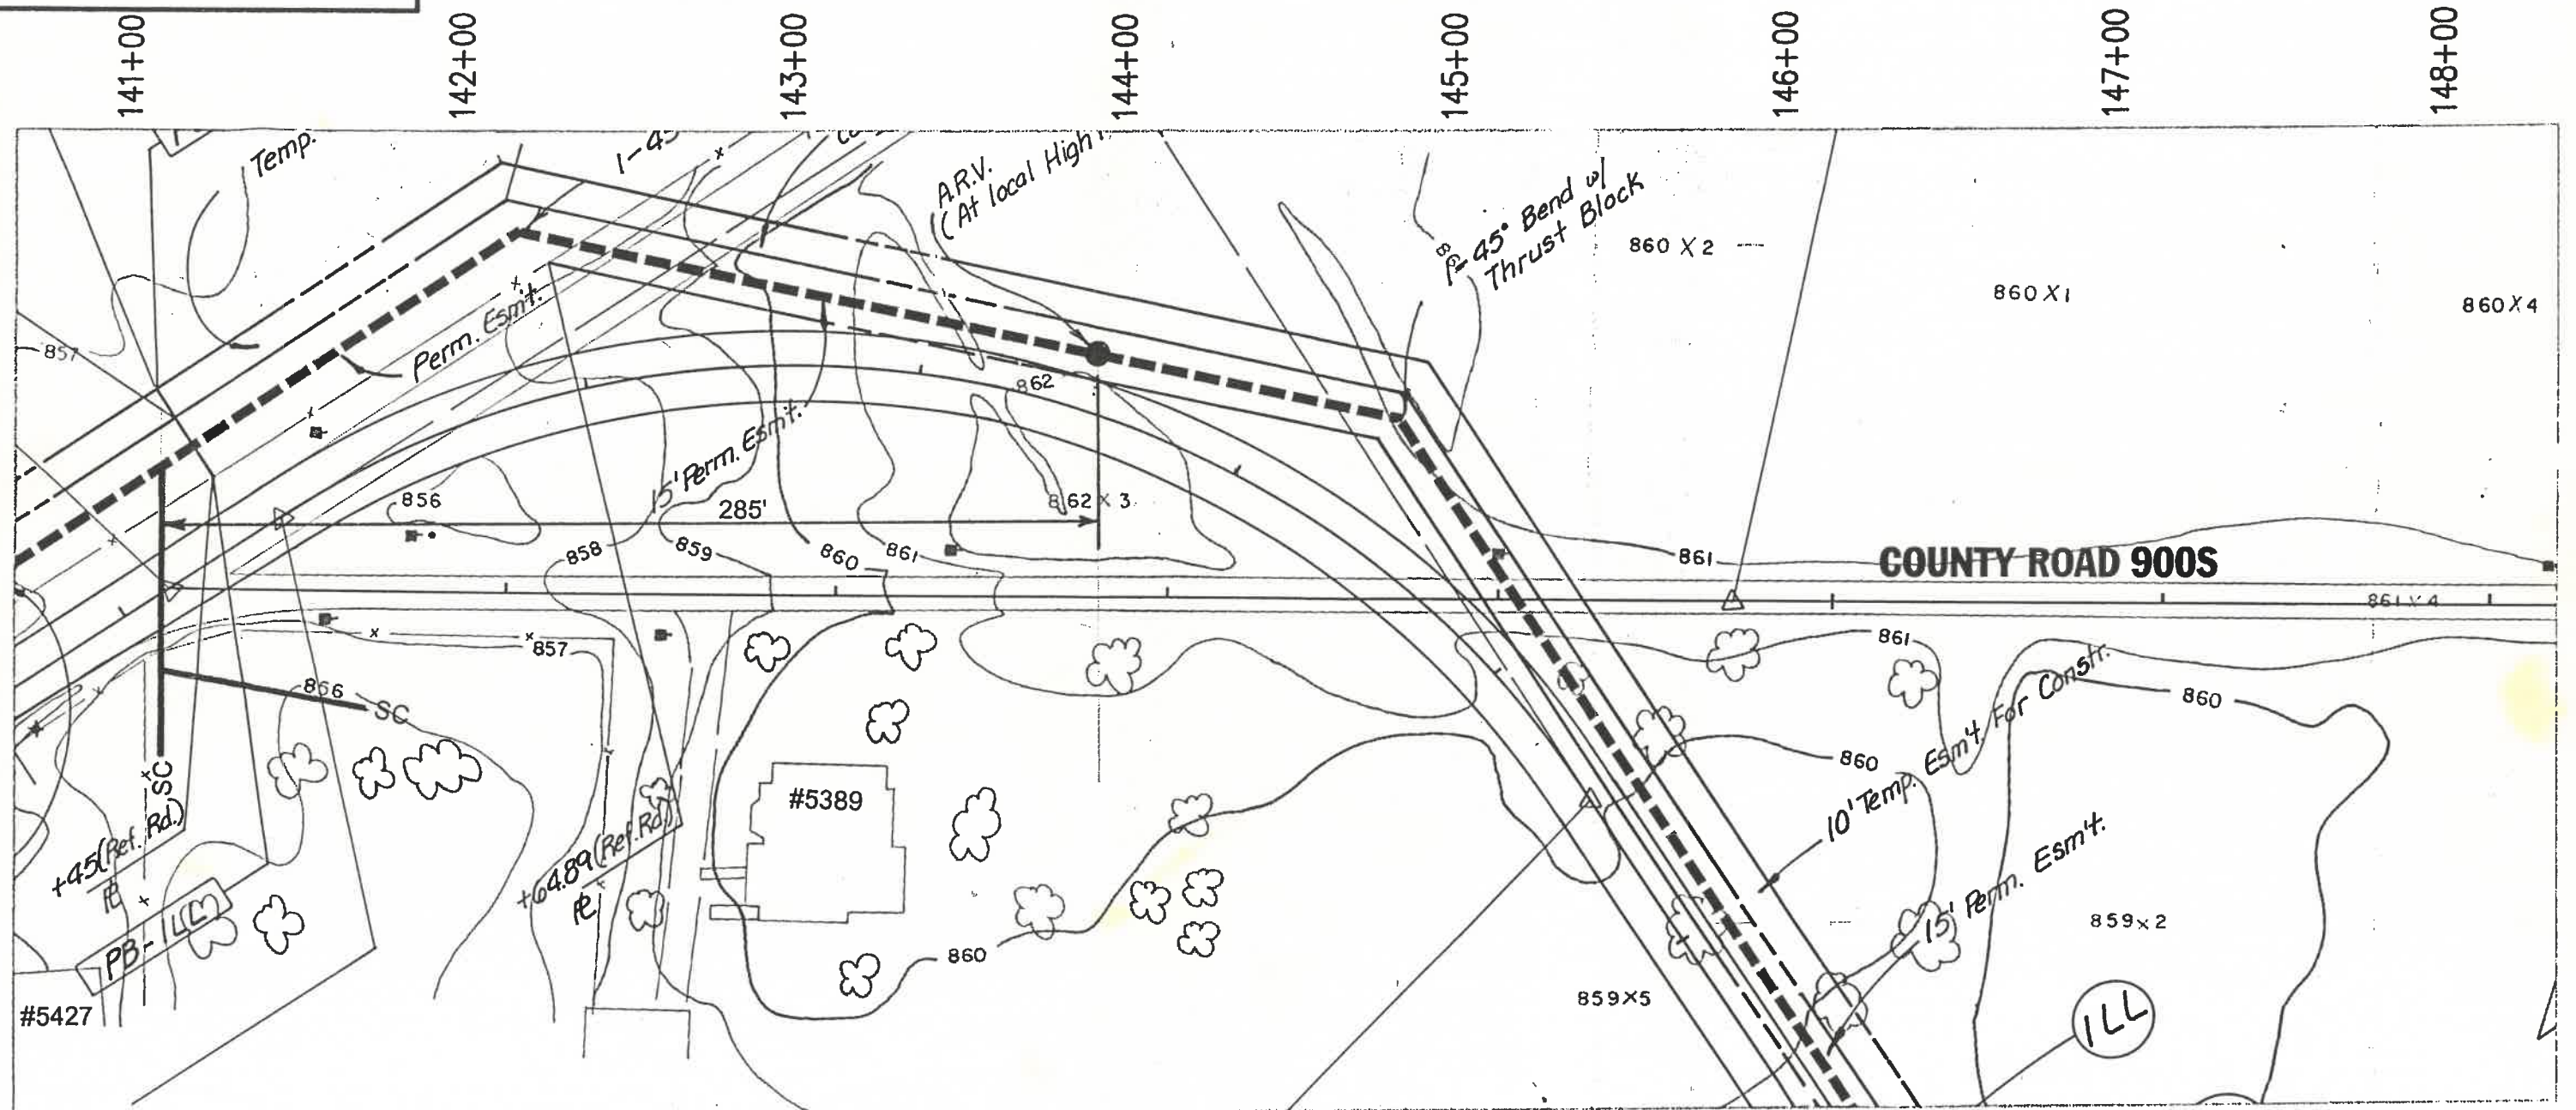

AS-BUILT INFORMATION

SCALE: 1" = 50'




TRIAD
ASSOCIATES
INC.

INDIANAPOLIS, INDIANA



FALL CREEK REGIONAL
WASTE DISTRICT
DIVISION 'A' & DIVISION 'B'
SHEET No. 41

INDEX MA-2

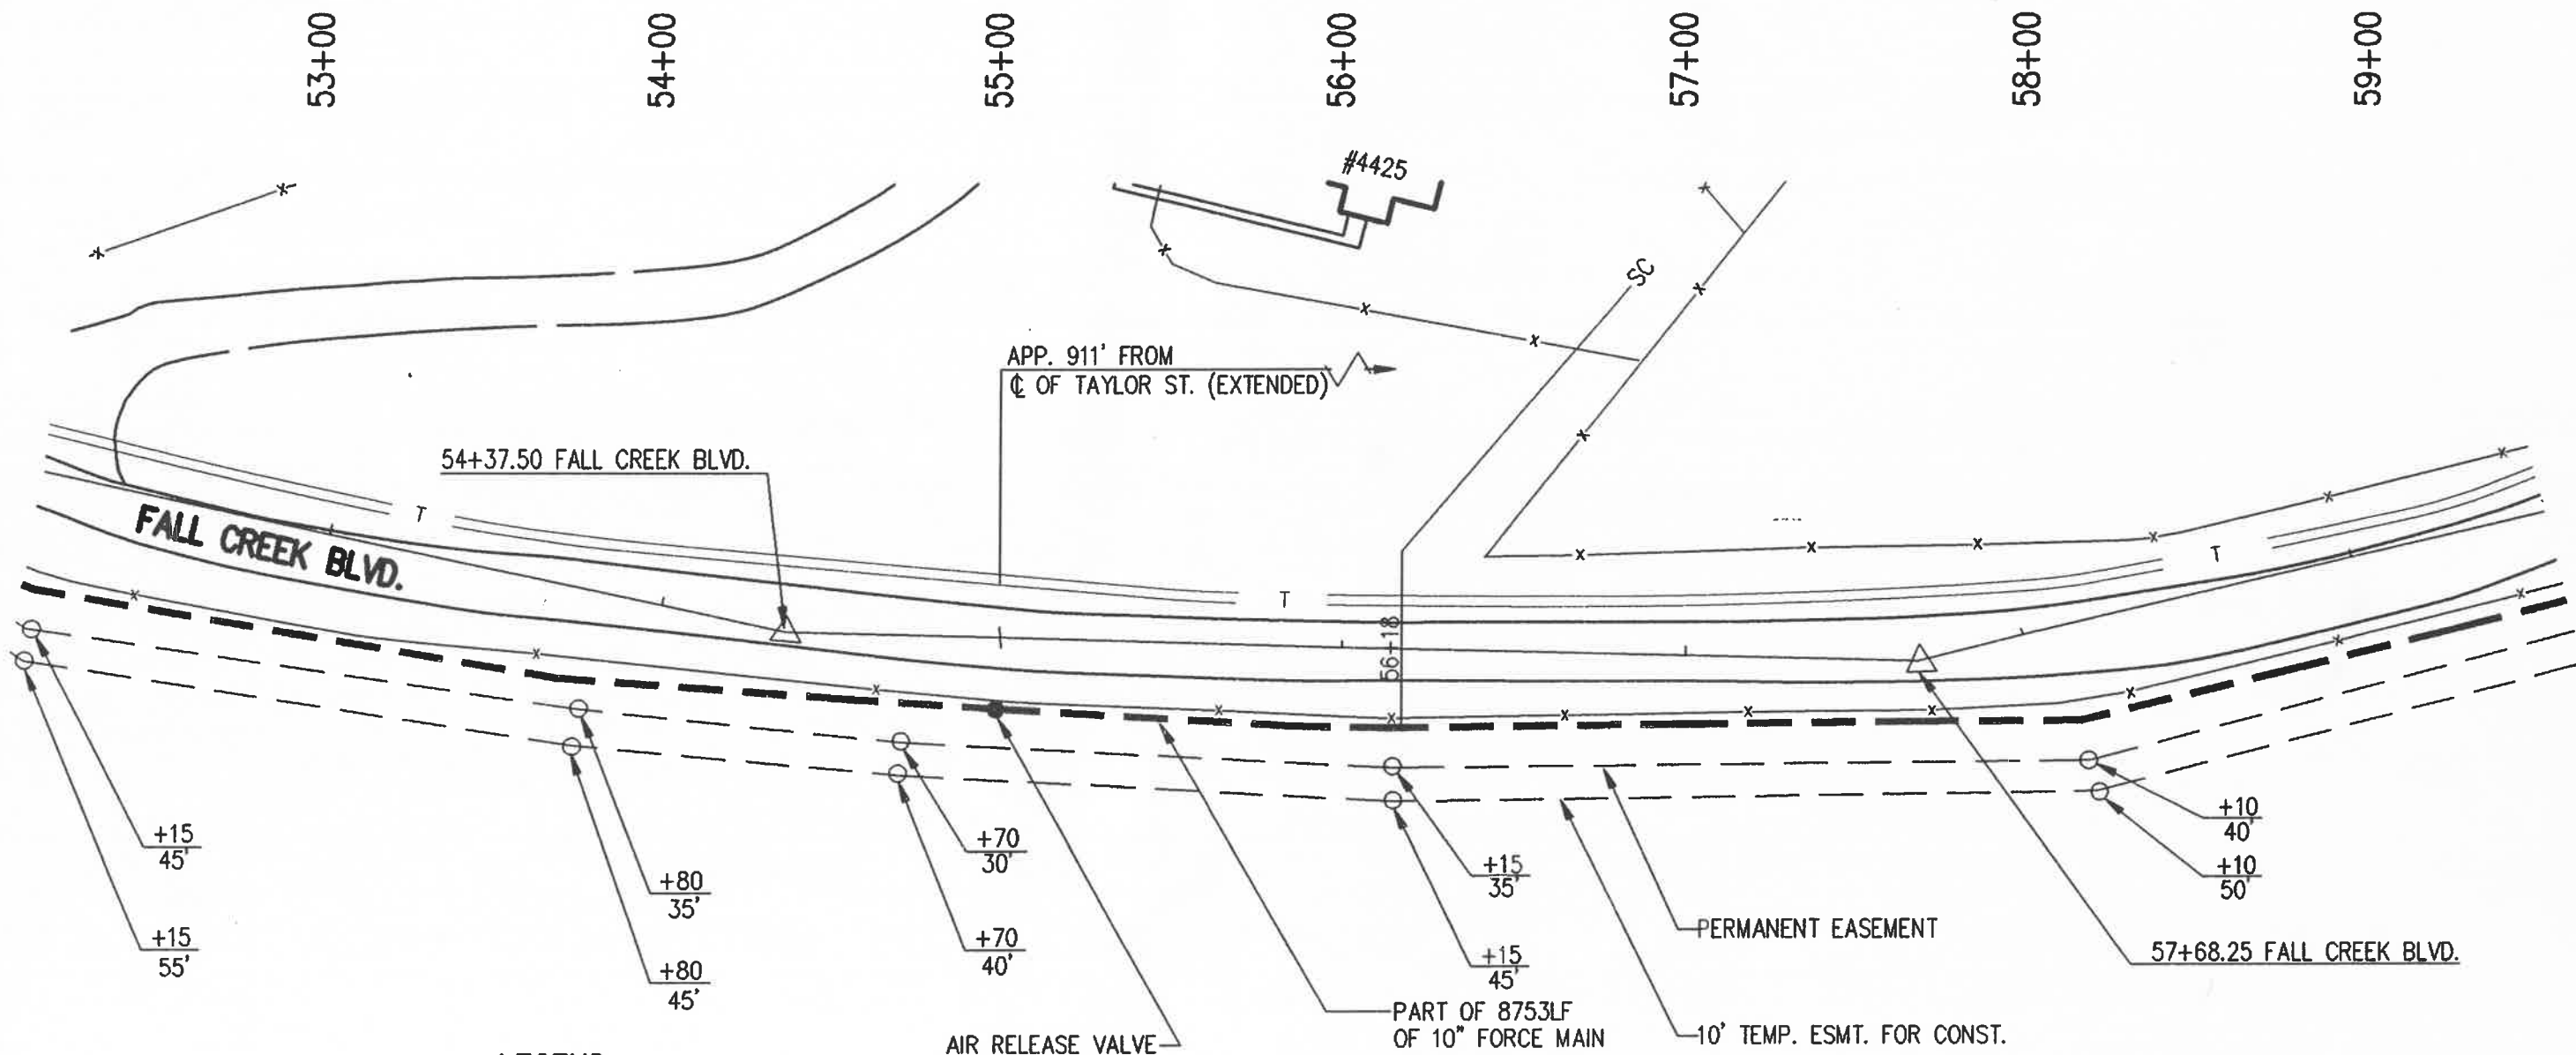

LEGEND

---	EASEMENT LIMITS	—W—	WATERLINE LOCATION
- - -	RIGHT-OF-WAY LIMITS	—G—	GAS LINE LOCATION
---	FORCE MAIN LOCATION	—T—	UNDERGROUND TELEPHONE
---	SANITARY SEWER LOCATION	* * *	FENCE LINE
=====	STORM SEWER LOCATION	x	LIGHT POLE
—SC	SANITARY SERVICE CONNECTION	■	POWER POLE

AS-BUILT INFORMATION

SCALE: 1" = 50'



TRIAD
ASSOCIATES
INC.
INDIANAPOLIS, INDIANA

FALL CREEK REGIONAL WASTE DISTRICT

DIVISION 'A' & DIVISION 'B'

SHEET No. 44

INDEX MA-3

37+00

38+00


39+00

40+00

41+00

42+00

PANHANDLE EASTERN PIPELINE GAS LINES
CONTRACTOR TO USE EXTREME CAUTION IN THIS AREA
LINES ARE IN THERE APPROXIMATE LOCATION.
CONTRACTOR MUST VERIFY DEPTH AND LOCATION WITH
GAS CORP. BEFORE CONSTRUCTION

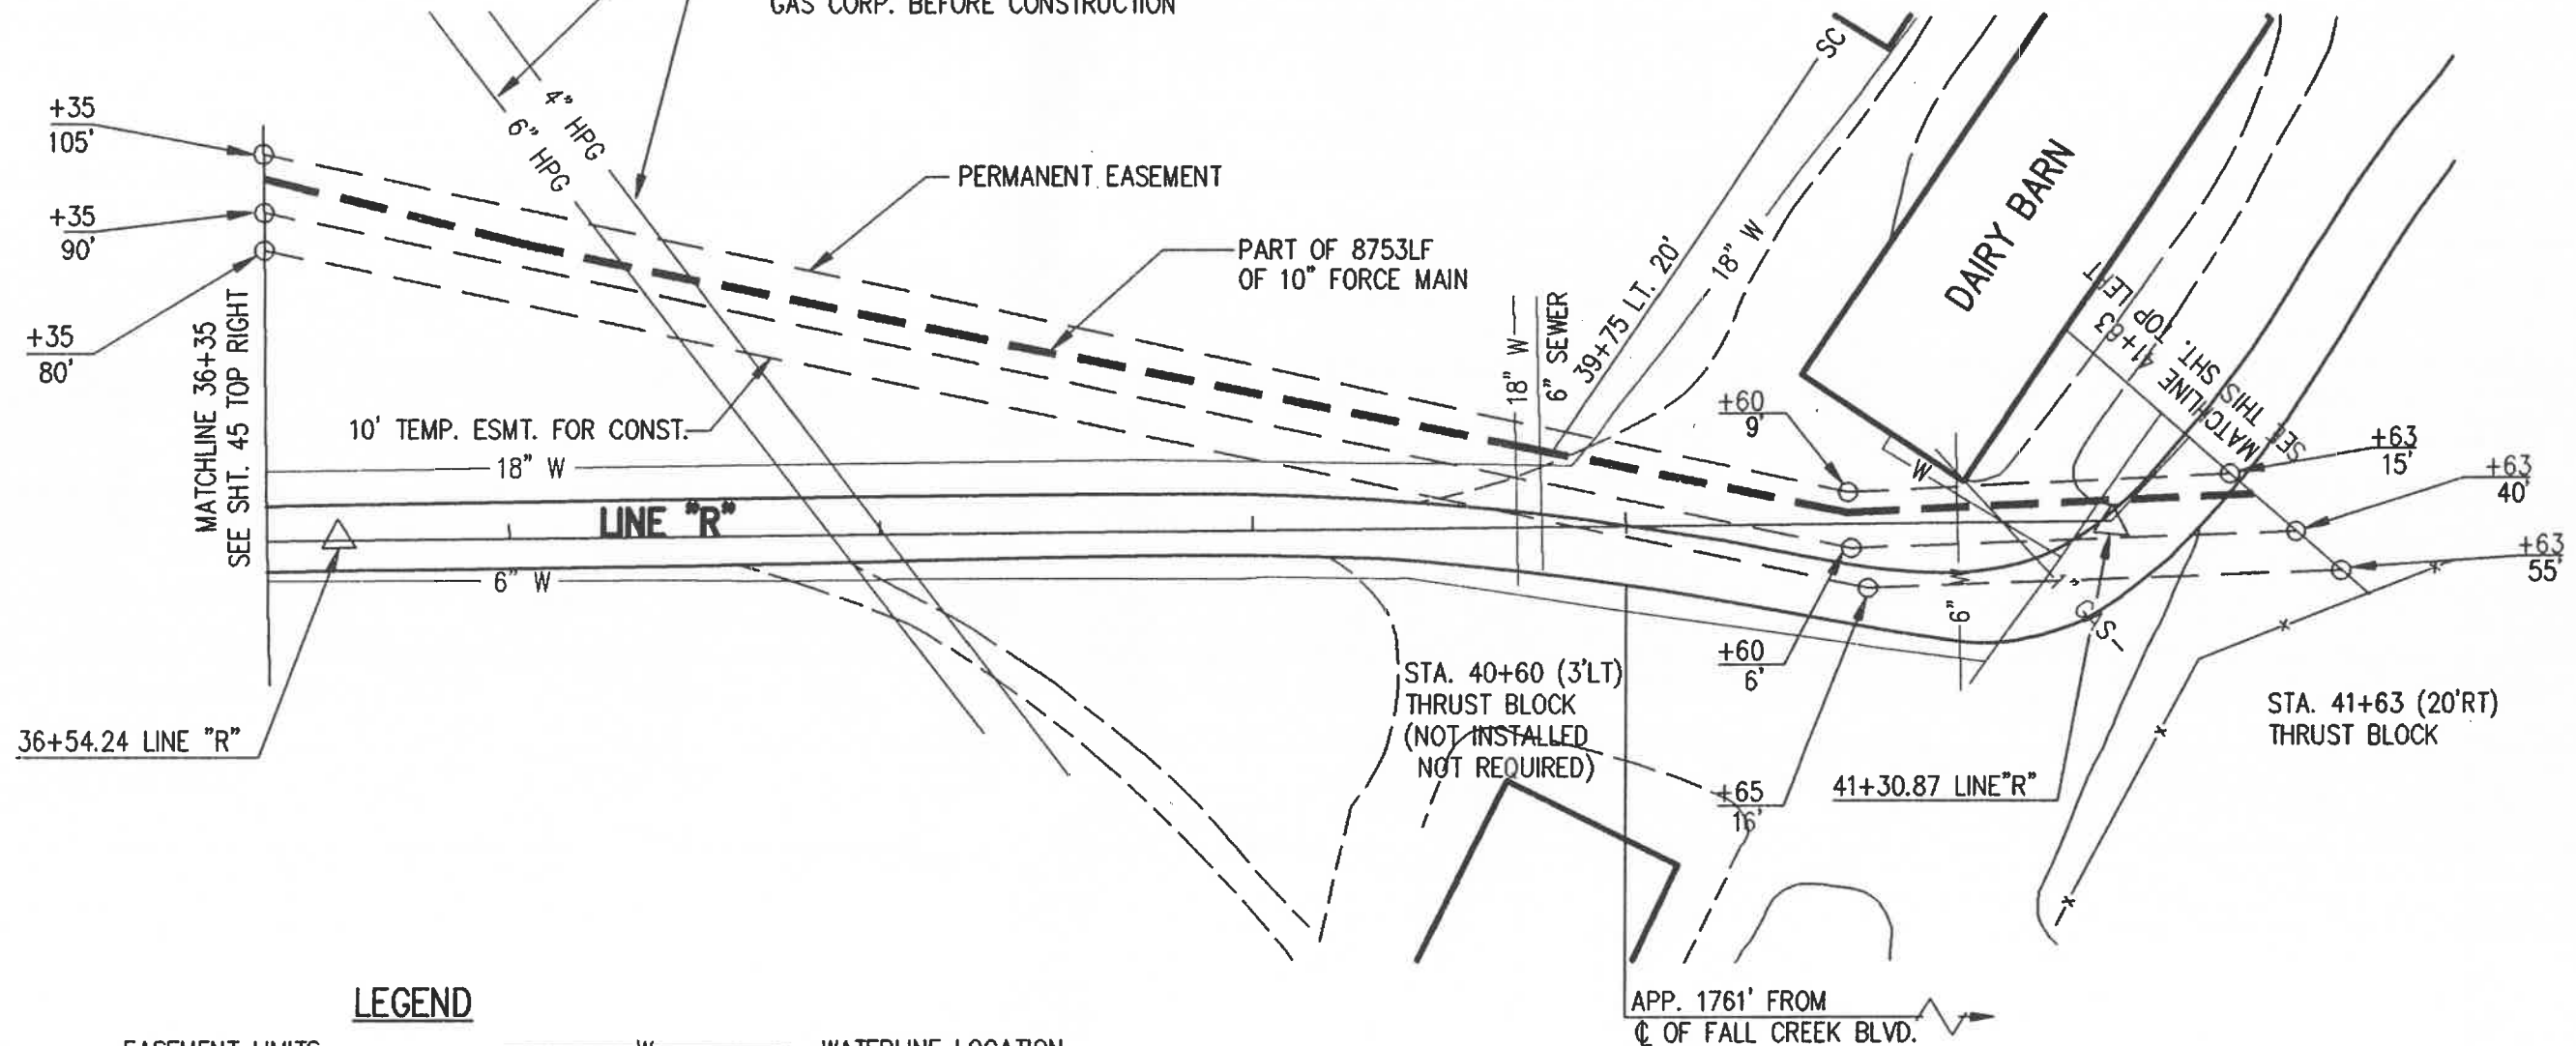

LEGEND

---	EASEMENT LIMITS	W	WATERLINE LOCATION
---	RIGHT-OF-WAY LIMITS	G	GAS LINE LOCATION
---	FORCE MAIN LOCATION	T	UNDERGROUND TELEPHONE
---	SANITARY SEWER LOCATION	x x x	FENCE LINE
---	STORM SEWER LOCATION	x	LIGHT POLE
SC	SANITARY SERVICE CONNECTION	■	POWER POLE

AS-BUILT INFORMATION

SCALE: 1" = 50'



NORTH

TRIAD
ASSOCIATES
INC.
INDIANAPOLIS, INDIANA