


**FALL CREEK REGIONAL
WASTE DISTRICT**
DIVISION 'A' & DIVISION 'B'
SHEET No. 37

INDEX MA-1

LEGEND

---	EASEMENT LIMITS	W	WATERLINE LOCATION
- - -	RIGHT-OF-WAY LIMITS	G	GAS LINE LOCATION
- - - - -	FORCE MAIN LOCATION	T	UNDERGROUND TELEPHONE
=====	SANITARY SEWER LOCATION	* * *	FENCE LINE
=====	STORM SEWER LOCATION	x	LIGHT POLE
SC	SANITARY SERVICE CONNECTION	■	POWER POLE

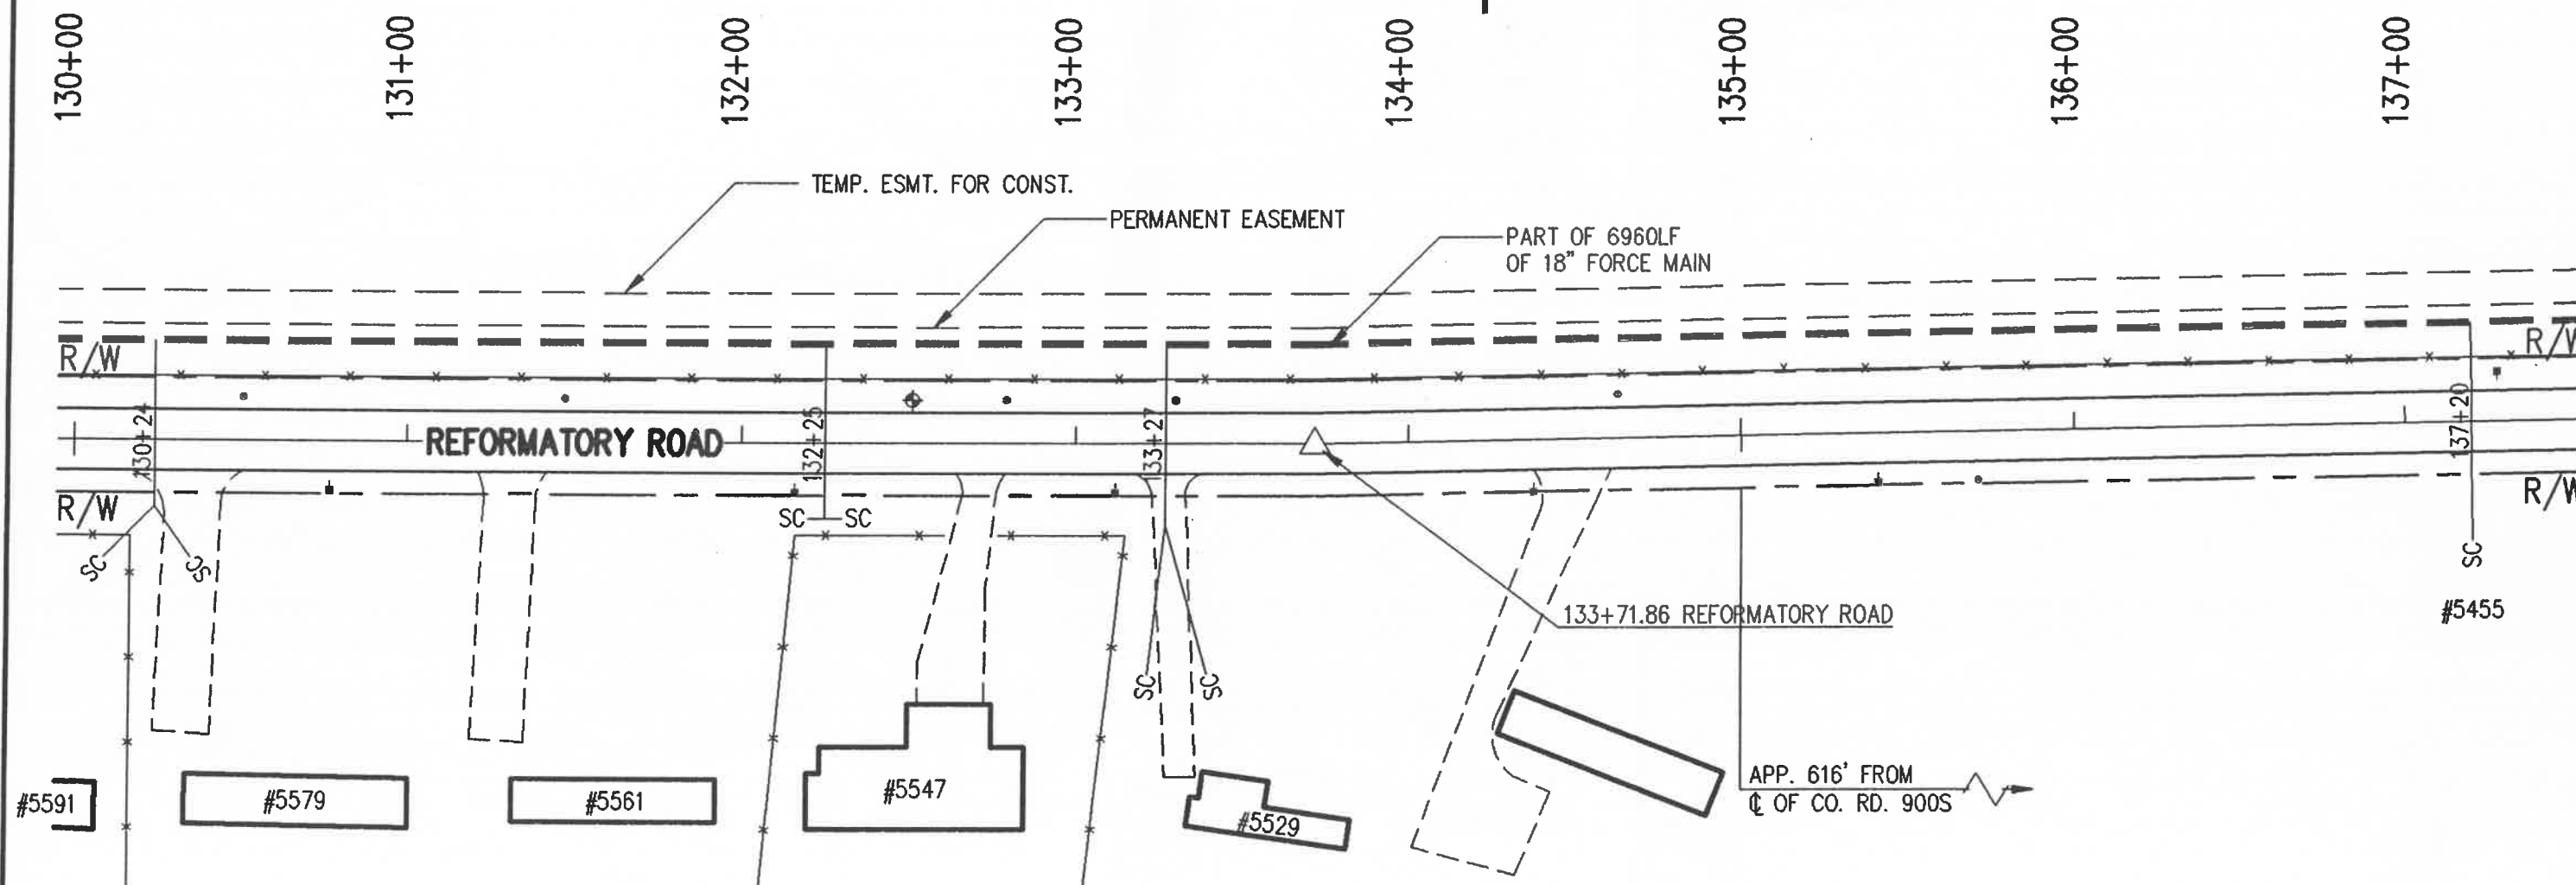

AS-BUILT INFORMATION

SCALE: 1" = 50'



**TRIAD
ASSOCIATES
INC.**
INDIANAPOLIS, INDIANA