


**FALL CREEK REGIONAL
WASTE DISTRICT
DIVISION 'A' & DIVISION 'B'
SHEET No. 37A**

INDEX MA-1

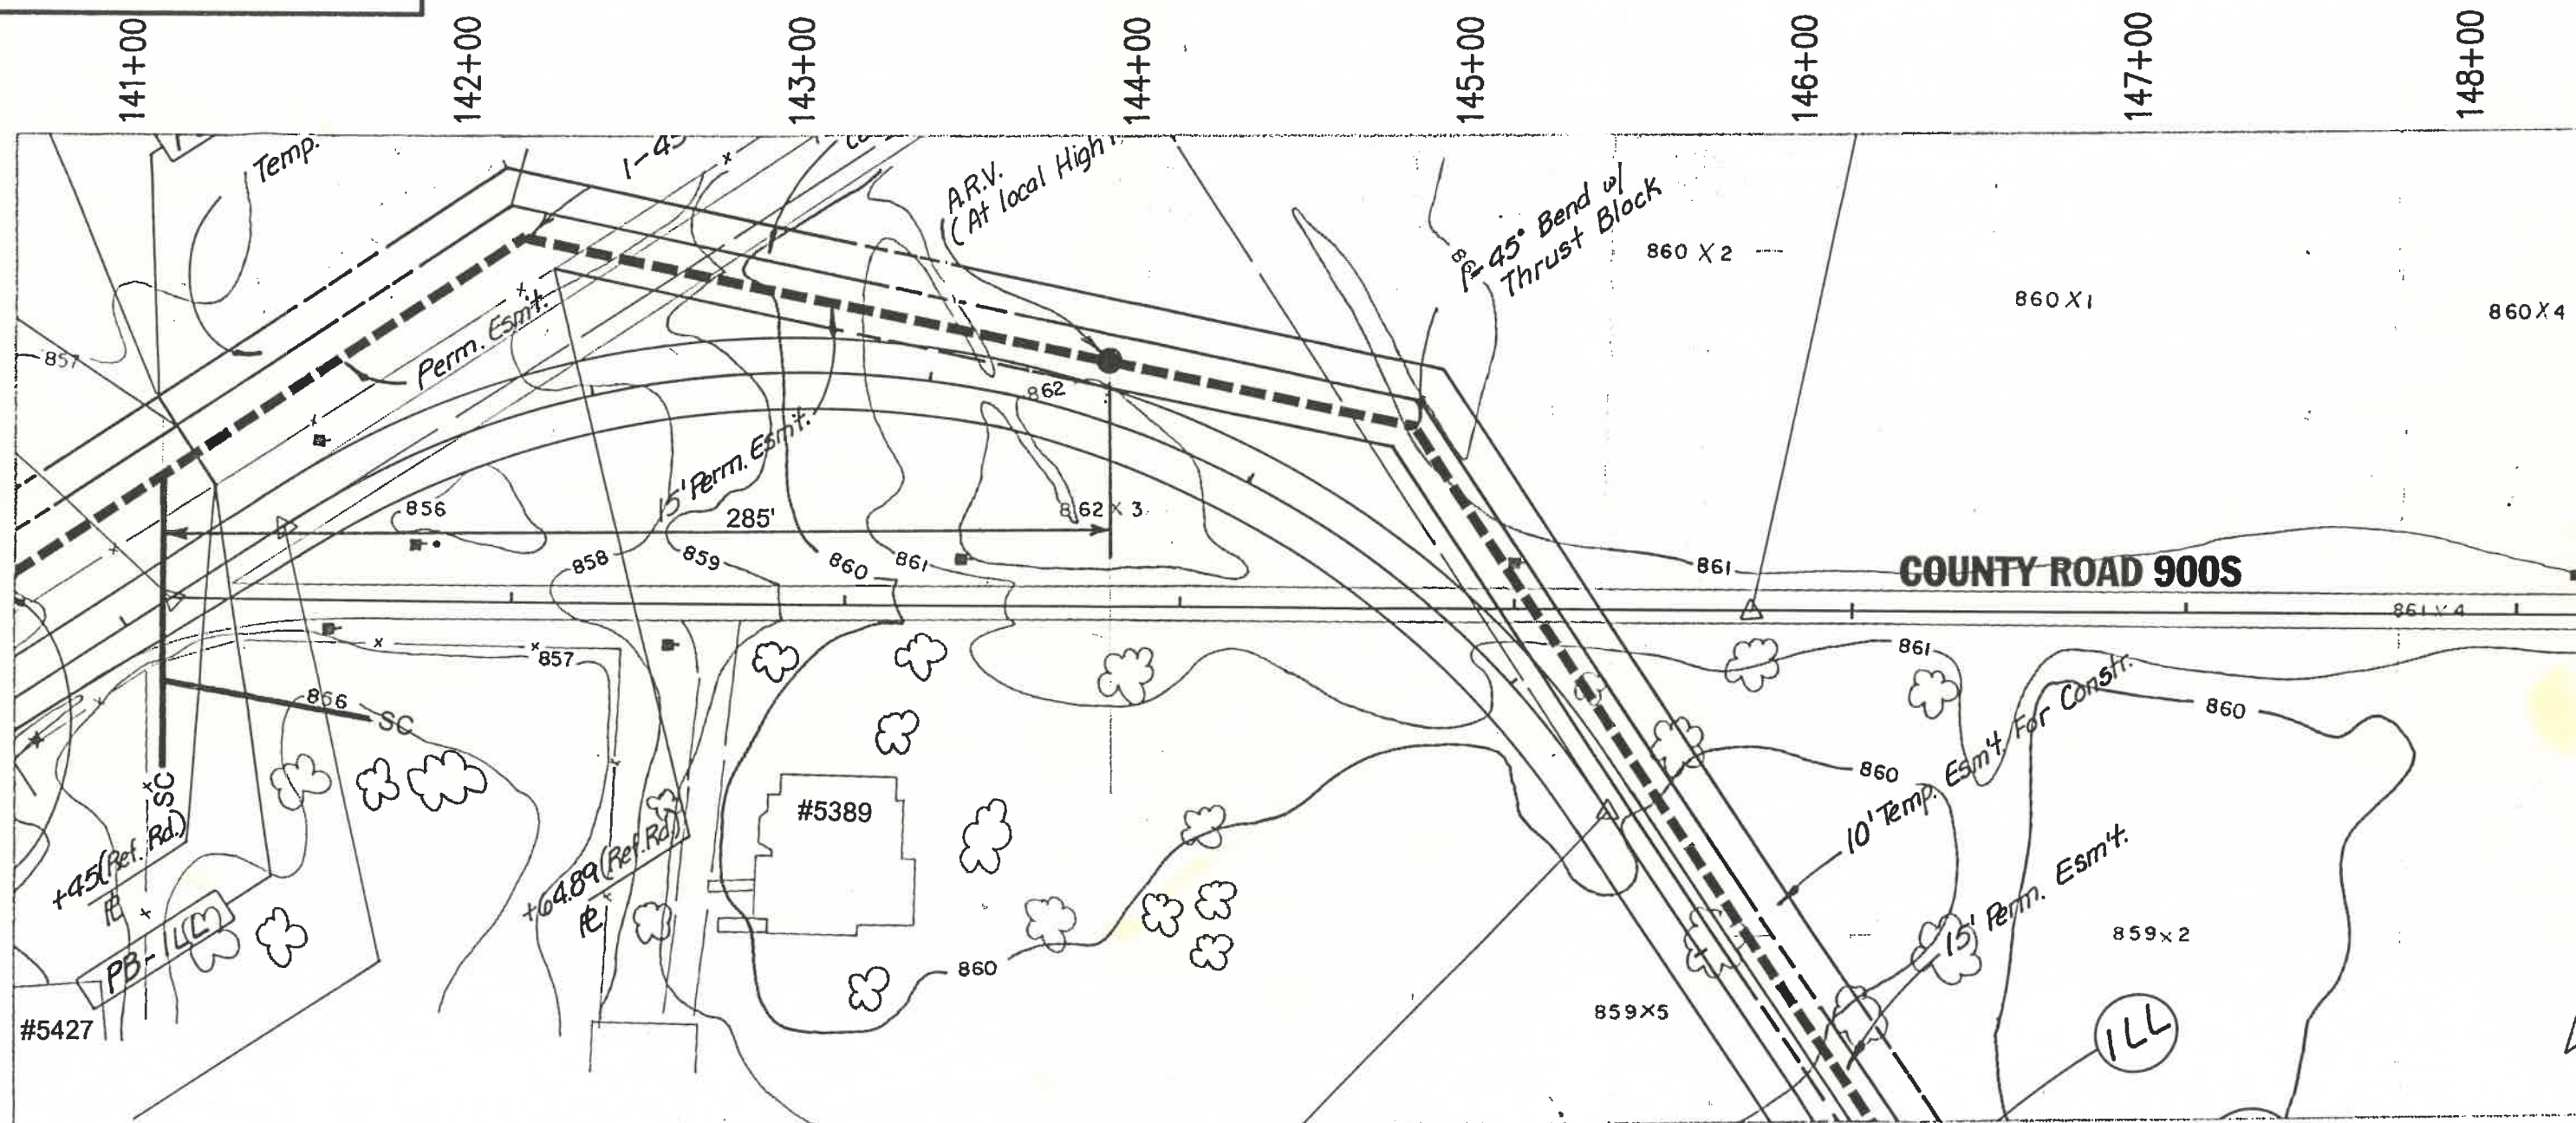

AS-BUILT INFORMATION

SCALE: 1" = 50'



**TRIAD
ASSOCIATES
INC.**

INDIANAPOLIS, INDIANA

