


FALL CREEK REGIONAL
WASTE DISTRICT
DIVISION 'A' & DIVISION 'B'
SHEET No. 41

INDEX MA-2

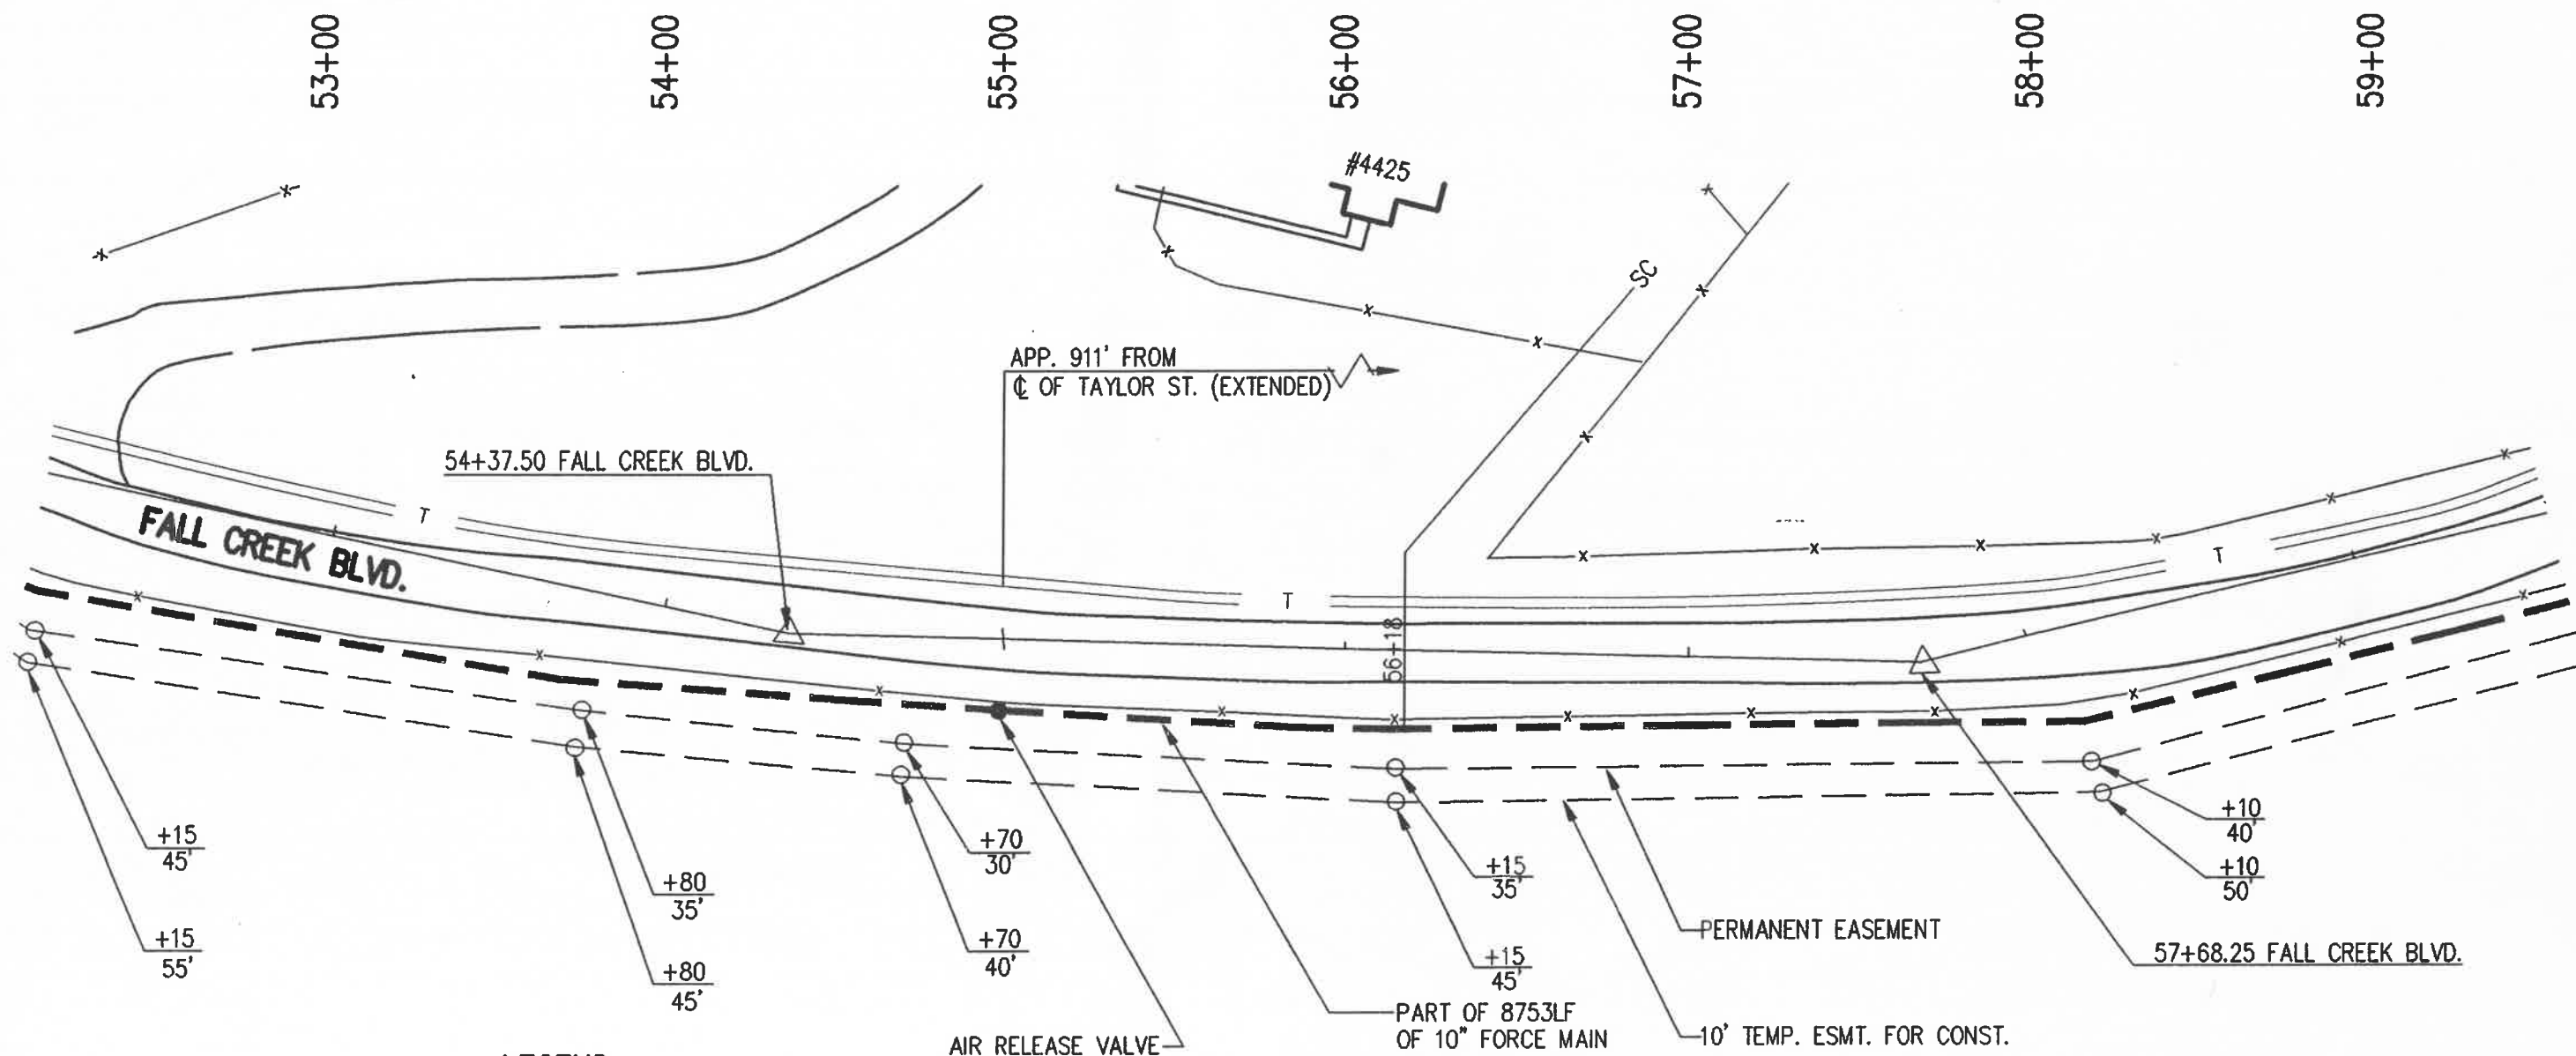

LEGEND

---	EASEMENT LIMITS	W	WATERLINE LOCATION
- - -	RIGHT-OF-WAY LIMITS	G	GAS LINE LOCATION
- - - - -	FORCE MAIN LOCATION	T	UNDERGROUND TELEPHONE
—	SANITARY SEWER LOCATION	x x x	FENCE LINE
=====	STORM SEWER LOCATION	x	LIGHT POLE
—SC	SANITARY SERVICE CONNECTION	■	POWER POLE

AS-BUILT INFORMATION

SCALE: 1" = 50'



TRIAD
ASSOCIATES
INC.
INDIANAPOLIS, INDIANA