

FALL CREEK REGIONAL WASTE DISTRICT

DIVISION 'A' & DIVISION 'B'

SHEET No. 44

INDEX MA-3

37+00

38+00


39+00

40+00

41+00

42+00

PANHANDLE EASTERN PIPELINE GAS LINES
CONTRACTOR TO USE EXTREME CAUTION IN THIS AREA
LINES ARE IN THERE APPROXIMATE LOCATION.
CONTRACTOR MUST VERIFY DEPTH AND LOCATION WITH
GAS CORP. BEFORE CONSTRUCTION

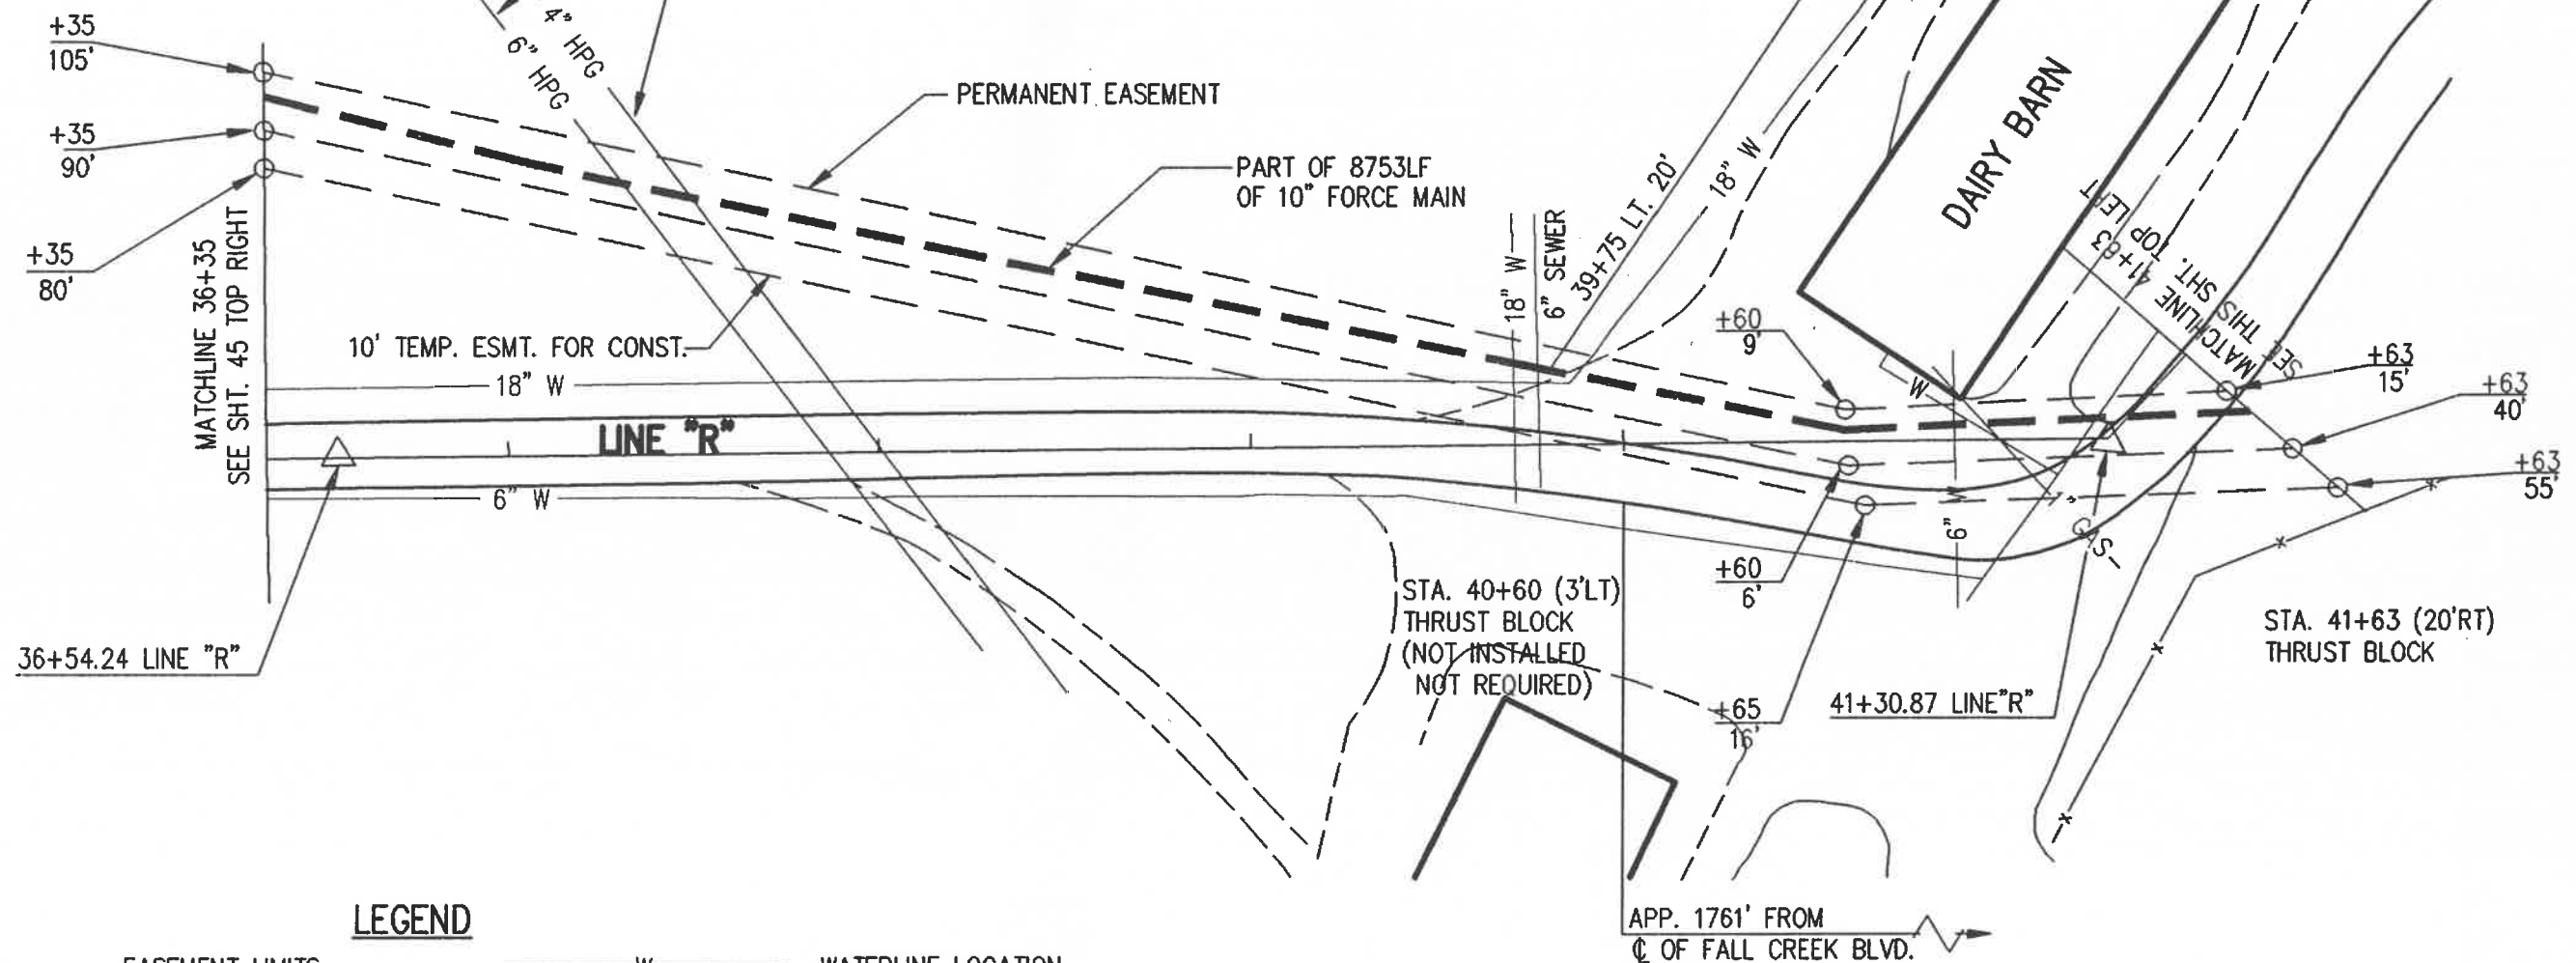

LEGEND

---	EASEMENT LIMITS	W	WATERLINE LOCATION
---	RIGHT-OF-WAY LIMITS	G	GAS LINE LOCATION
---	FORCE MAIN LOCATION	T	UNDERGROUND TELEPHONE
---	SANITARY SEWER LOCATION	x x x	FENCE LINE
---	STORM SEWER LOCATION	x	LIGHT POLE
SC	SANITARY SERVICE CONNECTION	■	POWER POLE

AS-BUILT INFORMATION

SCALE: 1" = 50'



NORTH

TRIAD
ASSOCIATES
INC.
INDIANAPOLIS, INDIANA