

FALL CREEK REGIONAL WASTE DISTRICT

DIVISION 'C'

SHEET No. 68

INDEX MA-5


KEYNOTES

- (A) MH #340
T.C. = 902.70
INV.(N) = 897.26
- (B) MH #339
T.C. = 902.18
INV.(S) = 896.57
INV.(E) = 896.06
- (C) CAPPED END
INV.(N) = 898.44

LEGEND

---	EASEMENT LIMITS	W	WATERLINE LOCATION
- - -	RIGHT-OF-WAY LIMITS	G	GAS LINE LOCATION
---	FORCE MAIN LOCATION	T	UNDERGROUND TELEPHONE
---	SANITARY SEWER LOCATION	* * *	FENCE LINE
==	STORM SEWER LOCATION	x	LIGHT POLE
SC	SANITARY SERVICE CONNECTION	-	POWER POLE

LATERAL DEPTH FROM GRADE
PLUG DISTANCE FROM MAIN

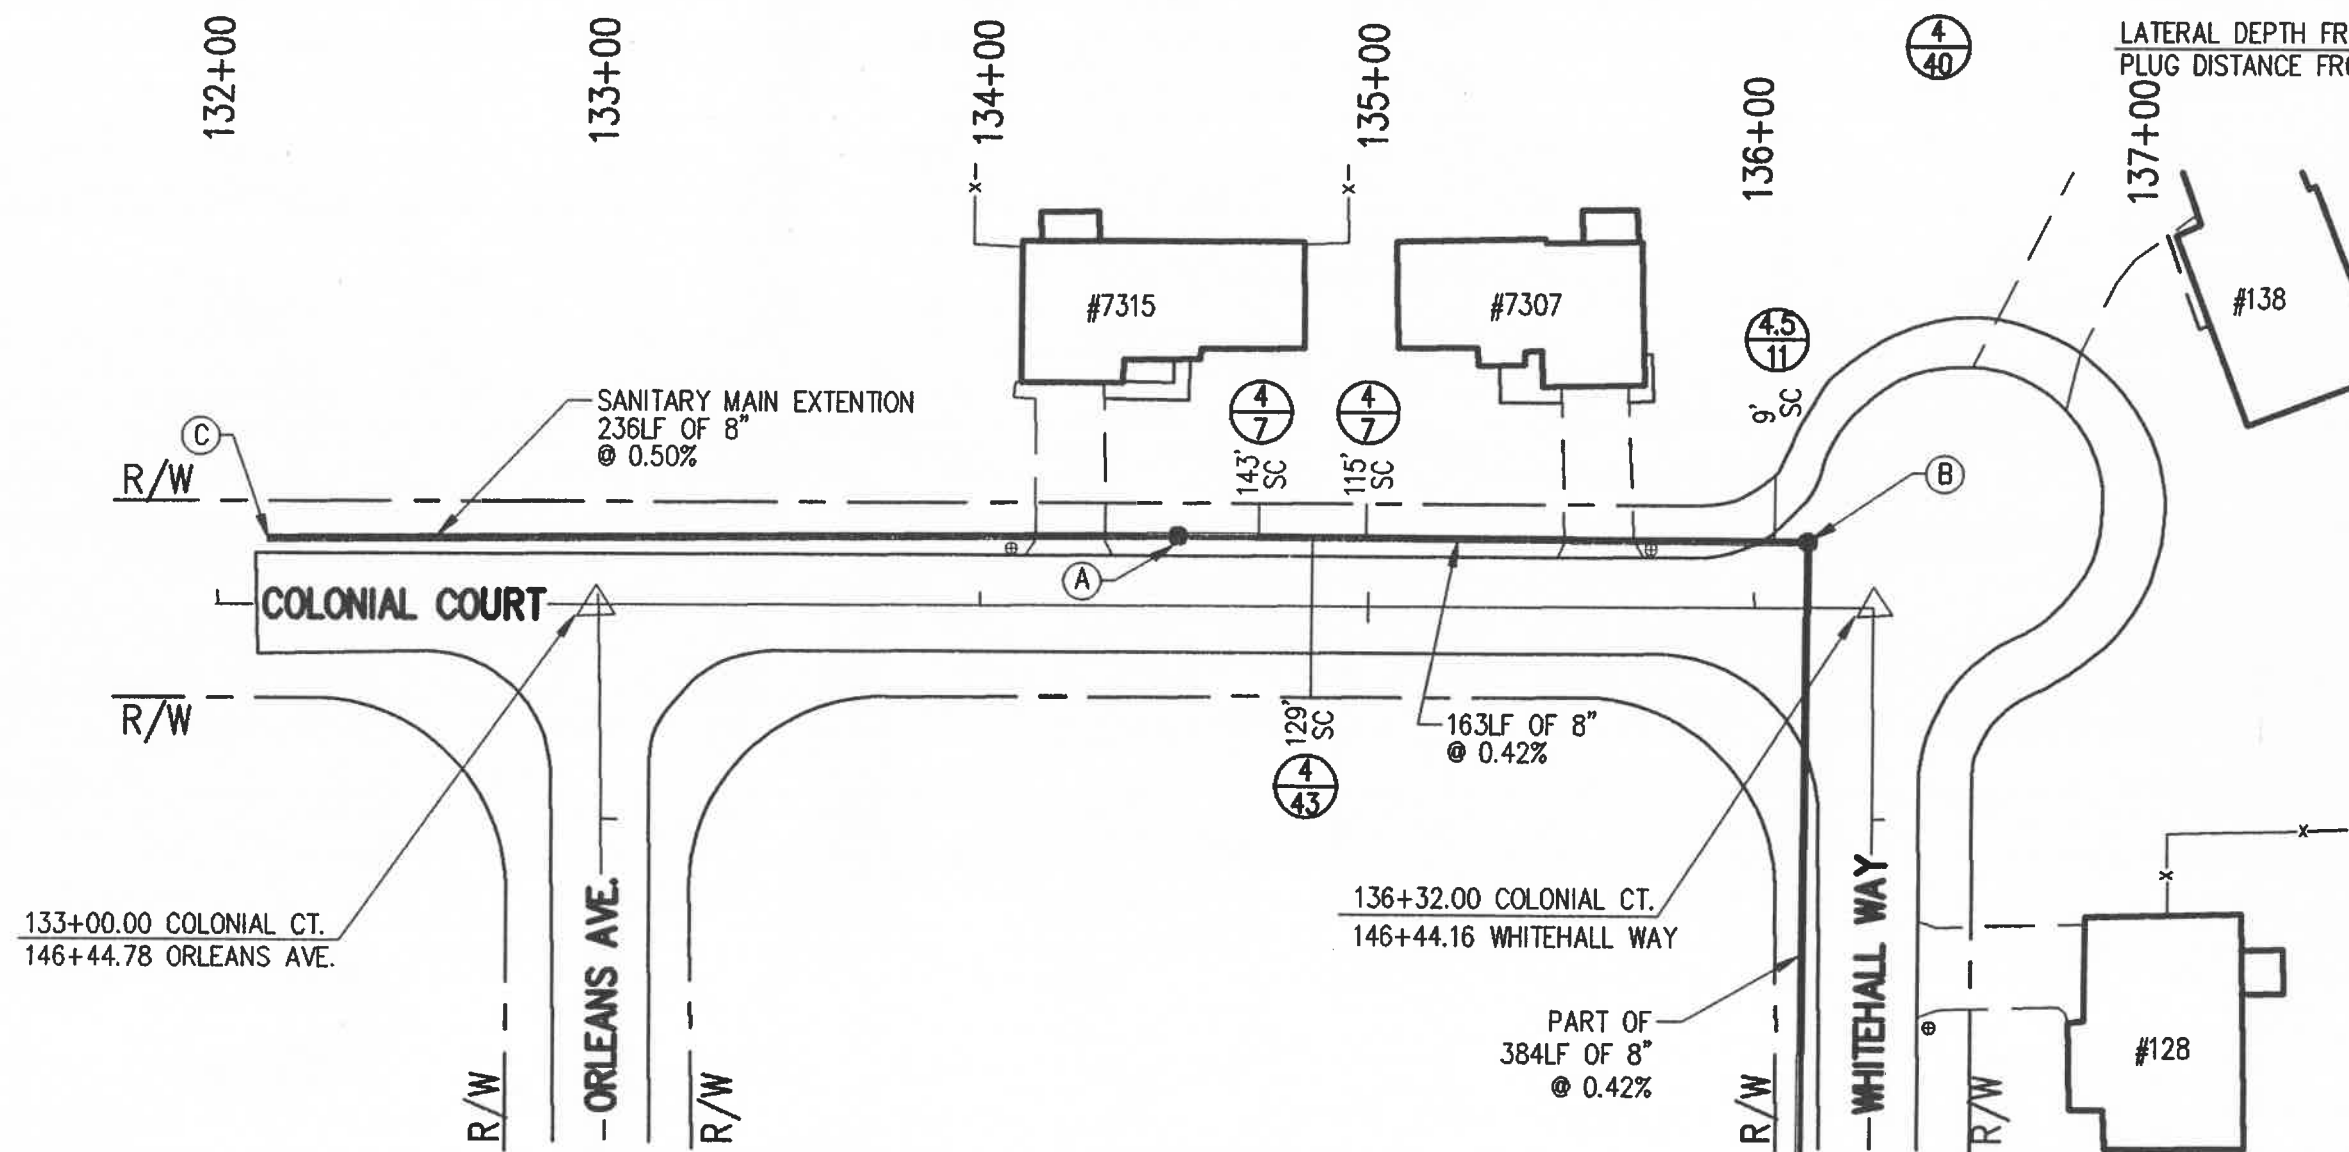

AS-BUILT INFORMATION

SCALE: 1" = 50'



TRIAD
ASSOCIATES
INC.

INDIANAPOLIS, INDIANA

