

FALL CREEK REGIONAL WASTE DISTRICT

DIVISION 'C'

SHEET No. 24

INDEX MA-6

LEGEND


---	EASEMENT LIMITS	W	WATERLINE LOCATION
- - -	RIGHT-OF-WAY LIMITS	G	GAS LINE LOCATION
---	FORCE MAIN LOCATION	T	UNDERGROUND TELEPHONE
---	SANITARY SEWER LOCATION	* * *	FENCE LINE
==	STORM SEWER LOCATION	x	LIGHT POLE
SC	SANITARY SERVICE CONNECTION	-	POWER POLE

4
40

LATERAL DEPTH FROM GRADE
PLUG DISTANCE FROM MAIN

KEYNOTES

- (A) MH #166
T.C. = 880.74
INV.(N) = 876.70
- (B) MH #165A
T.C. = 883.75
INV.(N) = 876.16
INV.(S&W) = 876.24
- (C) MH #165B
T.C. = 884.94
INV.(E) = 876.98

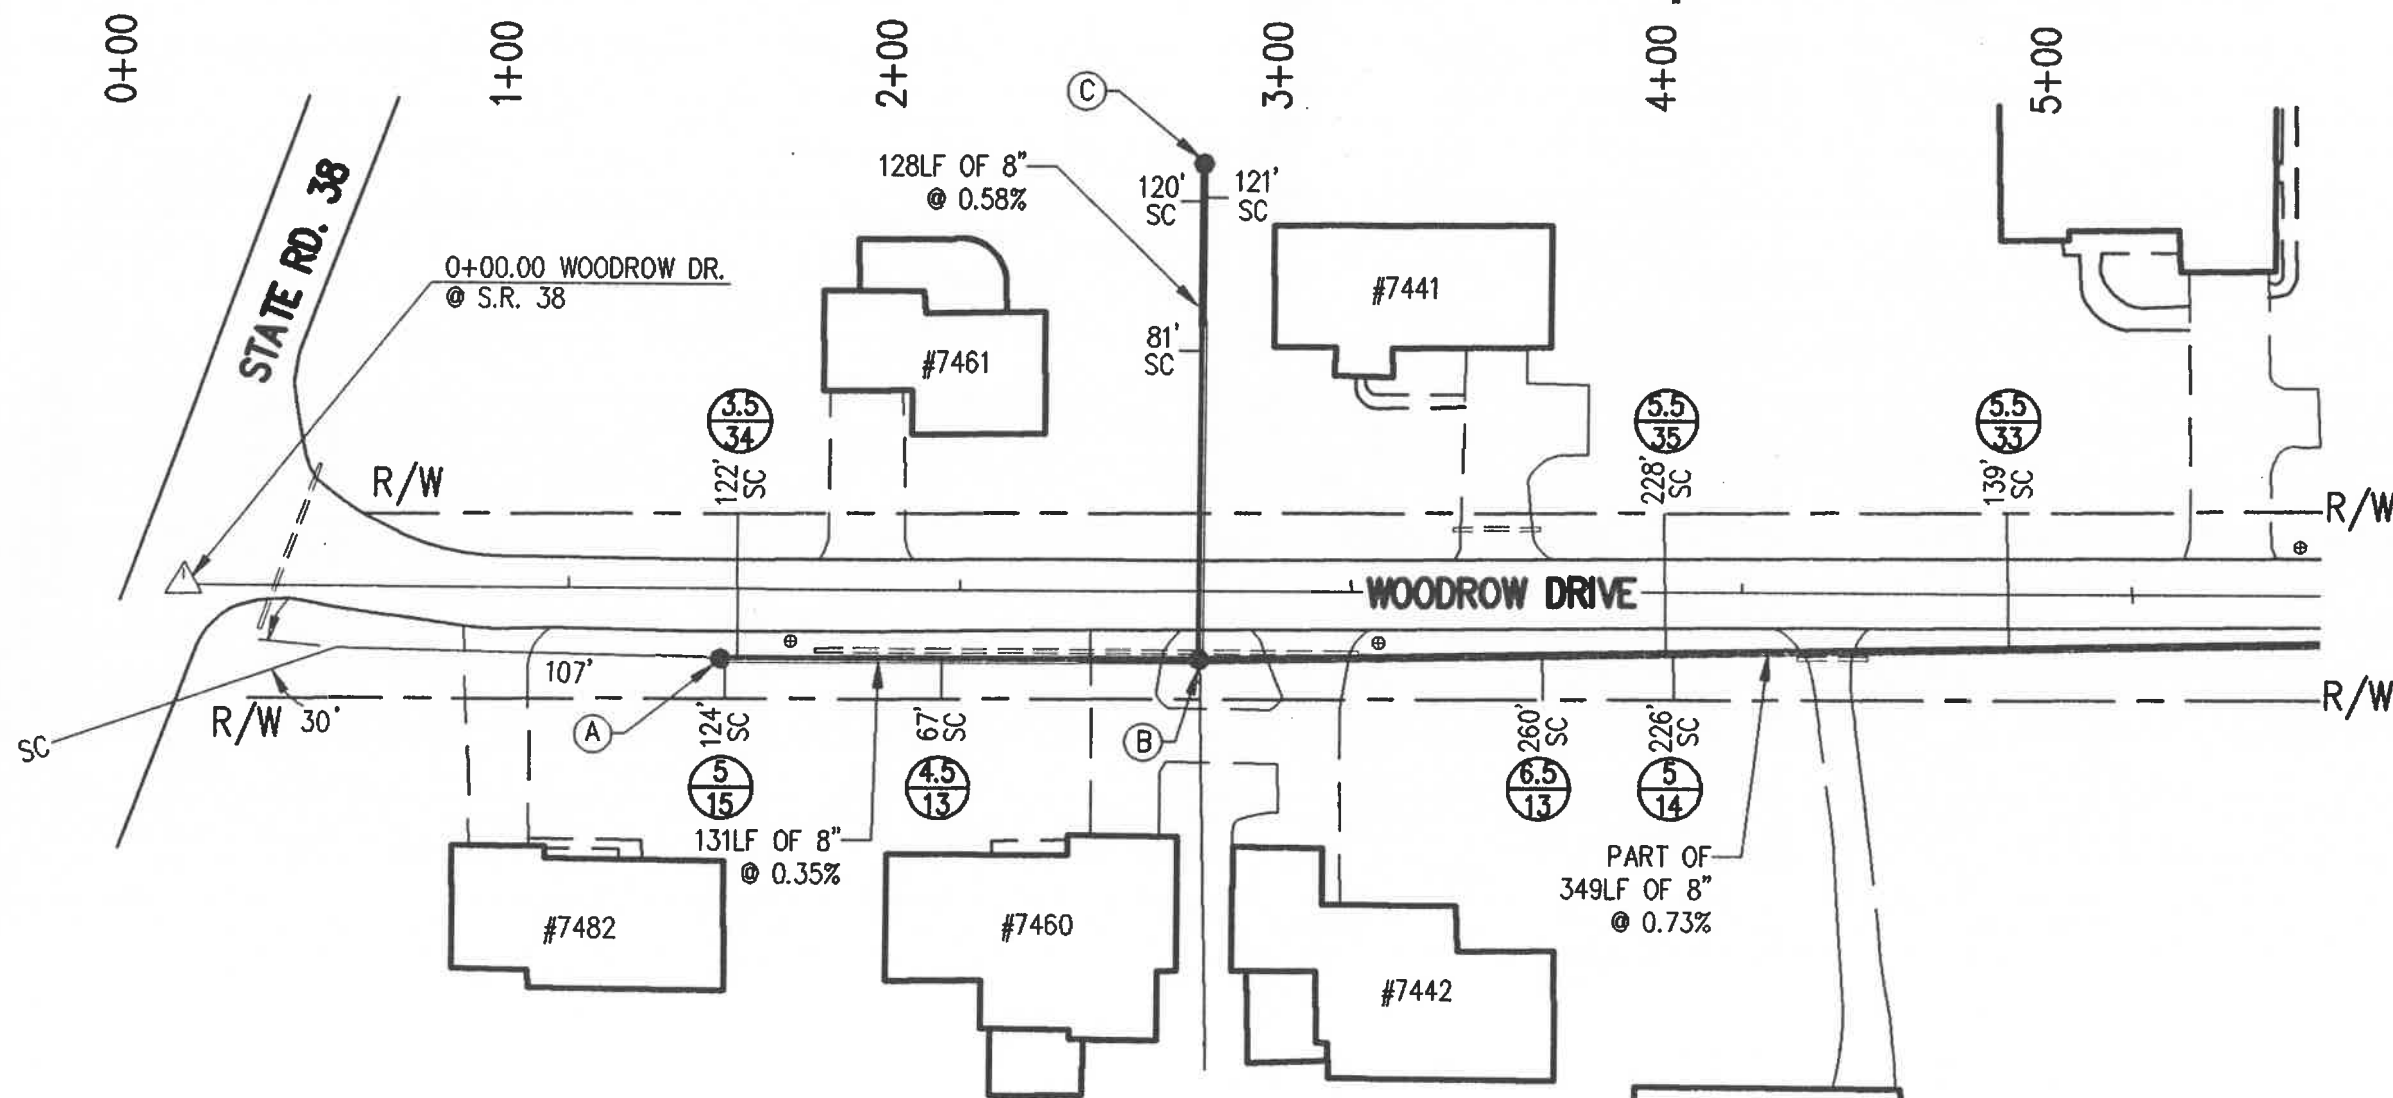

AS-BUILT INFORMATION

SCALE: 1" = 50'



TRIAD
ASSOCIATES
INC.
INDIANAPOLIS, INDIANA