


FALL CREEK REGIONAL
WASTE DISTRICT
DIVISION 'A' & DIVISION 'B'
SHEET No. 58d

INDEX MA-8

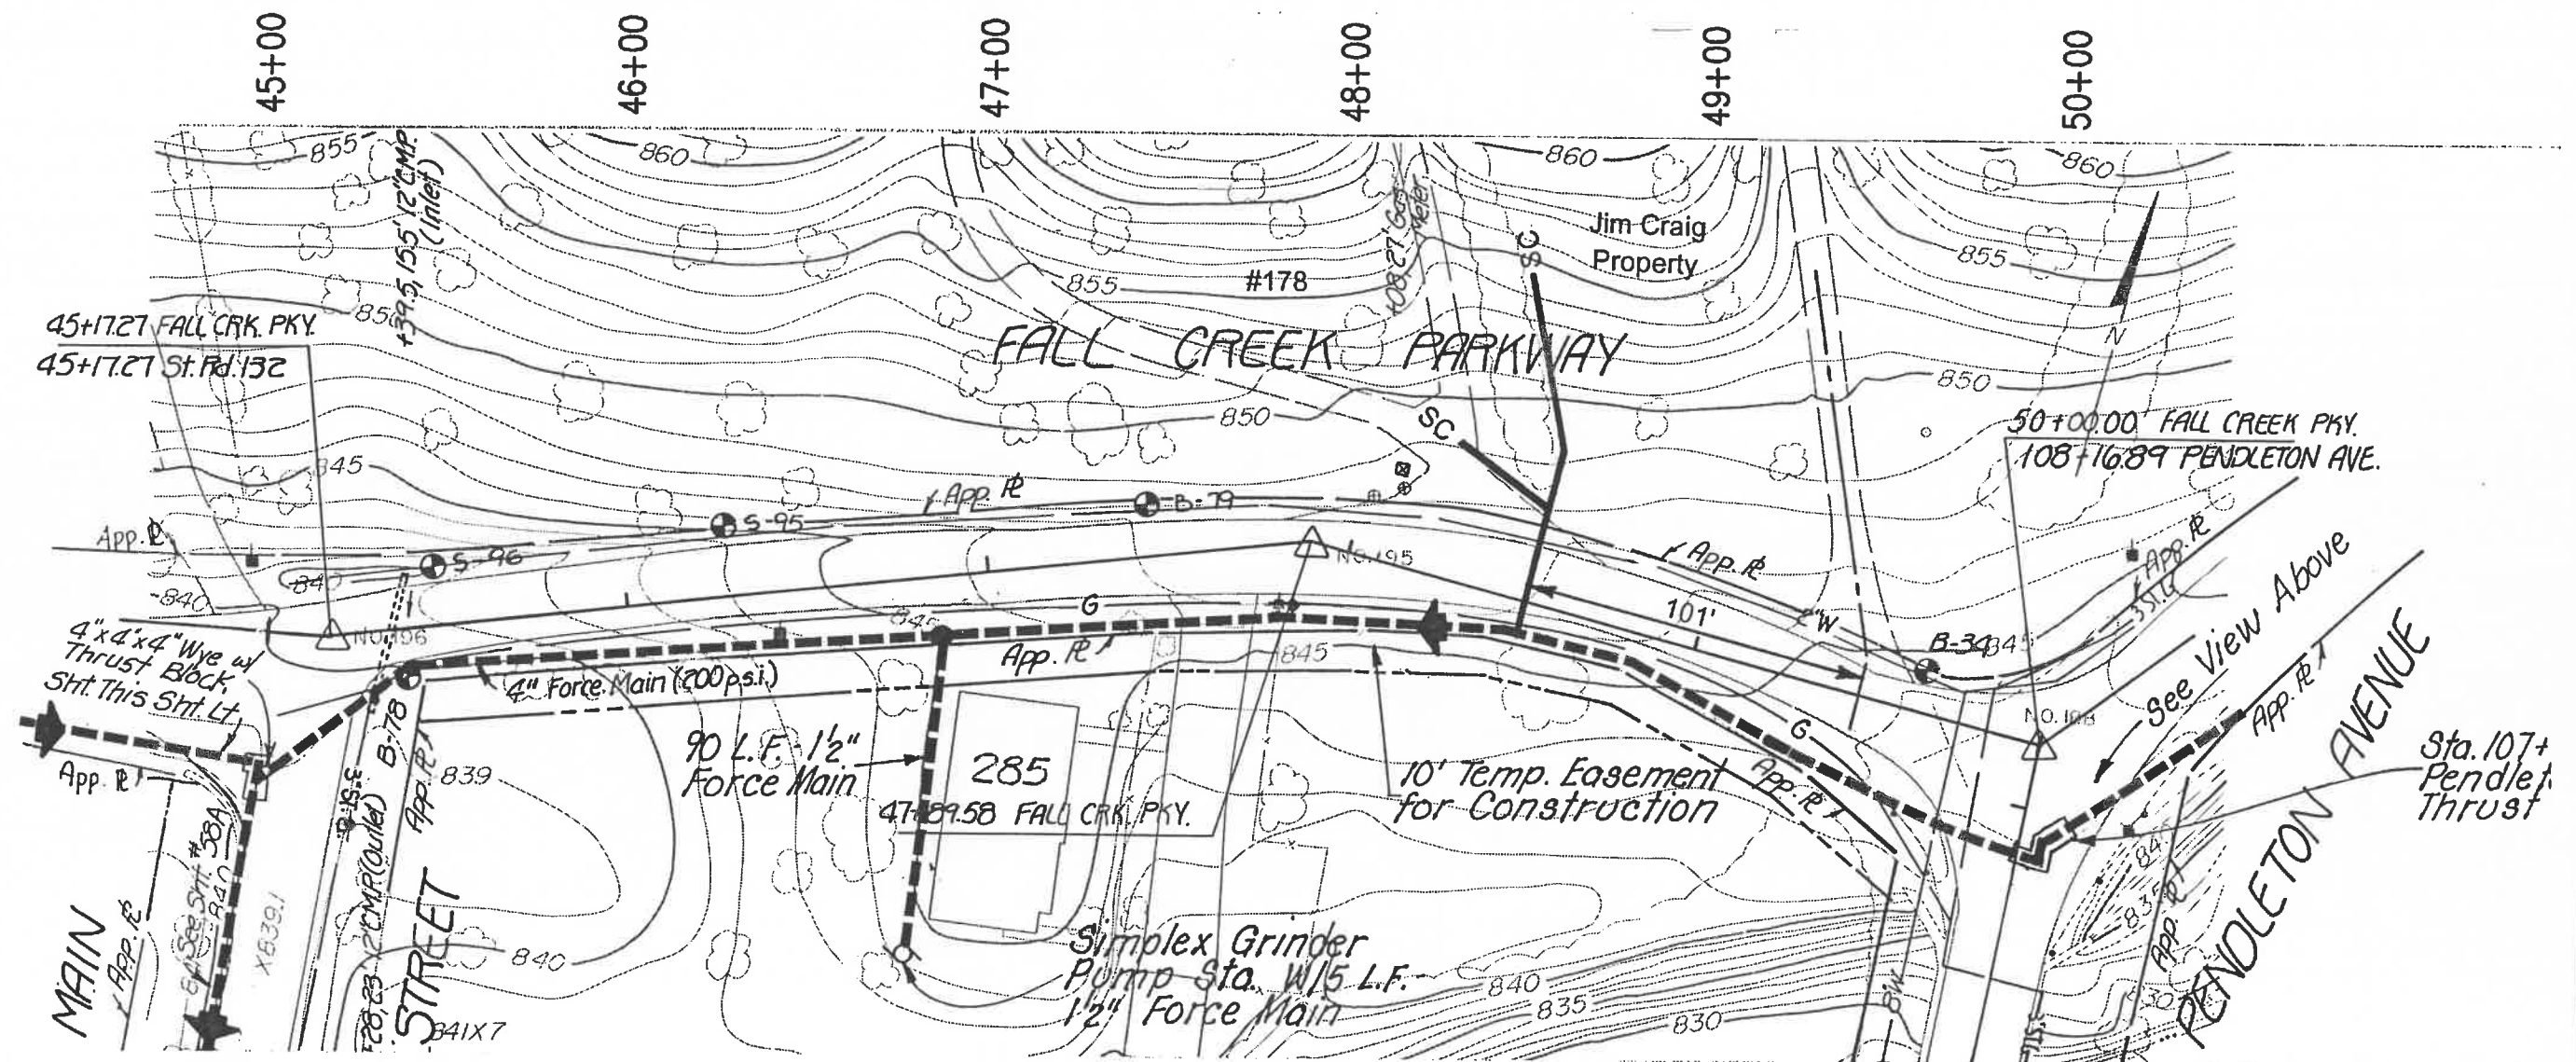

AS-BUILT INFORMATION

SCALE: 1" = 50'



TRIAD
ASSOCIATES
INC.

INDIANAPOLIS, INDIANA

