


FALL CREEK REGIONAL
WASTE DISTRICT

DIVISION 'C'

SHEET No. 20a

INDEX MA-9

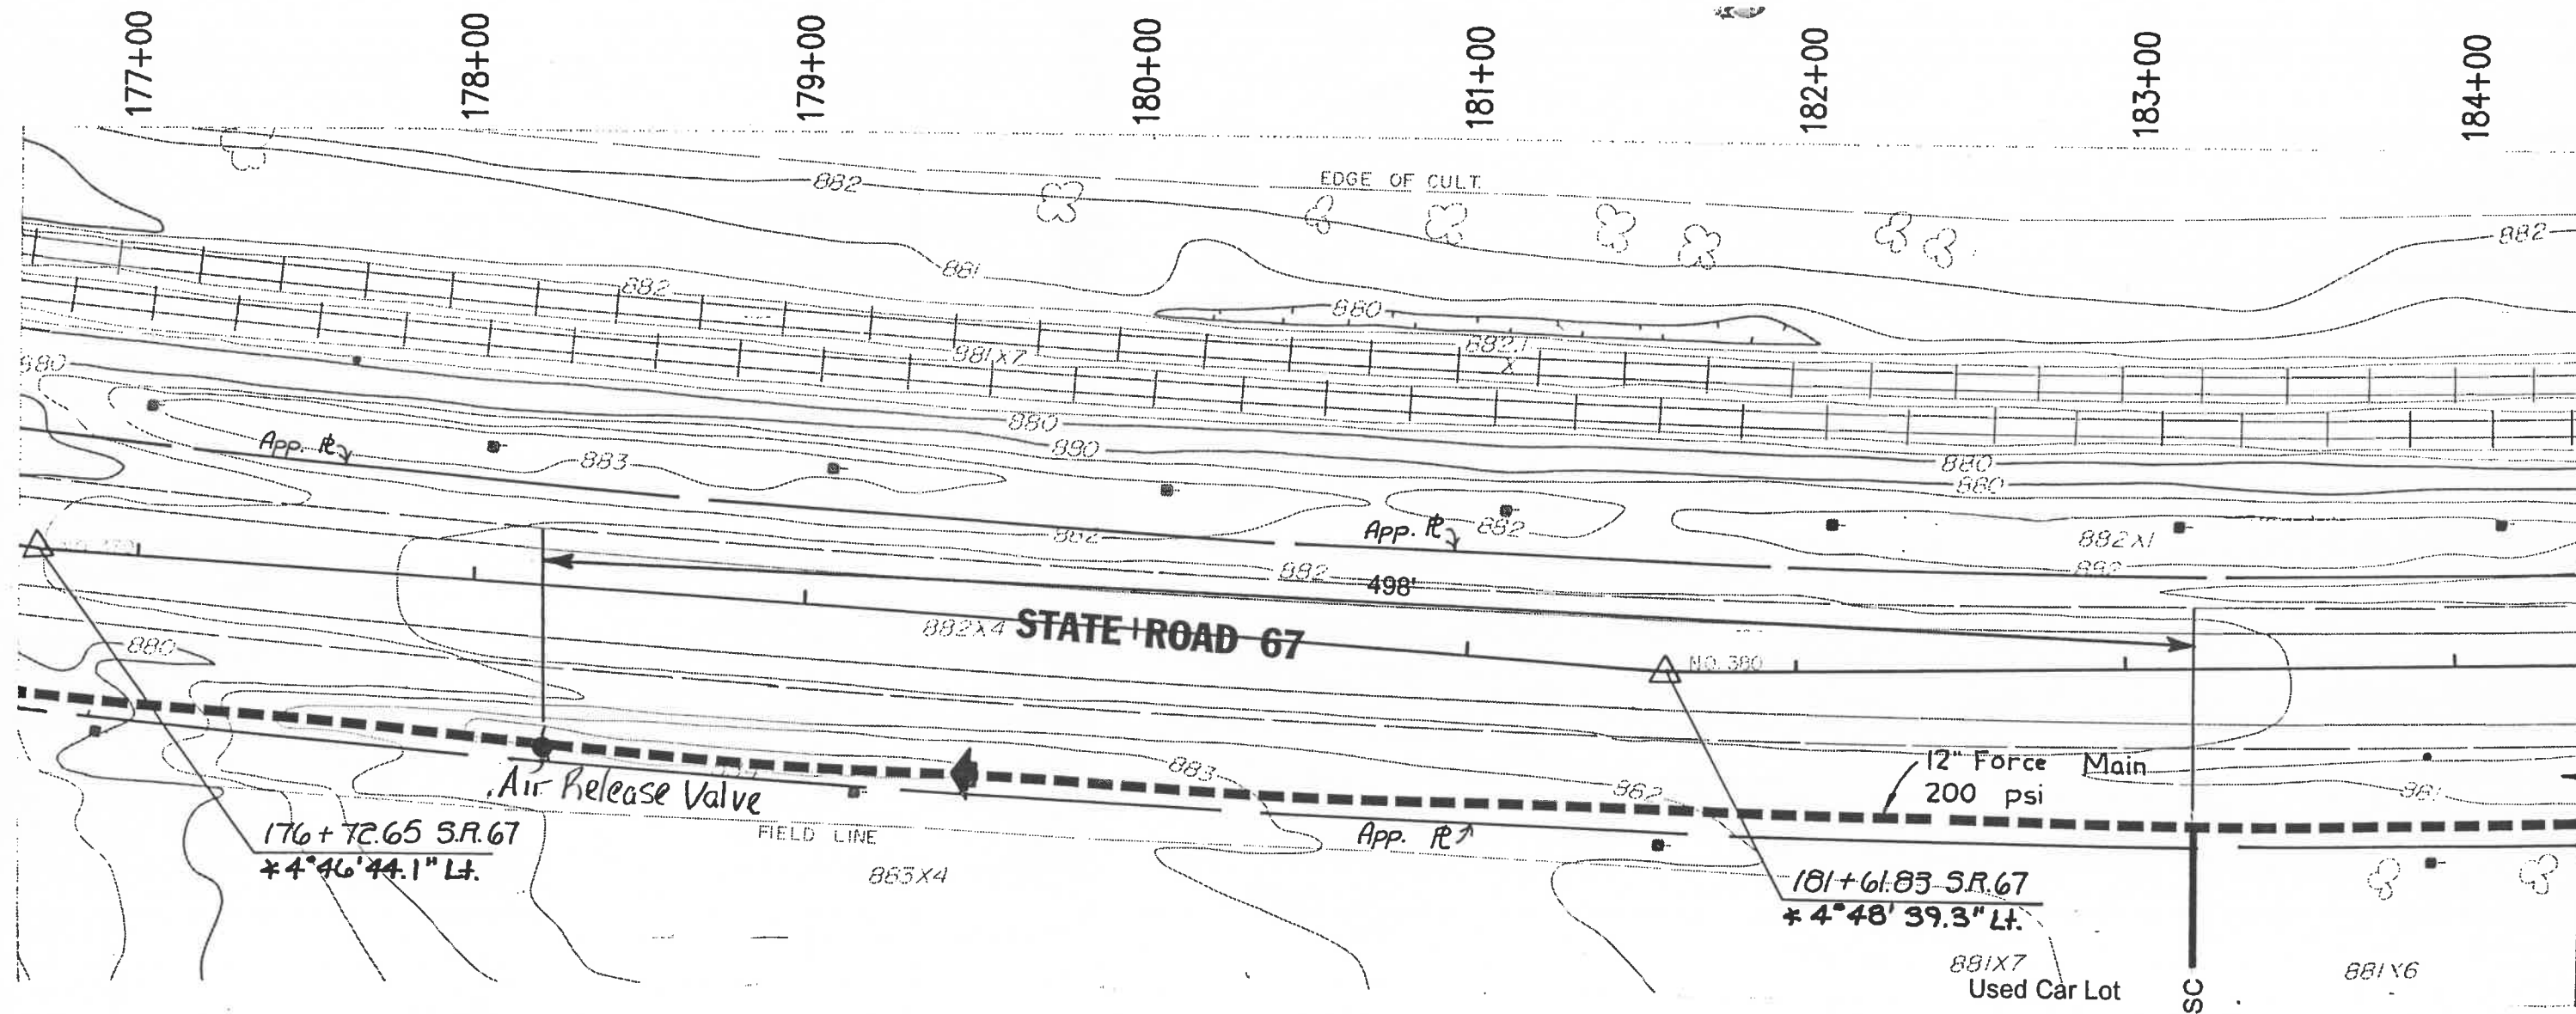

AS-BUILT INFORMATION

SCALE: 1" = 50'



NORTH

TRIAD
ASSOCIATES
INC.

INDIANAPOLIS, INDIANA

