


FALL CREEK REGIONAL
WASTE DISTRICT
EAST STREET AND
PENDLETON ROAD

INDEX SA-8

KEYNOTES

- (A) MH #62
TC = 867.14
INV. = 858.94
(B) MH #62A
TC = 866.98
INV. = 860.38
(C) CO #62B
TC = 868.60

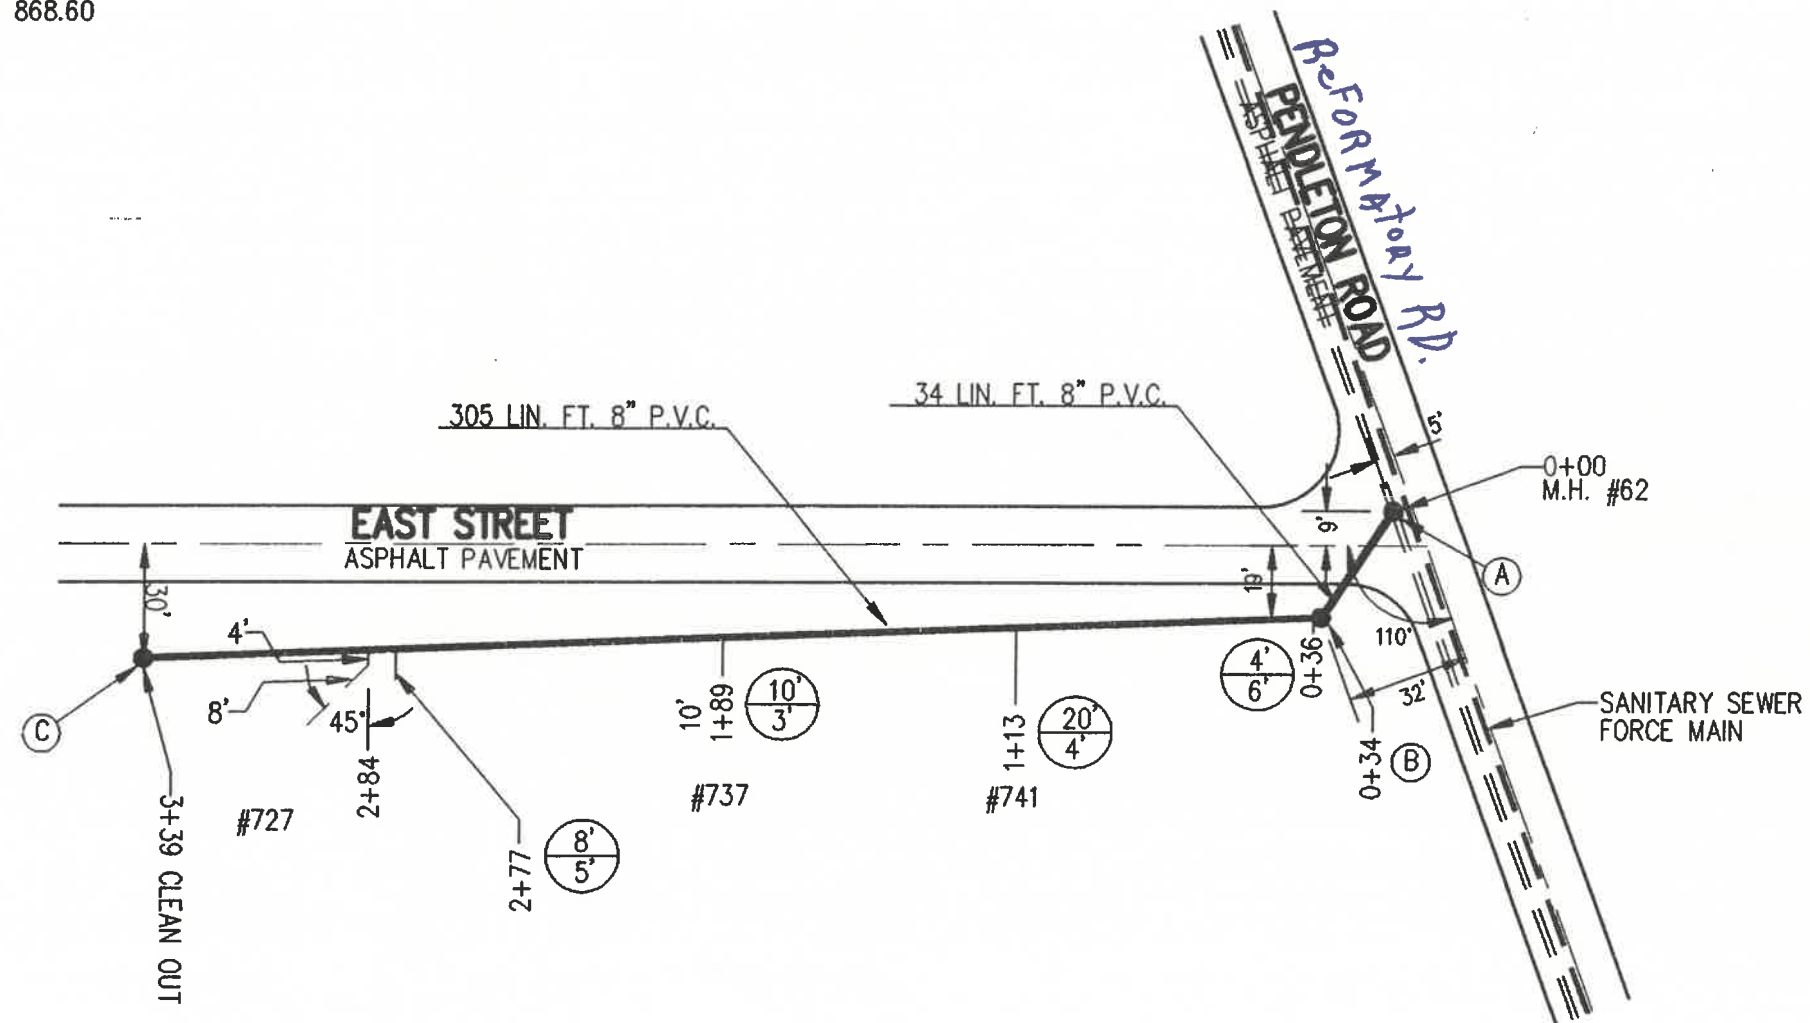

LEGEND

---	EASEMENT LIMITS	W	WATERLINE LOCATION
- - -	RIGHT-OF-WAY LIMITS	G	GAS LINE LOCATION
- - - - -	FORCE MAIN LOCATION	T	UNDERGROUND TELEPHONE
=====	SANITARY SEWER LOCATION	* * *	FENCE LINE
=====	STORM SEWER LOCATION	X	LIGHT POLE
---SC	SANITARY SERVICE CONNECTION	■	POWER POLE

AS-BUILT INFORMATION

SCALE: 1" = 50'



TRIAD
ASSOCIATES
INC.
INDIANAPOLIS, INDIANA