

SHEET No. 36a

INDEX MA-1

97+00

98+00

99+00


100+00

101+00

102+00

103+00

104+00

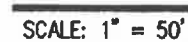

**TRIAD
ASSOCIATES
INC.**

INDIANAPOLIS, INDIANA

