

FALL CREEK REGIONAL
WASTE DISTRICT
DIVISION 'A' & DIVISION 'B'
SHEET No. 36d

INDEX MA-1

119+00

120+00

121+00


122+00

123+00

124+00

125+00

126+00

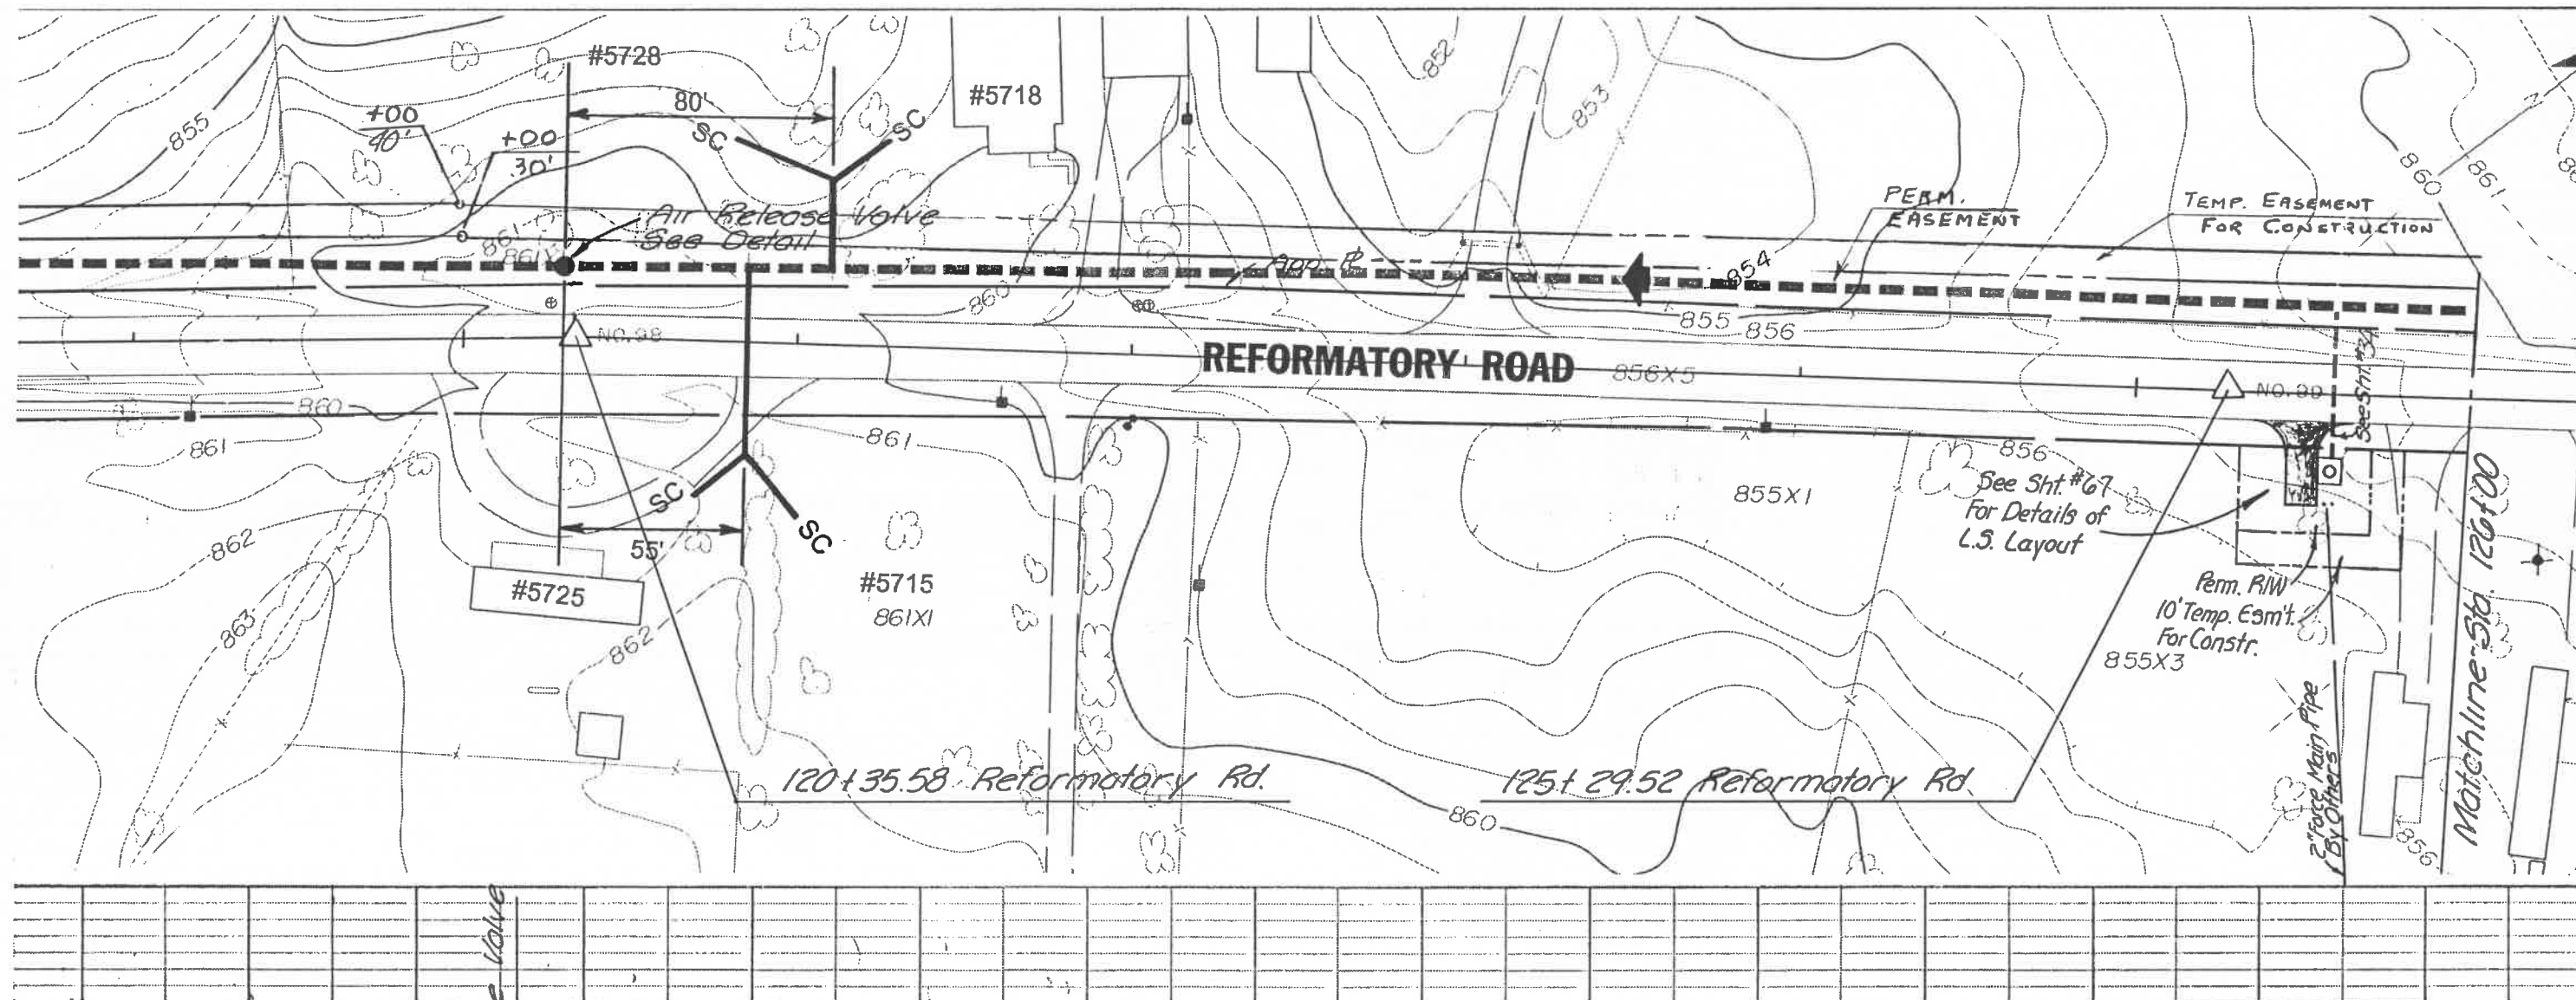

AS-BUILT INFORMATION

SCALE: 1" = 50'



TRIAD
ASSOCIATES
INC.

INDIANAPOLIS, INDIANA

