




HOR. 1" = 50'  
VER. 1" = 10'

① = Depth Of 6" Sanitary Stub  
Horizontal Distance To Stub  
From Nearest Downstream Manhole


Human Est.  
Cree Host  
Phase 2  
Phases 1-6

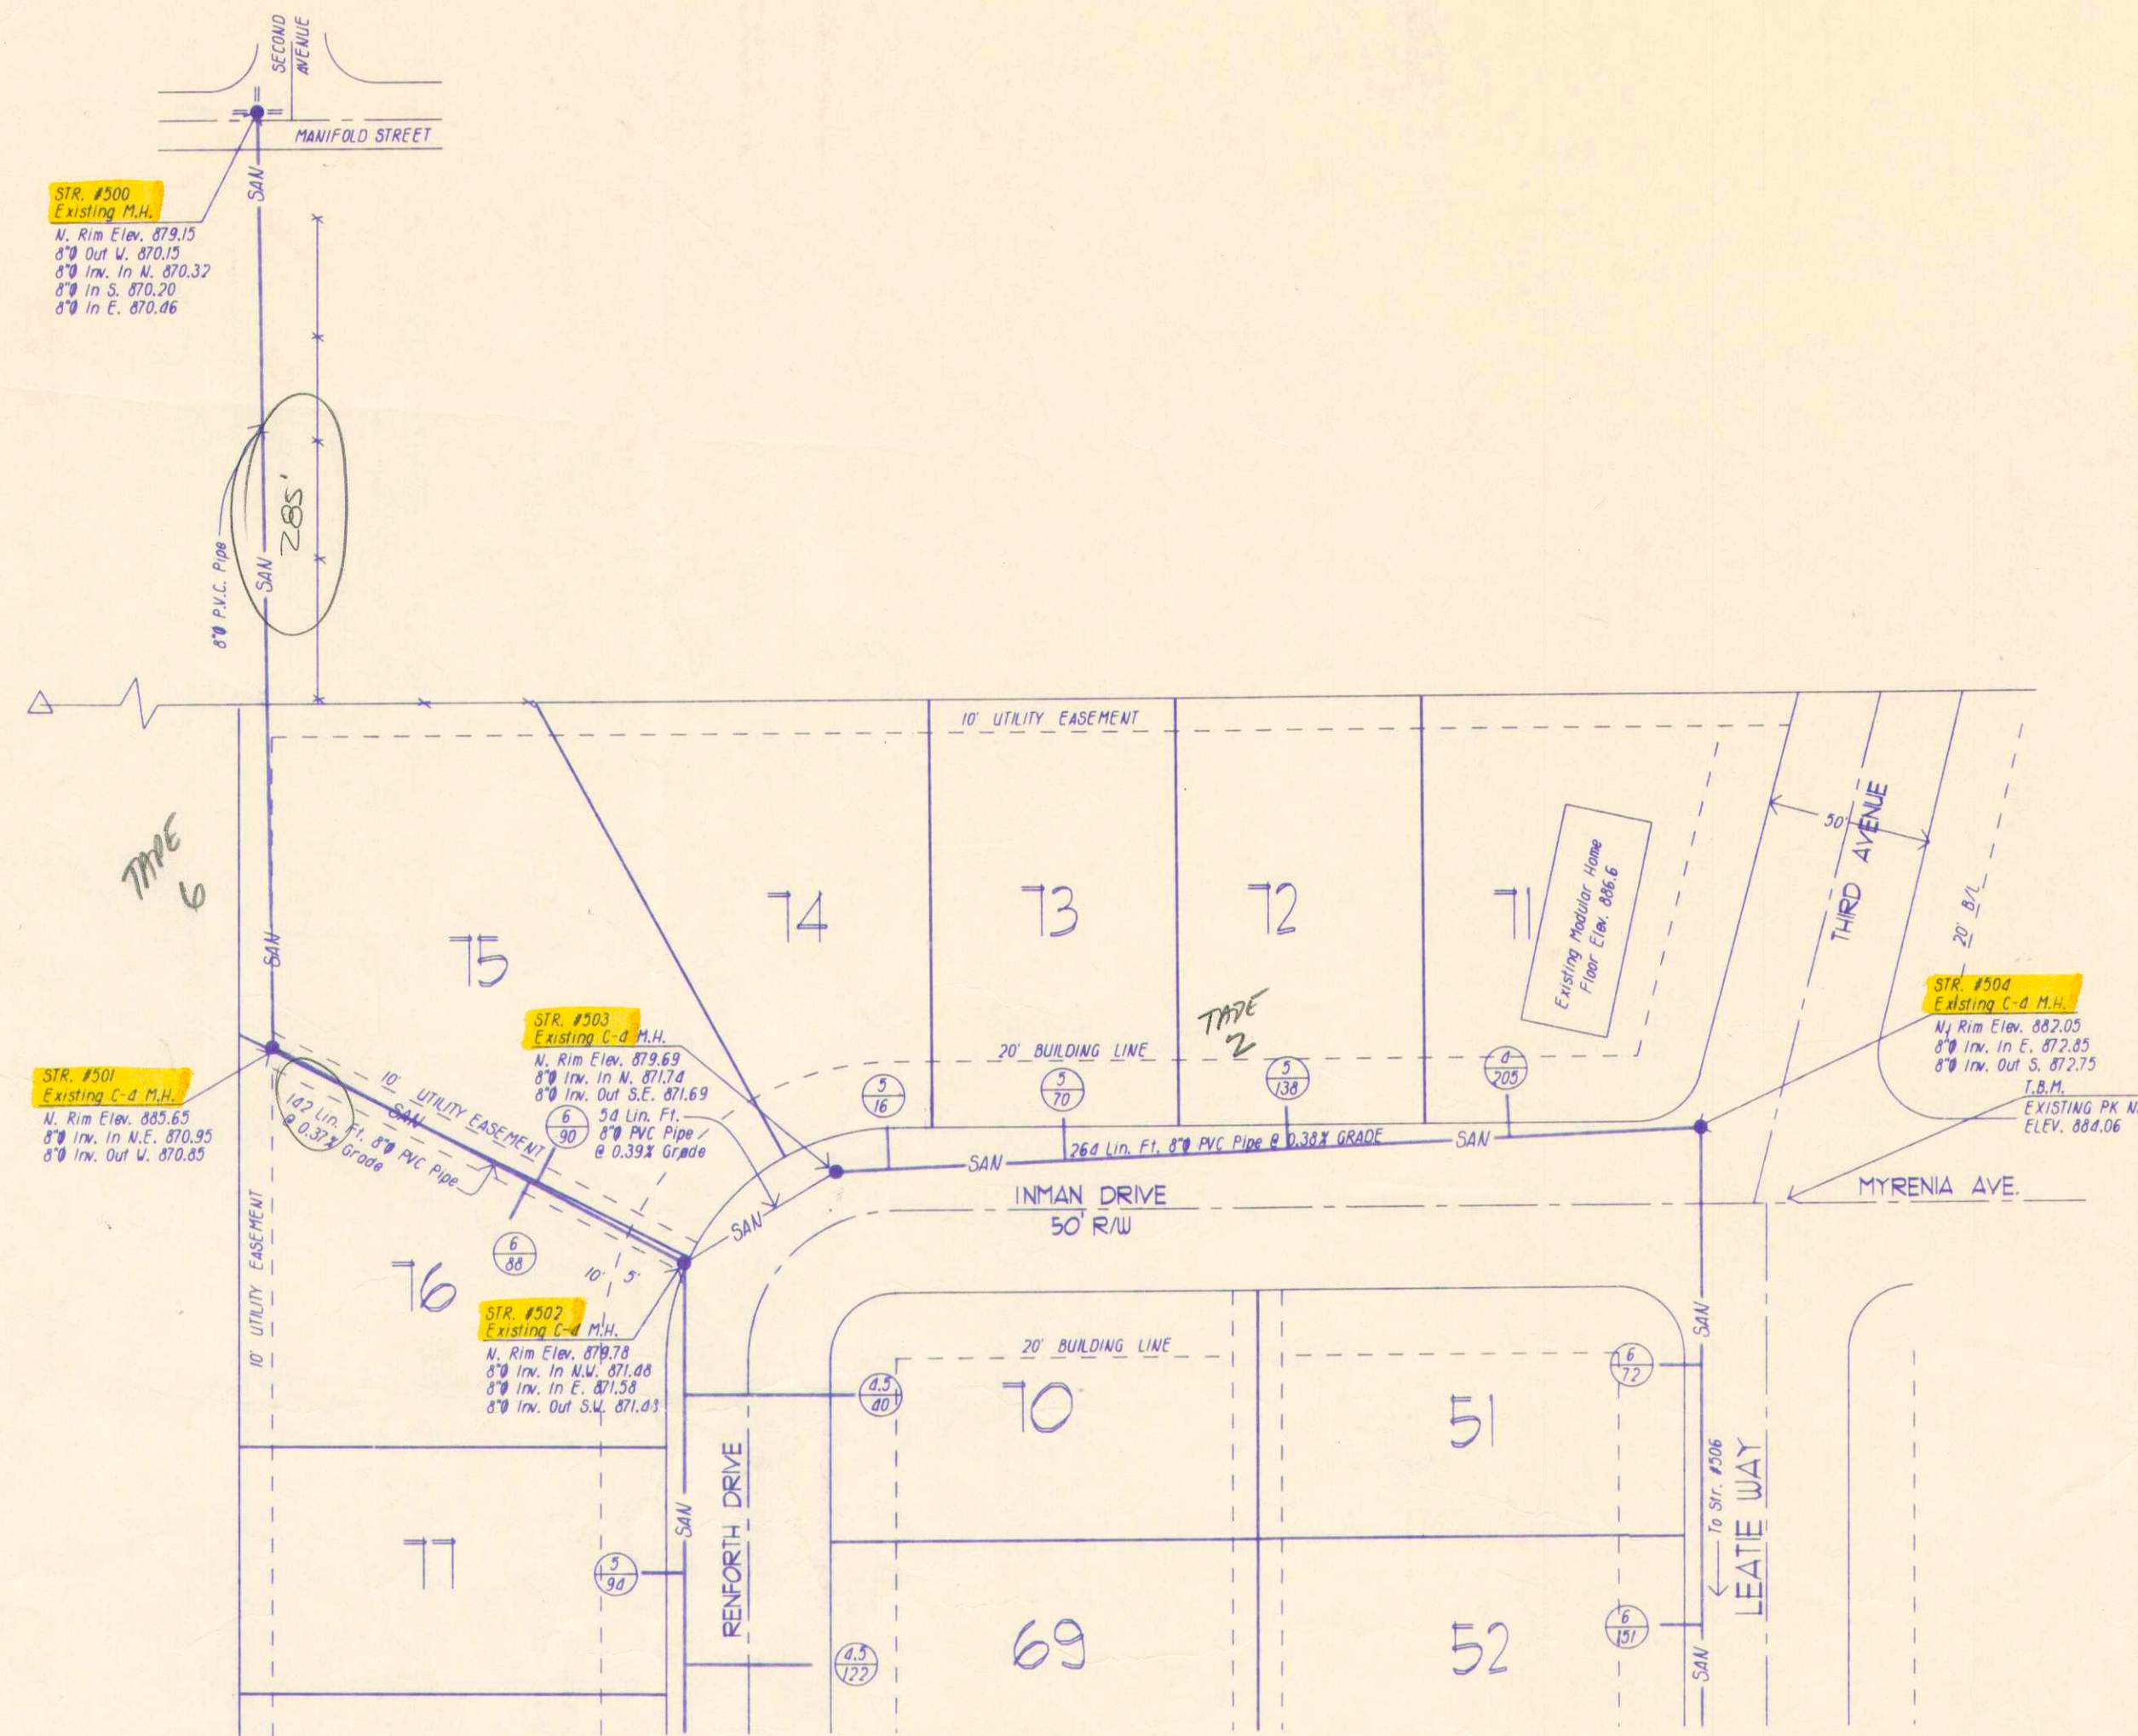

AS-BUILT

PLANS PREPARED FOR:  
FALL CREEK REGIONAL WASTE DISTRICT  
BOX 59 COUNTY ROAD 650 WEST  
PENDLETON, INDIANA 46064

\* TAP LOCATIONS PROVIDED BY GREG HOLT EXCAVATING

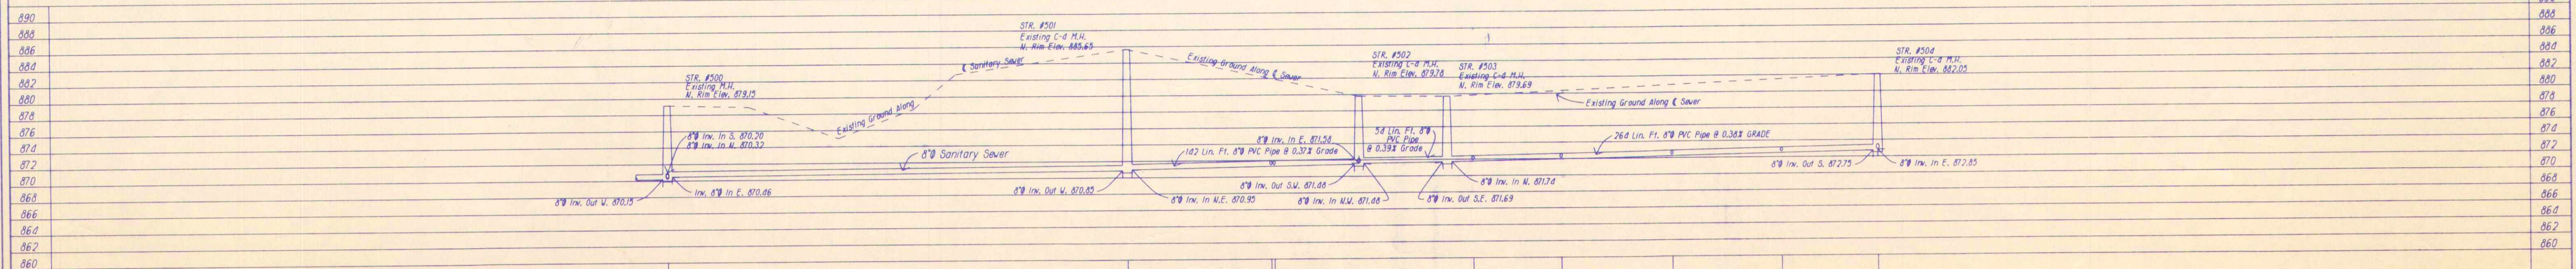

RAYL SURVEYING & ENGINEERING  
1926 E. 53RD STREET SUITE 4  
ANDERSON, IN. 46013  
(317) 643-5614

"AS BUILT" SANITARY SEWER PLAN & PROFILES

REVISIONS:

MYRENIA INMAN ADDITION PLAT TWO  
TOWN OF INGALLS MADISON COUNTY, IN.

DRAWN BY: Perry A. Narum DATE: 12/22/94



BY: *Bradley A. Rayl*

DATE: 1/4/95

SHEET

1 OF 3

941544A.2D