




HOR. 1" = 50'
VER. 1" = 10'


⑥ 20' = Depth Of 6" Sanitary Stub
Horizontal Distance To Stub
From Nearest Downstream Manhole

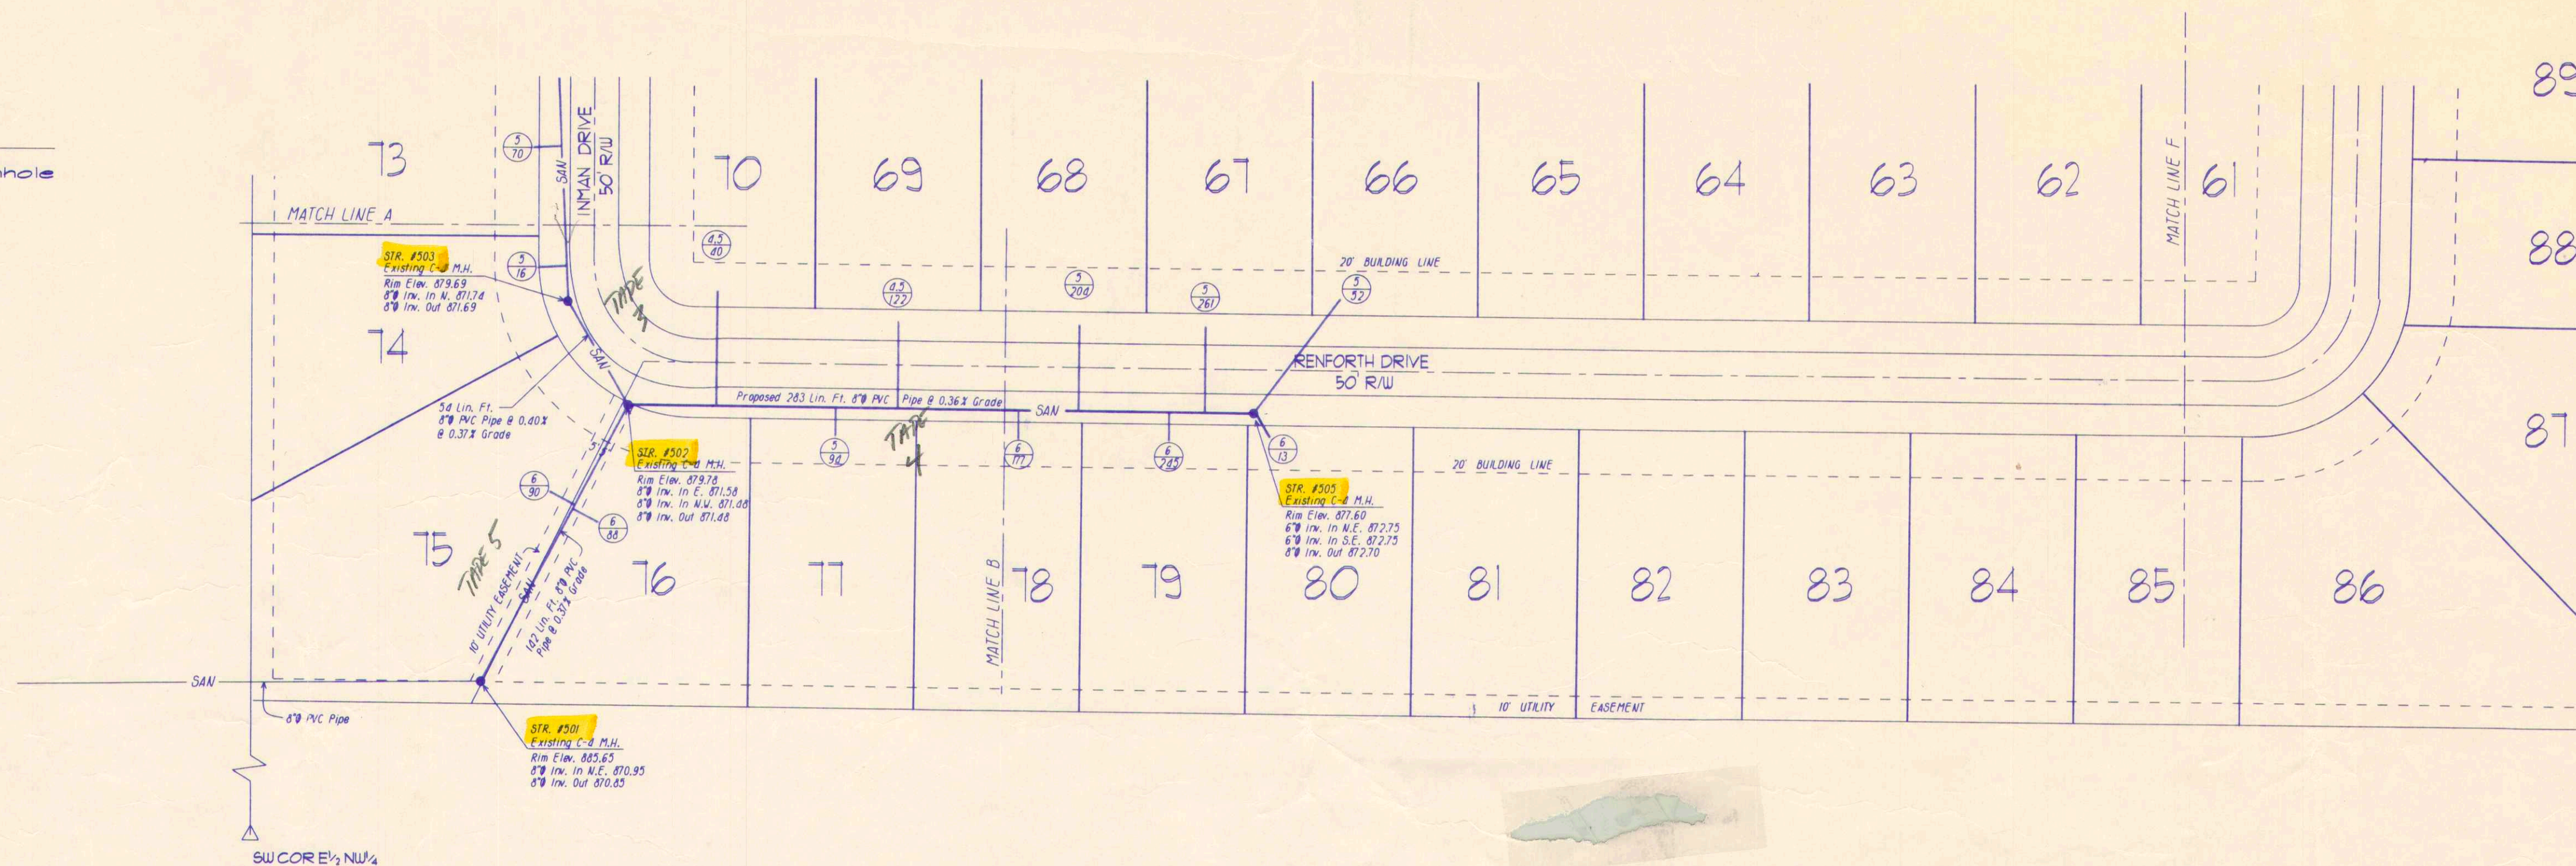

AS-BUILT

PLANS PREPARED FOR:
FALL CREEK REGIONAL WASTE DISTRICT
BOX 59 COUNTY ROAD 650 WEST
PENDLETON, INDIANA 46064

TAP LOCATIONS PROVIDED BY GREG HOLT EXCAVATING

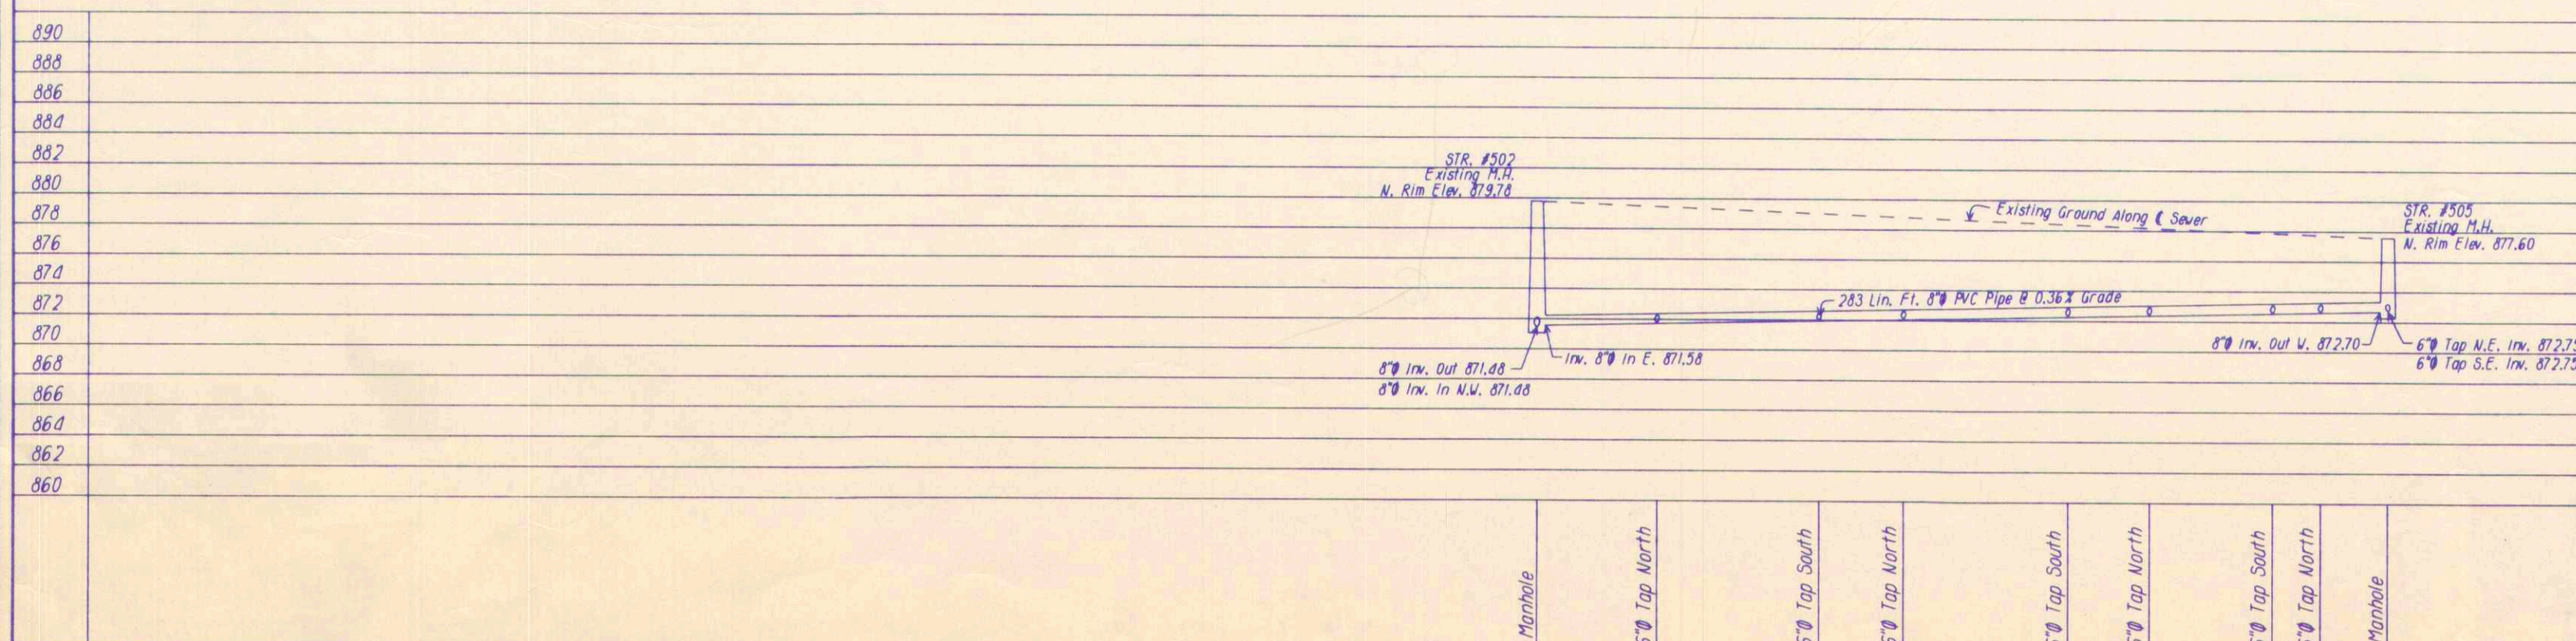

RAYL SURVEYING & ENGINEERING
1926 E. 53RD STREET SUITE 4
ANDERSON, IN. 46013
(317) 643-5614


"AS BUILT" SANITARY SEWER PLAN & PROFILES

REVISIONS:

MYRENA INMAN ADDITION PLAT TWO
TOWN OF NGALLS, MADISON COUNTY, IN.

DATE: 12/22/94

DRAWN BY: C. Flory

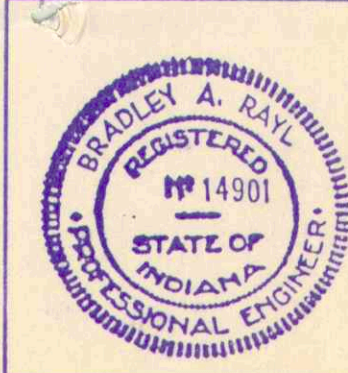

BY: *Bradley A. Rayl*

DATE: 1/4/95

SHEET
3 OF 3

940544C.2D