



PLOTTED BY: Arowley

PRINTED: 9/6/2023 @ 12:52PM

FILE NAME: S:\4923-FCRWD-SWW\Working Drawings\AutoCAD\4923-C-06.dwg

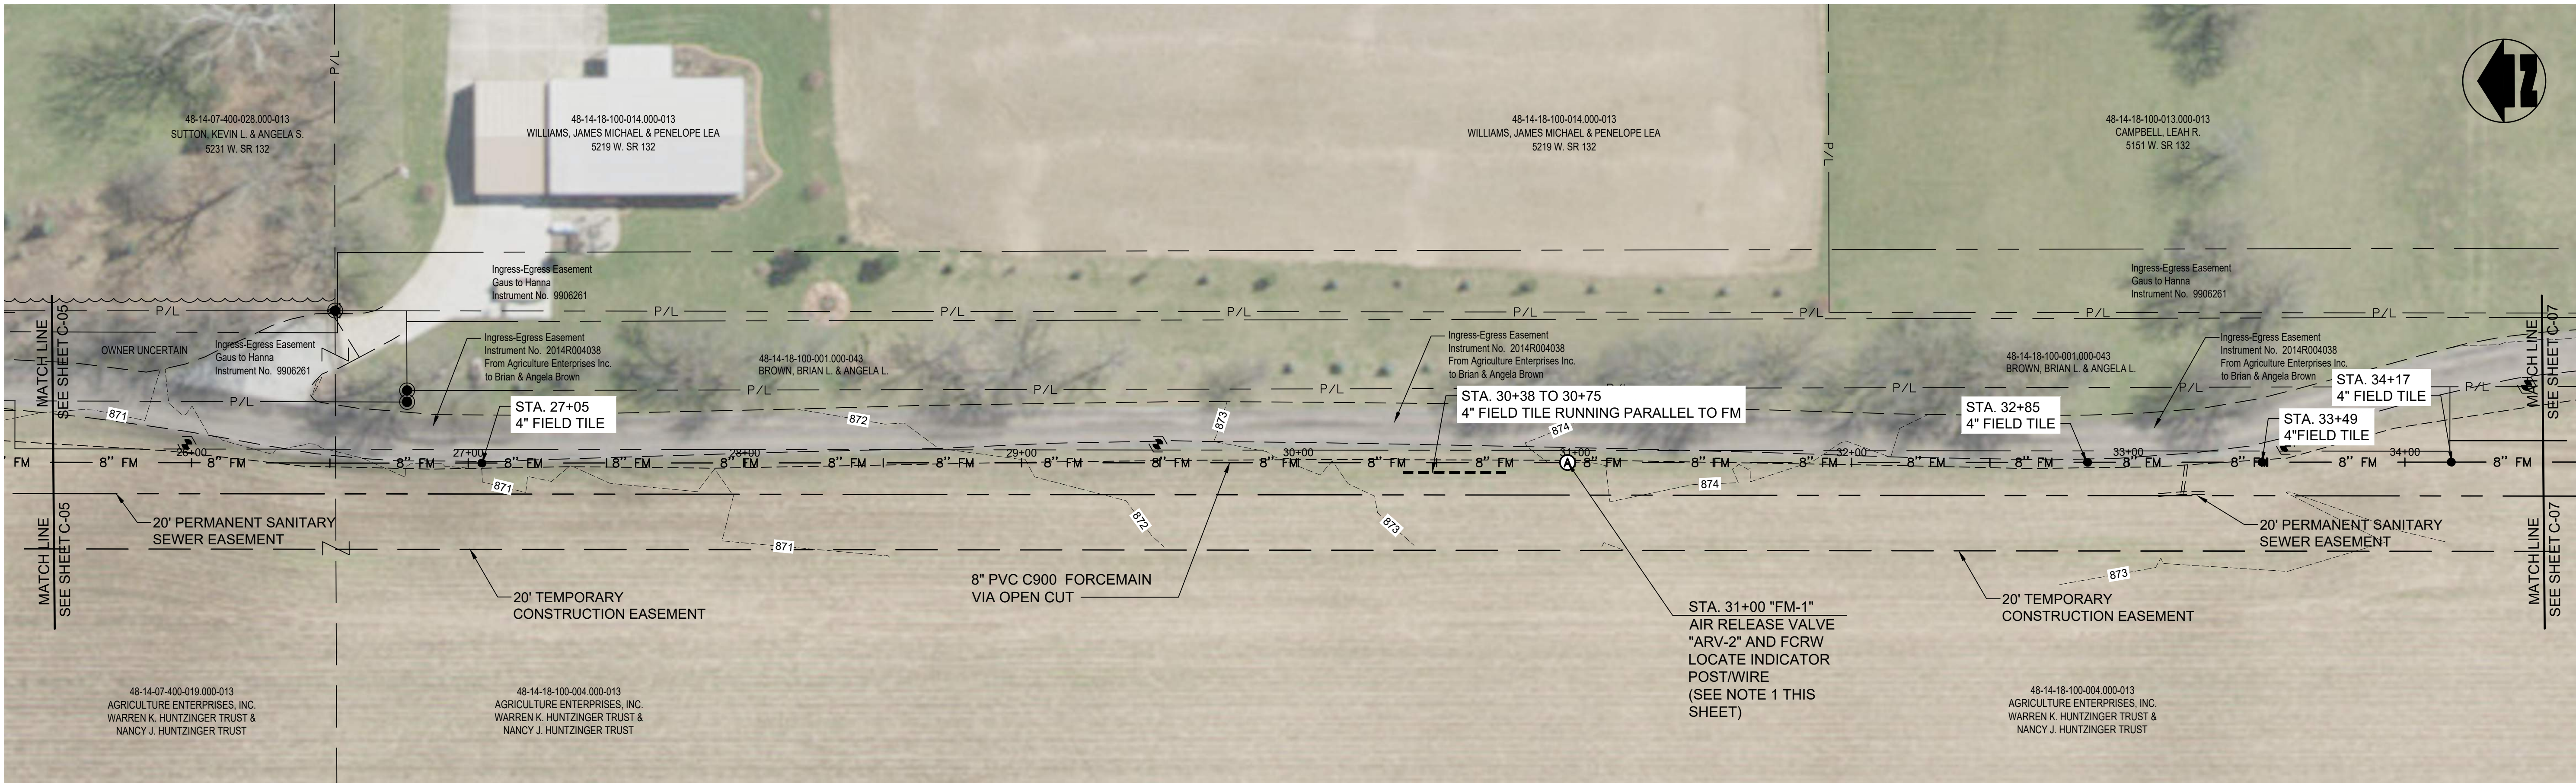

PLAN VIEW - STA. 25+50 TO STA. 34+50 LINE "FM-1"

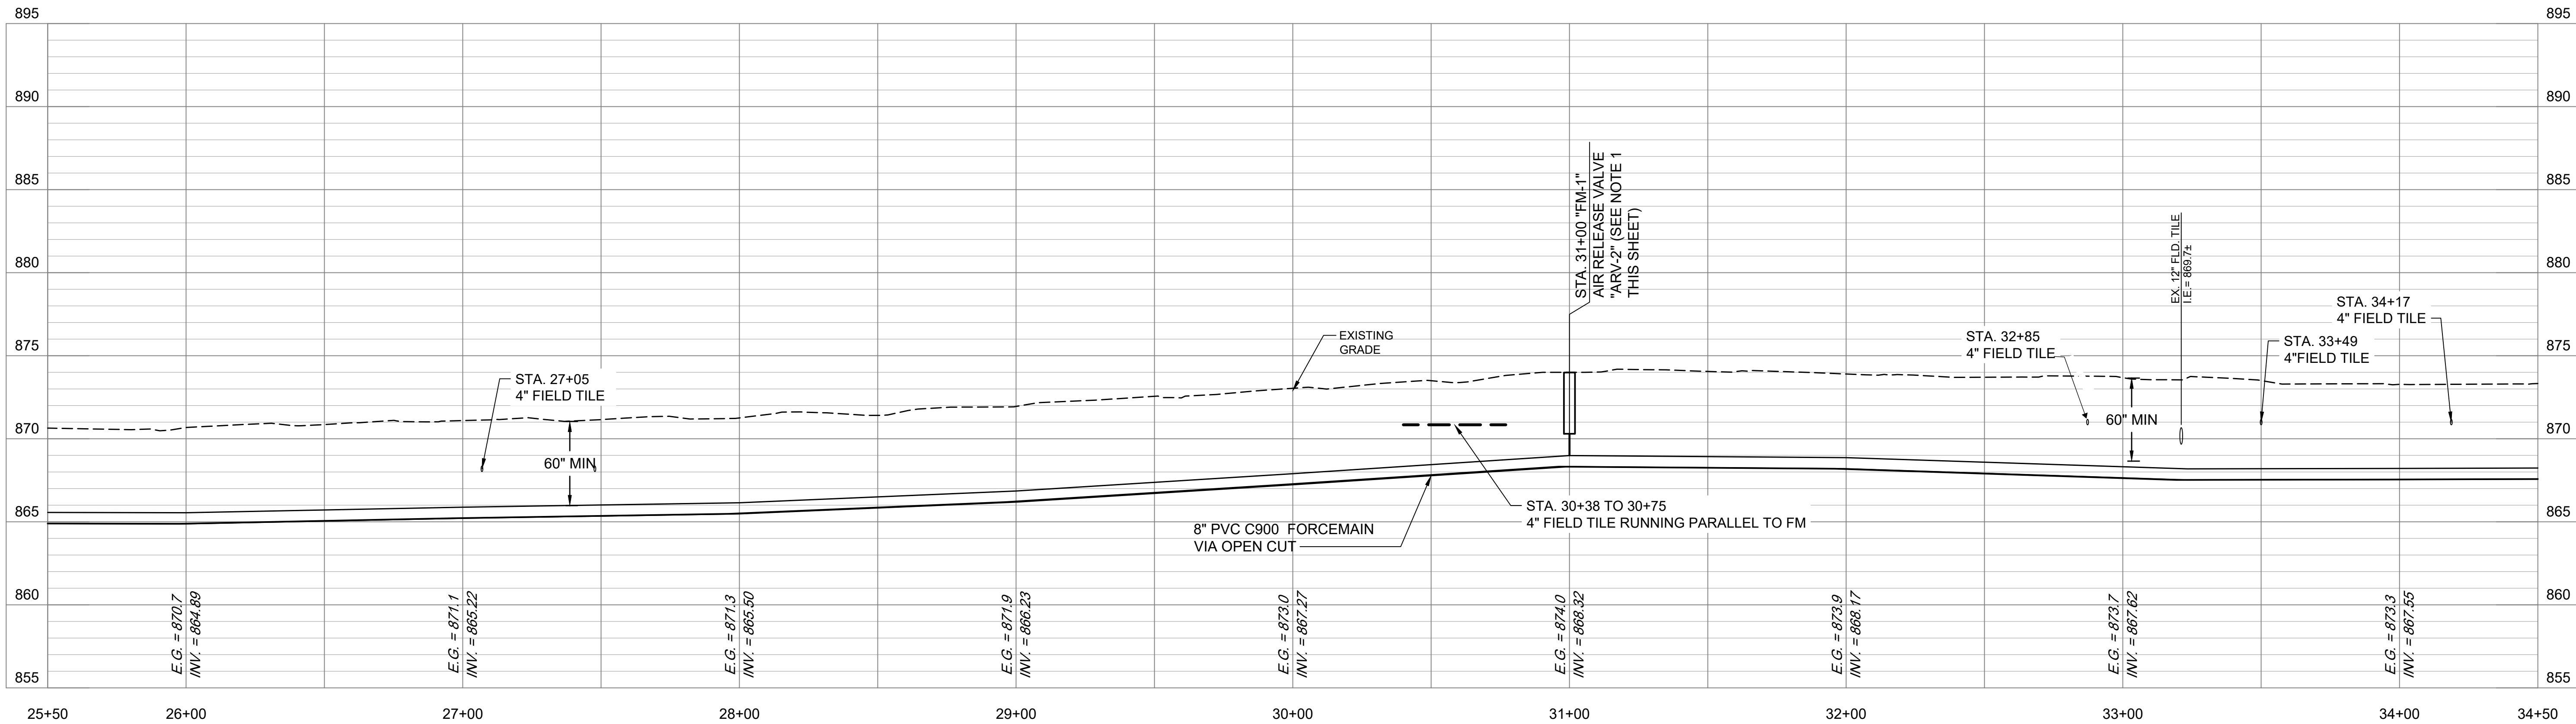

PROFILE - STA. 25+50 TO STA. 34+50 LINE "FM-1"

- NOTES:
- ARV VAULT SHALL BE KEPT AS NEAR AS PRACTICAL TO THE PROPERTY LINE AND OUT OF CROP FIELD. INSTALL REMOTE ARV OTHERWISE. (SEE DETAIL SHEET C-12)

THIS RECORD DOCUMENT HAS BEEN PREPARED BASED ON INFORMATION PROVIDED BY THE CONSTRUCTION CONTRACTOR. GRW ENGINEERS, INC. HAS ATTEMPTED TO VERIFY THE ACCURACY AND/OR COMPLETENESS OF THIS INFORMATION BUT SHALL NOT BE RESPONSIBLE FOR ANY ERRORS OR OMISSIONS WHICH MAY BE INCORPORATED HEREIN AS A RESULT.

engineering | architecture | geospatial

ENGINEER/ARCHITECT: JOSEPH P. TIERNEY

CONSTRUCTION COMPANY: B.L. BROWN COSNTRUCTION

DATE: 08/29/2023

DATE: JULY 2022

SCALE: H: 1"=30' V: 1"=5'

SHEET NO. C-06

PLAN AND PROFILE - LINE "FM-1"

STA. 25+50 TO STA. 34+50

NEW LIFT STATION AND FORCEMAIN

TOWN OF PENDLETON, INDIANA

REVISIONS	DATE	BY	DESCRIPTION	DESIGNED	JPT
NO					
1	9/9/23	LAD	ADDENDUM #1		

REVIEWED	AMR	JPT	JPT

SCALE CHECK: _____ THIS MARK SHOULD MEASURE EXACTLY 1" WHEN PLOTTED

GRW PROJECT NO. 4923	CLIENT PROJECT NO. --
----------------------	-----------------------

ALL RIGHTS RESERVED. NO PART OF THIS DOCUMENT MAY BE REPRODUCED IN WHOLE OR IN PART WITHOUT THE WRITTEN PERMISSION OF GRW ENGINEERS, INC.

engineering | architecture | geospatial

www.grwinc.com

This document, originally issued, sealed, and signed by Joseph P Tierney, Indiana Professional Engineer, No. 19300407, on July 2022, shall not be used in lieu of a certified document.

RECORD DWG