



PLOTTED BY: Arowley

PRINTED: 9/6/2023 @ 12:53PM

FILE NAME: S:\4923-FCRWD-SWW\Working Drawings\AutoCAD\4923-C-07.dwg

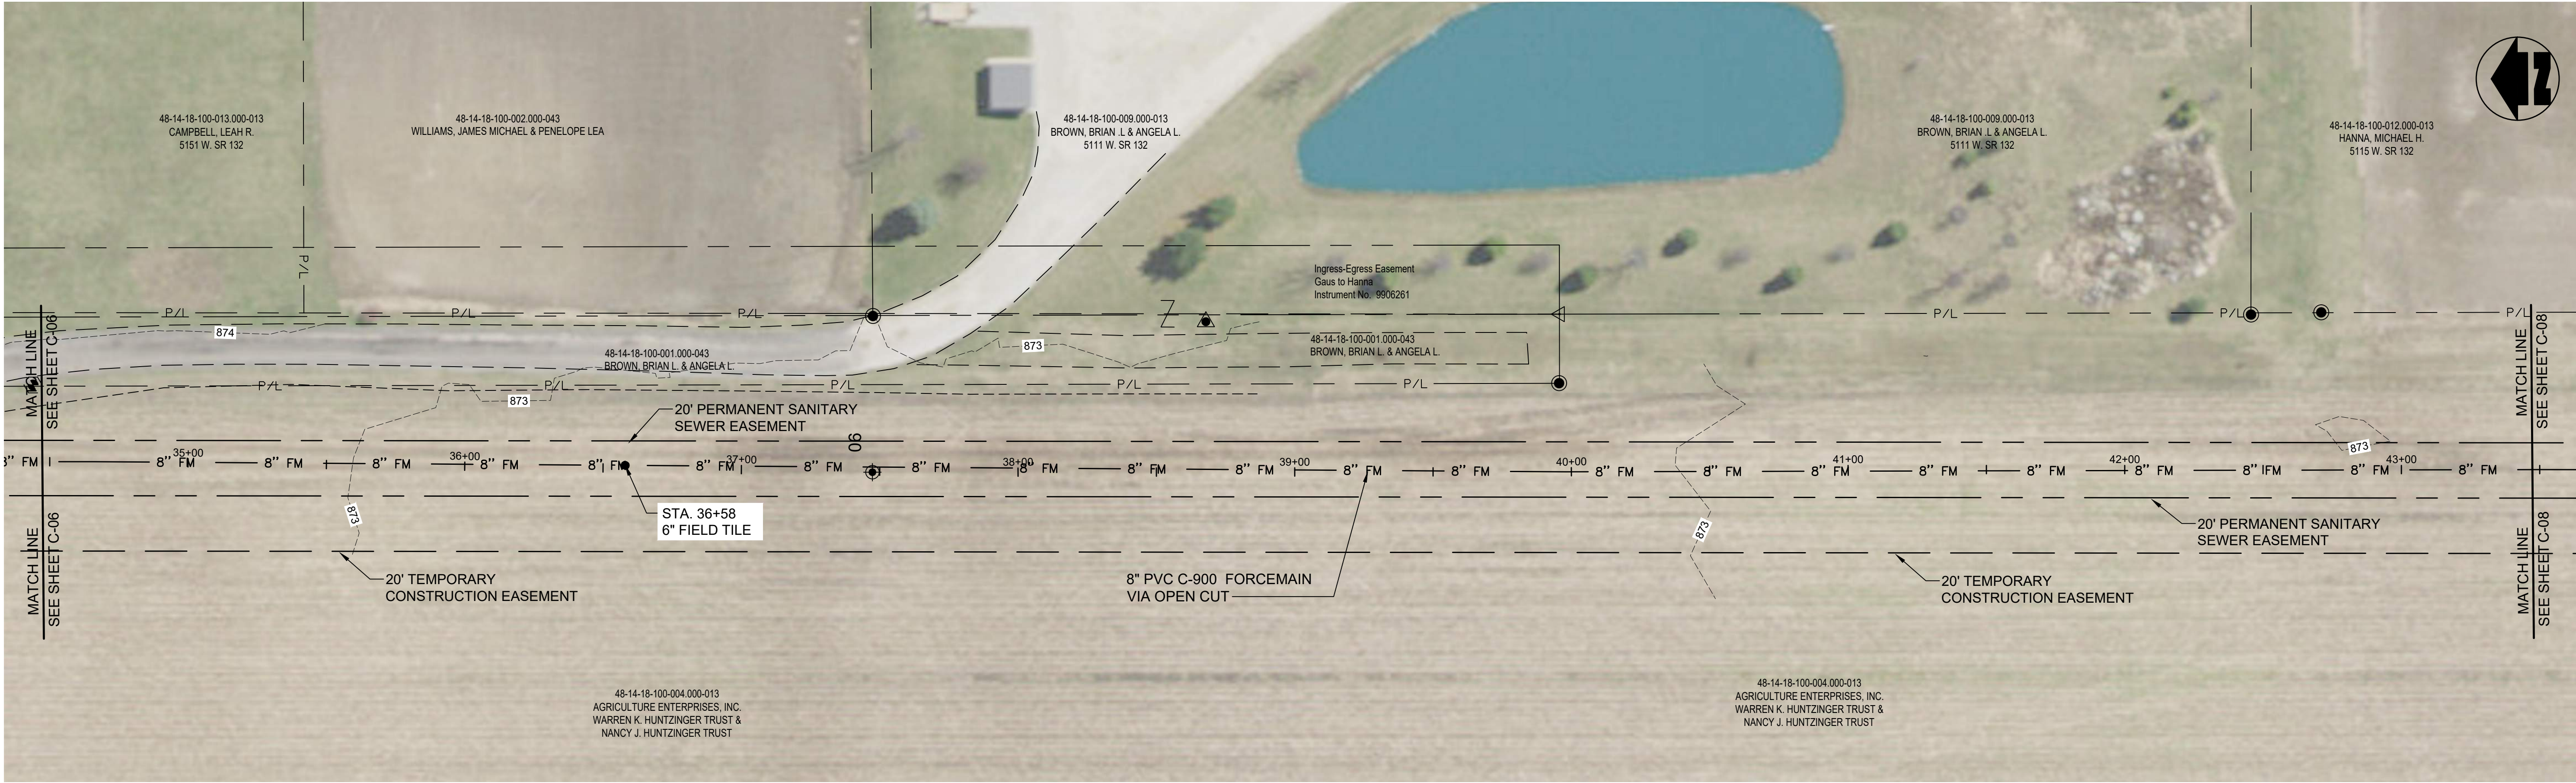

PLAN VIEW - STA. 34+50 TO STA. 43+50 LINE "FM-1"

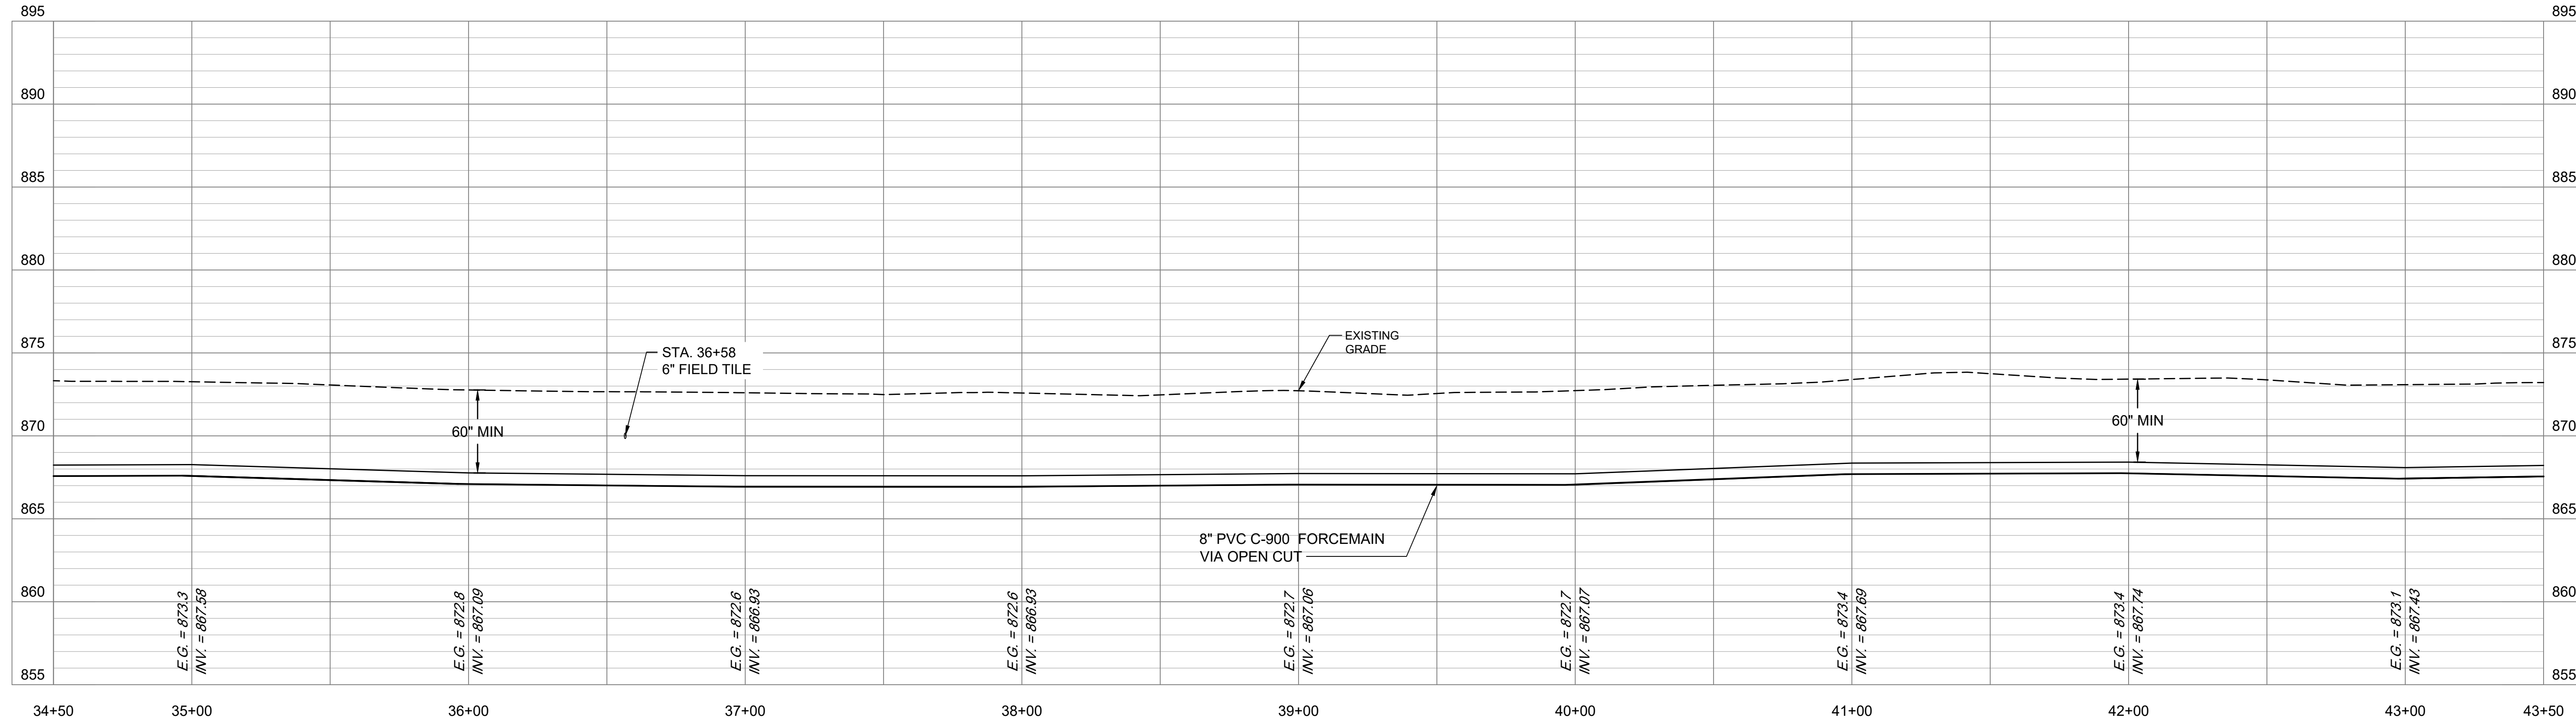

PROFILE - STA. 34+50 TO STA. 43+50 LINE "FM-1"

THIS RECORD DOCUMENT HAS BEEN PREPARED BASED ON INFORMATION PROVIDED BY THE CONSTRUCTION CONTRACTOR. GRW ENGINEERS, INC. HAS ATTEMPTED TO VERIFY THE ACCURACY AND/OR COMPLETENESS OF THIS INFORMATION BUT SHALL NOT BE RESPONSIBLE FOR ANY ERRORS OR OMISSIONS WHICH MAY BE INCORPORATED HEREIN AS A RESULT.

engineering | architecture | geospatial

ENGINEER/ARCHITECT: JOSEPH P. TIERNEY
 CONSTRUCTION COMPANY: B.L. BROWN CONSTRUCTION
 DATE: 08/29/2023

DATE: JULY 2022
 SCALE: H: 1"=30' V: 1"=5'
 SHEET NO.: C-07

HORIZONTAL SCALE: 1" = 30'-0"
 VERTICAL SCALE: 1" = 5'-0"

This document, originally issued, sealed, and signed by Joseph P Tierney, Indiana Professional Engineer, No. 19300407, on July 2022, shall not be used in lieu of a certified document.

GRW PROJECT NO. 4923
 CLIENT PROJECT NO. --
 ALL RIGHTS RESERVED. NO PART OF THIS DOCUMENT OR ANY INFORMATION CONTAINED HEREIN SHALL BE REPRODUCED IN WHOLE OR IN PART WITHOUT THE WRITTEN PERMISSION OF GRW ENGINEERS, INC.

engineering | architecture | geospatial
 www.grwinc.com

PLAN AND PROFILE - LINE "FM-1"
 STA. 34+50 TO STA. 43+50
 NEW LIFT STATION AND FORCEMAIN
 TOWN OF PENDLETON, INDIANA

DESIGNED		BY		DATE	
JPT	AMR	JPT	AMR	JPT	AMR

REVISIONS
 NO. DESCRIPTION
 1. THIS MARK SHOULD MEASURE EXACTLY 1" WHEN PLOTTED