



48-14-18-100-012.000-013
HANNA, MICHAEL H.
5115 W. SR 132

48-14-18-100-012.000-013
HANNA, MICHAEL H.
5115 W. SR 132

48-14-18-100-012.000-013
HANNA, MICHAEL H.
5115 W. SR 132

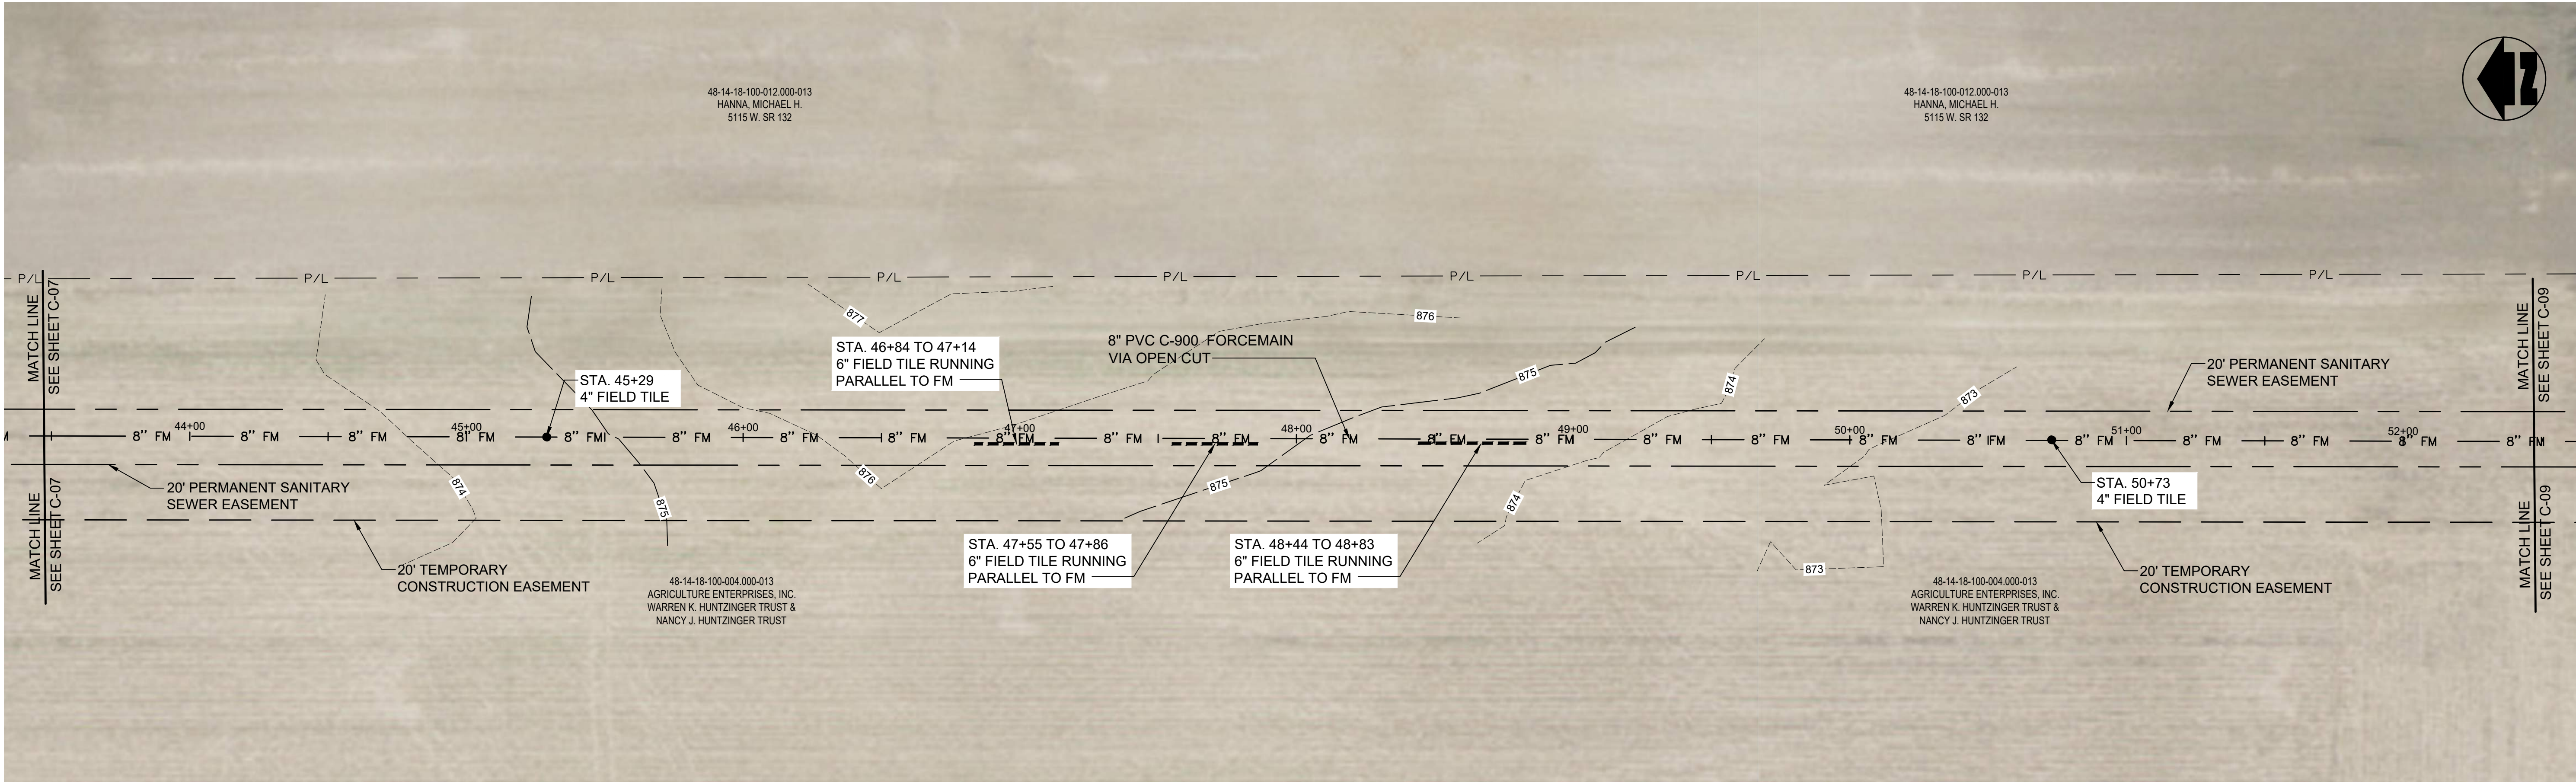

PLAN VIEW - STA. 43+50 TO STA. 52+50 LINE "FM-1"

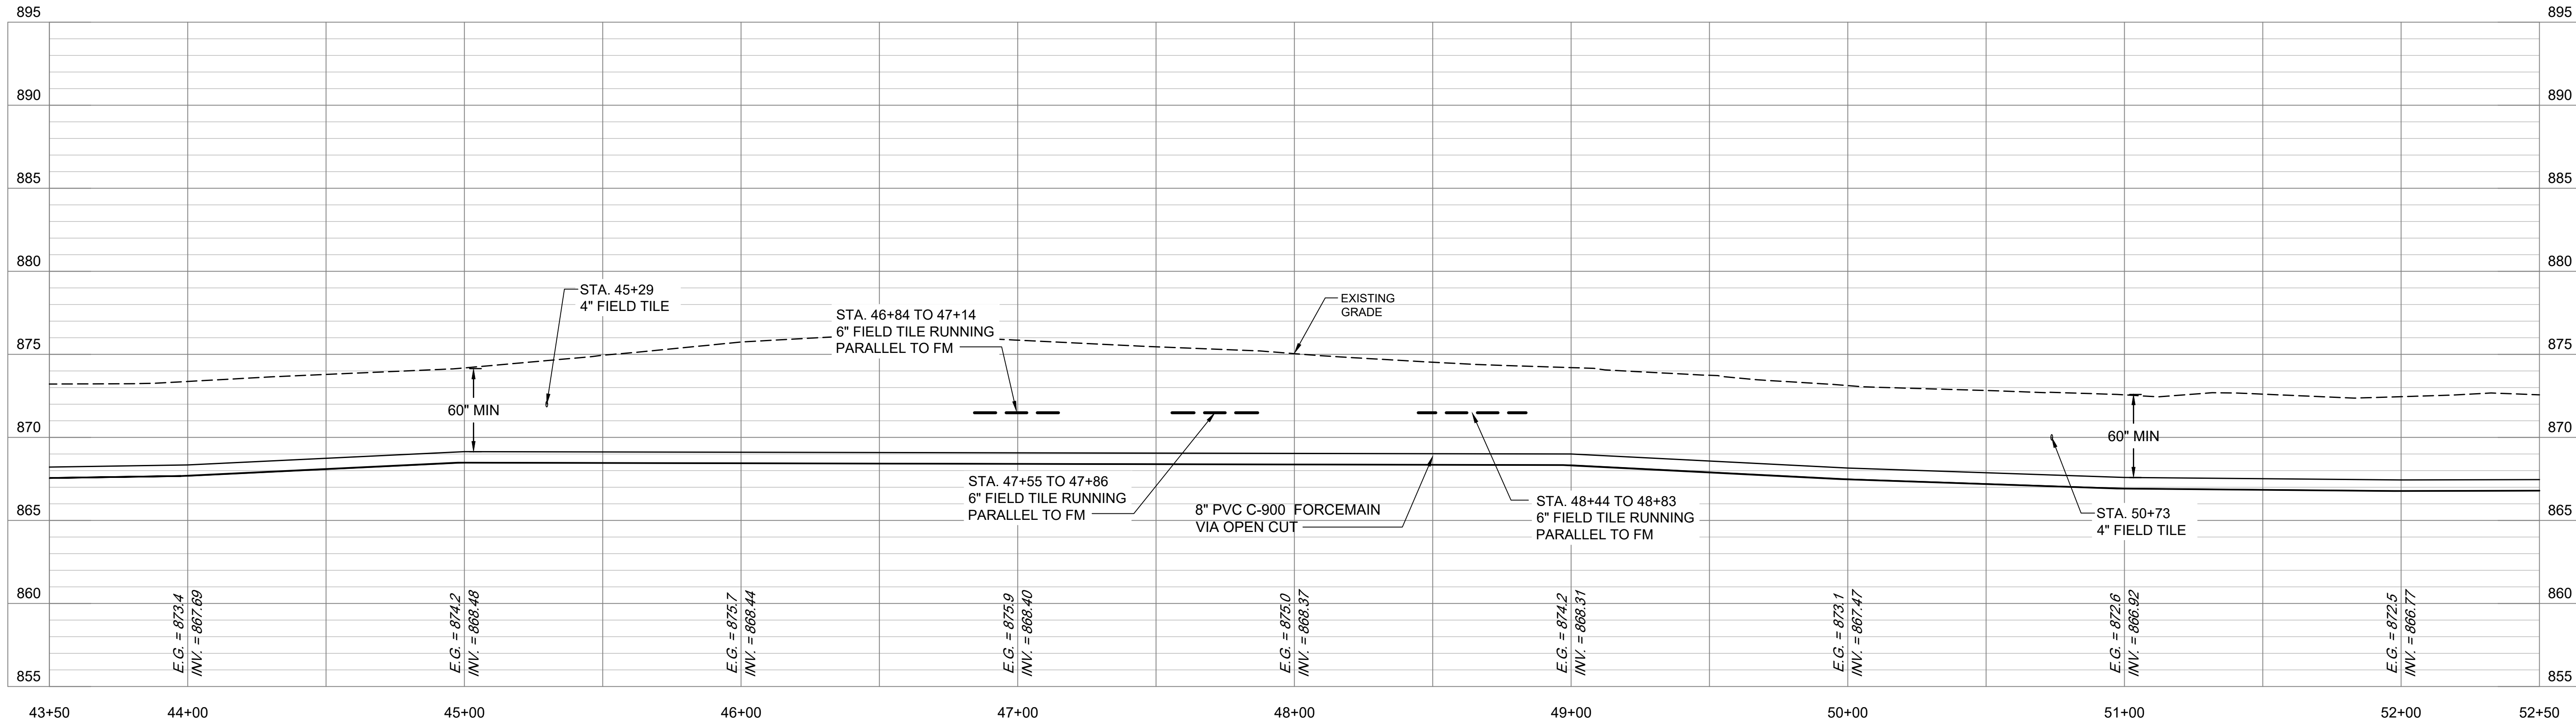


PROFILE - STA. 43+50 TO STA. 52+50 LINE "FM-1"

THIS RECORD DOCUMENT HAS BEEN PREPARED BASED ON INFORMATION PROVIDED BY THE CONSTRUCTION CONTRACTOR. GRW ENGINEERS, INC. HAS ATTEMPTED TO VERIFY THE ACCURACY AND/OR COMPLETENESS OF THIS INFORMATION BUT SHALL NOT BE RESPONSIBLE FOR ANY ERRORS OR OMISSIONS WHICH MAY BE INCORPORATED HEREIN AS A RESULT.

GRW
engineering | architecture | geospatial

ENGINEER/ARCHITECT: **JOSEPH P. TIERNEY**
CONSTRUCTION COMPANY: **B.L. BROWN CONSTRUCTION**
DATE: **08/29/2023**

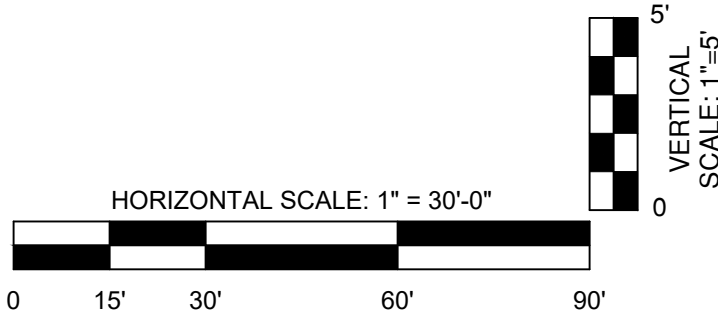

This document, originally issued, sealed, and signed by Joseph P Tierney, Indiana Professional Engineer, No. 19300407, on July 2022, shall not be used in lieu of a certified document.

GRW PROJECT NO. 4923

CLIENT PROJECT NO. --

ALL RIGHTS RESERVED. NO PART OF THIS DOCUMENT SHALL BE REPRODUCED IN WHOLE OR IN PART WITHOUT THE WRITTEN PERMISSION OF GRW ENGINEERS, INC.

GRW
engineering | architecture | geospatial

www.grwinc.com

PLAN AND PROFILE - LINE "FM-1"
STA. 43+50 TO 52+50
NEW LIFT STATION AND FORCEMAIN
TOWN OF PENDLETON, INDIANA

REVISIONS	DATE	BY	DESCRIPTION	DESIGNED	DRAWN	REVIEWED	APPROVED
1	9/9/22	LAD	ADDENDUM #1	JPT	AMR	JPT	JPT

DATE: **JULY 2022**
SCALE: **H: 1"=30' V: 1"=5'**
SHEET NO. **C-08**