



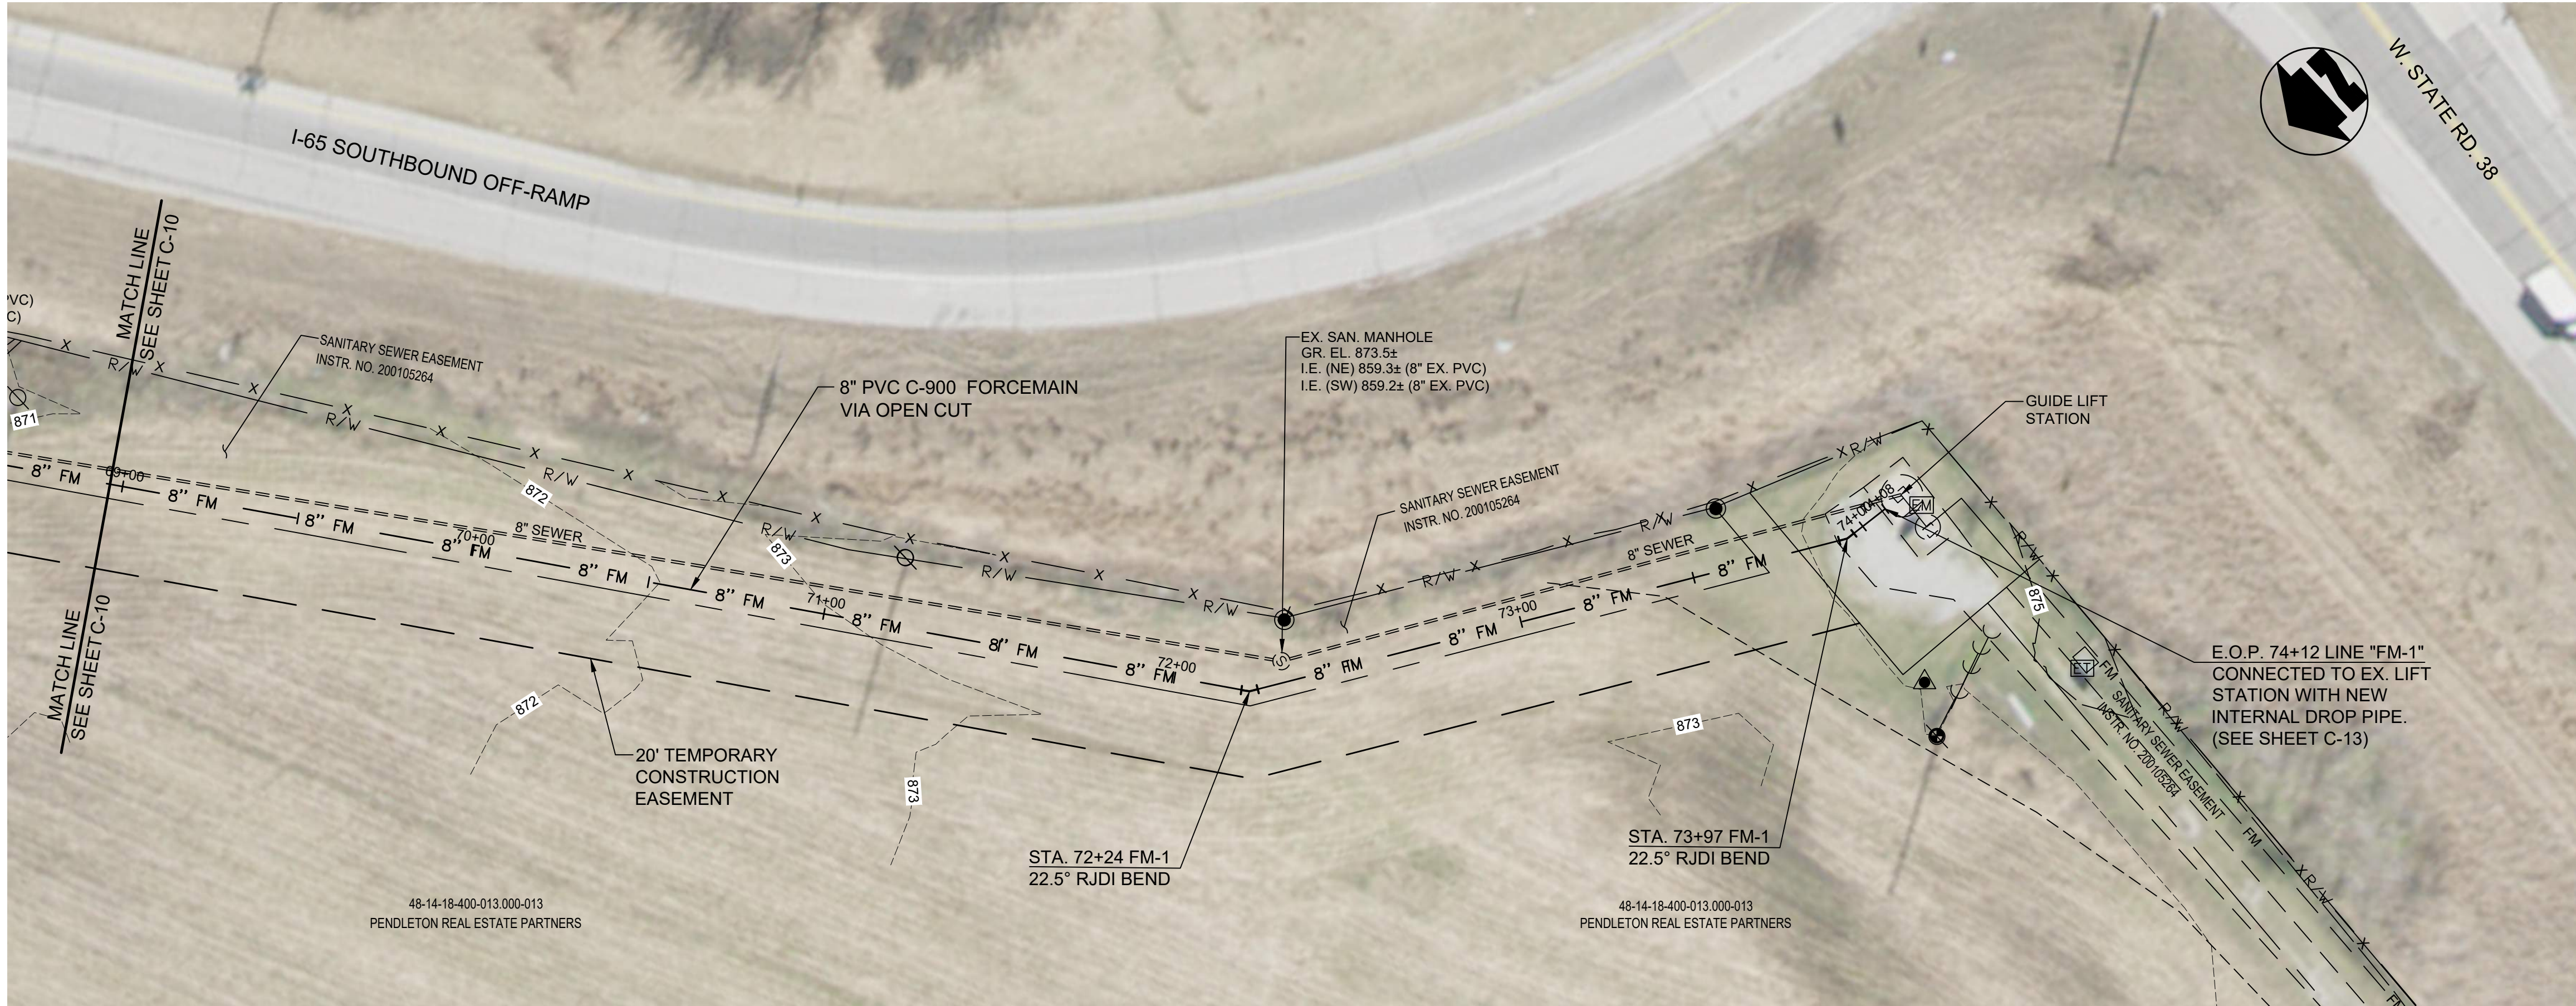

PLAN VIEW - STA. 69+00 TO E.O.P. STA. 74+12 LINE "FM-1"

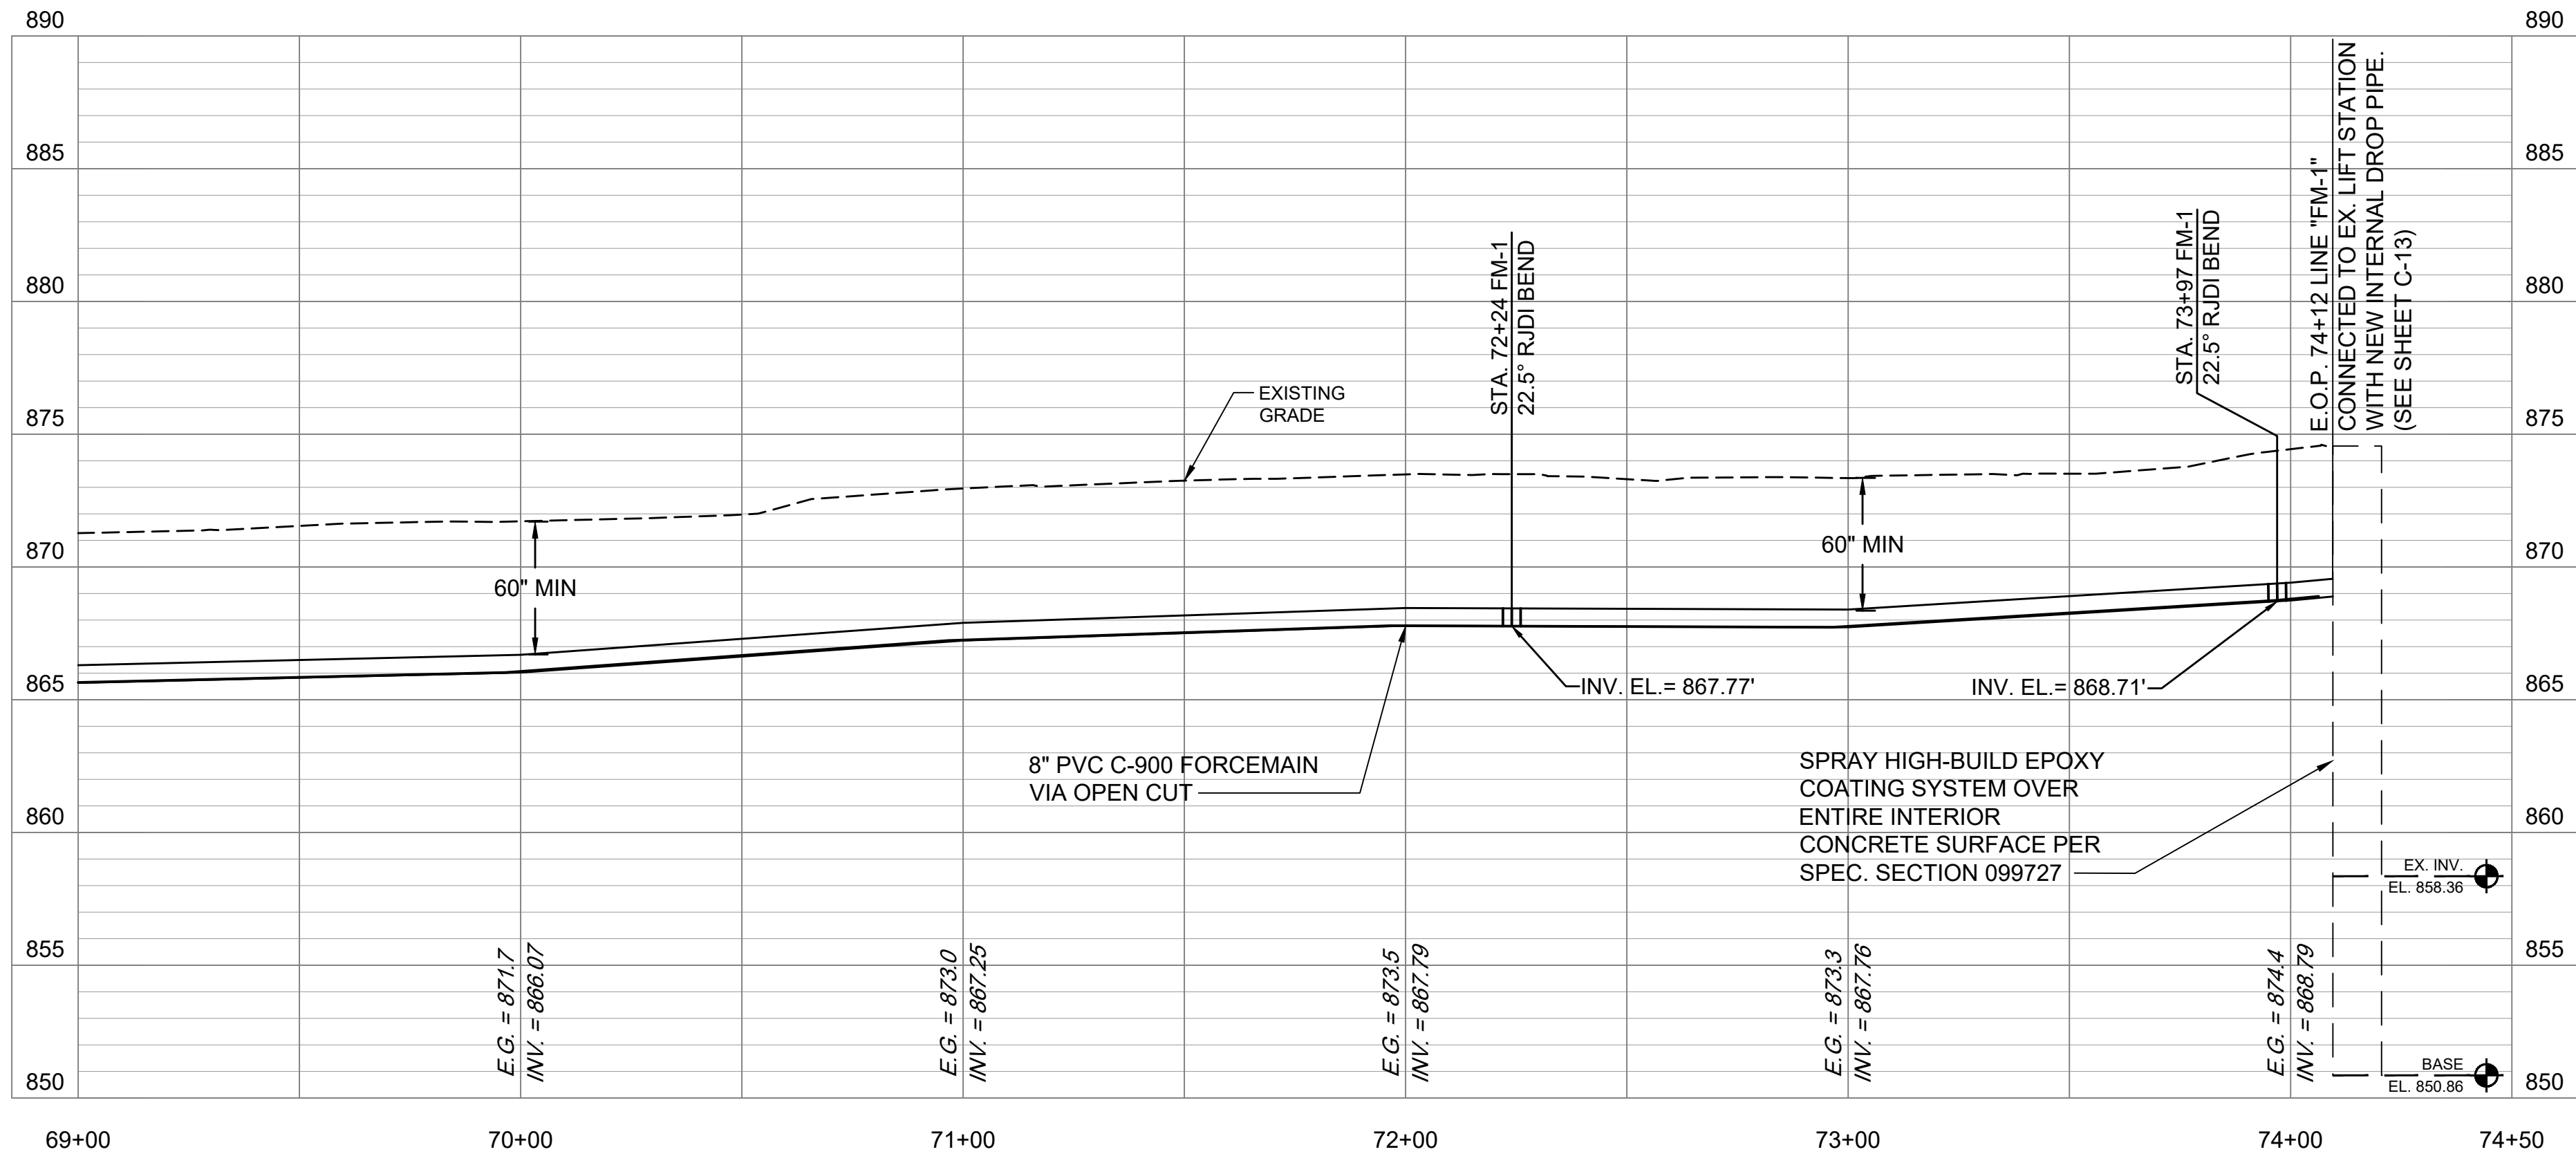


PROFILE - STA. 69+00 TO E.O.P. STA. 74+12 LINE "FM-1"

THIS RECORD DOCUMENT HAS BEEN PREPARED BASED ON INFORMATION PROVIDED BY THE CONSTRUCTION CONTRACTOR. GRW ENGINEERS, INC. HAS ATTEMPTED TO VERIFY THE ACCURACY AND/OR COMPLETENESS OF THIS INFORMATION BUT SHALL NOT BE RESPONSIBLE FOR ANY ERRORS OR OMISSIONS WHICH MAY BE INCORPORATED HEREIN AS A RESULT.

engineering | architecture | geospatial

ENGINEER/ARCHITECT: **JOSEPH P. TIERNEY**
 CONSTRUCTION COMPANY: **B.L. BROWN COSNTRUCTION**
 DATE: **08/29/2023**

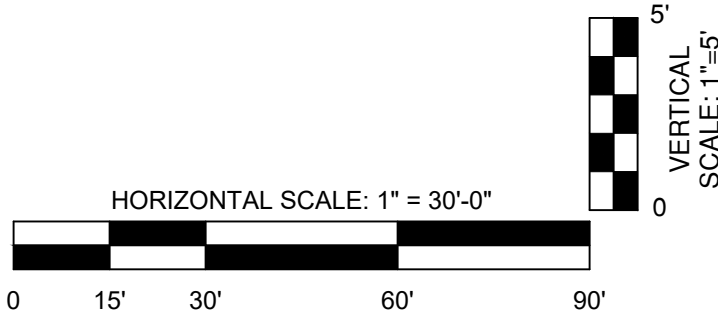

This document, originally issued, sealed, and signed by Joseph P Tierney, Indiana Professional Engineer, No.19300407, on July 2022, shall not be used in lieu of a certified document.

GRW PROJECT NO. 4923
 CLIENT PROJECT NO. --
 ALL RIGHTS RESERVED. NO PART OF THIS DOCUMENT SHALL BE REPRODUCED IN WHOLE OR IN PART WITHOUT WRITTEN PERMISSION FROM GRW ENGINEERS, INC.

engineering | architecture | geospatial
 www.grwinc.com

PLAN AND PROFILE - LINE "FM-1"
 STA. 69+00 TO E.O.P. STA. 74+11
 NEW LIFT STATION AND FORCEMAIN
 TOWN OF PENDLETON, INDIANA

DESIGNED		JPT	
NO.	DATE	BY	DATE
1	9/9/22	LAD	

DRAWN		AMR	
NO.	DATE	BY	DATE

REVIEWED		JPT	
NO.	DATE	BY	DATE

APPROVED		JPT	
NO.	DATE	BY	DATE

DATE: **JULY 2022**
 SCALE:
 H: 1"=30' V: 1"=5'
 SHEET NO.

C-11