




SHEET NOTES:

- 1. NOT ALL EROSION CONTROL REQUIREMENTS MAY BE SHOWN ON THIS SHEET. REFER TO SPEC. SECTIONS 312503 AND APPENDIX B FOR REQUIREMENTS.
- CONTRACTOR SHALL REPAIR/REPLACE ANY DAMAGED SIDEWALK OR CURB TO NEXT JOINT AS A RESULT OF CONSTRUCTION ACTIVITIES.

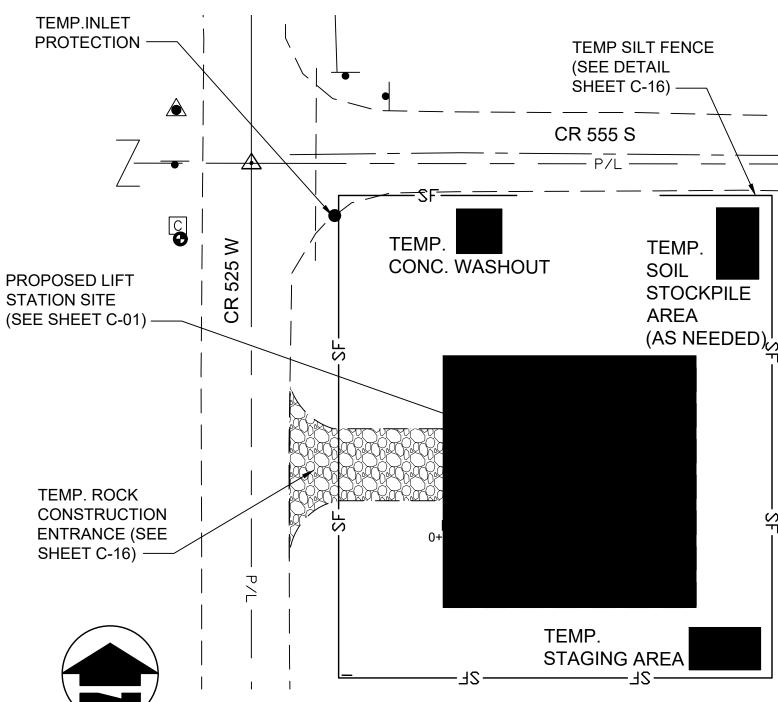

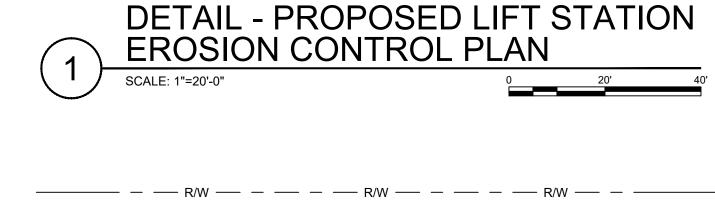

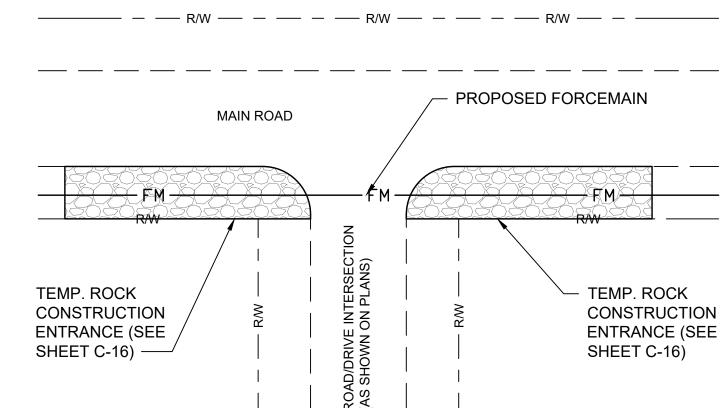



<u>LEGEND</u>

PROPOSED INLET PROTECTION

— SF — SILT FENCE

BORE PIT (HDD) SEE DETAIL 3/C-15

DITCH CROSSING SEE DETAIL 4/C-15 (AT OPEN CUT AREAS ONLY)

TEMPORARY ROCK CONSTRUCTION ENTRANCE (SEE DETAIL 2/C-14)

TEMPORARY MATERIAL DISPOSAL / STOCKPILING AREA (WITHIN TEMP. EASEMENT AND LIFT STATION SITE) THIS RECORD DOCUMENT HAS BEEN PREPARED BASED ON INFORMATION PROVIDED BY THE CONSTRUCTION CONTRACTOR. GRW ENGINEERS, INC. HAS ATTEMPTED TO VERIFY THE ACCURACY AND/OR COMPLETENESS OF THIS INFORMATION BUT SHALL NOT BE RESPONSIBLE FOR ANY ERRORS OR OMISSIONS WHICH MAY BE INCORPORATED HEREIN AS A RESULT.

engineering | architecture | geospatial

ENGINEER/ARCHITECT: JOSEPH P. TIERNEY

CONSTRUCTION COMPANY: B.L. BROWN COSNTRUCTION

MATERIAL HANDLING AND SPILL PREVENTION PLAN:

- 1. MATERIALS PRESENT ON-SITE THAT MAY BE
 POTENTIALLY HAZARDOUS WILL INCLUDE WASTES,
 EXCESS BUILDING/CONSTRUCTION MATERIALS, AND
 FUELS & LUBRICANTS REQUIRED FOR CONSTRUCTION
 EQUIPMENT. THESE ITEMS SHALL NOT BE ALLOWED TO
 BE CARRIED FROM THE SITE BY STORM WATER RUNOFF.
 THE CONTRACTOR SHALL DISPOSE OF ALL EXCESS
 BUILDING/CONSTRUCTION MATERIALS AND CONTAINERS
 AT AN APPROVED OFF-SITE LOCATION.
- 2. CONSTRUCTION VEHICLES SHALL BE SERVICED IN AREAS THAT WILL MINIMIZE IMPACTS IN THE OCCURRENCE OF A SPILL OR LEAK. SHOULD A SPILL OCCUR, CONTRACTOR SHALL MAKE ALL EFFORTS TO CONTAIN AND CLEAN THE SPILL, AND DISPOSE OF CONTAMINATED MATERIALS/SOIL IN AN APPROVED MANNER.
- 3. ALL SPILLS SHALL BE REPORTED TO THE INDIANA DEPARTMENT OF ENVIRONMENTAL MANAGEMENT'S EMERGENCY RESPONSE HOT LINE AT 1-888-233-7745 AND LOCAL EMERGENCY SERVICES.

EROSION CONTROL PLAN:

- CONTRACTOR SHALL COMPLY WITH ALL LOCAL AND STATE ORDINANCES THAT APPLY.
- 2. THIS PLAN SHALL NOT BE CONSIDERED ALL-INCLUSIVE CONTRACTOR SHALL TAKE ALL NECESSARY PRECAUTIONS TO PREVENT SEDIMENT FROM LEAVING THE SITE.
- ADDITIONAL EROSION AND SEDIMENT CONTROL
 MEASURES SHALL BE INSTALLED IF DEEMED
 NECESSARY BY ON-SITE INSPECTION BY THE LOCAL
 REVIEWING AUTHORITY.
- 4. WASTES AND UNUSED BUILDING/CONSTRUCTION MATERIALS SHALL NOT BE ALLOWED TO BE CARRIED FROM THE SITE BY STORM WATER RUNOFF. PROPER DISPOSAL OF ALL WASTES AND UNUSED BUILDING/CONSTRUCTION MATERIALS IS REQUIRED.
- 5. SEDIMENT BEING TRACKED ONTO PUBLIC OR PRIVATE ROADWAYS SHALL BE MINIMIZED. CLEARED SEDIMENT SHALL BE RETURNED TO THE SITE FOR DISPOSAL.
- 6. EXISTING VEGETATION SHALL BE PRESERVED IN AREAS NOT DISTURBED BY CONSTRUCTION ACTIVITIES.
- 7. IF SOIL STOCKPILES WILL BE LEFT FOR A PERIOD LONGER THAN FIFTEEN (15) DAYS, THEY SHALL BE STABILIZED WITH A TEMPORARY SEED MIX AND SURROUNDED BY SILT FENCING.
- 8. ALL APPLICABLE EROSION CONTROL MEASURES SHALL BE PLACED BEFORE ANY LAND DISTURBING ACTIVITIES TAKE PLACE.
- 9. UNVEGETATED AREAS THAT ARE SCHEDULED OR LIKELY TO BE LEFT INACTIVE FOR FIFTEEN (15) DAYS OR MORE SHALL BE TEMPORARILY OR PERMANENTLY SEEDED. ALTERNATIVE STABILIZATION METHODS ARE ACCEPTABLE IF THEY ARE ADEQUATE TO PREVENT SEDIMENT DISCHARGE AND APPROVED BY OWNER, ENGINEER, OR LOCAL REVIEWING AUTHORITY.
- 10. ANY DEWATERING ACTIVITIES SHALL BE PERFORMED IN A MANNER THAT WILL NOT DISCHARGE SEDIMENT LADEN WATER INTO A STREAM OR STORMWATER INLET. SEDIMENT LADEN WATER SHALL BE FILTERED THROUGH A PUMP DISCHARGE FILTER DEVICE SUCH AS DEWATERING BAG. PUMP DISCHARGE SHALL BE PLACED IN AN AREA THAT WILL NOT CAUSE EROSION AT THE OUTLET.
- 11. CONTRACTOR SHALL ENSURE ALL APPLICABLE EROSION AND SEDIMENT CONTROL MEASURES ARE IN PLACE AT THE APPROPRIATE PHASE(S) OF CONSTRUCTION.
- 12. IF CONTRACTOR WORKS OUTSIDE THE ESTABLISHED CONSTRUCTION LIMITS, SILT FENCE AND/OR OTHER EROSION AND SEDIMENT CONTROL DEVICES MAY BE REQUIRED. CONTRACTOR IS RESPONSIBLE FOR ANY WORK OUTSIDE THE CONSTRUCTION LIMITS AT NO COST TO THE OWNER.
- 13. CONTRACTOR SHALL DEVELOP A SELF-MONITORING PROGRAM/CHECKLIST TO ENSURE PROPER MAINTENANCE AND FUNCTION OF EROSION AND SEDIMENT CONTROL AND STORM WATER QUALITY MEASURES. A WRITTEN EVALUATION SHALL BE PERFORMED AT THE END OF THE NEXT BUSINESS DAY AFTER EACH MEASURABLE STORM EVENT, AND AT A MINIMUM OF ONE (1) TIME PER WEEK. WRITTEN EVALUATION SHALL INCLUDE THE NAME OF THE INDIVIDUAL PERFORMING THE EVALUATION, DATE OF THE EVALUATION, PROBLEM(S) IDENTIFIED AT THE SITE, AND DETAILS OF CORRECTIVE ACTION(S) RECOMMENDED AND COMPLETED. MONITORING SHALL BE PERFORMED BY AN INDIVIDUAL TRAINED IN EROSION AND SEDIMENT CONTROL PRACTICES.

This document, originally issued, sealed, and signed by Joseph P Tierney, Indiana Professional Engineer, No.19300407, on July 2022, shall not be used

PROJECT NO. 4923
PROJECT NO. -S RESERVED:
MENT IS THE PROPERTY OF
RERES. IN WHOLE OR IN PART
O'CE CONSTRUCTION OF
AN THIS SPECIFIC PROJECT
WRITTEN PERMISSION

eering | architecture | geospati

ORCEMAIN eng

PL

ONTROL

EROSION

W LIFT STATION AND FORCE FOWN OF PENDLETON, INDIA

DATE:

JULY 2022

SCALE:

NOTED

SHEET NO.

C-14

