



1
 DETAIL - HORIZONTAL DIRECTIONAL DRILL "FRAC-OUT" CONTINGENCY PLAN
 NOT TO SCALE

H.D.D. "FRAC-OUT" CONTINGENCY PLAN NOTES:


- REFER TO SPEC. 330523.13 FOR HORIZONTAL DIRECTIONAL DRILLING REQUIREMENTS. THE ITEMS IDENTIFIED HEREIN ARE GENERAL IN NATURE. CONTRACTOR SHALL SUBMIT A PROJECT SPECIFIC "FRAC-OUT" CONTINGENCY PLAN FOR OWNER AND ENGINEER APPROVAL AS PART OF SHOP DRAWING SUBMITTALS.
- AT LEAST ONE CONTAINMENT VESSEL MUST BE ON-SITE DURING ALL DRILLING OPERATIONS.
- CONTRACTOR SHALL HAVE AT LEAST ONE FULL-TIME PERSON ON-SITE DURING DRILLING OPERATIONS TO WALK THE DRILLING ROUTE AND IDENTIFY FRAC-OUTS AND COORDINATE REMEDIATION.
- MINIMIZE DRILLING PRESSURES TO KEEP MUD FROM FRACTURING OUT OF THE SOIL. IF A FRAC-OUT IS IDENTIFIED, STOP DRILLING IMMEDIATELY.
- IMMEDIATELY FOLLOWING THE DETECTION OF AN INADVERTENT MUD RELEASE, CONTAINMENT AND CLEAN-UP OPERATIONS SHALL COMMENCE.
 - FOR RELEASES ON LAND, CONTRACTOR SHALL USE SILT FENCING, SANDBAGS, AND/OR EARTH BERMS TO PREVENT FLUID FROM MIGRATING OR FLOWING FROM THE IMMEDIATE AREA OF THE DISCHARGE.
 - FOR RELEASES TO OPEN WATER OR DRAINAGE WAYS, ISOLATE THE AREA USING A TURBIDITY BARRIER, CONTAINMENT BOX, OR STAKED SEDIMENT BARRIER.
- CLEAN-UP SHALL COMMENCE IMMEDIATELY AFTER THE RELEASE IS CONTAINED. CLEAN-UP SHALL INCLUDE REMOVAL OF ALL VISIBLE DRILLING FLUID. REMOVAL METHODS MAY VARY BASED ON THE VOLUME OF THE RELEASE AND THE SITE-SPECIFIC CONDITIONS. REMOVAL EQUIPMENT MAY INCLUDE VACUUM TRUCK(S), LOADER AND TRACK HOE BUCKETS, SMALL PUMPS, SHOVELS, BUCKETS, ETC.

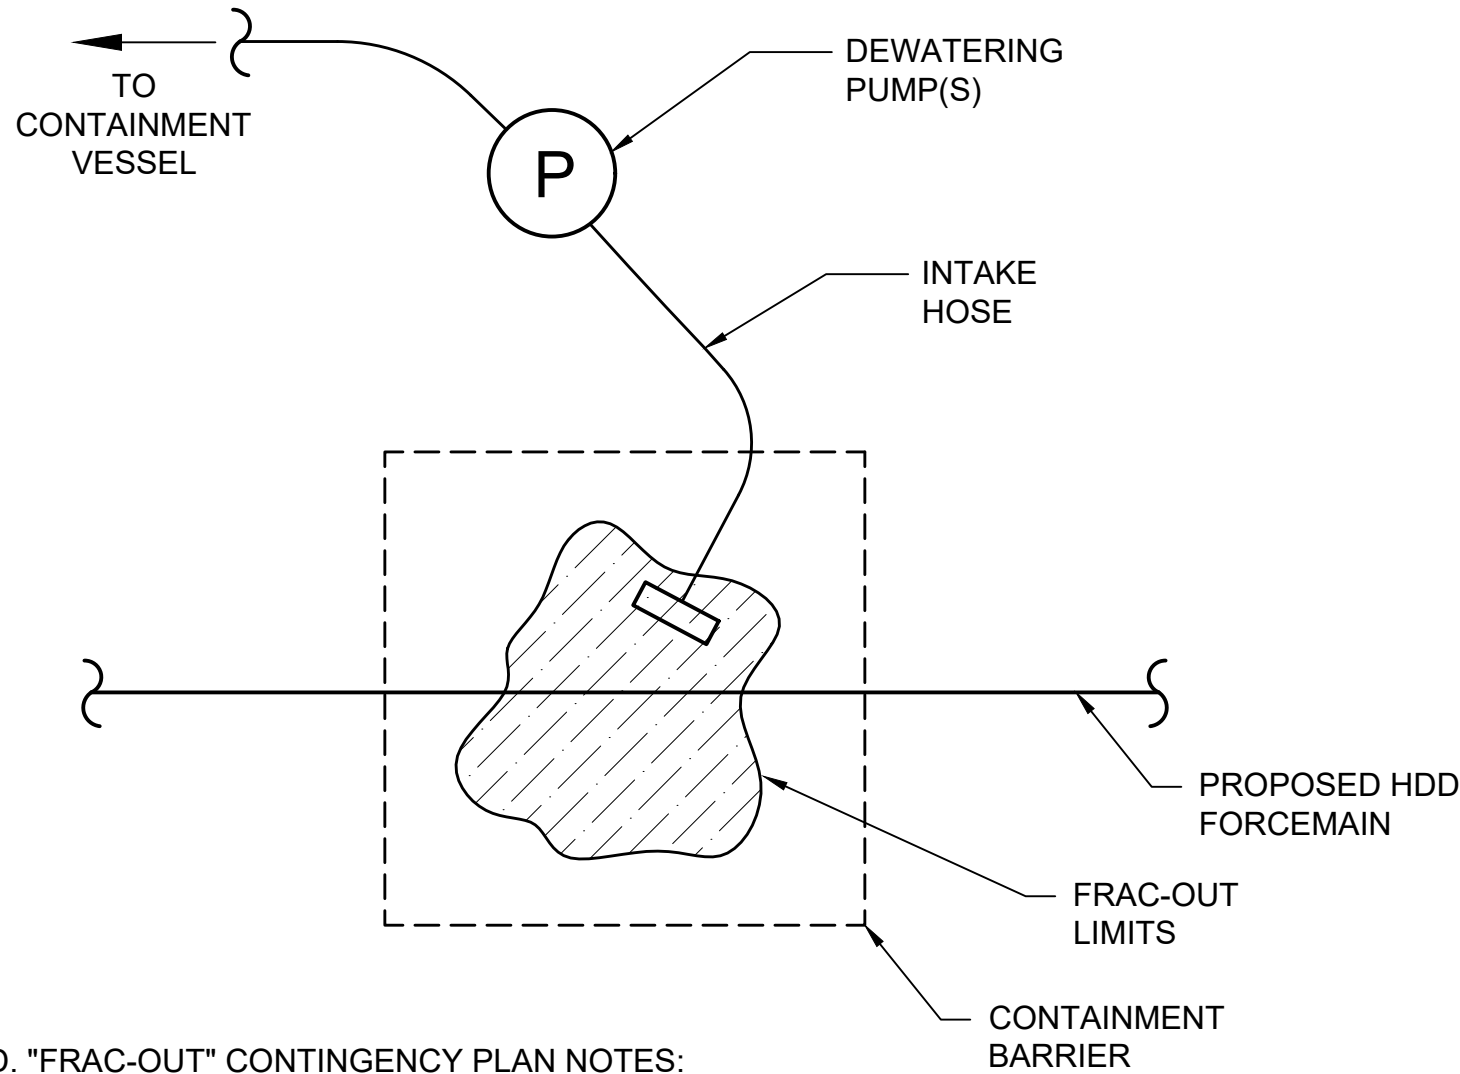


4
 DETAIL - OPEN CUT CROSSING AT "DRY" DITCH/STREAM
 NOT TO SCALE

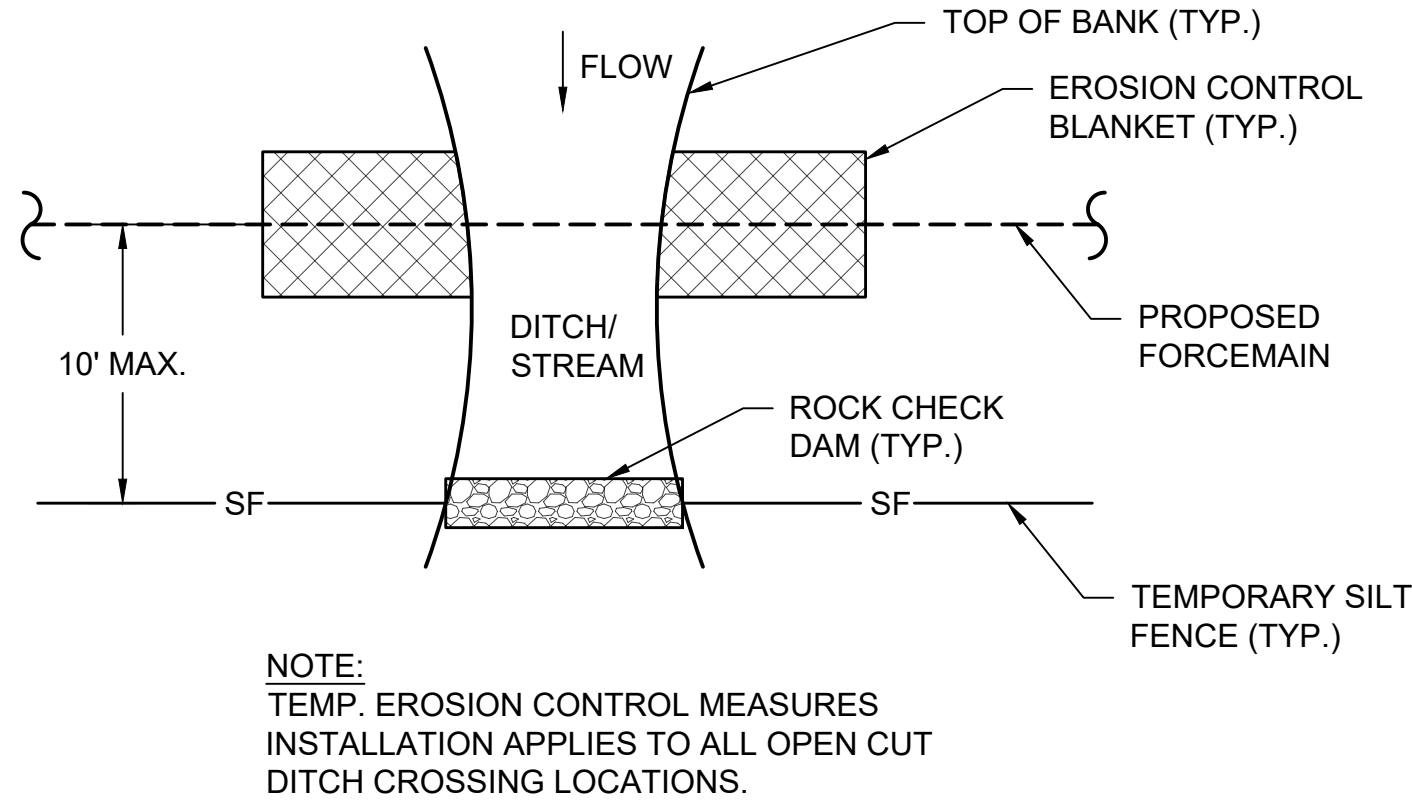

3
 DETAIL - TYP. BORE PIT LOCATION
 NOT TO SCALE

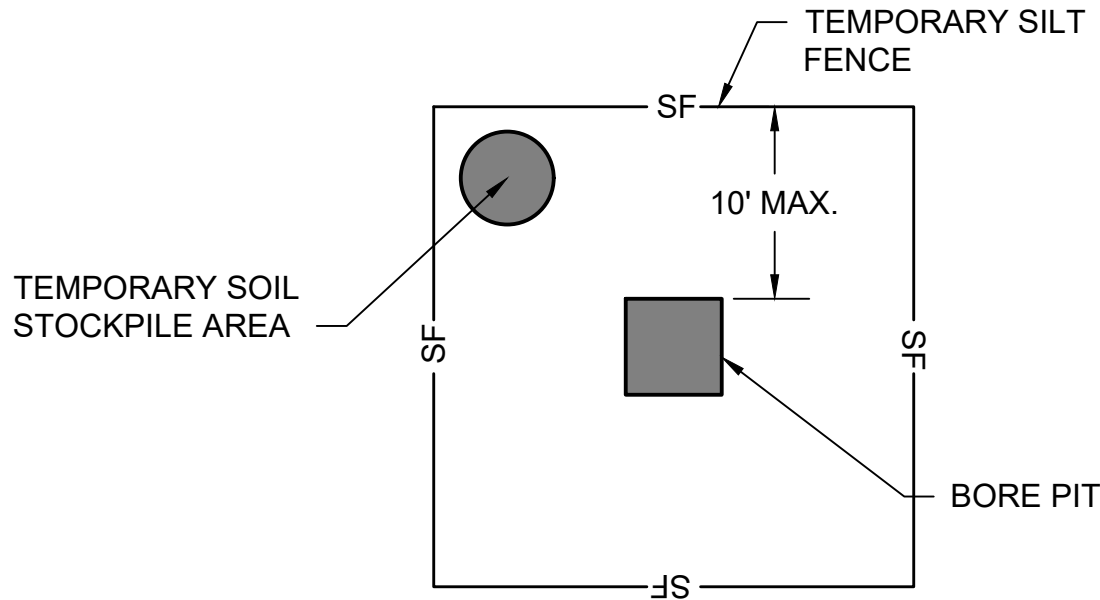

2
 DETAIL - TYP. OPEN CUT LOCATION
 NOT TO SCALE

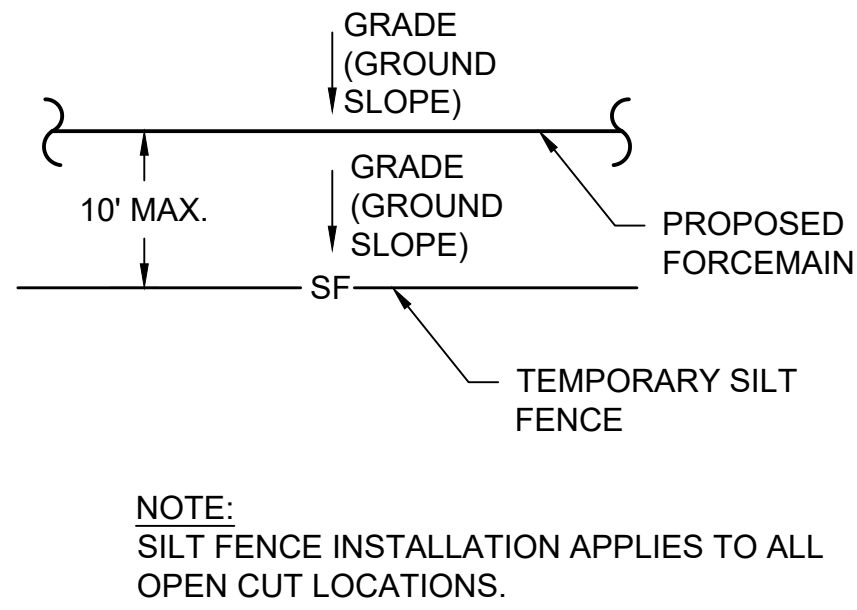

THIS RECORD DOCUMENT HAS BEEN PREPARED BASED ON INFORMATION PROVIDED BY THE CONSTRUCTION CONTRACTOR. GRW ENGINEERS, INC. HAS ATTEMPTED TO VERIFY THE ACCURACY AND/OR COMPLETENESS OF THIS INFORMATION BUT SHALL NOT BE RESPONSIBLE FOR ANY ERRORS OR OMISSIONS WHICH MAY BE INCORPORATED HEREIN AS A RESULT.

engineering | architecture | geospatial

ENGINEER/ARCHITECT: JOSEPH P. TIERNEY
 CONSTRUCTION COMPANY: B.L. BROWN COSNTRUCTION
 DATE: 08/29/2023

This document, originally issued, sealed, and signed by Joseph P Tierney, Indiana Professional Engineer, No.19300407, on July 2022, shall not be used in lieu of a certified document.

GRW PROJECT NO. 4923
 CLIENT PROJECT NO. --
ALL RIGHTS RESERVED. THIS DOCUMENT IS THE PROPERTY OF GRW ENGINEERS, INC. AND SHALL NOT BE REPRODUCED IN WHOLE OR IN PART WITHOUT THE WRITTEN PERMISSION OF GRW ENGINEERS, INC.

engineering | architecture | geospatial
 www.grwinc.com

EROSION CONTROL DETAILS I
 NEW LIFT STATION AND FORCEMAIN
 TOWN OF PENDLETON, INDIANA

DESIGNED	JPT	DATE	BY	NO.	DESCRIPTION	REVISIONS	SCALE CHECK	THIS MARK SHOULD MEASURE EXACTLY 1" WHEN PLOTTED
DRAWN	AMR	----	----	----	----	----		
REVIEWED	JPT							
APPROVED	JPT							

DATE: JULY 2022
 SCALE: N.T.S.
 SHEET NO. C-15