

ABBREVIATIONS

AB	ANCHOR BOLT	HB	HOSE BIBB	PO	PUSH ON
ABAND	ABANDONED	HCS	HOLLOW CORE SLAB	POL	POLISH
ABS	ABSOLUTE	HD	HEAD, HEAVY DUTY	POS	POSITION
ACOUST	ACOUSTICAL	HDN	HARDEN	PREFAB	PREFABRICATED
ADD	ADDENDUM	HDW	HARDWARE	PRESS	PRESSURE
ADDL	ADDITIONAL	HDWL	HEADWALL	PRI	PRIMARY
ADM	ADMINISTRATION	HGR	HANGER	PS	PUMP STATION
AFF	ABOVE FINISH FLOOR	HM	HOLLOW METAL	PSF	POUNDS PER SQUARE FOOT
AGG	AGGREGATE	HOL	HOLLOW	PSI	POUNDS PER SQUARE INCH
AHR	ANCHOR	HORIZ	HORIZONTAL	PSIG	POUNDS PER SQUARE INCH GAUGE
AL	ALUMINUM	HP	HORSEPOWER	PT	POINT
ALT	ALTERNATE	HPT	HIGH POINT	PTD	PAINTED
APPROX	APPROXIMATE	HR	HOUR	PVC	POLYVINYL CHLORIDE
ARCH	ARCHITECTURAL	HT	HEIGHT	PWR	POWER
ASB	ASBESTOS	HTR	HEATER		
AUX	AUXILIARY	HVY	HEAVY	QT	QUART
AVG	AVERAGE	HW	HOT WATER	QTY	QUANTITY
AWG	AMERICAN WIRE GAGE	HWL	HIGH WATER LEVEL		
		HWY	HIGHWAY		
		HYD	HYDRAULIC		
BC	BOLT CIRCLE			RAN	RANGE
BD	BOARD			RAD	RADIUS
BETW	BETWEEN	IAS	INTERCHANGE ACTIVATED SLUDGE	RAS	RETURN ACTIVATED SLUDGE
B'FLY	BUTTERFLY	IASFM	INTERCHANGE ACTIVATED SLUDGE	RASFM	RETURN ACTIVATED SLUDGE
BHP	BRAKE HORSEPOWER			RASFMA	RETURN ACTIVATED SLUDGE
BIT	BITUMINOUS	ID	INSIDE DIAMETER		
BL	BASE LINE, BUILDING LINE	IFM	INFLUENT FORCE MAIN	RCPT	RECEPTACLE
BLDG	BUILDING	IFMA	INFLUENT FORCE MAIN ALTERNATE	RD	ROOF DRAIN
BLK	BLOCK	ILLUM	ILLUMINATE	RDCR	REDUCER
BM	BENCH MARK, BEAM	ILLUS	ILLUSTRATE	RECD	RECEIVED
BOT	BOTTOM	IN	INCH	REF	REFERENCE
BP	BASE PLATE	INCR	INCREASER	REFG	REFRIGERATOR
BRG	BEARING	INFL	INFLUENT	REINF	REINFORCE
BSMT	BASEMENT	INSUL	INSULATION	REM	REMAINDER
BTU	BRITISH THERMAL UNIT	INT	INTERIOR	REPL	REPLACE
BU	BUILT UP	INV	INVERT	REQD	REQUIRED
BW	BOTH WAYS	ITI	INTERCHANGE TANK INFLUENT	RESIL	RESILIENT
BYP	BYPASS			REV	REVISION
		JT	JOINT	RJ	RESTRAINED JOINT
		JCT	JUNCTION	RM	ROOM
C	CENTIGRADE			RND	ROUND
CAP	CAPACITY			RPM	REVOLUTIONS PER MINUTE
CB	CATCH BASIN	KG	KILOGRAM		
CE	CLARIFIER EFFLUENT	KM	KILOMETER	S	SOUTH
CER	CERAMIC	KV	KILOVOLT	SCUM	SCUM
CFM	CUBIC FEET PER MINUTE	KVA	KILOVOLT - AMPERE	SCFM	SCUM FORCE MAIN
CFS	CUBIC FEET PER	KVAH	KILOVOLT - AMPERE HOUR	SCH	SCHEDULE
CHK	CHECK	KW	KILOWATT	SEC	SECOND
CHKR	CHECKERED	KWH	KILOWATT HOUR	SECT	SECTION
CI	CLARIFIER INFLUENT			SEQ	SEQUENCE
CIP	CAST IRON PIPE	L	LEFT, LONG	SFT	SHAFT
CJ	CONSTRUCTION JOINT	LAB	LABORATORY	SHLD	SHIELD
CL	CENTER LINE	LAM	LAMINATE	SHT	SHEET
CLG	CEILING	LBS	POUNDS	SIM	SIMILAR
CLO	CLOSET	LDG	LOADING	SK	SKETCH
CLR	CLEAR	LF	LINEAR FOOT	SOL	SOLENOID
CMU	CONCRETE MASONRY UNIT	LG	LENGTH	SPCS	SPACES
CO	COMPANY	LL	LEFT HAND	SPEC	SPECIFICATIONS
COL	COLUMN	LLH	LONG LEG HORIZONTAL	SP GR	SPECIFIC GRAVITY
CONC	CONCRETE	LLV	LONG LEG VERTICAL	SP HT	SPECIFIC HEAT
CONSTR	CONSTRUCTION	LPT	LOW POINT	SPRT	SUPPORT
CONT	CONTINUOUS	LS	LUMP SUM	SQ	SQUARE
CONTR	CONTRACTOR	LW	LONG WAY	SST	STAINLESS STEEL
CPLG	COUPLING			S/S	SERVICE SINK
CJ	CONTROL JOINT	MATL	MATERIAL	SS	SANITARY SEWER
CTR	CENTER	MAX	MAXIMUM	STA	STATION
CU	CUBIC	ME	MATCH EXISTING	STD	STANDARD
CW	CLOCKWISE	MECH	MECHANICAL	STIR	STIRRUP
		MED	MEDIUM	STL	STEEL
D	DEPTH	MFR	MANUFACTURER	STM	STORM
DBL	DOUBLE	MGD	MILLION GALLONS PER DAY	STRUCT	STRUCTURE
DET	DETAIL	MH	MANHOLE	SUSP	SUSPENDED
DF	DRINKING FOUNTAIN	MIN	MINIMUM	SW	STORM WATER
DI	DUCTILE IRON	MISC	MISCELLANEOUS	SYM	SYMBOL
DIA	DIAMETER	MJ	MECHANICAL JOINT	SYMM	SYMMETRICAL
DIM	DIMENSION	MO	MASONRY OPENING		
DIP	DUCTILE IRON PIPE	MP	MELTING POINT	T	TOP
DIR	DIRECTION	MTD	MOUNTED	T&B	TOP AND BOTTOM
DISTR	DISTRIBUTION	MTG	MOUNTING	TECH	TECHNICAL
DIV	DIVISION	MTL	METAL	TEMP	TEMPERATURE, TEMPERED
DL	DEAD LOAD			THEO	THEORETICAL
DN	DOWN	N	NORTH	THD	THREAD
DR	DRAIN	NATL	NATIONAL	THRES	THRESHOLD
DWG	DRAWING	NEG	NEGATIVE	THRU	THROUGH
		NET	NETWORK	TOF	TOP OF FOOTING
E	EAST	NEUT	NEUTRAL	TOL	TOLERANCE
EA	EACH	NIC	NOT IN CONTRACT	TOS	TOP OF STEEL
EF	EACH FACE	NO	NUMBER	TOT	TOTAL
EFL	EFFLUENT	NOM	NOMINAL	TRANS	TRANSFER
EJ	EXPANSION JOINT	NPT	NATIONAL PIPE THREAD	TW	TOP OF WALL
ELEC	ELECTRIC	NPW	NON-POTABLE WATER	TYP	TYPICAL
ELEV	ELEVATION	NR	NITRATE RECYCLE		
ELL	ELBOW	NRFM	NITRATE RECYCLE FORCE MAIN	UNIF	UNIFORM
ENCL	ENCLOSE	NTS	NOT TO SCALE	UON	UNLESS OTHERWISE NOTED
EO	EQUAL			UV	ULTRAVIOLET
EQUIP	EQUIPMENT	OBS	OBSOLETE		
EW	EACH WAY	OC	ON CENTER	V	VOLT
EXIST	EXISTING	OD	OUTSIDE DIAMETER	VAC	VACUUM
EXP	EXPANSION	ODE	OXIDATION DITCH EFFLUENT	VCT	VINYL COMPOSITION TILE
EXT	EXTERIOR	ODI	OXIDATION DITCH INFLUENT	VCP	VITRIFIED CLAY PIPE
		OF	OUTSIDE FACE	VERT	VERTICAL
FD	FLOOR DRAIN	OH	OVERHEAD	VISC	VISCOSITY
FDN	FOUNDATION	OPR	OPERATED	VLR	VERTICAL LOOP REACTOR
FIN	FINISH	OPNG	OPENING	VLRE	VERTICAL LOOP REACTOR EFFLUENT
FL	FLOOR	OPP	OPOSITE	VRS	VERSUS
FLEX	FLEXIBLE	ORG	ORIGINAL	VTR	VENT THROUGH ROOF
FLG	FLANGE, FLANGED	OVD	OVERHEAD		
FR	FRAME	OVL	OVERLOAD	W	WEST, WIDTH
FT	FOOT	OZ	OUNCE	W/	WITH
FTG	FOOTING			WAS	WASTE ACTIVATED SLUDGE
		PC	PIECE	WD	WOOD
G	GROUND	PCF	POUNDS PER CUBIC FOOT	WDW	WINDOW
GAL	GALLON	PE	PLAIN END	WG	WIRE GAGE
GALV	GALVANIZED	PEJ	PREMOLDED EXPANSION JOINT	WL	WATER LEVEL
GEN	GENERATOR	PERM	PERMANENT	WPG	WATERPROOFING
GENL	GENERAL	PERP	PERPENDICULAR	WR	WATER RESISTANT
GL	GLASS	PH	PHASE	WS	WASTE SLUDGE
GND	GROUND	PI	PLANT INFLUENT	WSDR	WASTE SLUDGE DRAIN
GR	GRADE	PKG	PACKING	WSE	WATER SURFACE ELEVATION
GRTG	GRATING	PL	PLATE	WWF	WELDED WIRE FABRIC
GSKT	GASKET	PNEU	PNEUMATIC		
GYP	GYP SUM			YD	YARD
GYP	GYP SUM WALLBOARD			YP	YIELD POINT
				YR	YEAR


LINETYPES

	EXISTING	NEW
FENCE	— X — X —	—○—○—
PROPERTY LINE	— — — P/L — — —	
RIGHT OF WAY	— — — R/W — — —	
UNDERGROUND ELECTRIC	— — — UGE — — —	
OVERHEAD UTILITY LINE	— — — OHU — — —	
UNDERGROUND COMMUNICATION	— — — T — — —	
UNDERGROUND FIBER OPTICS	— — — F/O — — —	
CREEK / SWALE	- - - - -	
SILT FENCE		— SF —
NATURAL GAS	— — — G — — —	
RAILROAD TRACKS		
SANITARY FORCE MAIN		— 12" FM —
SANITARY SEWERS	- - - - -	
STORM SEWERS		
WATER LINE	— — — W — — —	
CONTOUR LINE	— — — 800 — — —	— 800 —
SPOT ELEVATION	+ 800.00	800.00
YARD PIPING	— — — — —	— 800.00 —
STORM CULVERT	= = = = =	
PERMANENT EASEMENT	- - - - -	
EXISTING YARD PIPING TO BE ABANDONED IN PLACE	- X - X - X - X - X - X - X - X -	

MATERIALS - PLAN/SECTION

	EARTH
	CRUSHED STONE
	STRUCTURAL CONCRETE
	GROUT, PLASTER OR SAND
	ASPHALT PAVEMENT

BUBBLE & SECTIONING CONVENTIONS

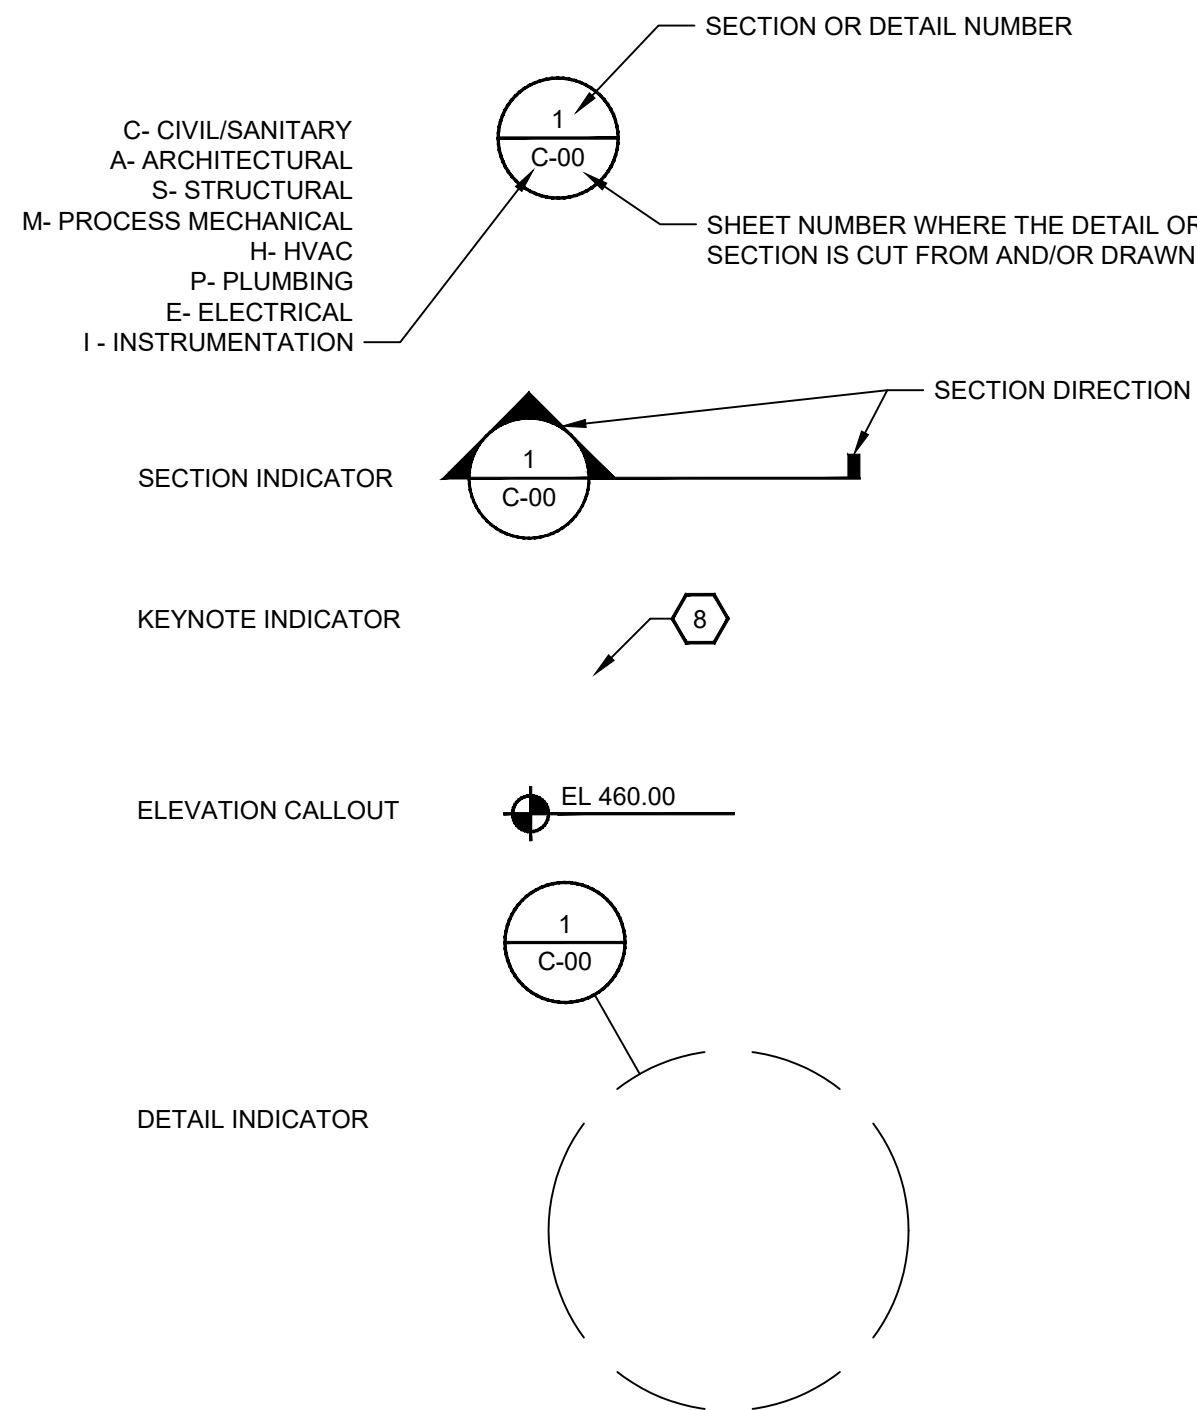

NOTE: SYMBOLS, MATERIALS AND ABBREVIATIONS MAY NOT BE ALL-INCLUSIVE. SYMBOLS USED BUT NOT LISTED HEREIN MAY BE DEFINED ELSEWHERE. IF NOT, CONTACT THE ENGINEER FOR CLARIFICATION PRIOR TO BIDDING. SYMBOLS, MATERIALS AND ABBREVIATIONS MISSING FROM THE DRAWINGS DO NOT EXCUSE THE CONTRACTOR FROM PROVIDING THE WORK.

SYMBOLS

	EXISTING	NEW		EXISTING	NEW
WATER METER	⊙ WM	⊙ WM	COMMUNICATIONS PEDESTAL	⊙ C	
LIFT STATION	⊙ LS	⊙ LS	UNDERGROUND TELEPHONE MARKER	⊙ T	
FIRE HYDRANT	⊙ F	⊙ F	TELEPHONE MANHOLE	⊙ T	
AIR RELEASE VALVE	⊙ A	⊙ A	TELEPHONE PEDESTAL	⊙ T	
BLOW OFF VALVE	⊙ BO	⊙ BO	BOLLARD	●	●
WATER MAIN BEND		⊙	SECTION CORNER	⊙	
WATER MAIN CAP/PLUG		⊙	SURVEY CONTROL POINT	⊙	
WATER MAIN TEE		⊙	SURVEY BENCHMARK	⊙	
WATER MAIN CROSS		⊙	TELEVISION ANTENNA	⊙	
REDUCER	⊙ WV	⊙ WV	FIELD DRAIN	⊙ FD	
WATER VALVE	⊙ W	⊙ W	FLAG POLE	⊙	
WATER MAIN MARKER	⊙ W	⊙ W	HEADSTONE	⊙	
PUMP STATION	⊙ PS	⊙ PS	MAILBOX	⊙	
WATER SERVICE	⊙ WS	⊙ WS	PARKING METER	⊙ PM	
IN LINE CONTROL VALVE	⊙ CV	⊙ CV	PLANTER BOX	⊙	
SANITARY MANHOLE	⊙ S	⊙ S	RAILROAD SIGNAL	⊙	
CORPORATION STOP	⊙ CSS	⊙ CSS	RAILROAD GATE	⊙	
SANITARY SEWER MARKER	⊙ SA	⊙ SA	RIGHT OF WAY MONUMENT	⊙ RW	
SANITARY SEWER VALVE	⊙ SV	⊙ SV	PROPERTY CORNER	⊙	
SANITARY SEWER VALVE VAULT	⊙ V	⊙ V	ROCK SOUNDING	⊙ RS	
SANITARY SEWER WET WELL	⊙ WW	⊙ WW	SOIL BORING	⊙ SB	
SEPTIC TANK	⊙ ST	⊙ ST	ROCK ELEVATION (PROFILE)	⊙	
CLEAN OUT	⊙ C	⊙ C	SATELLITE DISH	⊙	
CATCH BASIN	⊙ CB	⊙ CB	SIGN	⊙	
DOUBLE CATCH BASIN	⊙ CB	⊙ CB	SIGN WITH MAST ARM	⊙	
CURB INLET	⊙ CI	⊙ CI	SINK HOLE	⊙	
CIRCULAR INLET	⊙ CI	⊙ CI	IRRIGATION SPRINKLER HEAD	⊙	
STORM SEWER MANHOLE	⊙ ST	⊙ ST	STEAM MANHOLE	⊙ SM	
NATURAL GAS METER	⊙ GM	⊙ GM	TRAFFIC LIGHT CONTROL BOX	⊙ TR	
NATURAL GAS PRESSURE VALVE	⊙ PV	⊙ PV	TRAFFIC LIGHT MAST POLE	⊙	
NATURAL GAS STOP	⊙ GS	⊙ GS	TRAFFIC LIGHT LOOP DETECTOR	⊙	
NATURAL GAS VALVE	⊙ GV	⊙ GV	TRAFFIC LIGHT MANHOLE	⊙ TR	
NATURAL GAS MARKER	⊙ G	⊙ G	WELL	⊙ W	
NATURAL GAS VENT	⊙ GV	⊙ GV	YARD LIGHT	⊙	
NATURAL GAS WELL	⊙ GW	⊙ GW	MONITORING WELL	⊙ MW	
ELECTRIC MANHOLE	⊙ E	⊙ E	VEGETATION	⊙	
ELECTRIC METER	⊙ EM	⊙ EM	DECIDUOUS TREE	⊙	⊙
ELECTRIC PEDESTAL	⊙ E	⊙ E	PINE TREE	⊙	⊙
ELECTRIC TRANSFORMER PAD	⊙ ET	⊙ ET	TREE STUMP	⊙	⊙
ELECTRIC HAND HOLE BOX	⊙ EH	⊙ EH			
DOWN GUY WIRE	⊙	⊙			
LIGHT POLE	⊙	⊙			
UTILITY POLE	⊙	⊙			
ELECTRIC MARKER	⊙	⊙			
UNDERGROUND FIBER MARKER	⊙	⊙			
FIBER MANHOLE	⊙	⊙			
POST	⊙	⊙			

THIS RECORD DOCUMENT HAS BEEN PREPARED BASED ON INFORMATION PROVIDED BY THE CONSTRUCTION CONTRACTOR. GRW ENGINEERS, INC. HAS ATTEMPTED TO VERIFY THE ACCURACY AND/OR COMPLETENESS OF THIS INFORMATION BUT SHALL NOT BE RESPONSIBLE FOR ANY ERRORS OR OMISSIONS WHICH MAY BE INCORPORATED HEREIN AS A RESULT.

engineering | architecture | geospatial

ENGINEER/ARCHITECT: JOSEPH P. TIERNEY

CONSTRUCTION COMPANY: B.L. BROWN CONSTRUCTION

DATE: 08/29/2023

This document, originally issued, sealed, and signed by Joseph P Tierney, Indiana Professional Engineer, No.19300407, on July 2022, shall not be used in lieu of a certified document.

GRW PROJECT NO.	4923
CLIENT PROJECT NO.	-
ALL RIGHTS RESERVED. NO PART OF THIS DOCUMENT MAY BE REPRODUCED IN WHOLE OR IN PART WITHOUT WRITTEN PERMISSION.	

engineering | architecture | geospatial

www.grwinc.com

SYMBOLS AND ABBREVIATIONS
 NEW LIFT STATION AND FORCEMAIN
 TOWN OF PENDLETON, INDIANA

DESIGNED	JPT
DRAWN	AMR
REVIEWED	JPT
APPROVED	JPT

NO	DATE	DESCRIPTION
1	08/29/2023	ISSUED FOR BIDDING

DATE	JULY 2022
SCALE	N.T.S.
SHEET NO.	G-02