


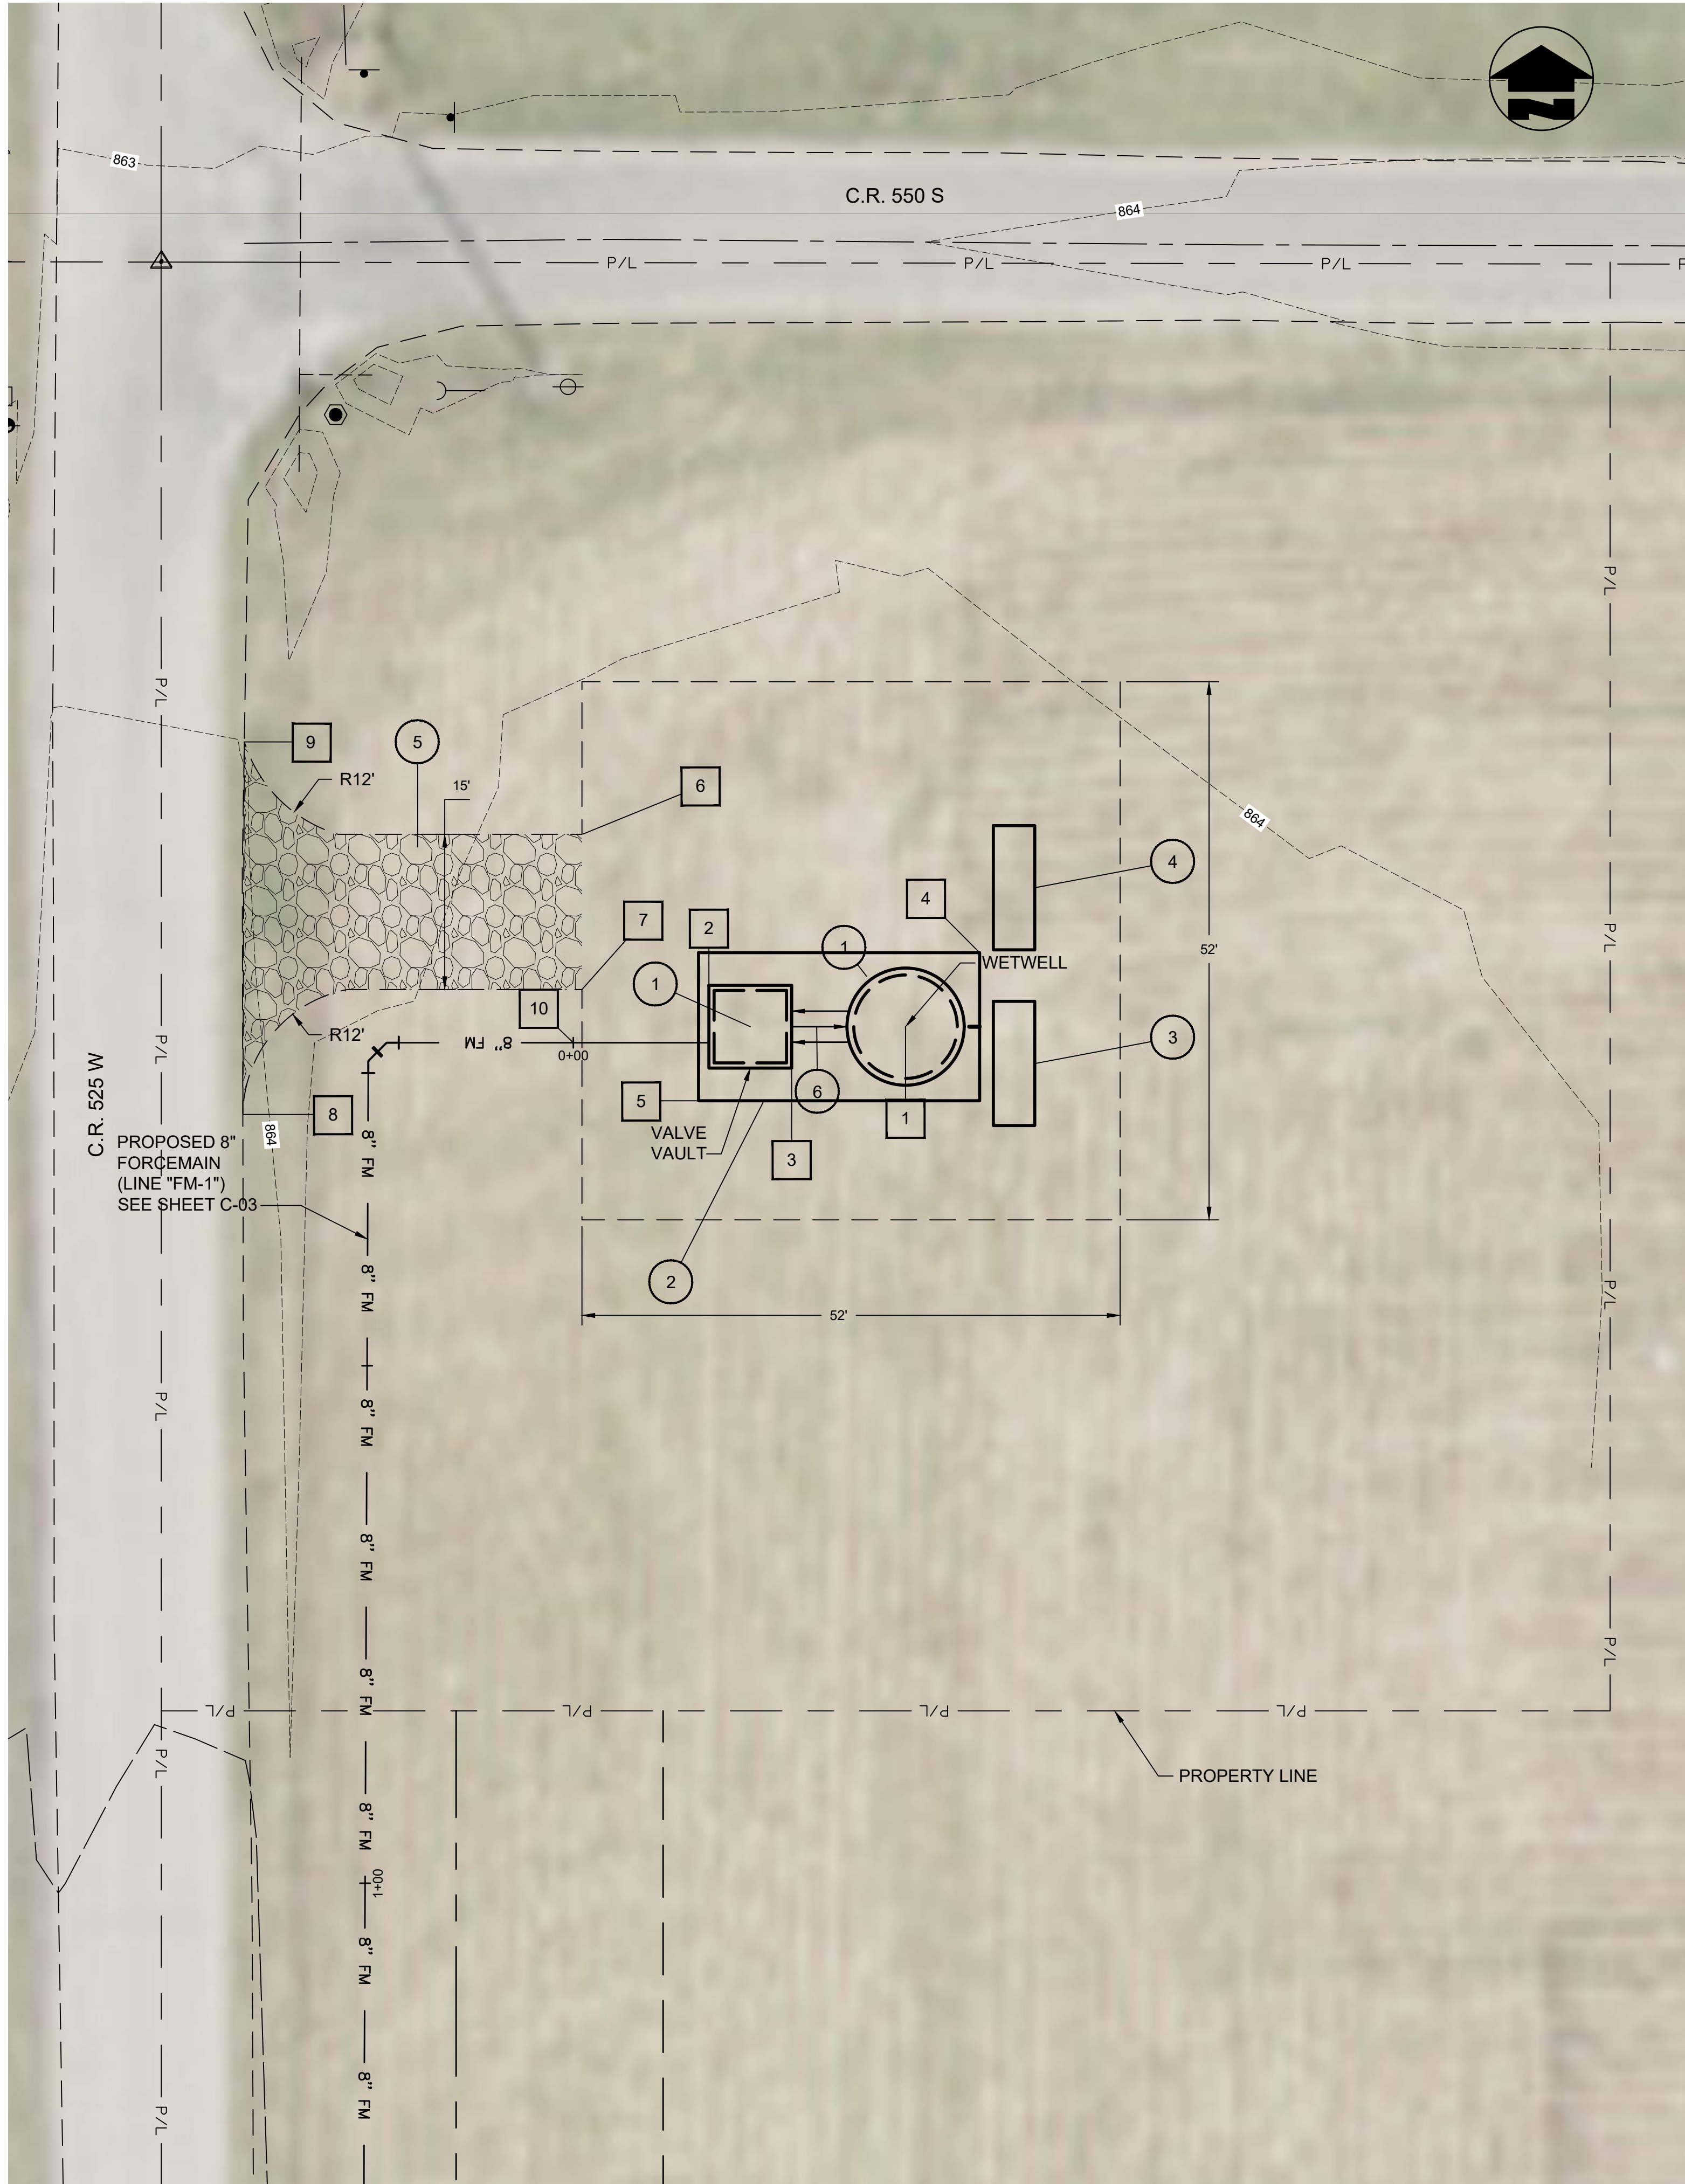

1 LIFT STATION SITE PLAN
SCALE: 1"=10'-0"

SHEET NOTES

- EXISTING SURFACES SHALL BE RESTORED TO CONDITIONS EQUAL TO OR BETTER THAN ORIGINAL CONDITIONS USING NEW MATERIALS ONLY. ALL DISTURBED GRASS AREAS OUTSIDE OF PROPOSED PAVEMENT LIMITS SHALL BE RE-SEEDED PER SPECIFICATIONS.
- PROVIDE POSITIVE SURFACE WATER DRAINAGE RELIEF AROUND ALL LIFT STATION AND MANHOLE STRUCTURES.
- CONTRACTOR SHALL INSTALL TEMPORARY SILT FENCE AROUND ALL DISTURBED AREAS, INCLUDING STAGING AREAS. REFER TO SPEC. SECTION 02370 AND EROSION CONTROL DETAILS FOR EROSION CONTROL REQUIREMENTS.
- CONTRACTOR SHALL PROTECT/SECURE CONSTRUCTION SITE PERIMETER FROM PUBLIC ACCESSIBILITY AT ALL TIMES.
- CONTRACTOR SHALL OBTAIN COUNTY R/W PERMITTING PRIOR TO COMMENCING WORK ACTIVITIES IF ANY VEHICLES, EQUIPMENT, CONSTRUCTION ACTIVITIES, ETC. WILL BE LOCATED WITHIN R/W.

LOCATION COORDINATES			
POINT	NORTHING	EASTING	TYPE
01	1739921.3458	298466.9213	CENTER WETWELL
02	1739917.3458	298455.9213	COR. VALVE VAULT
03	1739925.3458	298447.9213	COR. VALVE VAULT
04	1739928.5058	298474.0813	COR. CONC PAD
05	1739914.1858	298446.9213	COR. CONC PAD
06	1739939.9369	298435.6527	COR. GRAVEL DRIVE
07	1739924.9369	298435.6527	COR. GRAVEL DRIVE
08	1739912.9412	298402.8904	EDGE OF DRIVE RADIUS
09	1739948.8608	298403.0327	EDGE OF DRIVE RADIUS
10	1739919.7978	298434.8263	START NEW F.M.

IMPROVEMENTS KEYNOTES:

- REFER TO SHEET C-02 FOR NEW LIFT STATION (WETWELL AND VALVE VAULT).
- NEW CONCRETE SLAB - NOT IN THIS CONTRACT
- REFER TO SHEET E-05 FOR ELECTRICAL SITE IMPROVEMENTS AND CONTROL PANEL. *-NOT IN THIS CONTRACT*
- NEW PERMANENT GENERATOR; REFER TO ELECTRICAL DRAWINGS. *-NOT IN THIS CONTRACT*
- NEW GRAVEL ACCESS DRIVE TO APPROX. LIMITS SHOWN.
- NEW 3" SCH. 80 PVC DRAIN FROM NEW VALVE VAULT TO NEW WETWELL; CORE DRILL AND LINK SEAL; SLOPE 1% TO DRAIN; EXTEND DRAIN 3" BEYOND INSIDE FACE OF WETWELL AND ATTACH "DUCKBILL" CHECK VALVE TO END.

THIS RECORD DOCUMENT HAS BEEN PREPARED BASED ON INFORMATION PROVIDED BY THE CONSTRUCTION CONTRACTOR. GRW ENGINEERS, INC. HAS ATTEMPTED TO VERIFY THE ACCURACY AND/OR COMPLETENESS OF THIS INFORMATION BUT SHALL NOT BE RESPONSIBLE FOR ANY ERRORS OR OMISSIONS WHICH MAY BE INCORPORATED HEREIN AS A RESULT.

GRW
engineering | architecture | geospatial

ENGINEER/ARCHITECT: JOSEPH P. TIERNEY

CONSTRUCTION COMPANY: B.L. BROWN COSNTRUCTION

DATE: 08/29/2023

SURFACE LEGEND

PROPOSED GRAVEL DRIVE AREA

This document, originally issued, sealed, and signed by Joseph P Tierney, Indiana Professional Engineer, No.19300407, on July 2022, shall not be used in lieu of a certified document.

GRW PROJECT NO. 4923	CLIENT PROJECT NO. -
ALL RIGHTS RESERVED. NO PART OF THIS DOCUMENT SHALL BE REPRODUCED IN WHOLE OR IN PART WITHOUT WRITTEN PERMISSION OF GRW ENGINEERS, INC. AND SHALL NOT BE USED FOR ANY OTHER PROJECT OTHER THAN THIS SPECIFIC PROJECT WITHOUT WRITTEN PERMISSION.	

engineering | architecture | geospatial

www.grwinc.com

NEW LIFT STATION SITE
IMPROVEMENTS PLAN
NEW LIFT STATION AND FORCEMAIN
TOWN OF PENDLETON, INDIANA

NO.	DESCRIPTION	DESIGNED		DRAWN		REVIEWED		APPROVED	
		DATE	BY	DATE	BY	DATE	BY	DATE	BY

1	ADDENDUM #1	9/6/23	LAD						

DATE:	JULY 2022
SCALE:	1"=10'
SHEET NO.	

C-01