



PLOTTED BY: Arowley

PRINTED: 9/6/2023 @ 12:52PM

FILE NAME: G:\4923-FCRWD-SWW\Working Drawings\AutoCAD\4923-C-04.dwg

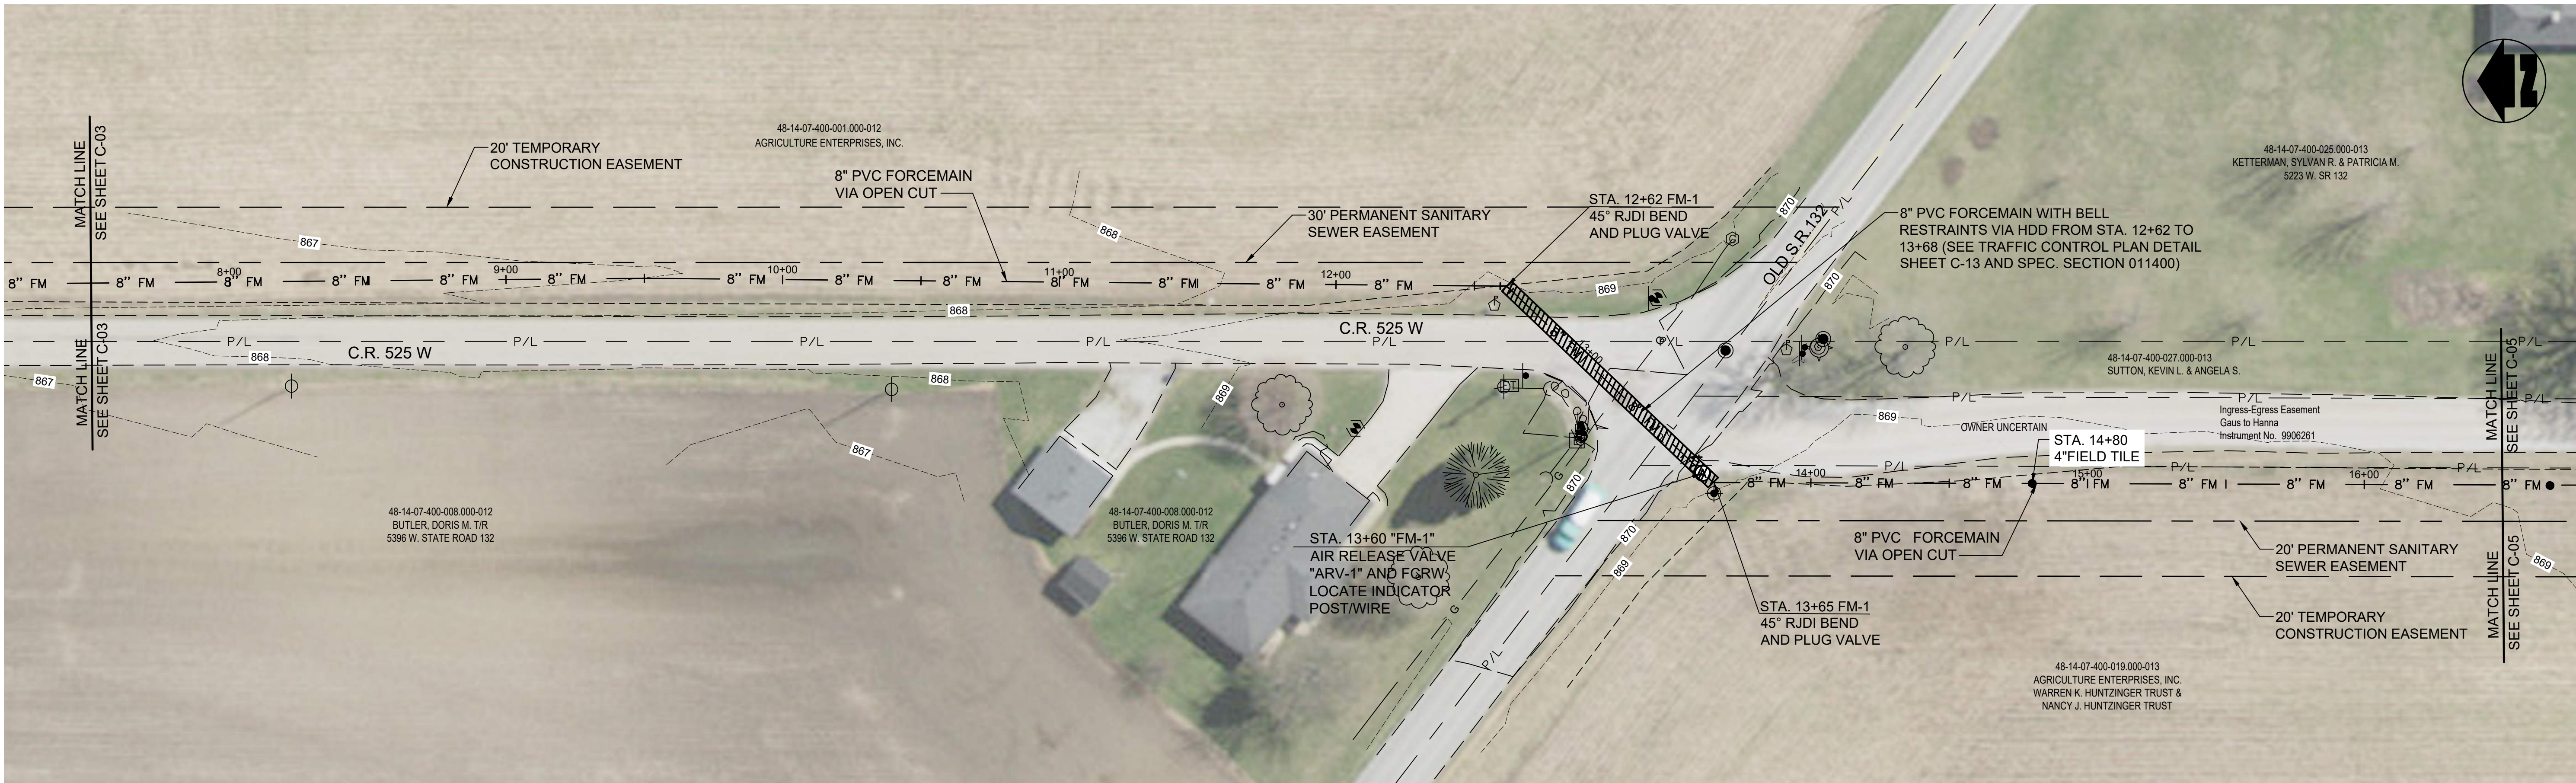

PLAN VIEW - STA. 7+50 TO STA. 16+50 LINE "FM-1"

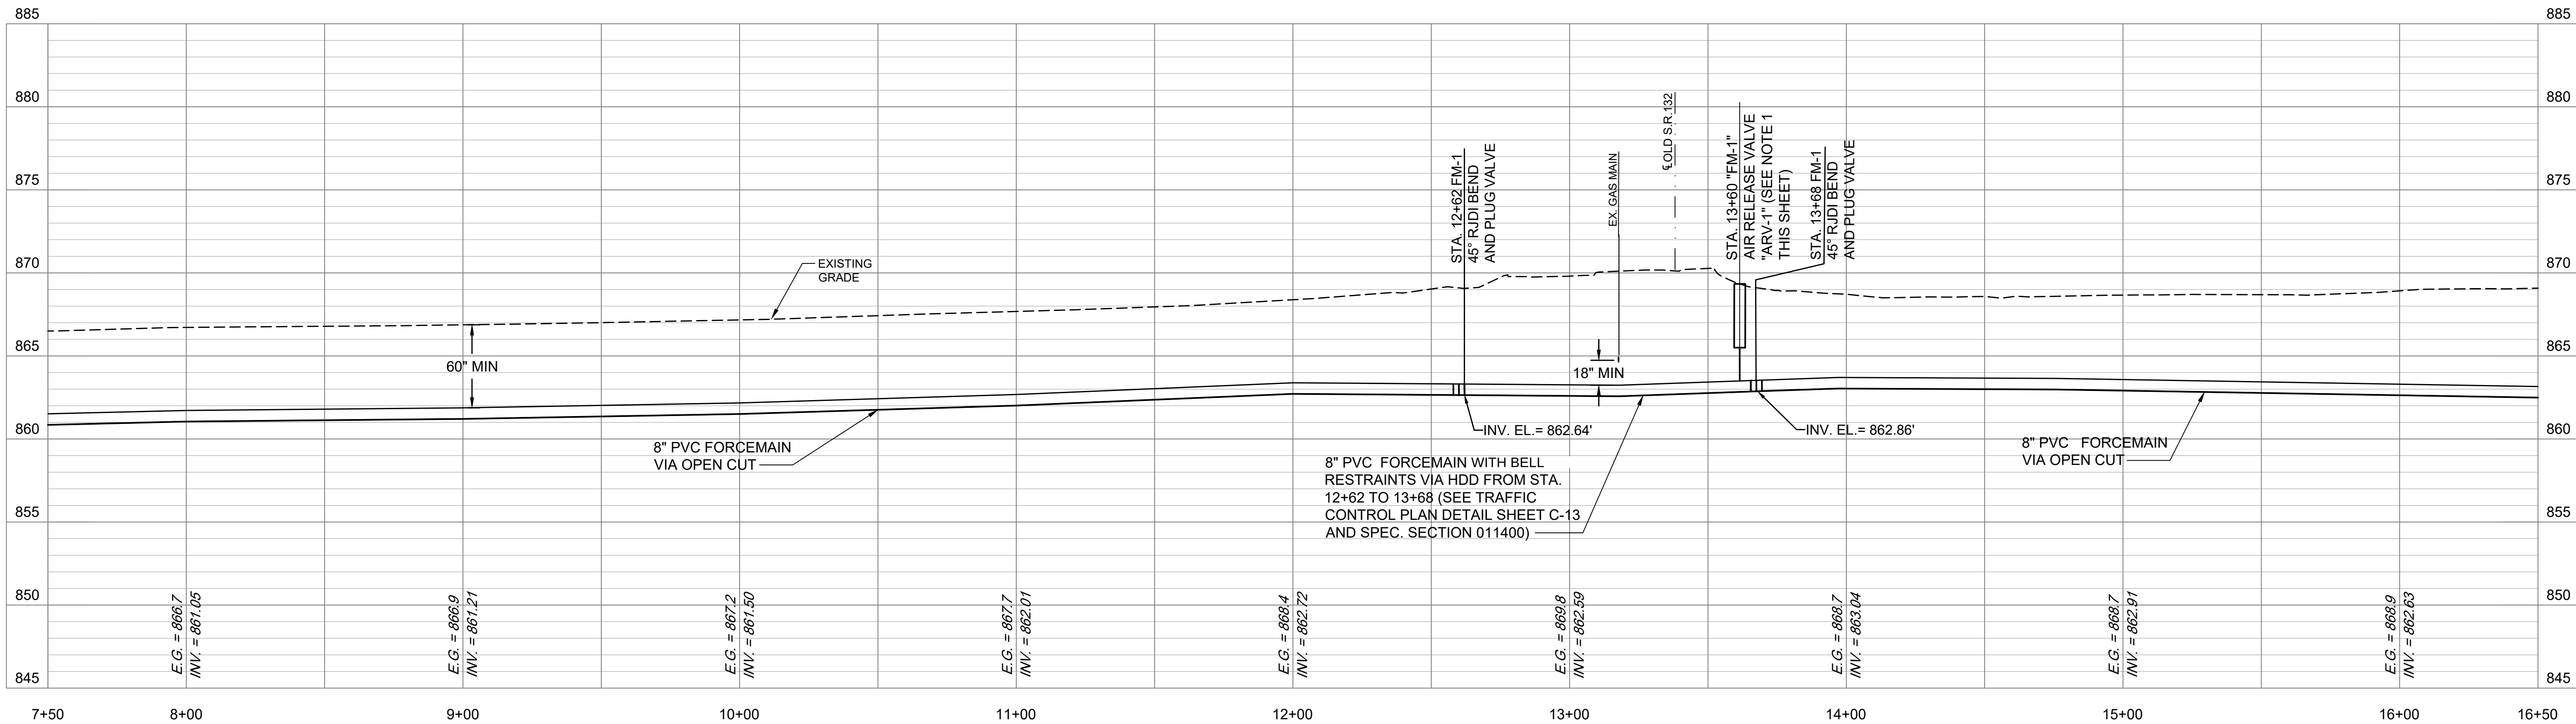

PROFILE - STA. 7+50 TO STA. 16+50 LINE "FM-1"

- NOTES:
- CONTRACTOR SHALL OBTAIN COUNTY AND/OR TOWN OF PENDLETON RIGHT-OF-WAY CUT PERMITTING PRIOR TO COMMENCING WORK ACTIVITIES WITHIN THE RIGHT-OF-WAY.


THIS RECORD DOCUMENT HAS BEEN PREPARED BASED ON INFORMATION PROVIDED BY THE CONSTRUCTION CONTRACTOR. GRW ENGINEERS, INC. HAS ATTEMPTED TO VERIFY THE ACCURACY AND/OR COMPLETENESS OF THIS INFORMATION BUT SHALL NOT BE RESPONSIBLE FOR ANY ERRORS OR OMISSIONS WHICH MAY BE INCORPORATED HEREIN AS A RESULT.

engineering | architecture | geospatial

ENGINEER/ARCHITECT: JOSEPH P. TIERNEY

CONSTRUCTION COMPANY: B.L. BROWN CONSTRUCTION

DATE: 08/29/2023

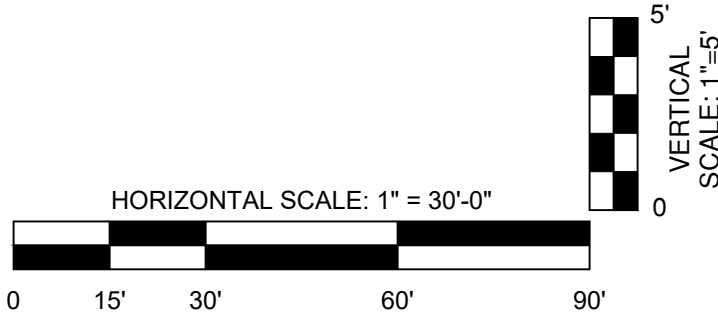

This document, originally issued, sealed, and signed by Joseph P Tierney, Indiana Professional Engineer, No.19300407, on July 2022, shall not be used in lieu of a certified document.

GRW PROJECT NO. 4923

CLIENT PROJECT NO. --

ALL RIGHTS RESERVED. NO PART OF THIS DOCUMENT MAY BE REPRODUCED IN WHOLE OR IN PART WITHOUT WRITTEN PERMISSION.

engineering | architecture | geospatial

www.grwinc.com

PLAN AND PROFILE - LINE "FM-1"

STA. 7+50 TO STA. 16+50

NEW LIFT STATION AND FORCEMAIN

TOWN OF PENDLETON, INDIANA

REVISED	DATE	BY	DESCRIPTION	DESIGNED	JPT	AMR	JPT	APPROVED	JPT
1	9/9/23	LAD	ADDENDUM #1						

DATE: JULY 2022

SCALE: H: 1"=30' V: 1"=5'

SHEET NO. C-04

RECORD DWG