



PLOTTED BY: Arowley

PRINTED: 9/6/2023 @ 12:52PM

FILE NAME: S:\4923-FCRWD-SWW\Working Drawings\AutoCAD\4923-C-05.dwg

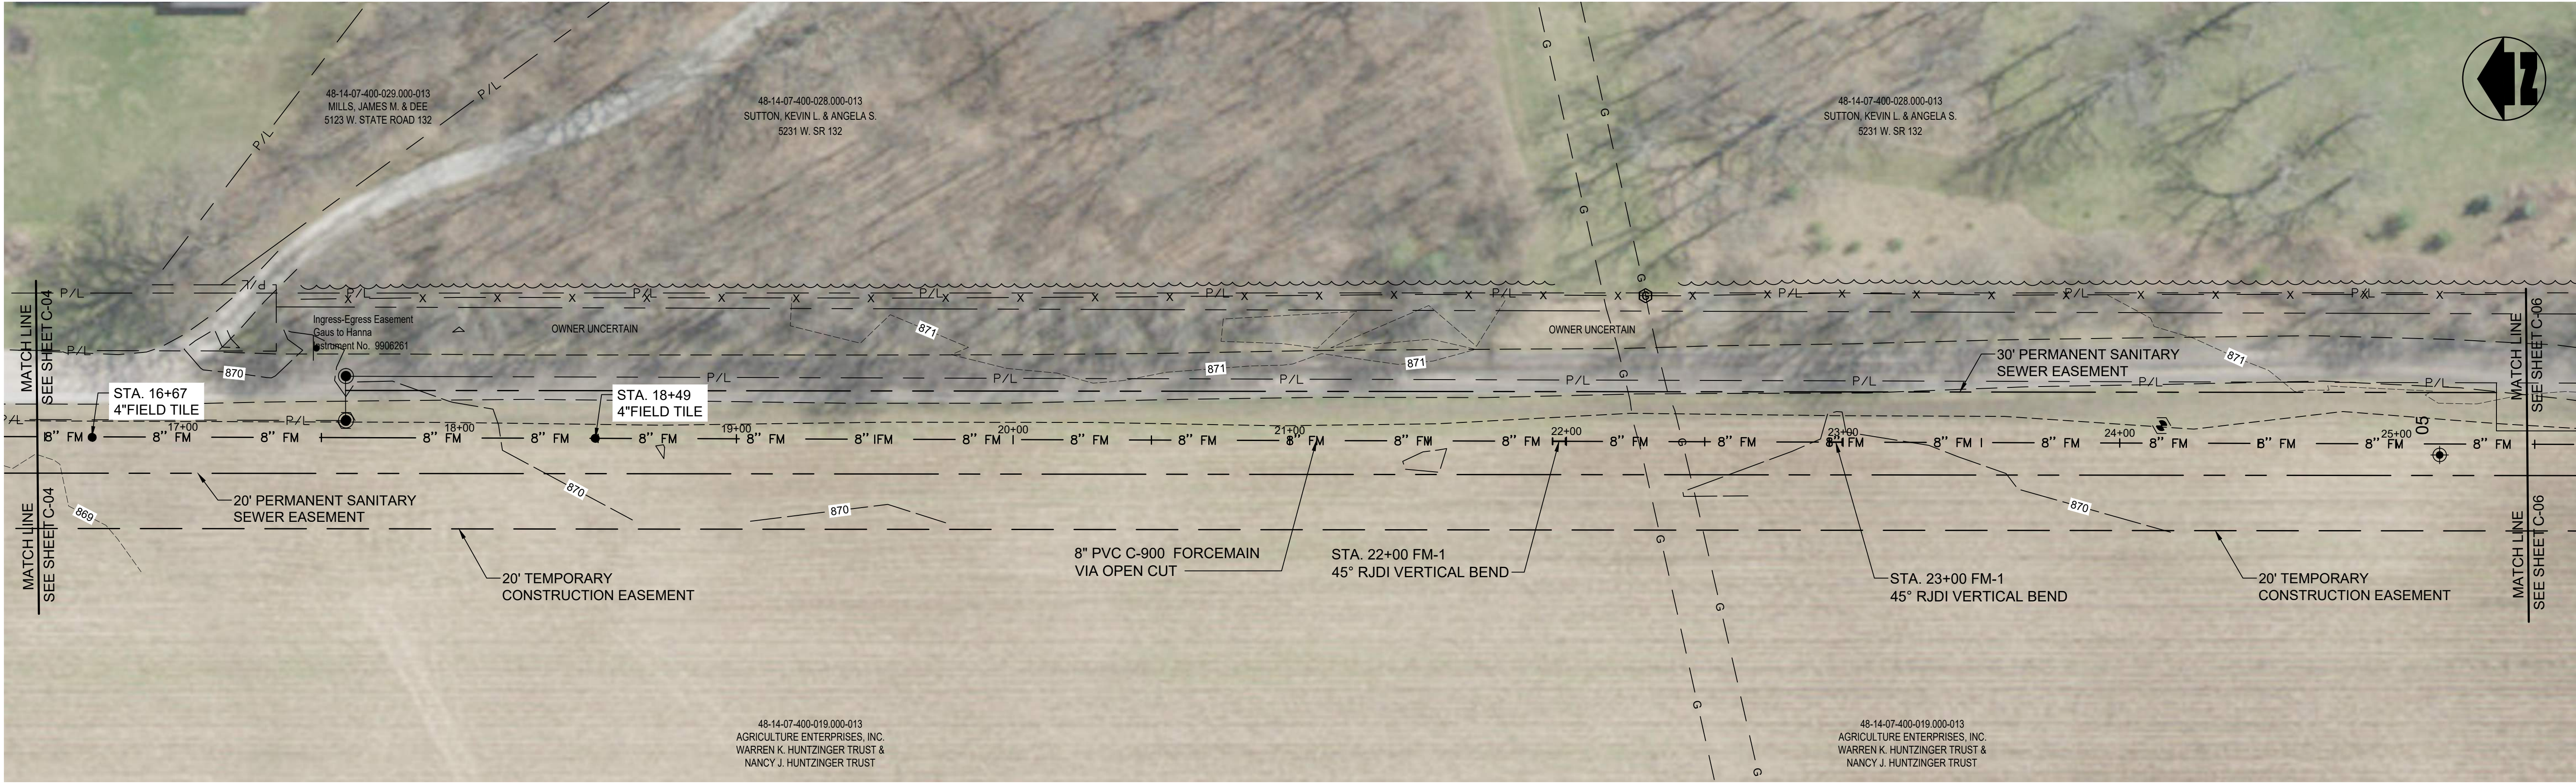

PLAN VIEW - STA. 16+50 TO STA. 25+50 LINE "FM-1"

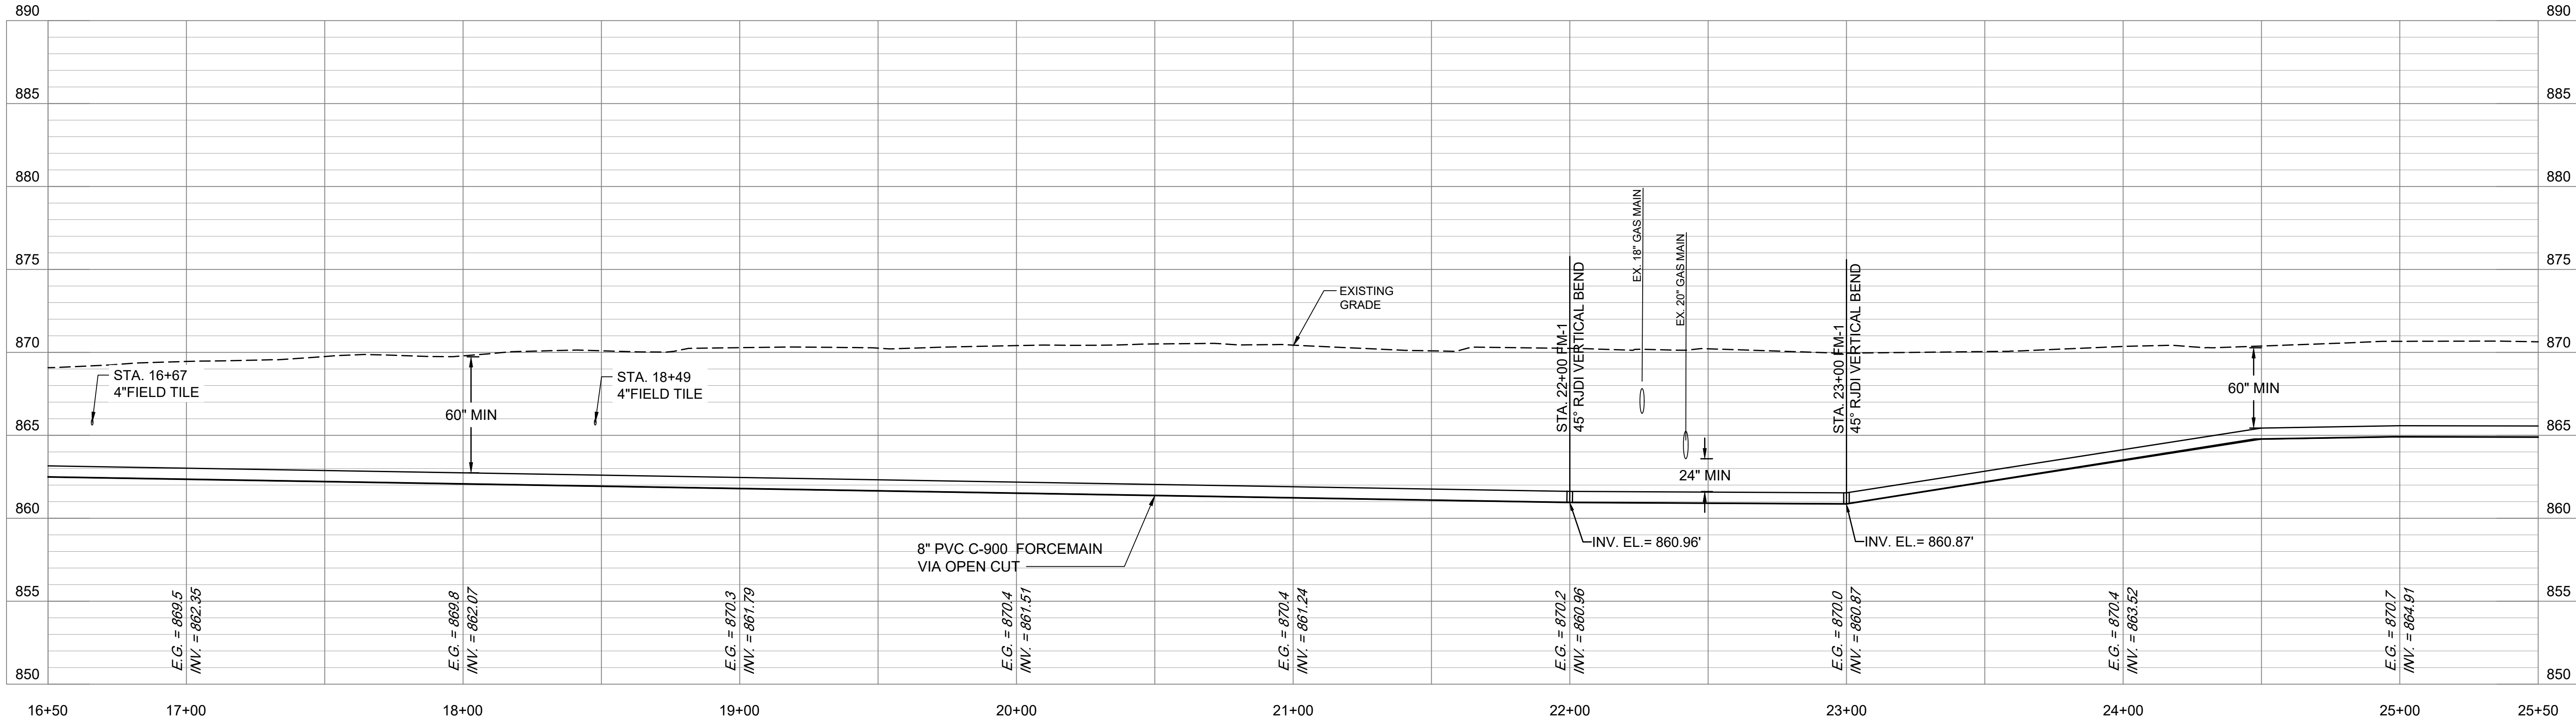


PROFILE - STA. 16+50 TO STA. 25+50 LINE "FM-1"

- NOTES:
 1. ARV VAULT SHALL BE KEPT AS NEAR AS PRACTICAL TO THE PROPERTY LINE AND OUT OF CROP FIELD. INSTALL REMOTE ARV OTHERWISE. (SEE DETAIL SHEET C-12)

THIS RECORD DOCUMENT HAS BEEN PREPARED BASED ON INFORMATION PROVIDED BY THE CONSTRUCTION CONTRACTOR. GRW ENGINEERS, INC. HAS ATTEMPTED TO VERIFY THE ACCURACY AND/OR COMPLETENESS OF THIS INFORMATION BUT SHALL NOT BE RESPONSIBLE FOR ANY ERRORS OR OMISSIONS WHICH MAY BE INCORPORATED HEREIN AS A RESULT.

engineering | architecture | geospatial

ENGINEER/ARCHITECT: JOSEPH P. TIERNEY
 CONSTRUCTION COMPANY: B.L. BROWN CONSTRUCTION
 DATE: 08/29/2023

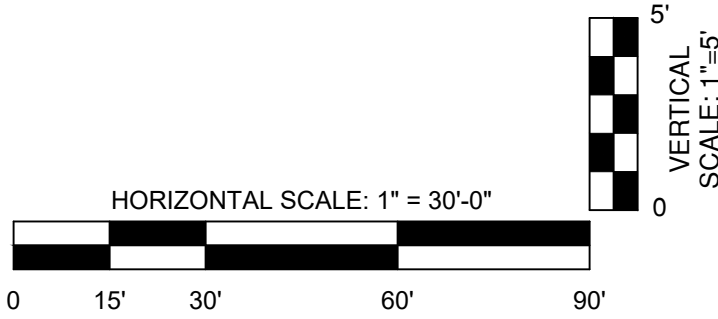

This document, originally issued, sealed, and signed by Joseph P Tierney, Indiana Professional Engineer, No. 19300407, on July 2022, shall not be used in lieu of a certified document.

GRW PROJECT NO. 4923	CLIENT PROJECT NO. --
ALL RIGHTS RESERVED. NO PART OF THIS DOCUMENT OR ANY INFORMATION CONTAINED HEREIN SHALL BE REPRODUCED IN WHOLE OR IN PART WITHOUT WRITTEN PERMISSION.	

engineering | architecture | geospatial

www.grwinc.com

PLAN AND PROFILE - LINE "FM-1"
 STA. 16+50 TO STA. 25+50
 NEW LIFT STATION AND FORCEMAIN
 TOWN OF PENDLETON, INDIANA

REVISIONS				DESIGNED:	JPT
NO	DESCRIPTION	DATE	BY	DRAWN	
1	ADDENDUM #1	9/9/22	LAD		AMR
					REVIEWED: JPT
					APPROVED: JPT
SCALE CHECK: _____ THIS MARK SHOULD MEASURE EXACTLY 1" WHEN PLOTTED					

DATE: JULY 2022
 SCALE: H: 1"=30' V: 1"=5'
 SHEET NO.

C-05

RECORD DWG