


LEGEND

RIGHT-OF-WAY LINE

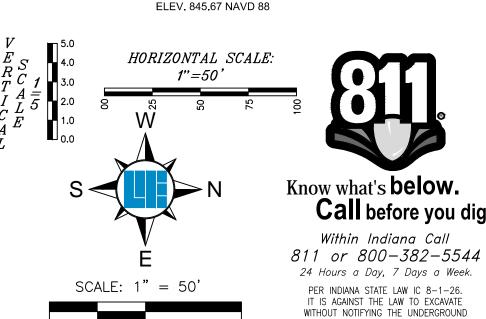

25 50

LOCATION SERVICE TWO (2) WORKING

DAYS BEFORE COMMENCING WORK.

W170338-2