

GENERAL NOTES


1. BERM ARE TO BE GRADED WITH A SMOOTH, NATURAL LOOKING TRANSITION TO ADJACENT GRADES.
2. WORK INSIDE OF ROW TO BE COORDINATED WITH LOCAL OFFICIALS.
3. ALL STORM SEWER PIPE AND SUBDRAINS TO BE CONSTRUCTED IN PHASE 1.
4. ALL EARTHWORK TO BE DONE IN PHASE 1 INCLUDING BUILDING PADS.
5. M.E. = MATCH EXISTING GRADE ELEVATION
6. ——— DIRECTIONAL FLOW ARROW
7. CONCRETE SPLASH BLOCKS AT ALL DOWNSPOUT LOCATIONS. SEE ARCHITECTURAL PLANS FOR FINAL LOCATIONS AND QUANTITY.

BENCHMARK:

HCOX DISK AT NW END OF S.R. ROAD #38 BRIDGE OVER I-69, STAMPED "MAD 652". ELEV. 897.84

TBM #1 CUT SQUARE ON TOP OF CONCRETE LIGHT BASE ON NORTH PROPERTY LINE, 3.5' WEST OF BACK OF CURB ON WEST SIDE OF VILLAGE DRIVE AND 1.5' SOUTH OF END OF STREET. ELEV. 873.17

TBM #2 PK NAIL 1.0' UP ON NORTH SIDE OF POWER POLE APPROX. 10' WEST OF SOUTHWEST PROPERTY CORNER AND ON SOUTH PROPERTY LINE EXTENDED. ELEV. 871.16

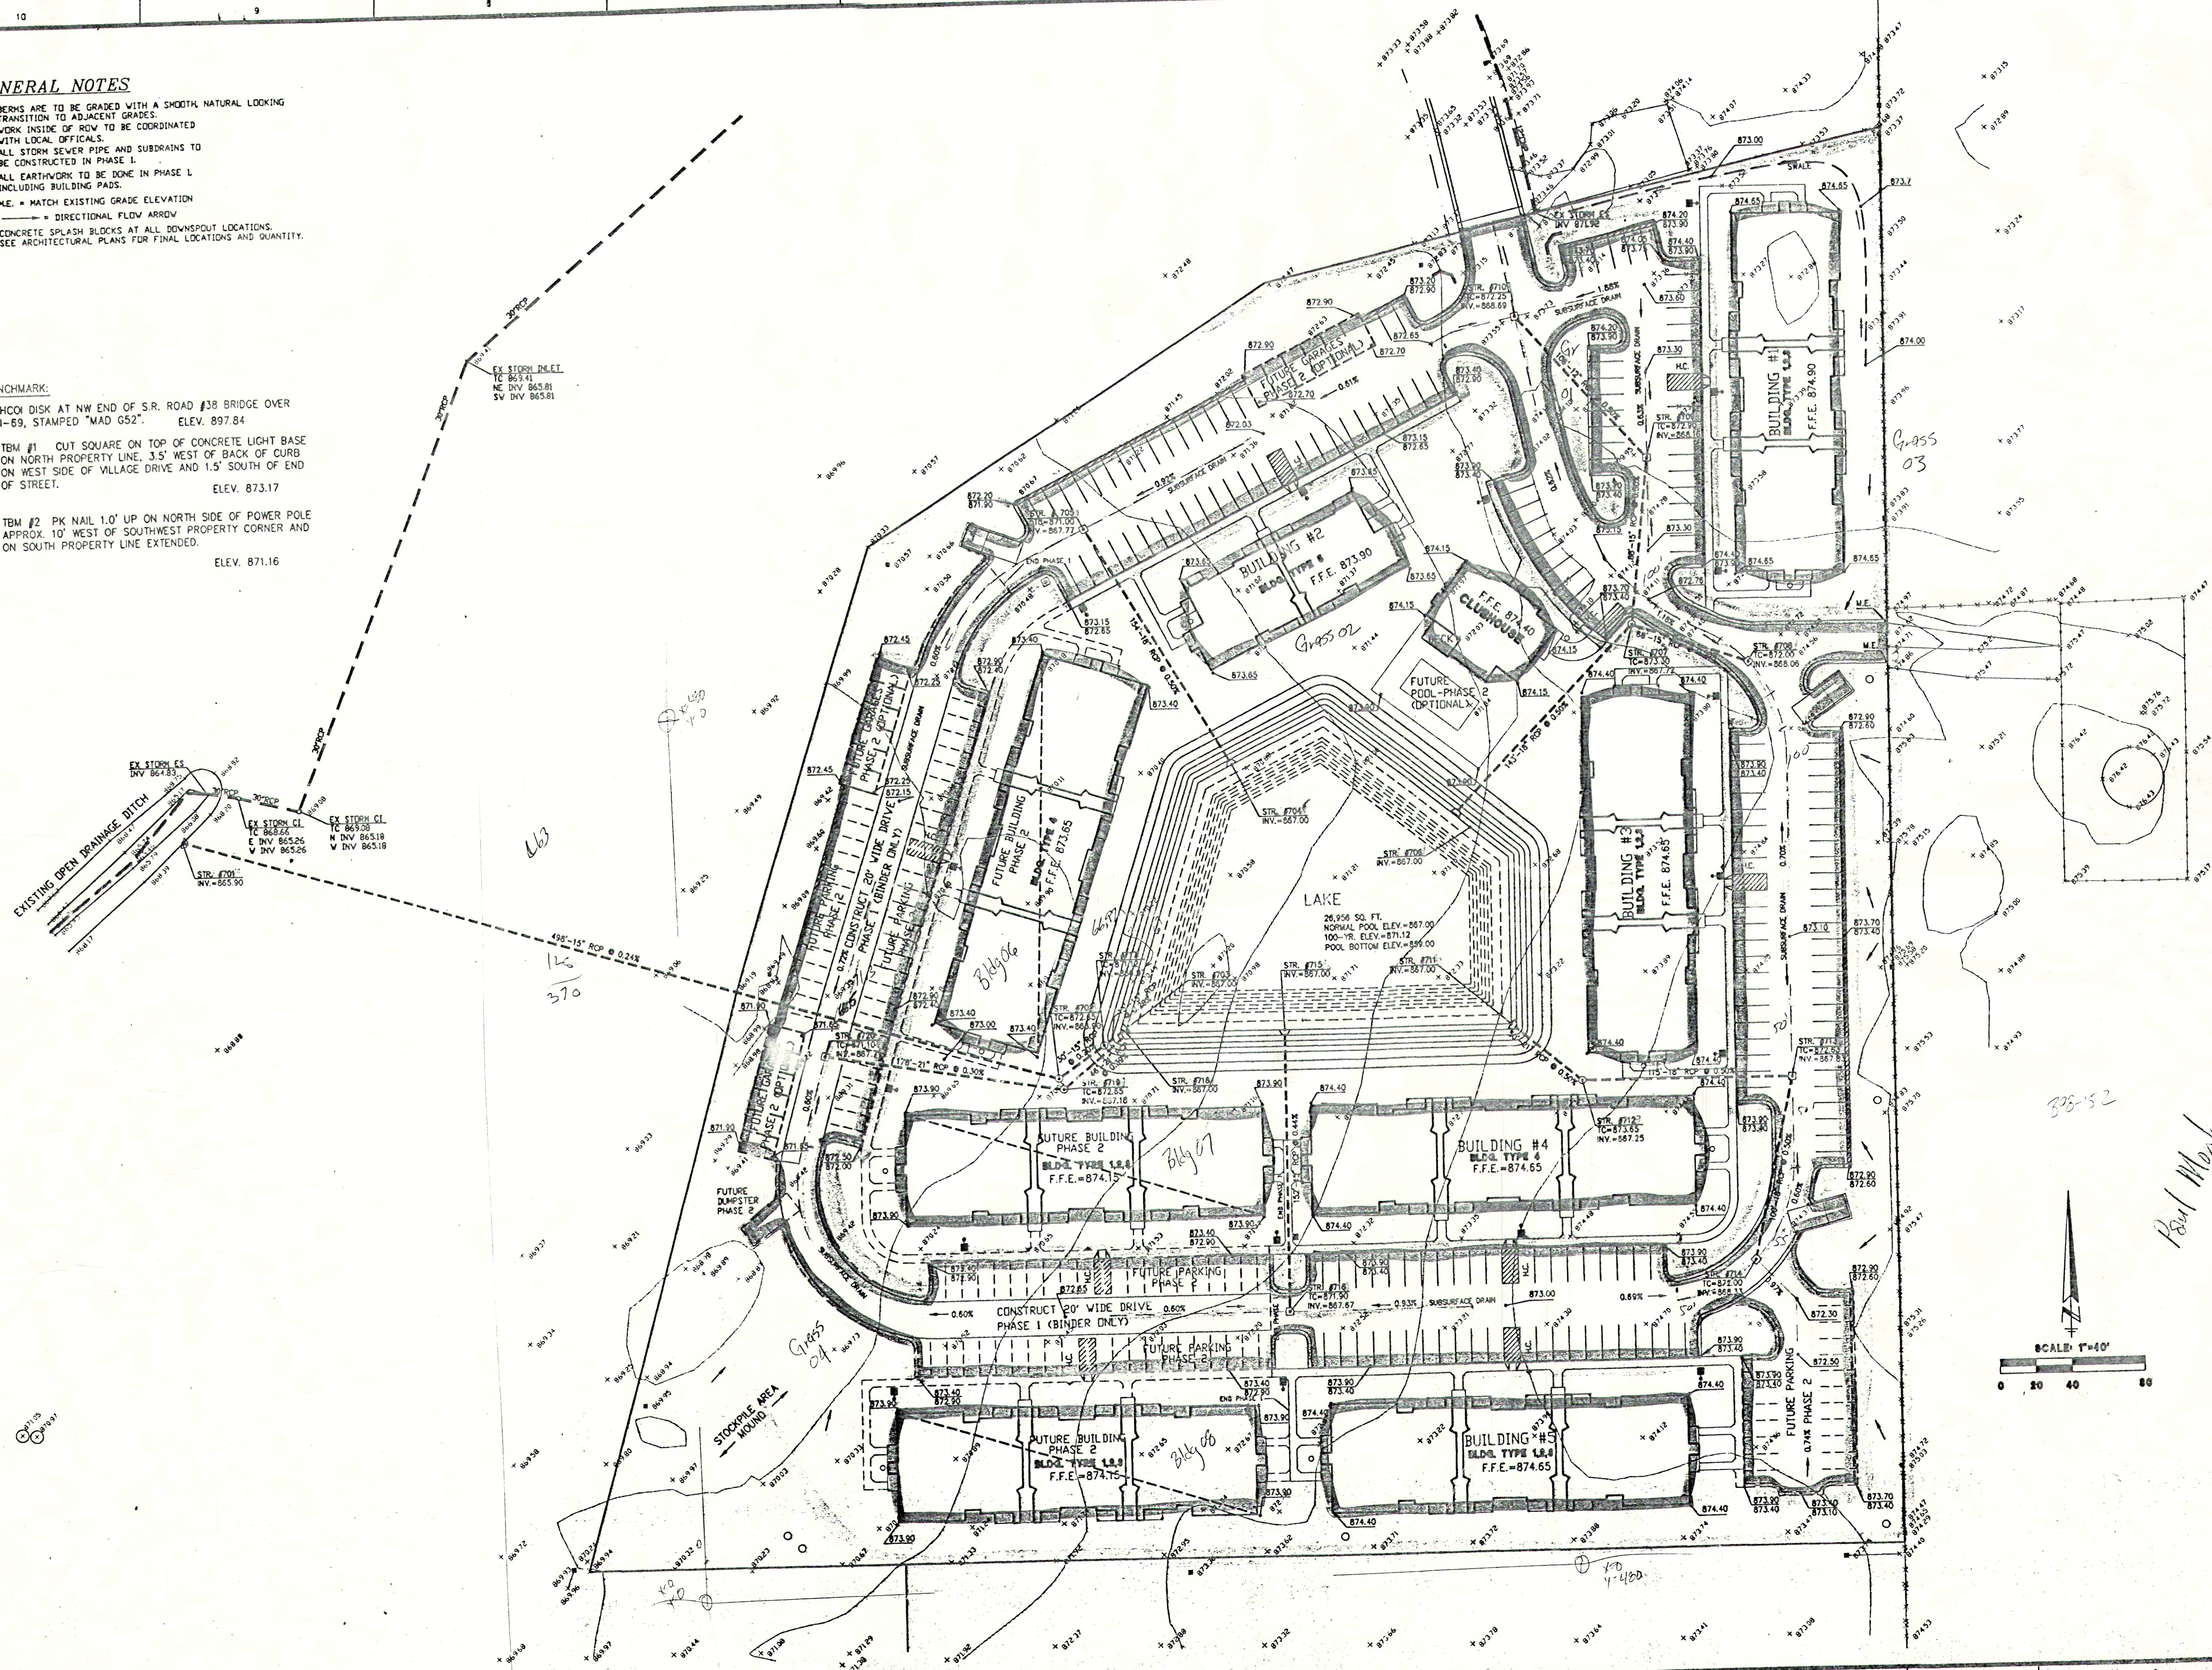

WEIHE ENGINEERS, INC.

ALLAN H. WEIHE, P.E., L.S.
PRESIDENT
10005 NORTH COLLEGE AVENUE
INDIANAPOLIS, INDIANA 46220
(317) 846-8811 FAX (317) 846-8846
TOLL-FREE (800) 445-0008

CIVIL ENGINEERS • LAND SURVEYORS • LAND PLANNERS • LANDSCAPE ARCHITECTS

PROJECT NO.	DATE	BY	DATE	BY
8827				
STATE OF INDIANA				
ALLAN H. WEIHE, P.E., L.S.				
Professional Engineer				
No. 8827				
Expiry Date: 12/31/98				

PREPARED FOR: **PENDLETON PLACE APARTMENTS**

SHEEHAN CONSTRUCTION CO., INC.
GRADING AND DRAINAGE PLAN

SHEET NO. **C3**