


1. THE CONTRACTOR SHALL CONTACT ALL APPLICABLE UTILITIES AND VERIFY ANY AND ALL FEES ASSOCIATED WITH THE INSTALLATION OF ALL UTILITIES.
2. COORDINATE LOCATION OF ELECTRICAL AND TELEPHONE LINES WITH LOCAL UTILITIES AND ELECTRICAL DRAWINGS.
3. COORDINATE LOCATION AND SIZE OF GAS SERVICE CONNECTION AND INSTALLATION OF SERVICE LINE AND METERS WITH GAS COMPANY AND MECHANICAL DRAWINGS.
4. COORDINATE LOCATIONS AND CONNECTIONS OF DOWNSPOUTS WITH ARCHITECTURAL DRAWINGS FOR SPLASH BLOCKS.
5. CONTRACTOR SHALL BE RESPONSIBLE FOR OBTAINING ALL PERMITS AND/OR VERIFY THAT THEY HAVE BEEN OBTAINED.
6. VERIFY EXISTING INVERTS OF STORM SEWER AND SANITARY SEWER. ADJUST INVERTS AS REQUIRED. DOCUMENT ANY CHANGES.
7. COORDINATE LOCATION OF WATER SERVICE CONNECTION AND MASTER METER WITH LOCAL WATER UTILITY.
8. SEE GRADING AND DRAINAGE PLAN C3 FOR STORM SEWER PIPES.

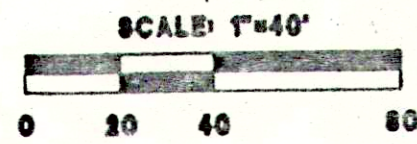

C4