
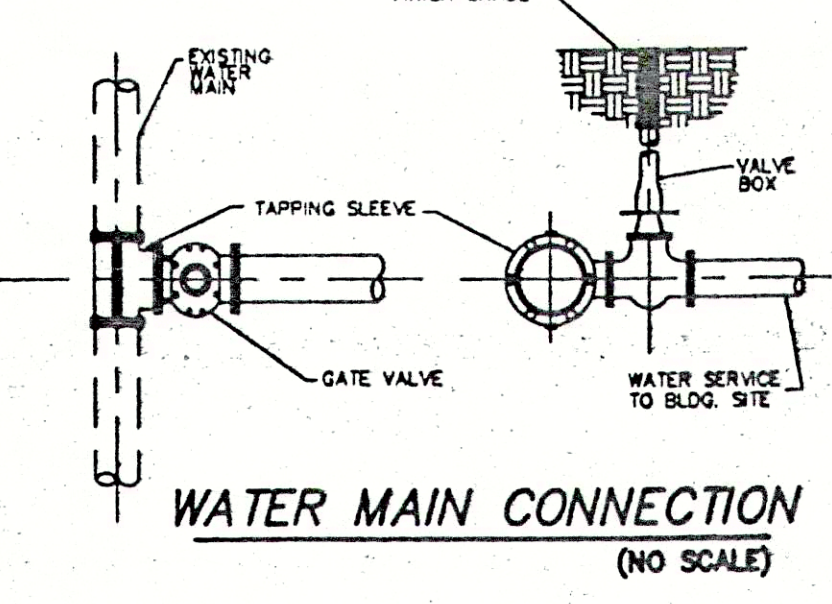
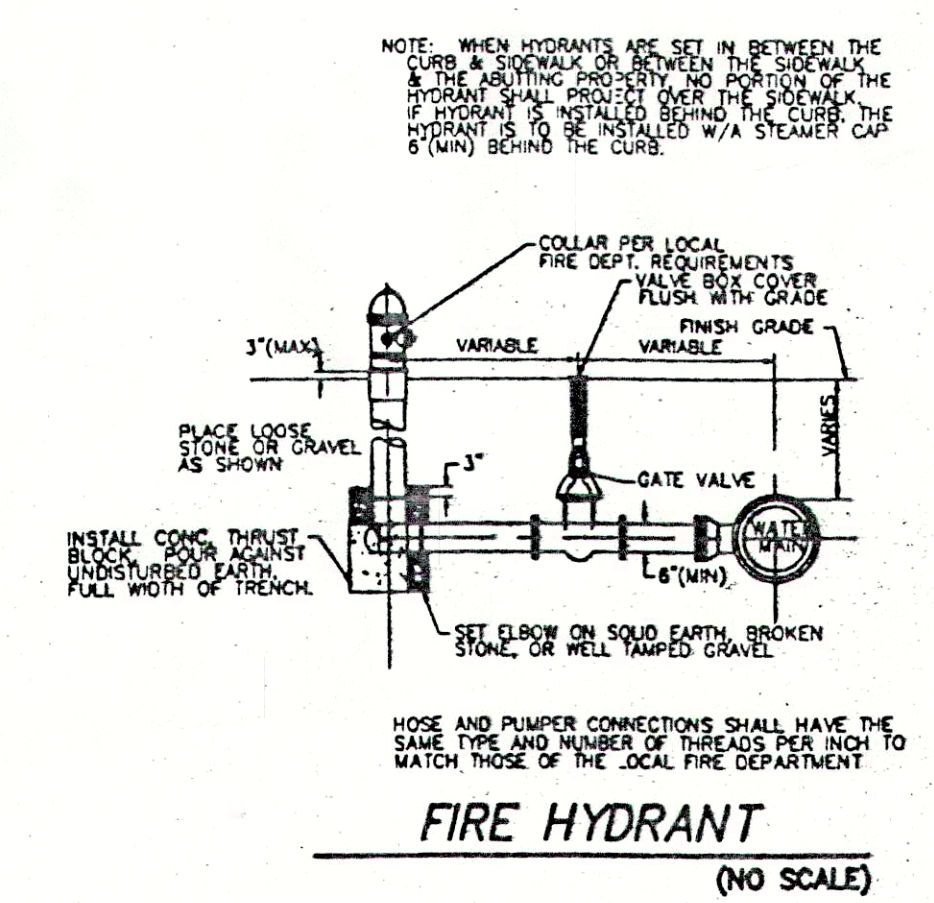
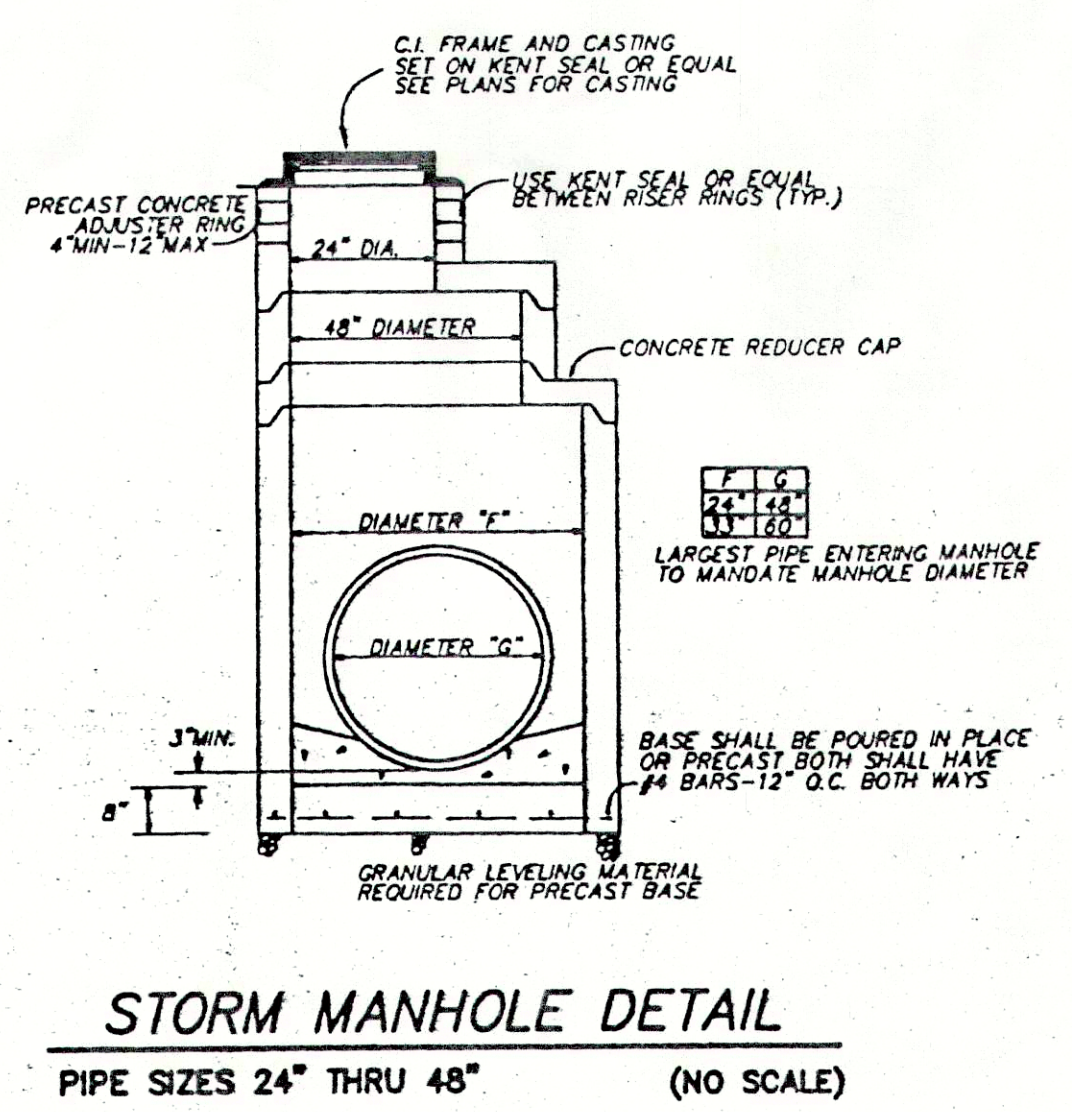
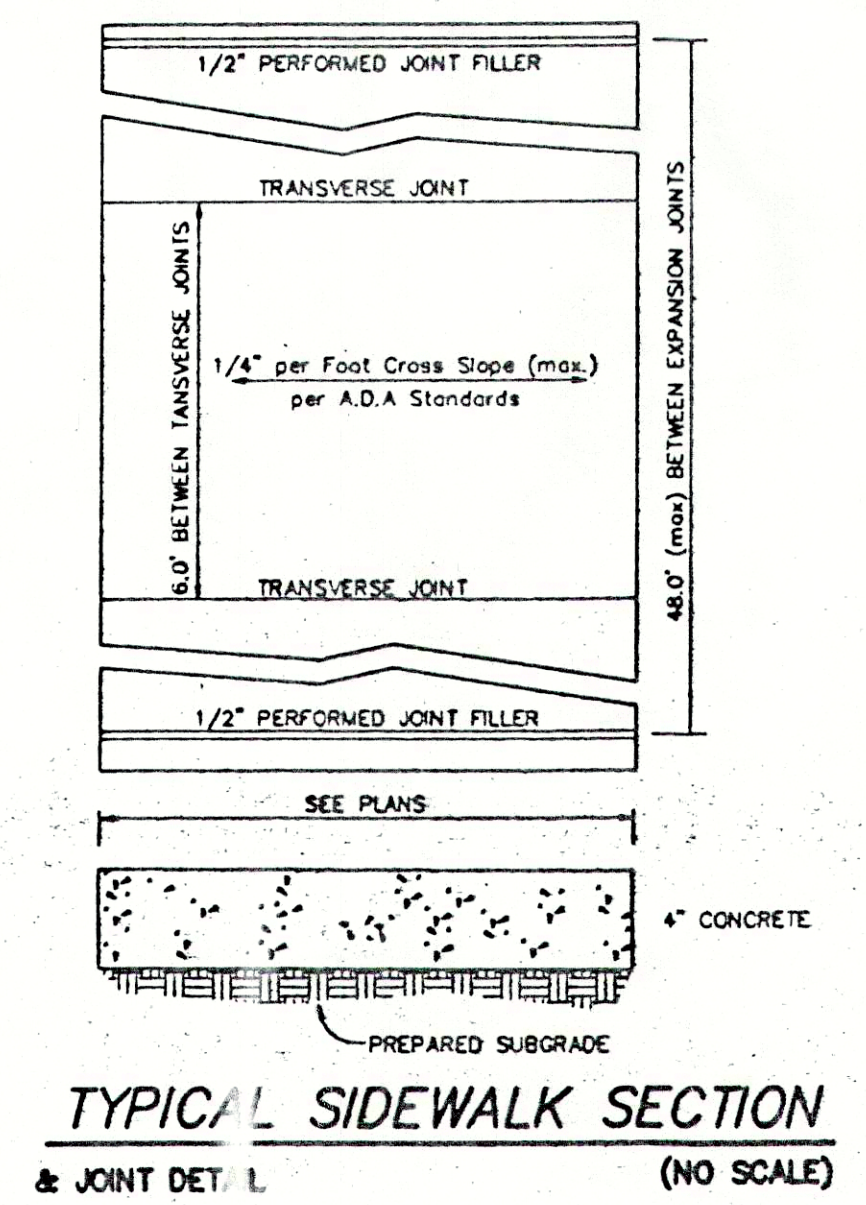
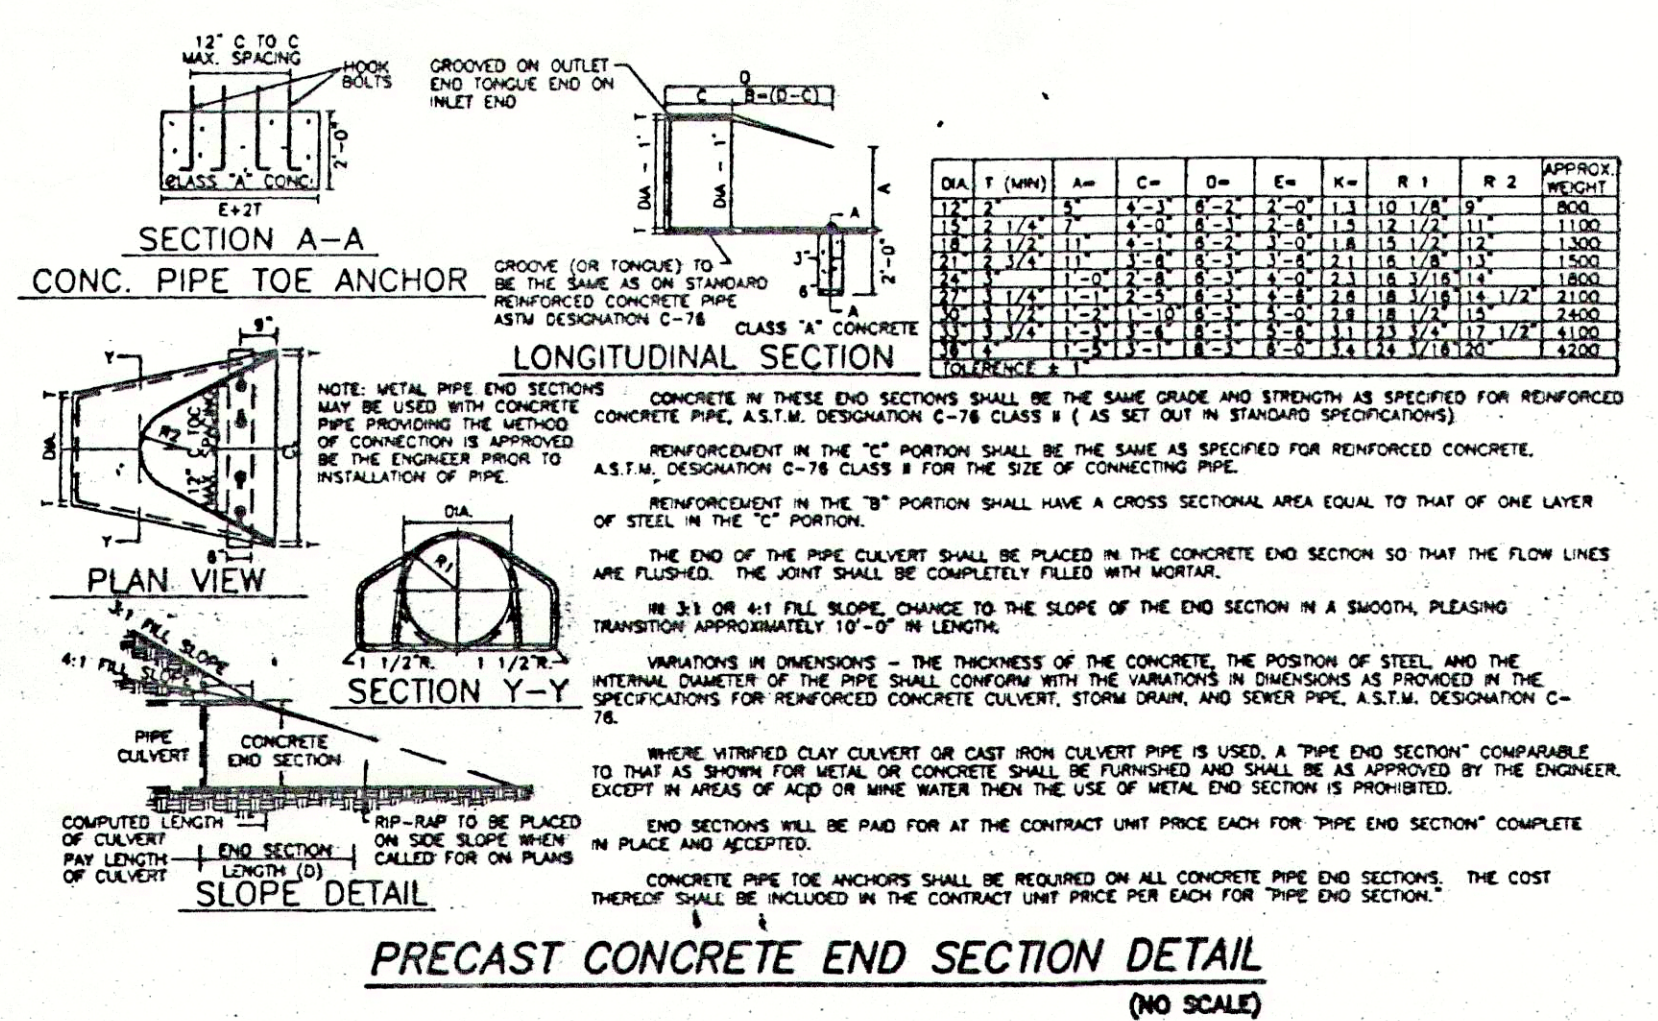
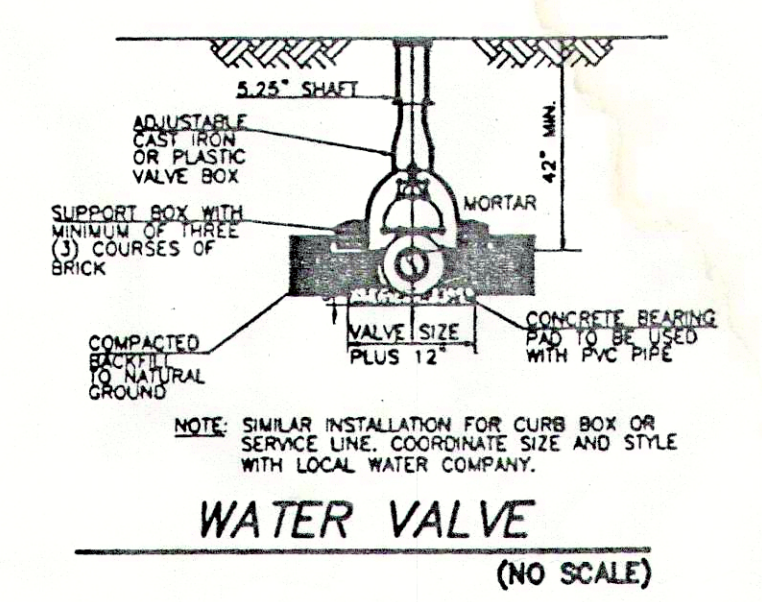
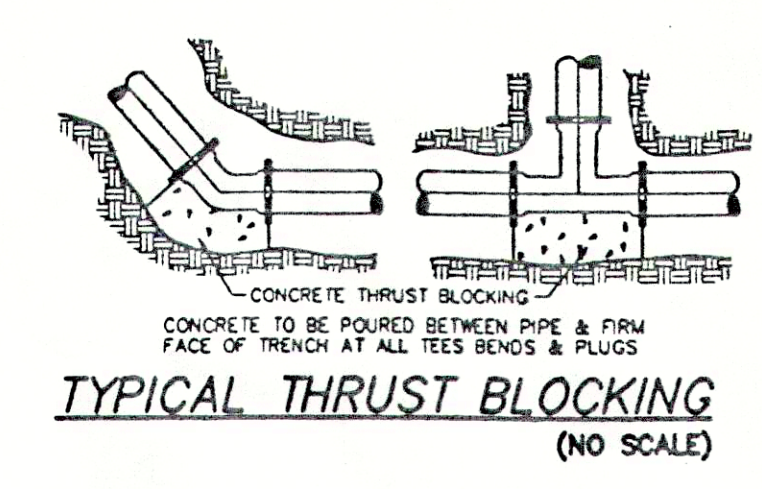
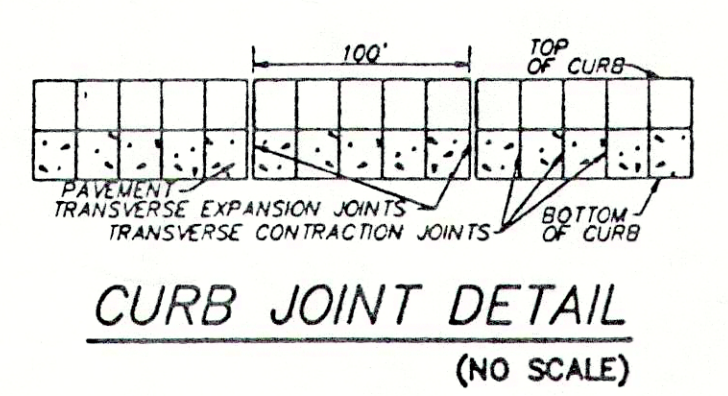
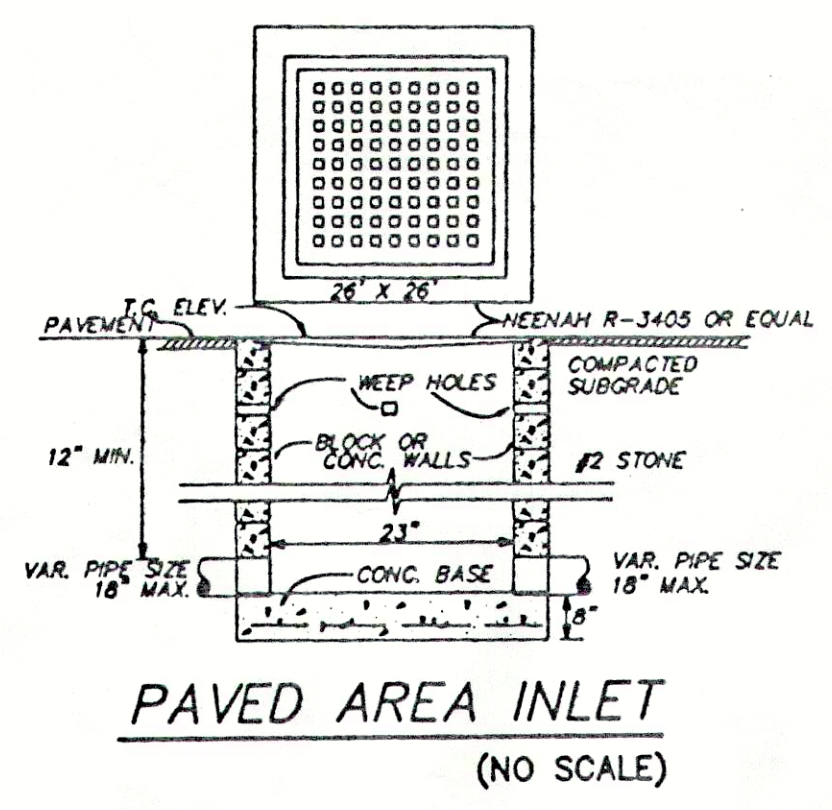
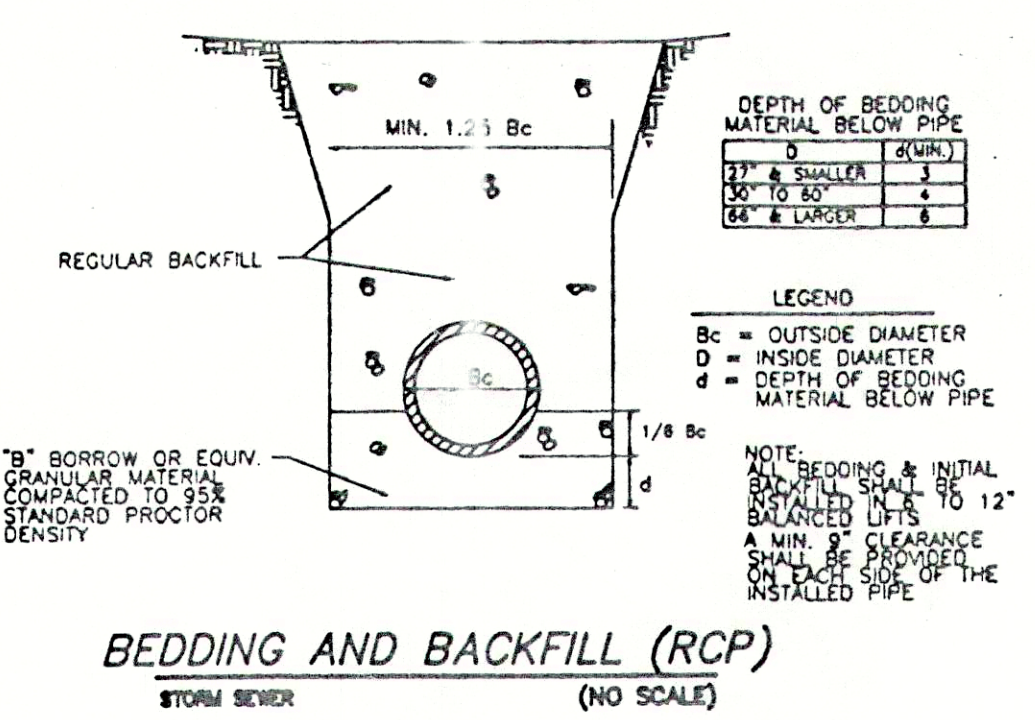
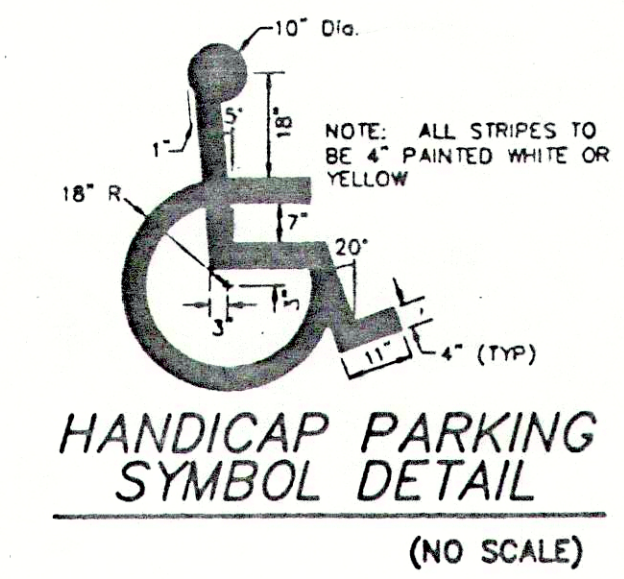
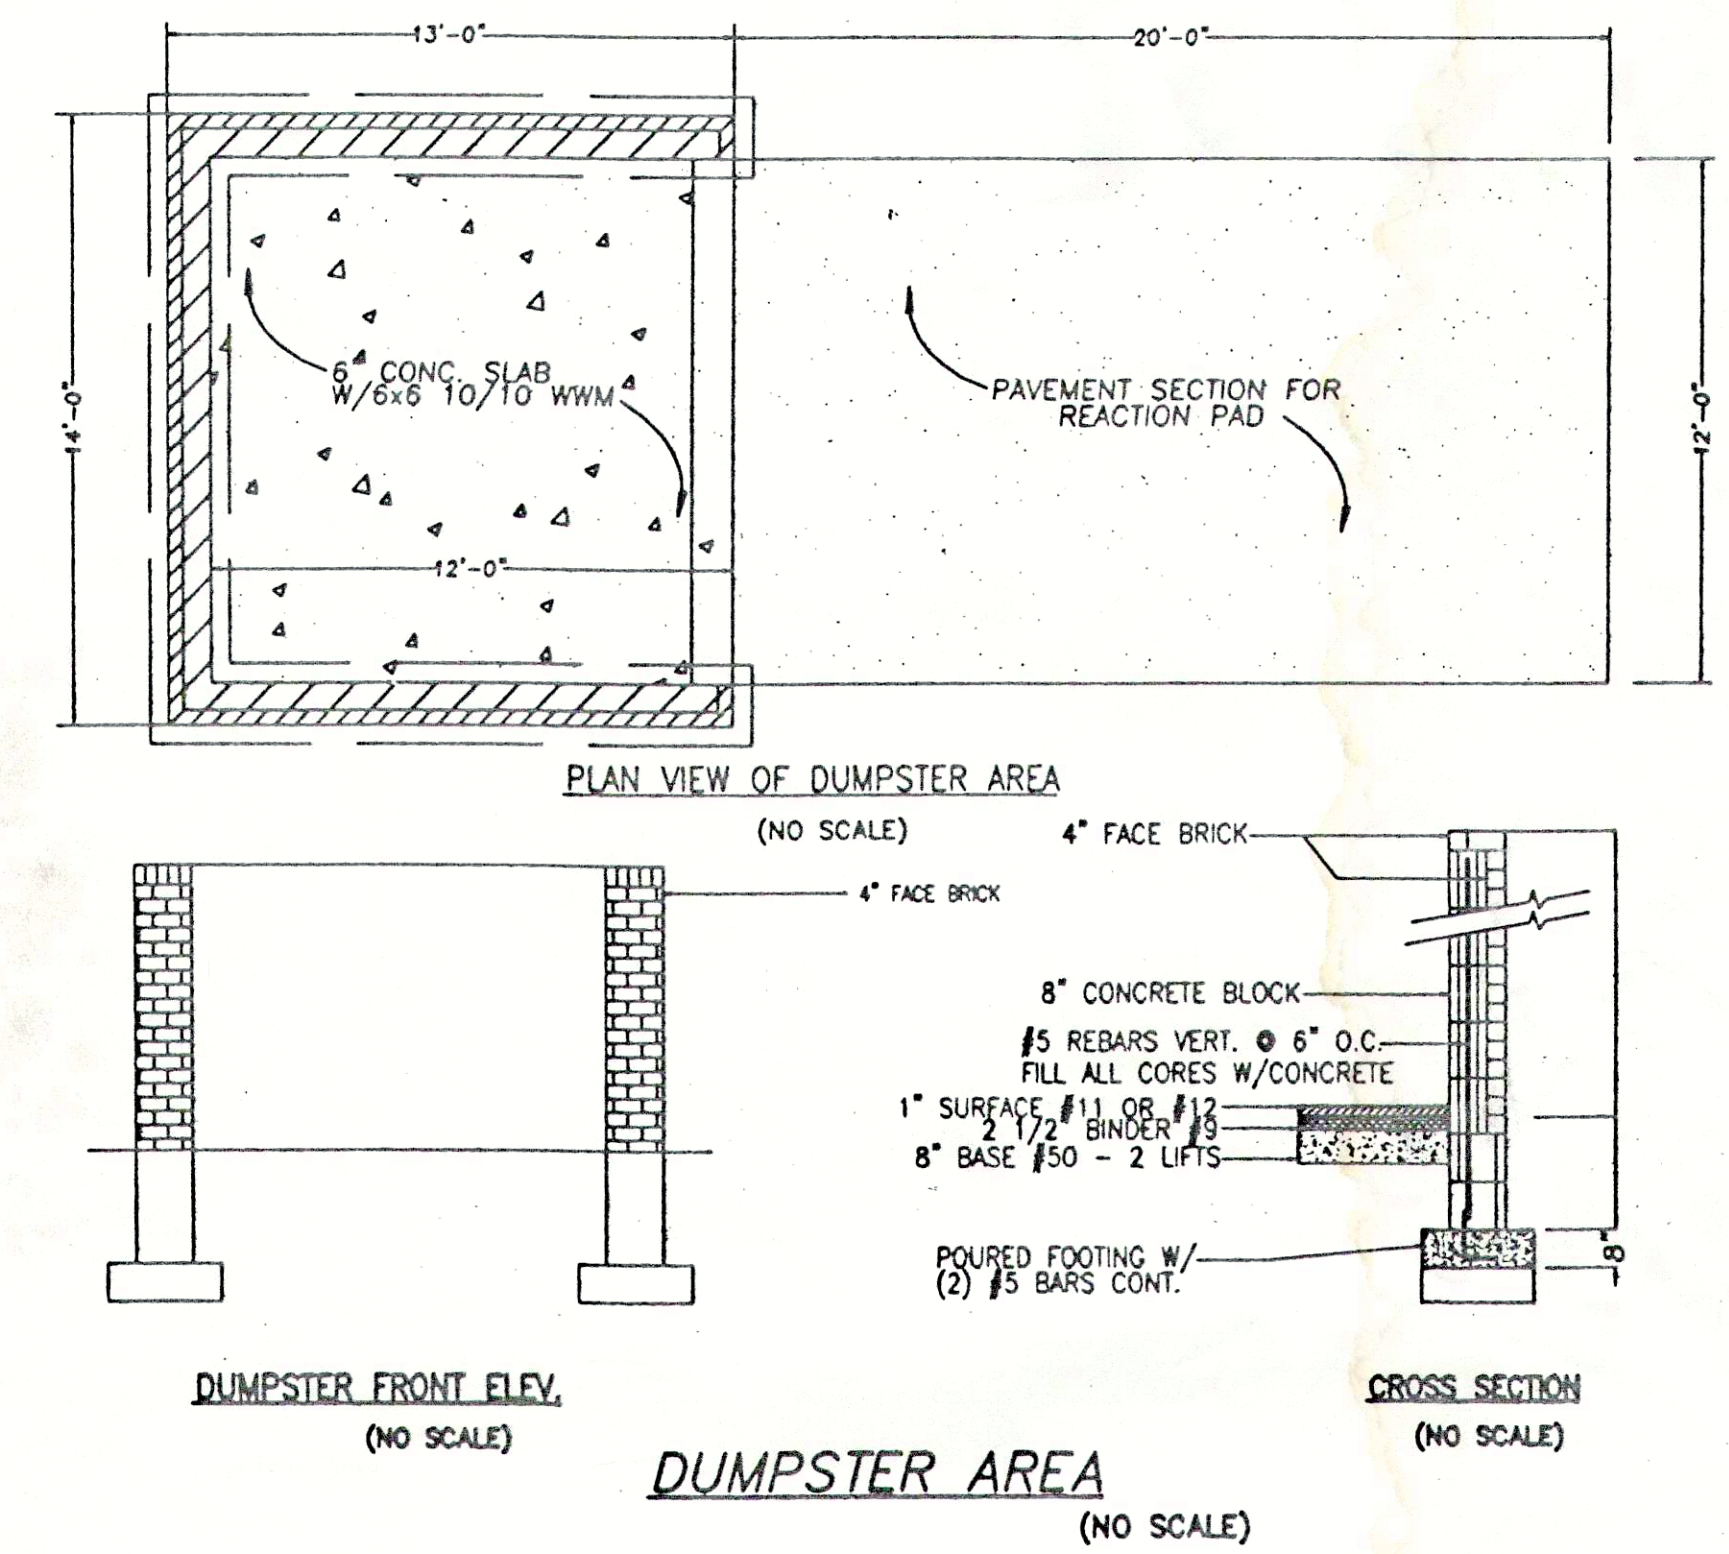
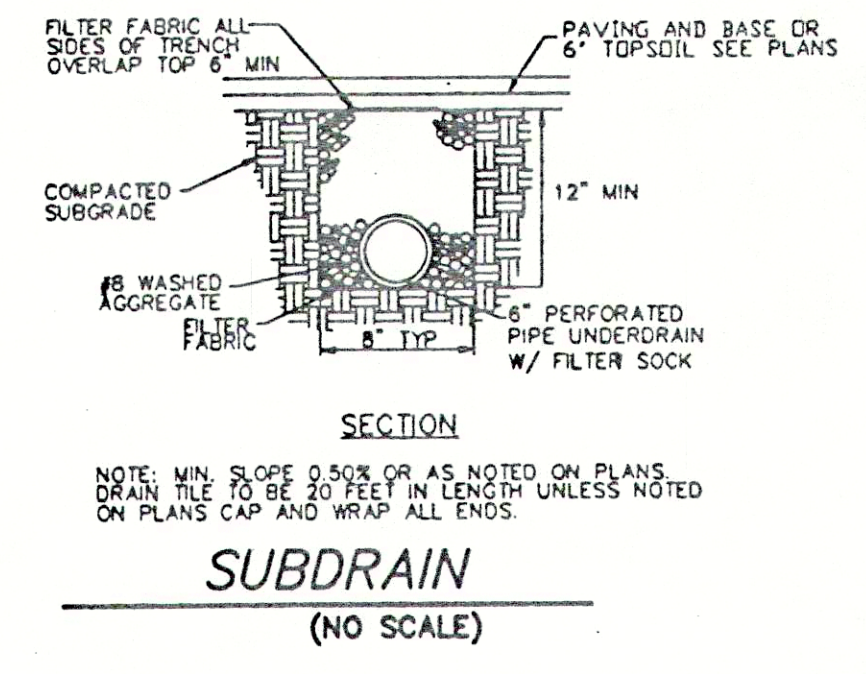
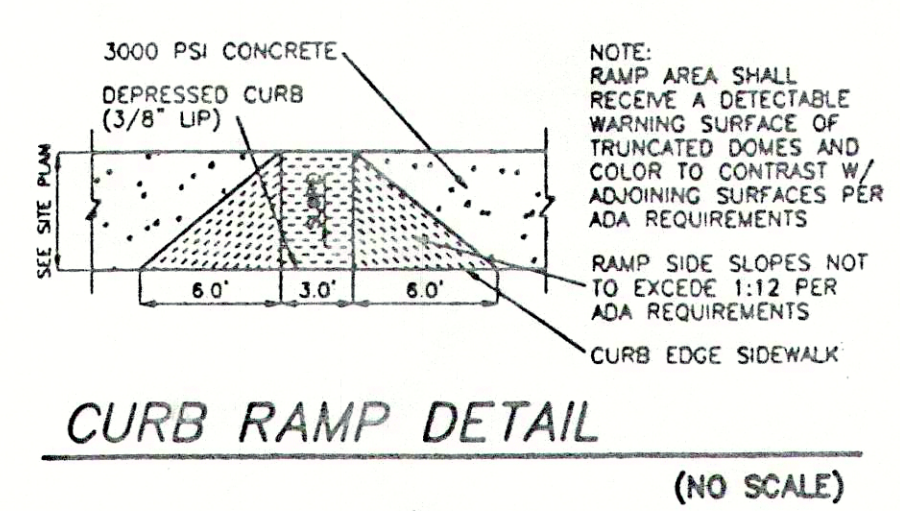
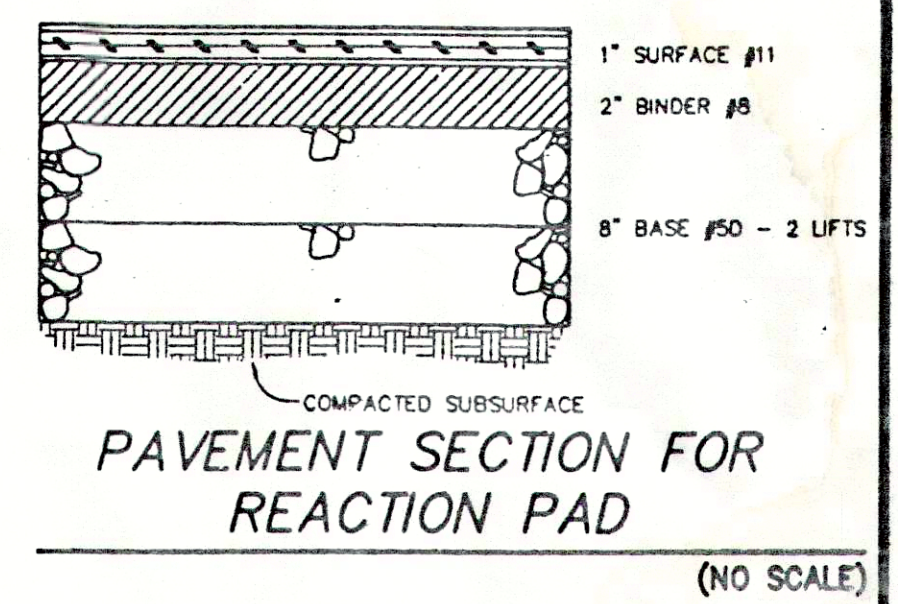
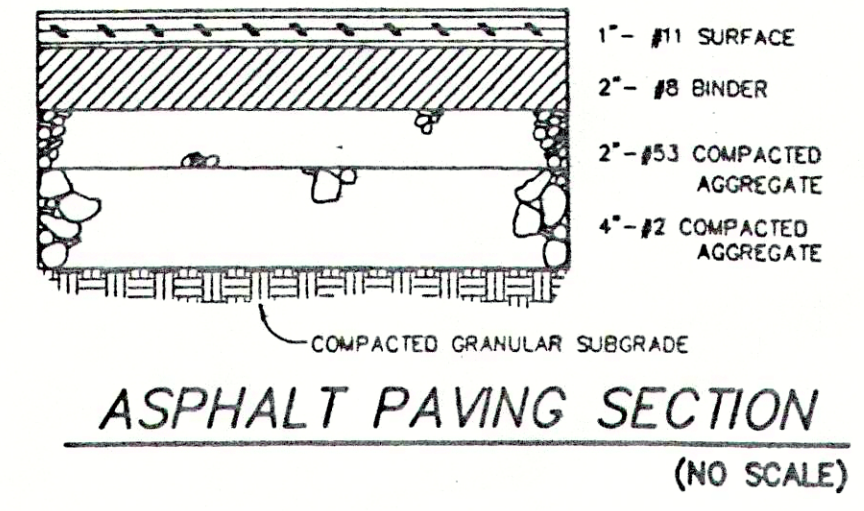
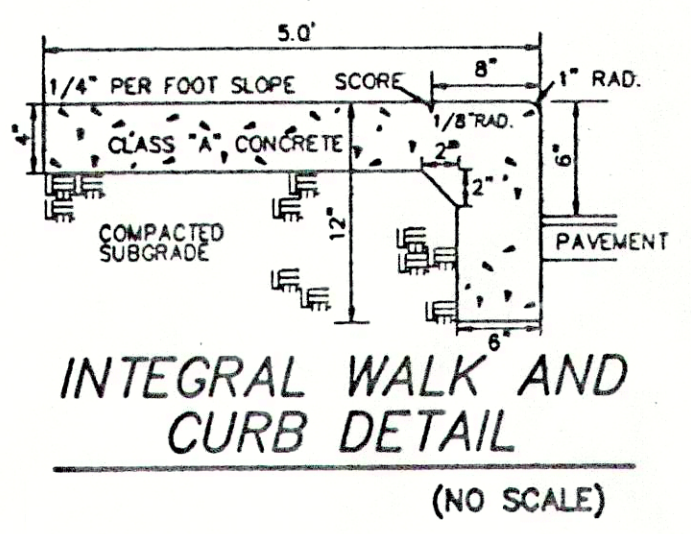


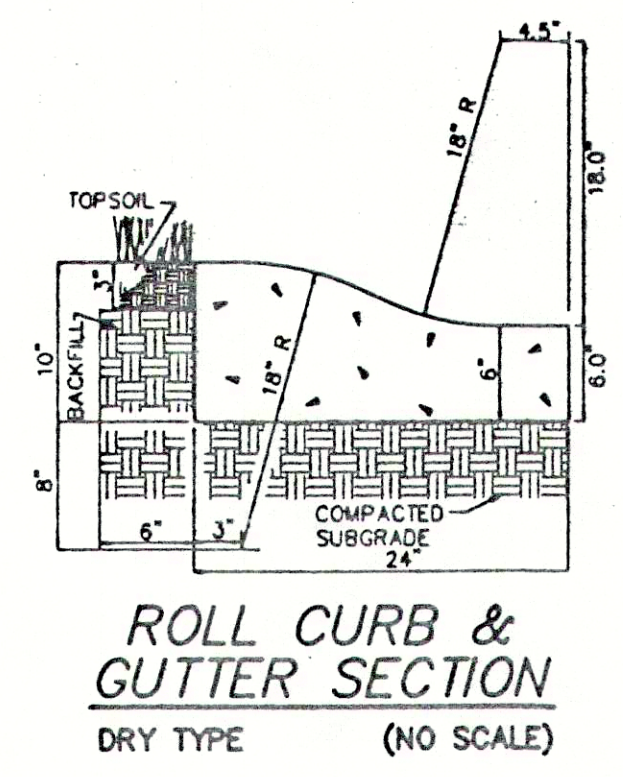

WEIHE ENGINEERS, INC.
10005 NORTH COLLEGE AVENUE
INDIANAPOLIS, INDIANA 46250
(317) 551-1111 FAX (317) 551-1112
TOLL-FREE (800) 455-4400
CIVIL ENGINEERS • LAND SURVEYORS • LAND PLANNERS • LANDSCAPE ARCHITECTS

ALAN H. WEIHE, P.E., L.S.
PRESIDENT
DANIEL L. WEIHE, L.S.
VICE PRESIDENT

PENDLETON PLACE APARTMENTS
SHEEHAN CONSTRUCTION CO., INC.
SITE DETAILS

ALAN H. WEIHE, P.E., L.S.
REGISTERED PROFESSIONAL ENGINEER
No. 8827
STATE OF INDIANA

PREPARED FOR:
SHEET NO. C5