
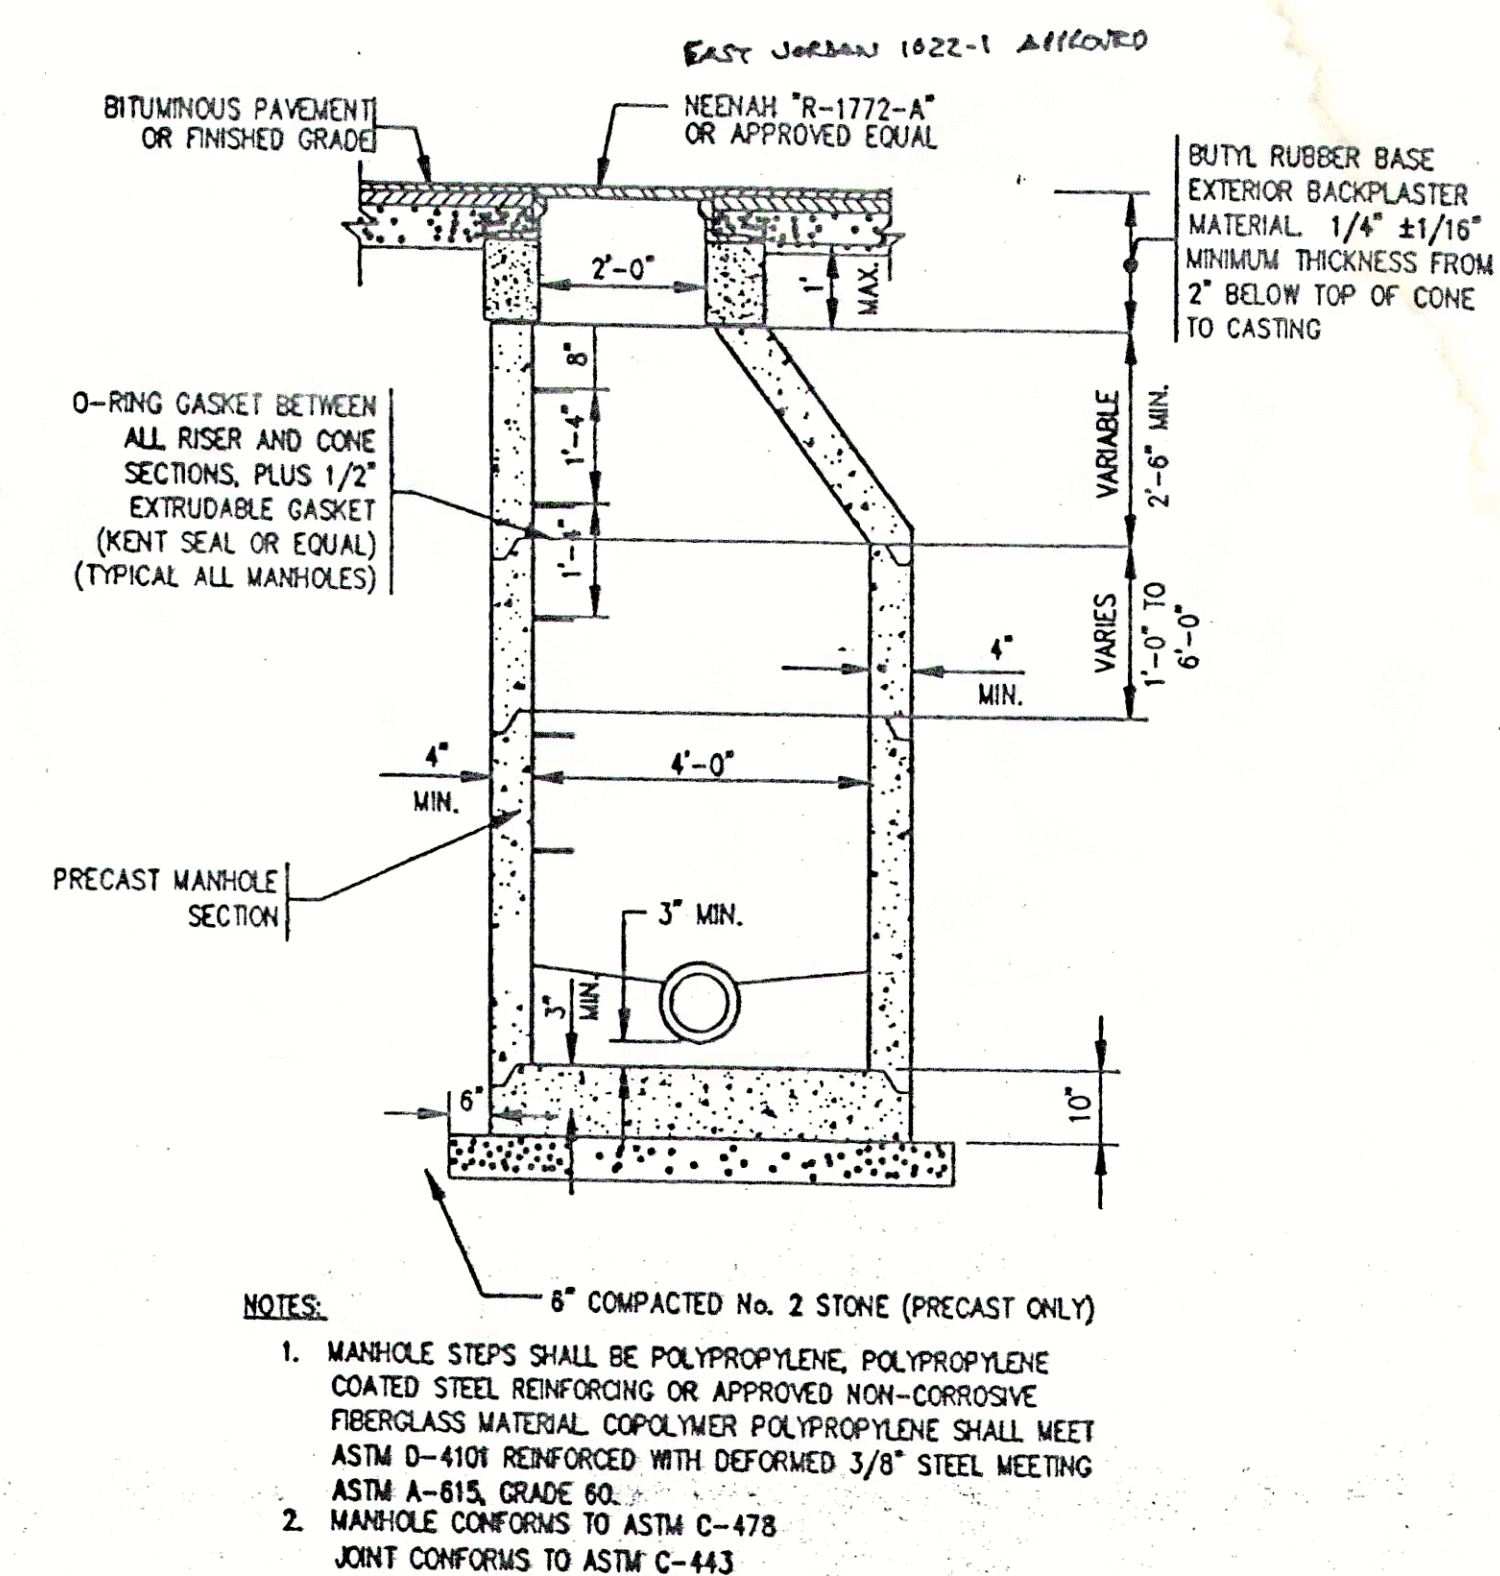
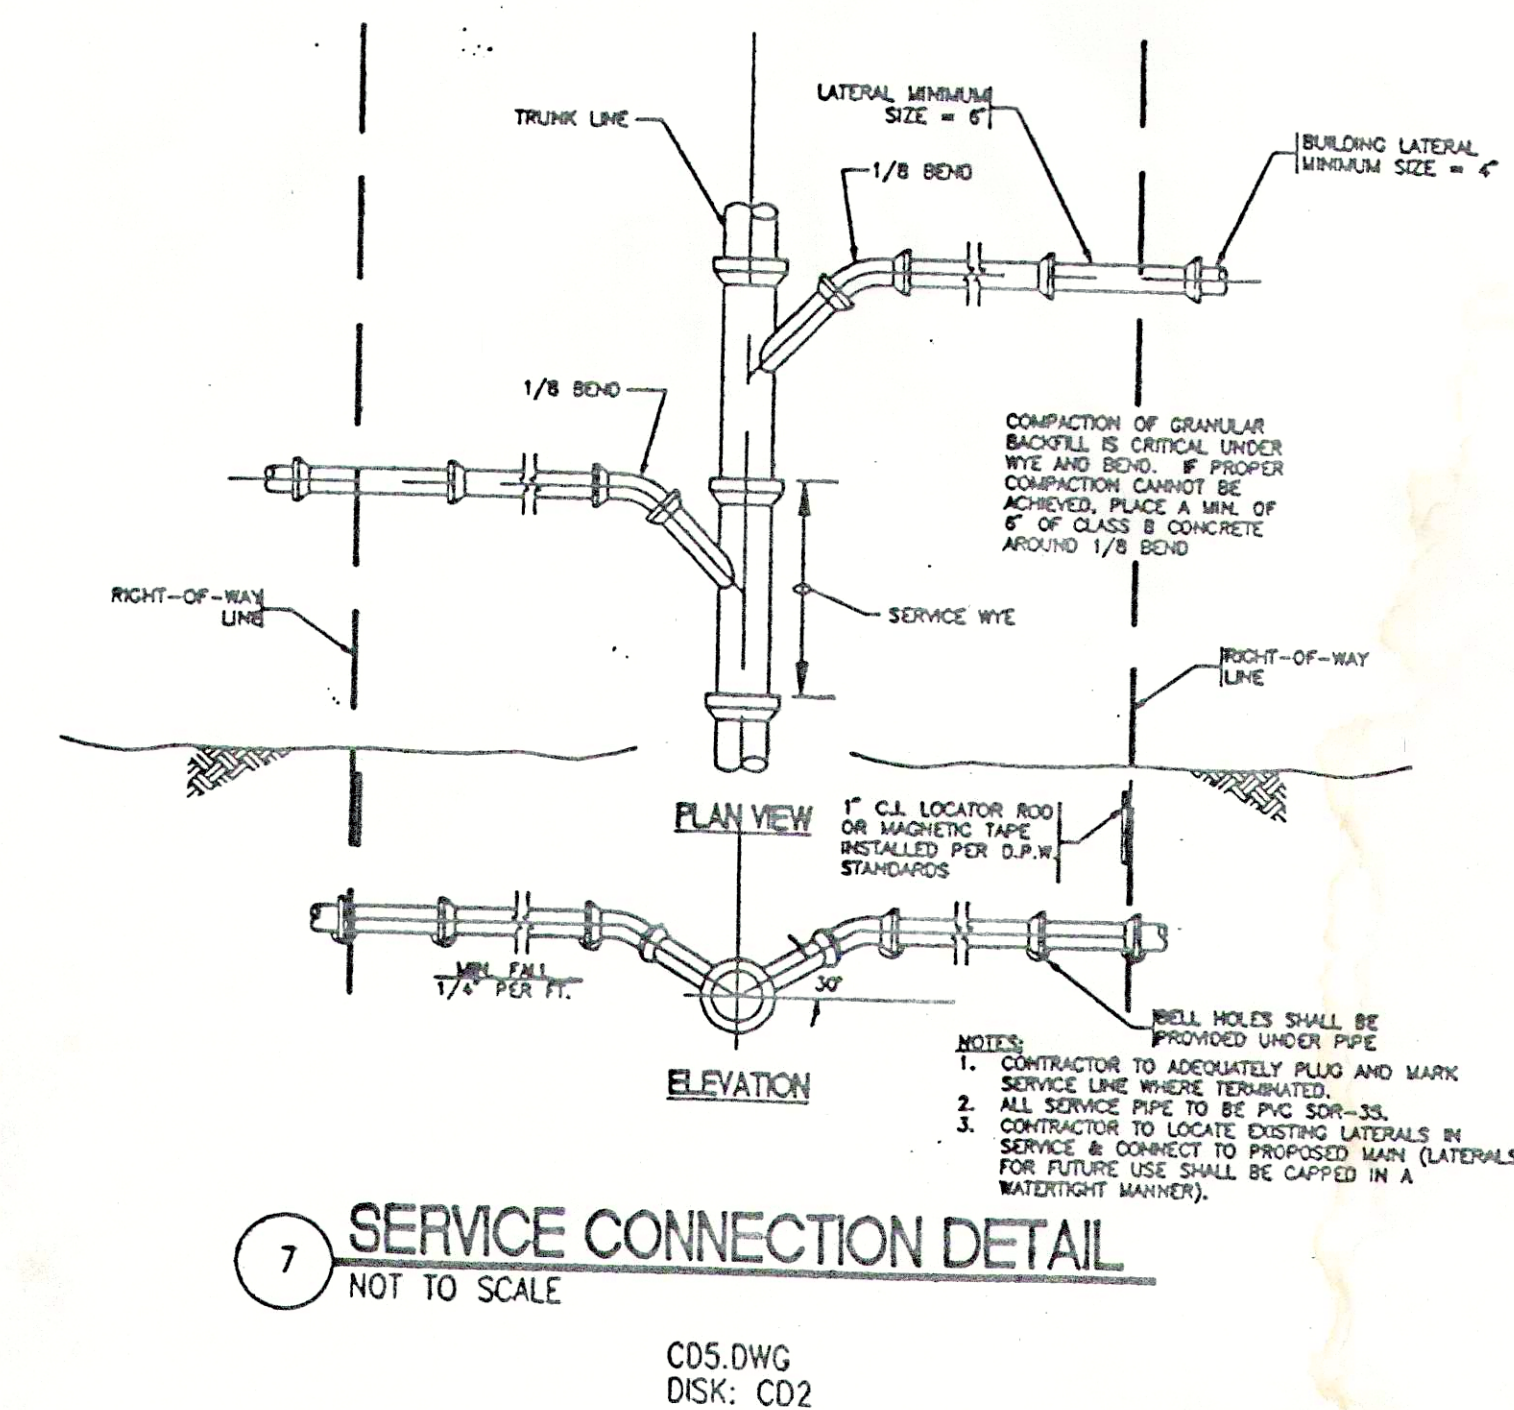
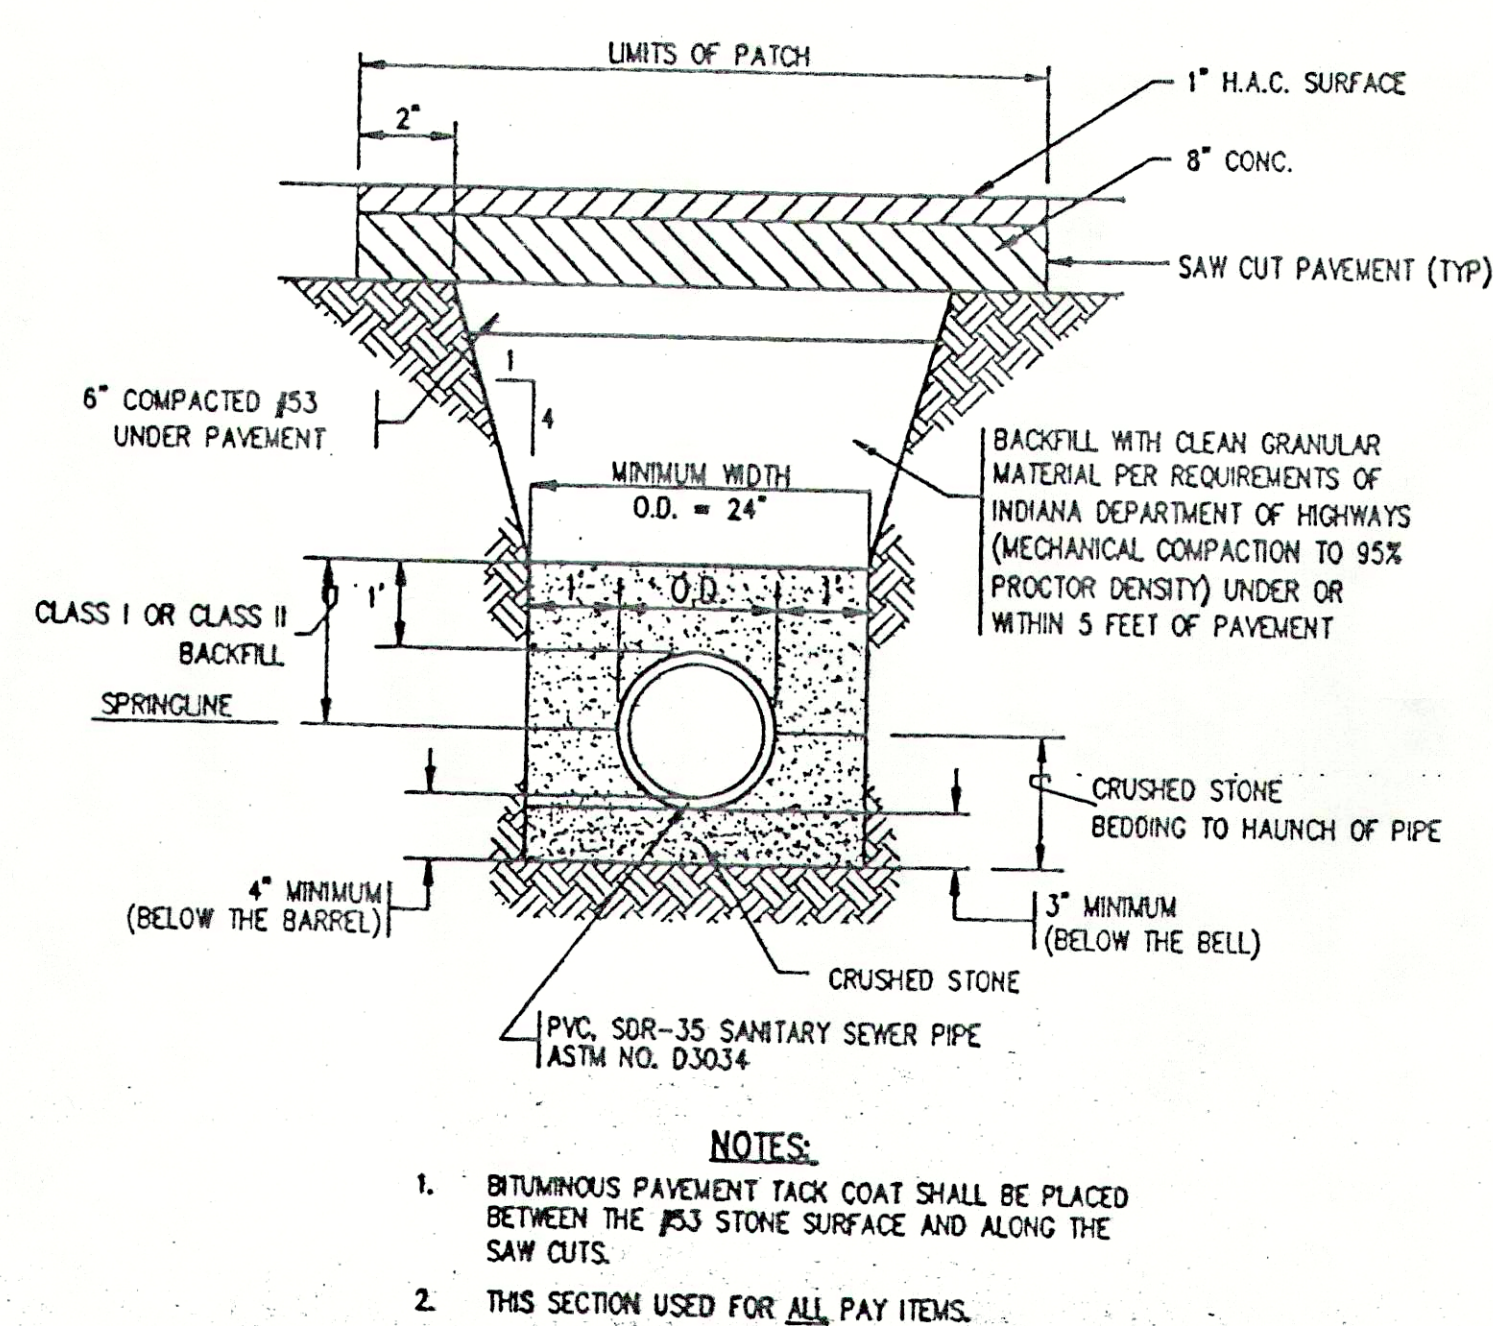
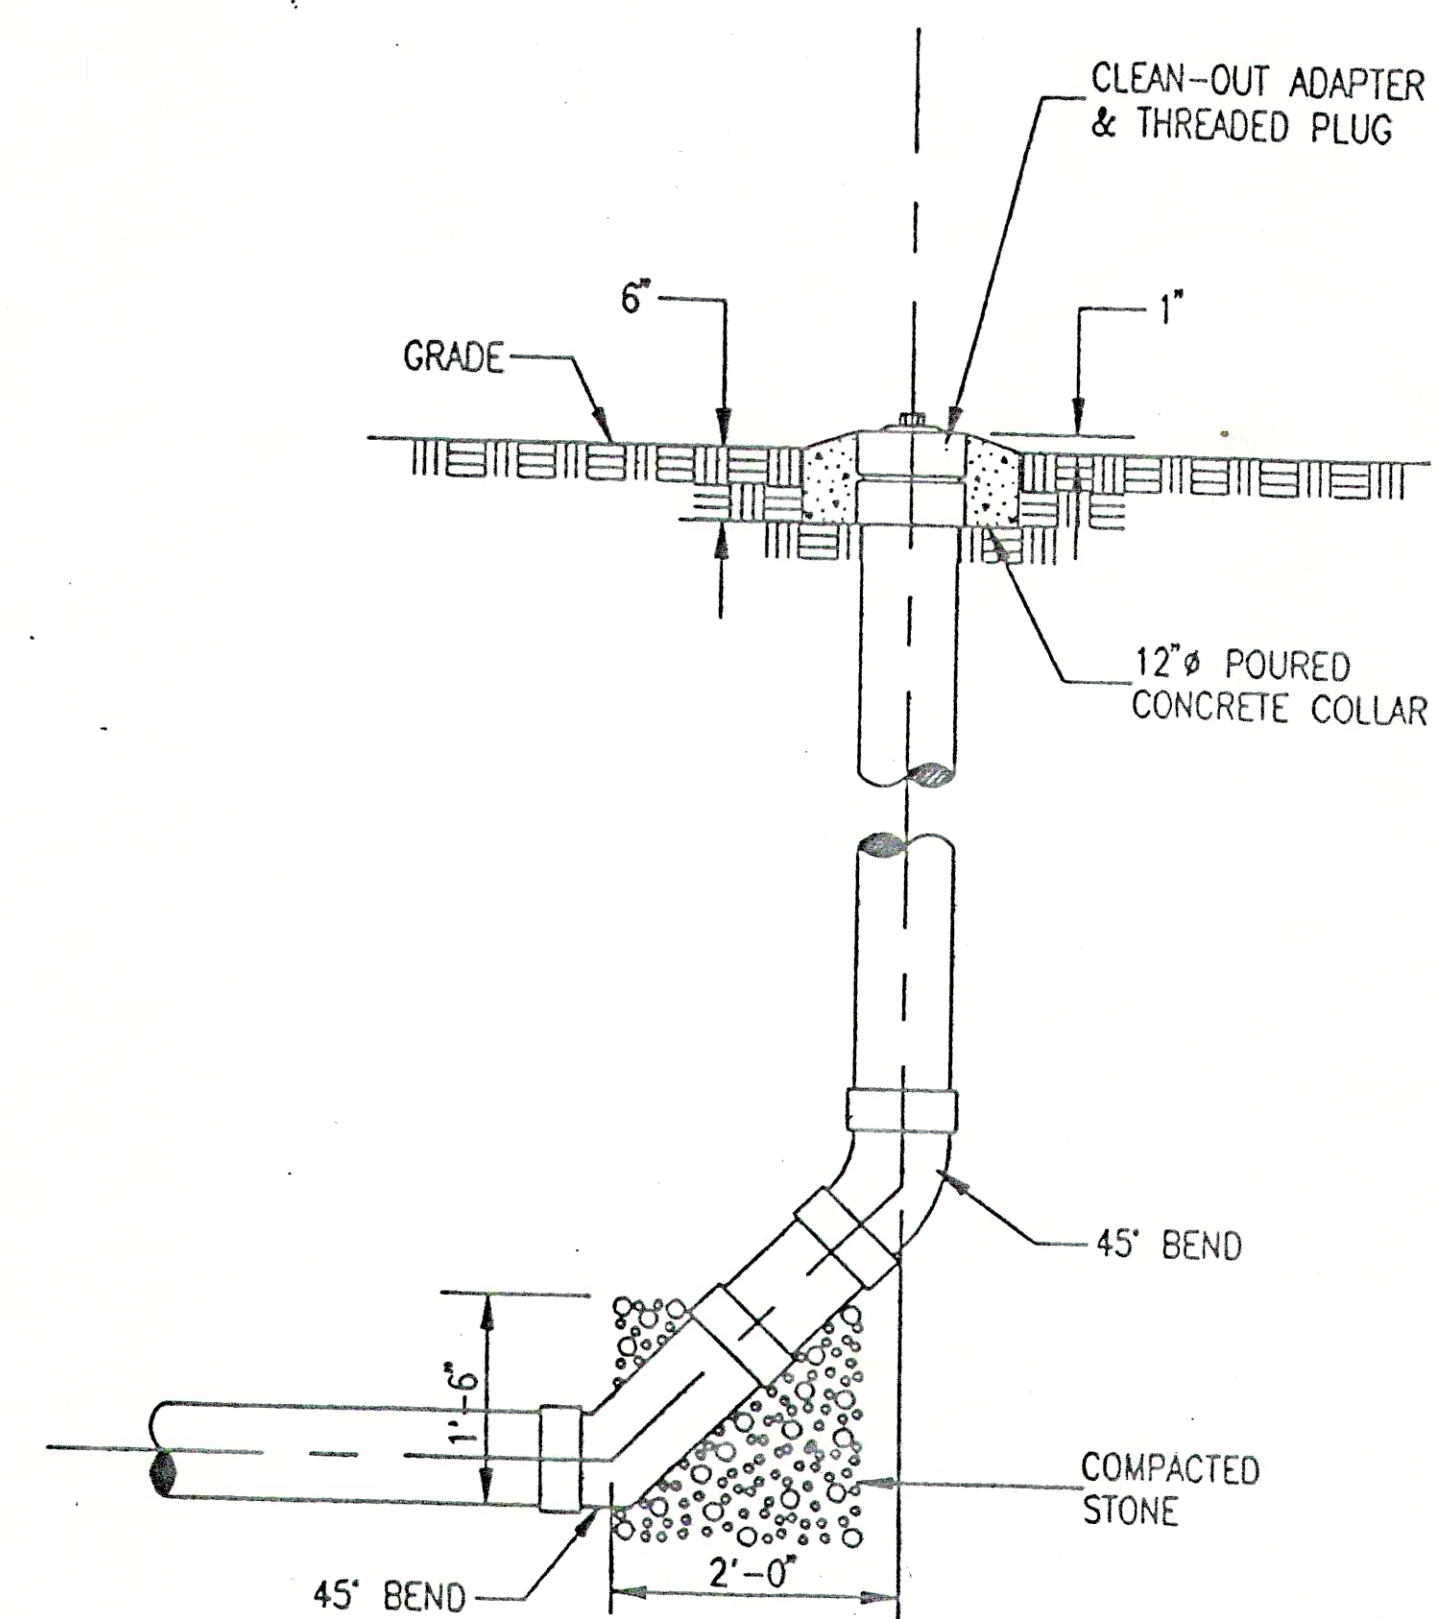
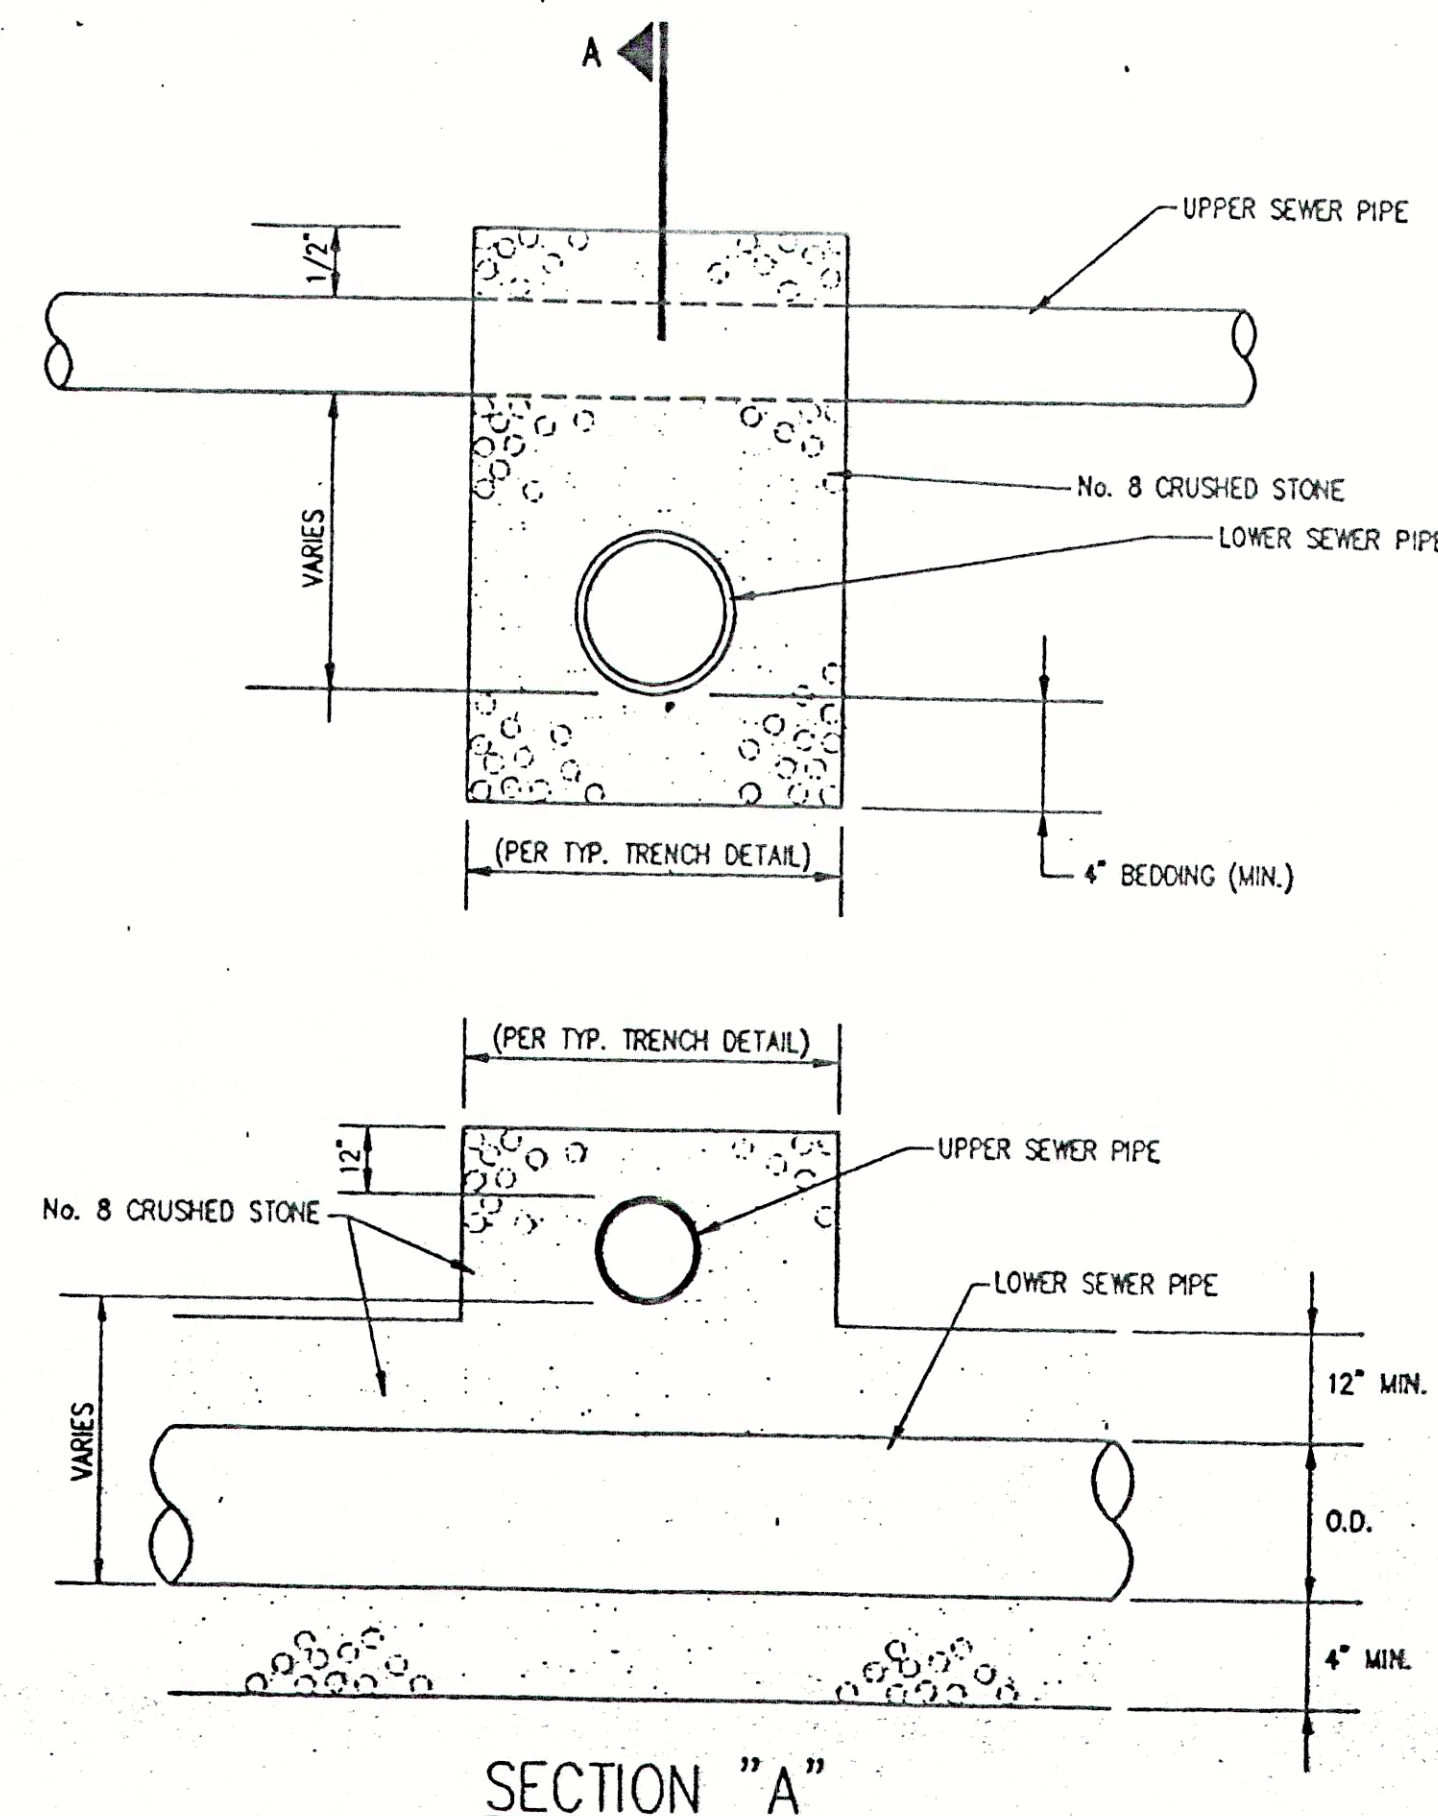


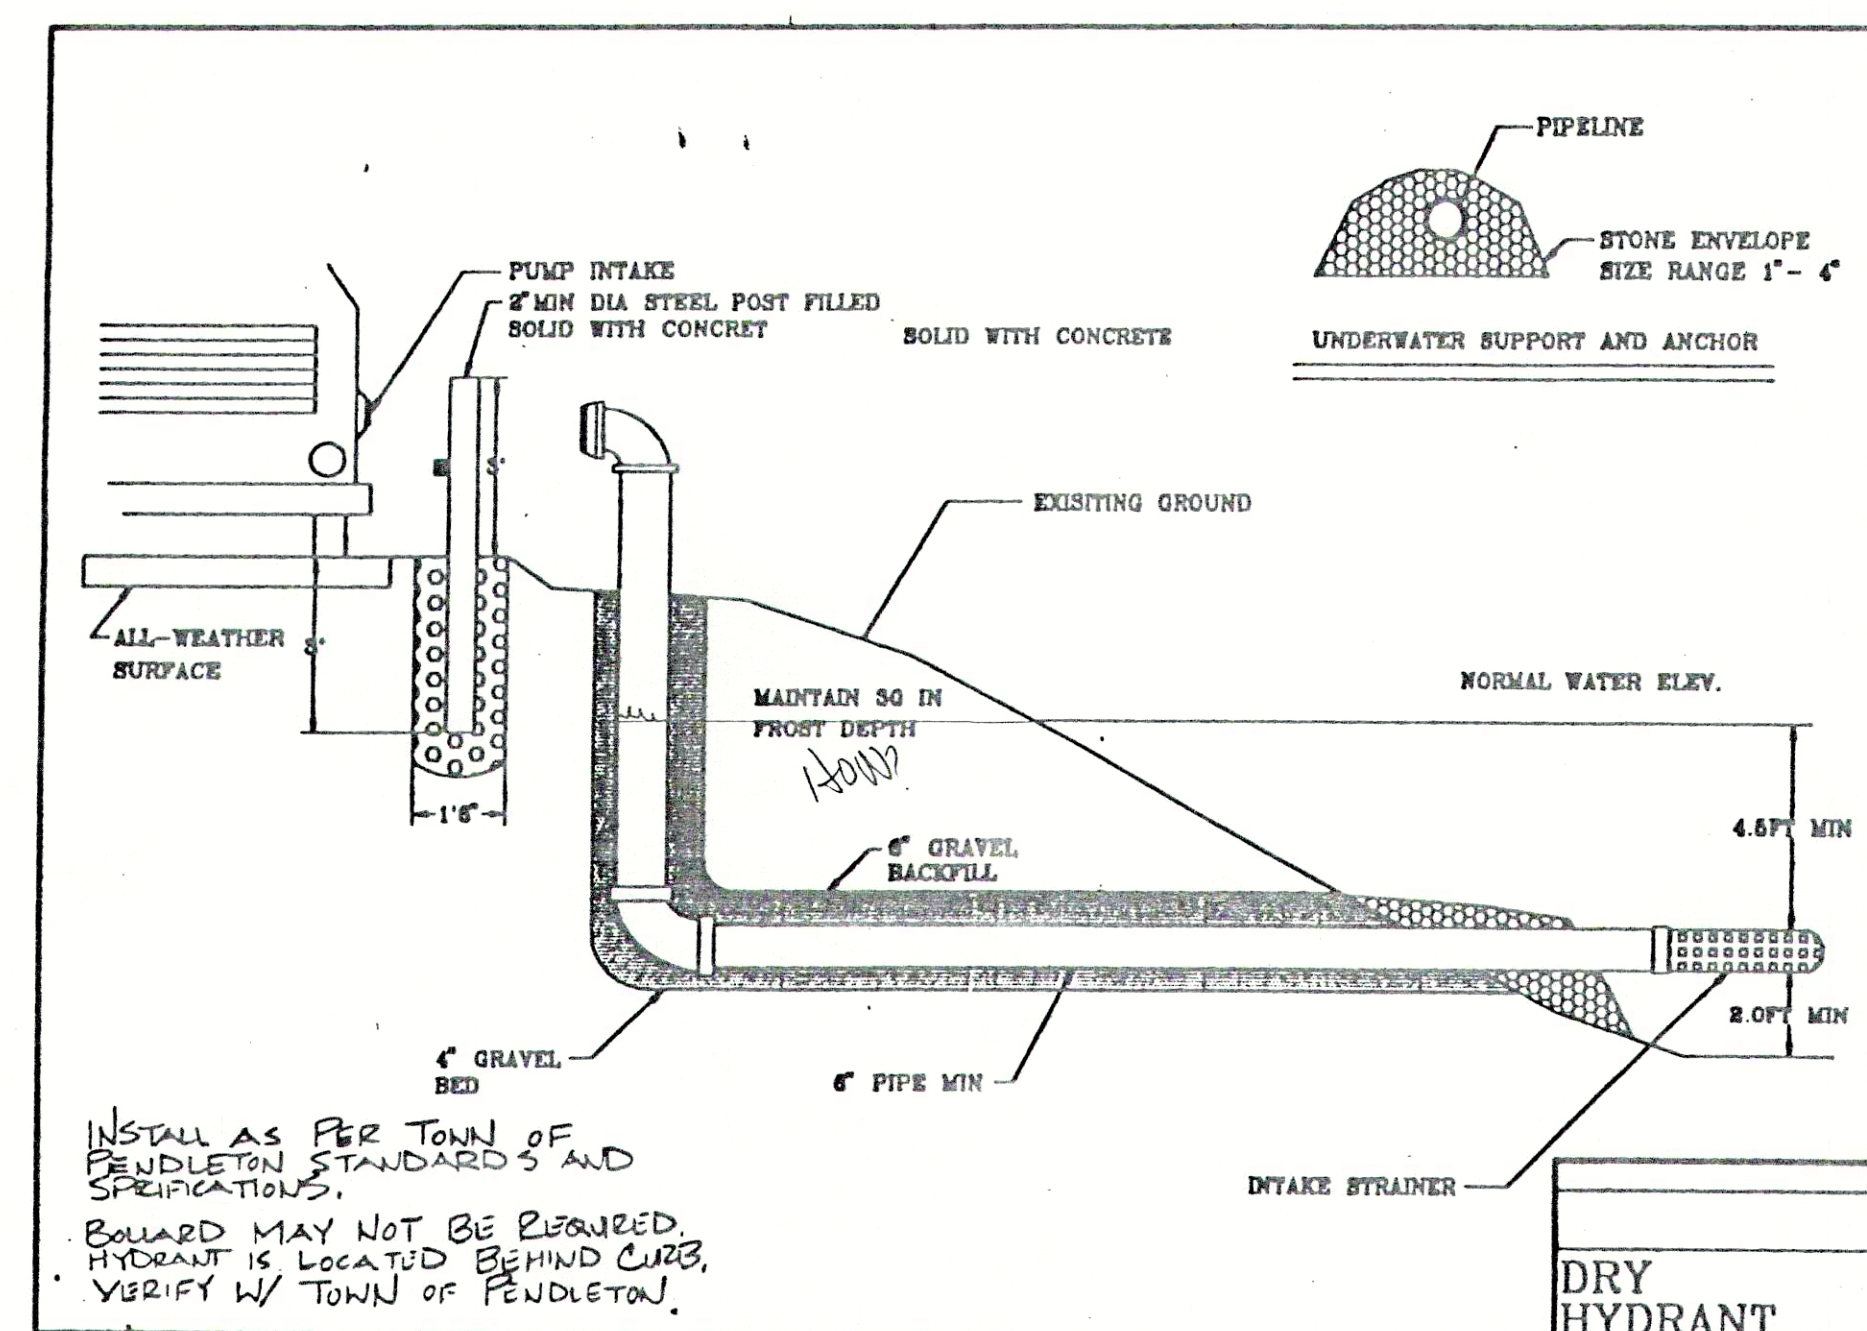

WEIHE ENGINEERS, INC.

ALLAN H. WEHR, P.E., L.S.
PRESIDENT
MICHAEL L. DeBOY, L.S.
VICE - PRESIDENT

143-0548

EDGE AVENUE
MA 01828
AX: (317) 8
52-6408

ORTH COLLEGE
COLS, INDIA
5-6811 P/1
KE (800) 44

10603 NO
INDIANAPOLIS
(317) 646
TOLL-FREE



BY: Kendall	BY: SMR,PRM	BY: SMR,PRM	BY: SMR,PRM
-------------	-------------	-------------	-------------

DATE	CHG	DATE

[illegible]

10

1

10

ALL INFORMATION CONTAINED
HEREIN IS UNCLASSIFIED
DATE 08-14-2010 BY 60322
A. WEIHE
REGISTERED



AL ENG
20th

SHU P.E. 8827	
---------------	--

5

21

DETAILS

ARD D

C.

CO., INC.

ADLET

CONSTR
5 PER
Southern 12, 3

...of the NE/2.

THE	TOL	Part of
------------	------------	----------------

6