

SEASONAL SOIL PROTECTION

NO SCALE

6

STABILIZATION
PERMANENT
SEEDING
TEMPORARY
SEEDING
MULCHING

A - KENTUCKY BLUEGRASS 40 LBS./ACRE, CREEPING RED FESCUE 40 LBS./ACRE, PLUS 3 TONS STRAW MULCH/ACRE, OR ADD ANNUAL RYEGRASS 20 LBS./ACRE
B - KENTUCKY BLUEGRASS 80 LBS./ACRE, CREEPING RED FESCUE 80 LBS./ACRE, PLUS 3 TONS STRAW MULCH/ACRE, OR ADD ANNUAL RYEGRASS 50 LBS./ACRE
C - SPRING GRASS 3 BURLS/ACRE
D - WHEAT OR RYE 2 BURLS/ACRE
E - ANNUAL RYEGRASS 40 LBS./ACRE
F - SOY
G - STRAW MULCH 2 TONS/ACRE
H - IRRIGATION NEEDED DURING APRIL, JULY, AND/OR SEPTEMBER
I - IRRIGATION NEEDED FOR 2 TO 3 WEEKS AFTER APPLYING SOY

INLET PROTECTION W/FABRIC

NO SCALE

5

FRAME AND COVER
FILTER FABRIC SHOULD BE 6" (MIN) EXTRA ALL AROUND FOR HAND HOLD.

MAINTENANCE:
1. INSPECT AFTER EACH STORM EVENT OF SILT ACCUMULATION.
2. REMOVE SEDIMENTATION AND REPLACE FILTER FABRIC IF NECESSARY.
3. PERIODICALLY REMOVE SEDIMENT AND TRACKED-ON SOIL FROM THE STREET.

STRAW BALES @ LAWN NLETS

NO SCALE

4

PLAN VIEW
SECTION VIEW

STRAW BALES BURIED 3"
STORM INLET
3" #4 REBAR STAKE
2"x6" SILT TRAP

MAINTENANCE:
1. INSPECT THE STRUCTURE PROTECTION AFTER EACH STORM EVENT.
2. REMOVE ACCUMULATED SEDIMENT AND MAKE NEEDED REPAIRS.
3. WHEN DRAINAGE AREA HAS BEEN STABILIZED, REMOVE ALL SEDIMENT AND CONSTRUCTION MATERIALS, GRADE DISTURBED AREA TO ELEVATION OF TOP OF INLET AND STABILIZE.

GENERAL NOTES

SEED ALL DISTURBED AREA UNLESS NOTED OTHERWISE.
COORDINATE ALL UTILITY DISCONNECTS AND RELOCATIONS WITH LOCAL UTILITY COMPANIES.
COORDINATE ALL RIGHT OF WAY WORK WITH THE TOWN OF PENDLETON, INDIANA.
FIELD LOCATE ALL STORM AND SANITARY SEWER INVERTS AND PIPES SIZES PRIOR TO BEGINNING CONSTRUCTION.
LANDSCAPING PLAN SEE SHEET C6.

DEMOLITION NOTES

1. REMOVE EXISTING ASPHALT PAVING, SAWCUT EDGES TO REMAIN, DISPOSE OF OFF-SITE.
2. EXISTING ASPHALT TO REMAIN.
3. REMOVE EXISTING CONCRETE CURB, SAWCUT EDGES TO REMAIN, DISPOSE OF OFF-SITE.
4. EXISTING CONCRETE CURB TO REMAIN.
5. REMOVE EXISTING GRAVEL PAVING, DISPOSE OF OFF-SITE.
6. EXISTING GRAVEL PAVING TO REMAIN.
7. EXISTING LIGHT POLE TO REMAIN.
8. EXISTING UTILITY POLE TO REMAIN.
9. EXISTING FENCE TO REMAIN.

PLAN NOTES:

1. 500' LAKE BANK.
2. SILT FENCE, SEE DETAIL 2/C1.
3. STRAW BALES IN SWALE, SEE DETAIL 3/C1.
4. STRAW BALES @ LAWN NLETS, SEE DETAIL 4/C1.
5. INLET PROTECTION W/FABRIC, SEE DETAIL 5/C1.
6. OUTLET EROSION CONTROL, SEE DETAIL 1/C1.

EROSION CONTROL LEGEND

-SF- SILT FENCE
-S- STRAW BALE DAM (SEE DETAIL)

SOIL SURVEY PLAN

CR-A - Crosby silt loam
BS - Brookston silty clay loam
MH2 - Miami silt loam

STRAW BALES N SWALE

NO SCALE

3

MAINTENANCE:
1. INSPECT STRAW BALE DAMS WEEKLY AND AFTER EACH STORM EVENT.
2. REMOVE ANY SEDIMENT DEPOSITS PROMPTLY, TAKING CARE NOT TO UNDERMINE ENTRENCHED BALES.
3. INSPECT WEEKLY FOR DETERIORATION OR DAMAGE BY CONSTRUCTION ACTIVITIES AND REPAIR IMMEDIATELY.
4. AFTER DRAINAGE AREA HAS BEEN STABILIZED, REMOVE BALES AND SEDIMENT, BRING DISTURBED AREA TO GRADE AND STABILIZE IT.

SILT FENCE

NO SCALE

2

MAINTENANCE:
1. INSPECT WEEKLY AND AFTER EACH STORM EVENT.
2. IF FABRIC IS TORN OR DETERIORATED, REPLACE SECTION IMMEDIATELY.
3. REMOVE SEDIMENT WHEN HEIGHT REACHES 1/3 OF THE HEIGHT OF THE FENCE OR IS CAUSING FABRIC TO BULGE.
4. TAKE CARE NOT TO UNDERMINE THE ENTRENCHED FABRIC.
5. AFTER DRAINAGE AREA IS STABILIZED, REMOVE FENCE AND SEDIMENT, BRING DISTURBED AREA TO GRADE AND STABILIZE IT.

OUTLET EROSION CONTROL

NO SCALE

1

PLAN
SOE

PREPARATION AND EROSION CONTROL PLAN

PREPARED FOR: PENDING PLACE APARTMENTS
SHEKHAN CONSTRUCTION CO., INC.
SHEET NO. C1

WEIHE ENGINEERS, INC.

10005 NORTH COLLEGE AVENUE
INDIANAPOLIS, INDIANA 46240
PHONE: (317) 440-0648
FAX: (317) 440-0649
WWW.WEIHE-ENGINEERS.COM
CIVIL ENGINEERING • LAND SURVEYING • LAND PLANNING • LANDSCAPE ARCHITECTURE

GENERAL NOTES


1. BERM ARE TO BE GRADED WITH A SMOOTH, NATURAL LOOKING TRANSITION TO ADJACENT GRADES.
2. WORK INSIDE OF ROW TO BE COORDINATED WITH LOCAL OFFICIALS.
3. ALL STORM SEWER PIPE AND SUBDRAINS TO BE CONSTRUCTED IN PHASE 1.
4. ALL EARTHWORK TO BE DONE IN PHASE 1 INCLUDING BUILDING PADS.
5. ME = MATCH EXISTING GRADE ELEVATION
6. ——— DIRECTIONAL FLOW ARROW
7. CONCRETE SPLASH BLOCKS AT ALL DOWNSPOUT LOCATIONS. SEE ARCHITECTURAL PLANS FOR FINAL LOCATIONS AND QUANTITY.

BENCHMARK:

HCOX DISK AT NW END OF S.R. ROAD #38 BRIDGE OVER I-69, STAMPED "MAD 652". ELEV. 897.84

TBM #1 CUT SQUARE ON TOP OF CONCRETE LIGHT BASE ON NORTH PROPERTY LINE, 3.5' WEST OF BACK OF CURB ON WEST SIDE OF VILLAGE DRIVE AND 1.5' SOUTH OF END OF STREET. ELEV. 873.17

TBM #2 PK NAIL 1.0' UP ON NORTH SIDE OF POWER POLE APPROX. 10' WEST OF SOUTHWEST PROPERTY CORNER AND ON SOUTH PROPERTY LINE EXTENDED. ELEV. 871.16

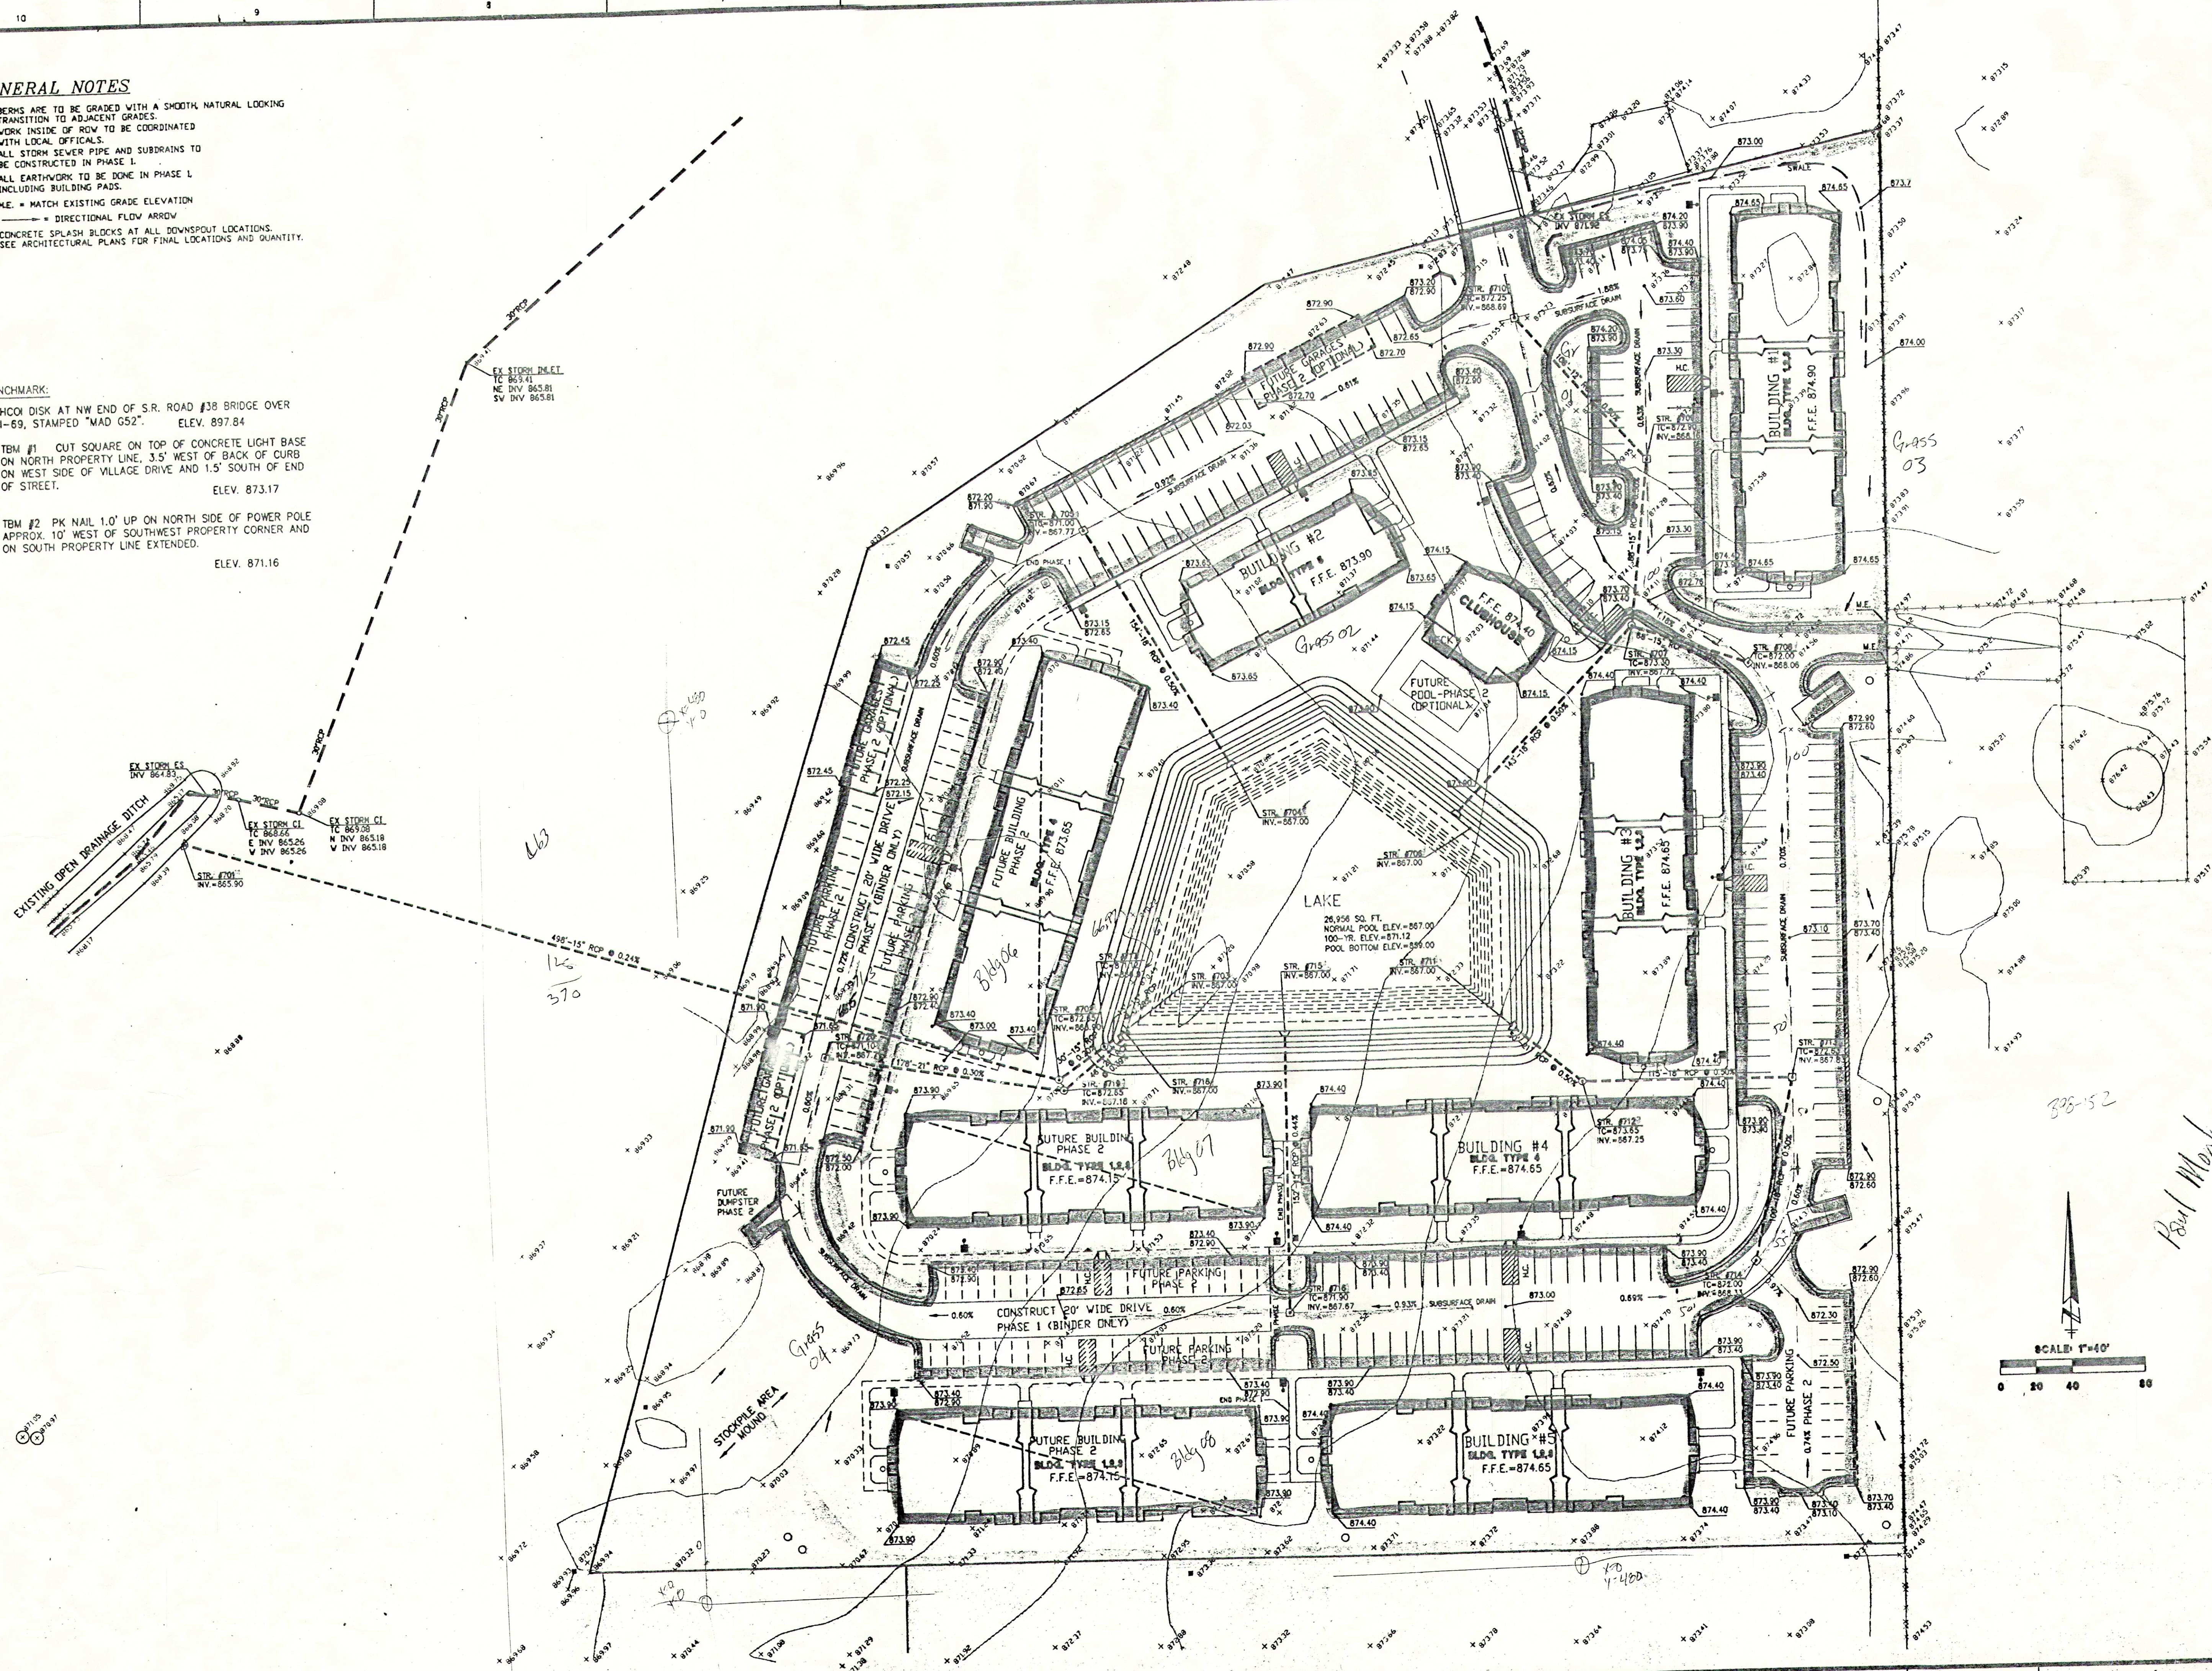

WEIHE ENGINEERS, INC.

ALLAN H. WEIHE, P.E., L.S.
PRESIDENT
10005 NORTH COLLEGE AVENUE
INDIANAPOLIS, INDIANA 46220
(317) 846-8811 FAX (317) 846-8846
TOLL-FREE (800) 445-0008
VICE - PRESIDENT

CIVIL ENGINEERS • LAND SURVEYORS • LAND PLANNERS • LANDSCAPE ARCHITECTS

PROJECT NO.	DATE	BY	REVISIONS
10005 NORTH COLLEGE AVENUE			
INDIANAPOLIS, INDIANA 46220			
(317) 846-8811 FAX (317) 846-8846			
TOLL-FREE (800) 445-0008			
VICE - PRESIDENT			
CIVIL ENGINEERS • LAND SURVEYORS • LAND PLANNERS • LANDSCAPE ARCHITECTS			

PREPARED FOR:
PENDLETON PLACE APARTMENTS
SHEEHAN CONSTRUCTION CO., INC.
GRADING AND DRAINAGE PLAN
Part of the 100% Submittal, Phase 10, March, 1999, for Pendleton Place Apartments, Indianapol...

SHEET NO.
C3

GENERAL NOTES

1. THE CONTRACTOR SHALL CONTACT ALL APPLICABLE UTILITIES AND VERIFY ANY AND ALL FEES ASSOCIATED WITH THE INSTALLATION OF ALL UTILITIES.
2. COORDINATE LOCATION OF ELECTRICAL AND TELEPHONE LINES WITH LOCAL UTILITIES AND ELECTRICAL DRAWINGS.
3. COORDINATE LOCATION AND SIZE OF GAS SERVICE CONNECTION AND INSTALLATION OF SERVICE LINE AND METER(S) WITH GAS COMPANY AND MECHANICAL DRAWINGS.
4. COORDINATE LOCATIONS AND CONNECTIONS OF DOWNSPOUTS WITH ARCHITECTURAL DRAWINGS FOR SPLASH BLOCKS.
5. CONTRACTOR SHALL BE RESPONSIBLE FOR OBTAINING ALL PERMITS AND/OR VERIFY THAT THEY HAVE BEEN OBTAINED.
6. VERIFY EXISTING INVERTS OF STORM SEWER AND SANITARY SEWER. ADJUST INVERTS AS REQUIRED. DOCUMENT ANY CHANGES.
7. COORDINATE LOCATION OF WATER SERVICE CONNECTION AND MASTER METER WITH LOCAL WATER UTILITY.
8. SEE GRADING AND DRAINAGE PLAN C3 FOR STORM SEWER PIPES.

EXISTING OPEN DRAINAGE DITCH

EX STORM IS
INV 864.83

EX STORM CL
TC 865.26
C INV 865.26
V INV 865.26

EX STORM CL
TC 865.08
N INV 865.18
V INV 865.18

EXISTING LIFT STATION
AND FORCE MAIN


EX STORM IS
TC 869.50
SE INV 859.30
NE INV 859.30
V INV 859.30

EXISTING MANHOLE
SHALL BE PLUGGED UNTIL
FINAL ACCEPTANCE OF THE
NEW MAIN EXTENSION.

EX STORM IS
TC 870.35
NW INV 861.84
FIELD VERIFY
PLUG & SEAL & INVERT
OLD SEWER

EX STORM IS
TC 870.35
NW INV 861.84
FIELD VERIFY
PLUG & SEAL & INVERT
OLD SEWER

EX STORM IS
TC 870.35
NW INV 861.84
FIELD VERIFY
PLUG & SEAL & INVERT
OLD SEWER

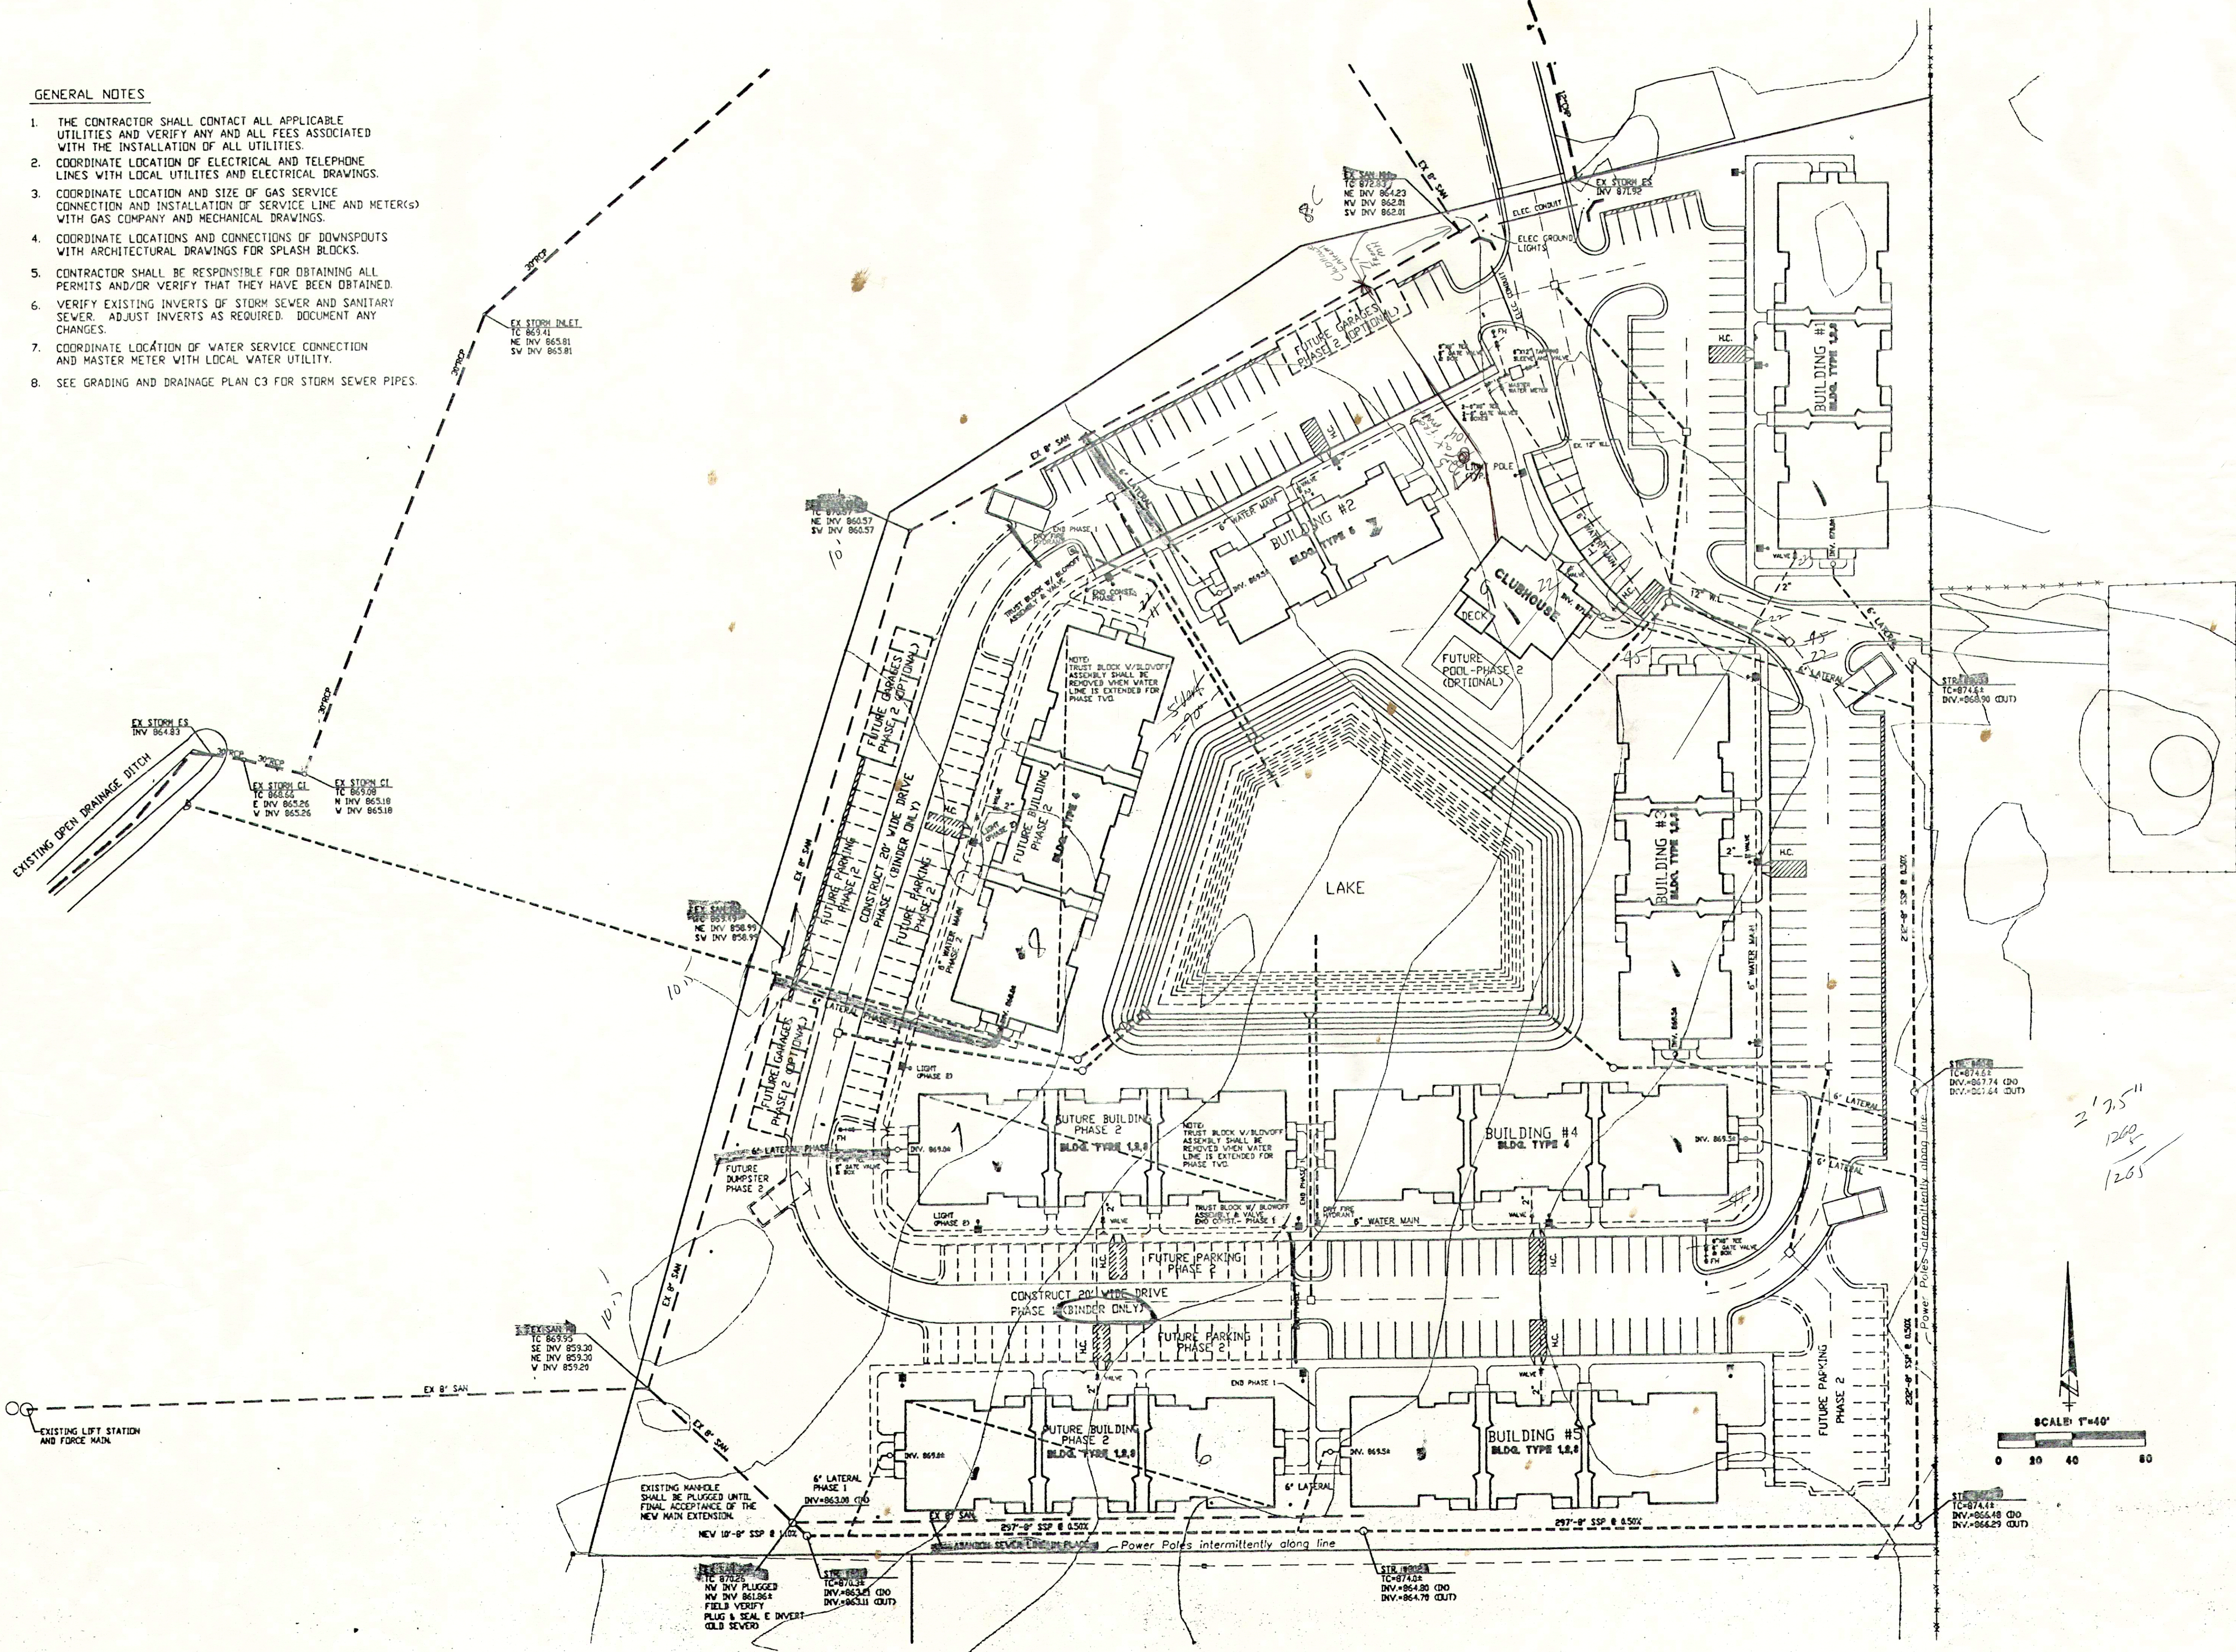

SCALE: 1"=40'

0 20 40 80

WEIHE ENGINEERS, INC.

ALLAN H. WEIHE, P.E., L.S.
PRESIDENT

10005 NORTH COLLEGE AVENUE
INDIANAPOLIS, INDIANA 46260
TEL: (317) 441-1111 FAX: (317) 441-1112
TOLL-FREE: (800) 445-4448

CIVIL ENGINEERS • LAND SURVEYORS • LAND PLANNERS • LANDSCAPE ARCHITECTS

PROJECT NO.	88-0038
DWG. NAME	UTILITY PLAN
DATE	22 MARCH 88
BY	ALLAN H. WEIHE
CHECKED BY	ALLAN H. WEIHE
DATE	22 MARCH 88



















PENDLETON PLACE APARTMENTS

UTILITY PLAN

SHEEHAN CONSTRUCTION CO., INC.

Prep. of this plan by Sheehan Construction Co., Inc. under the supervision of Allan H. Weihe, P.E., L.S., State of Indiana, License No. 8627.

SHEET NO. **C4**

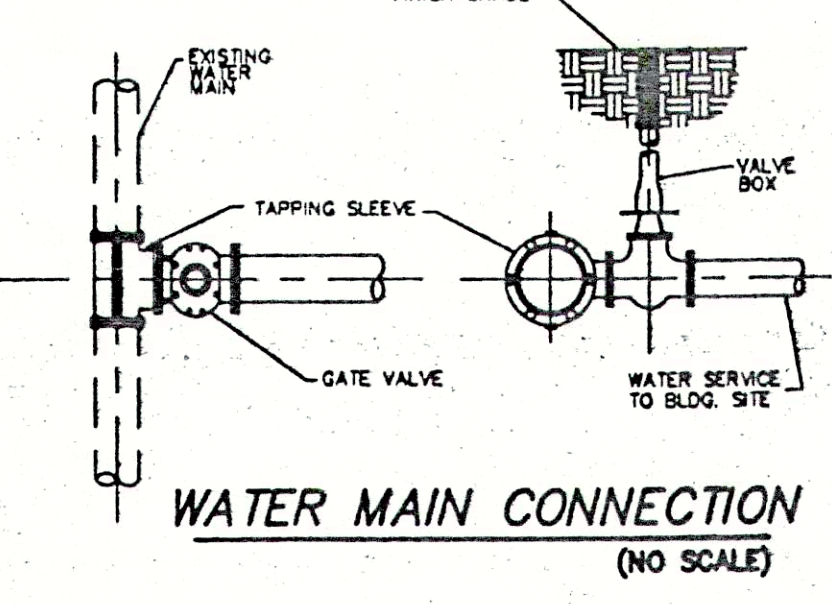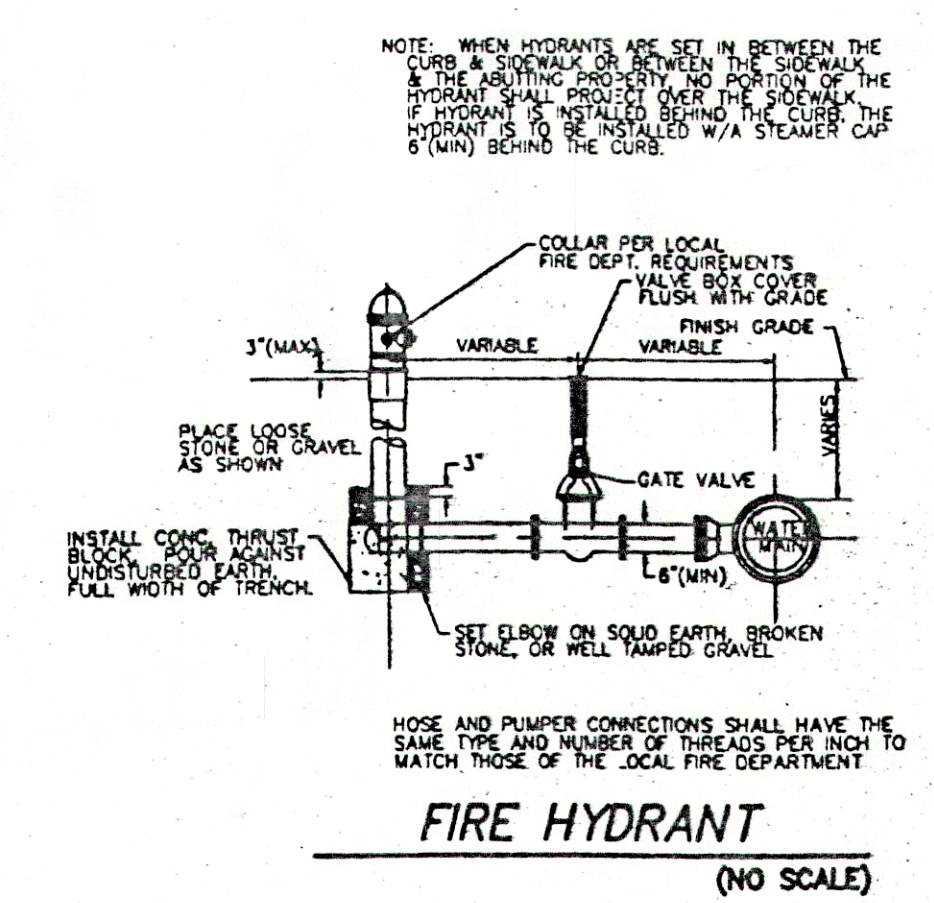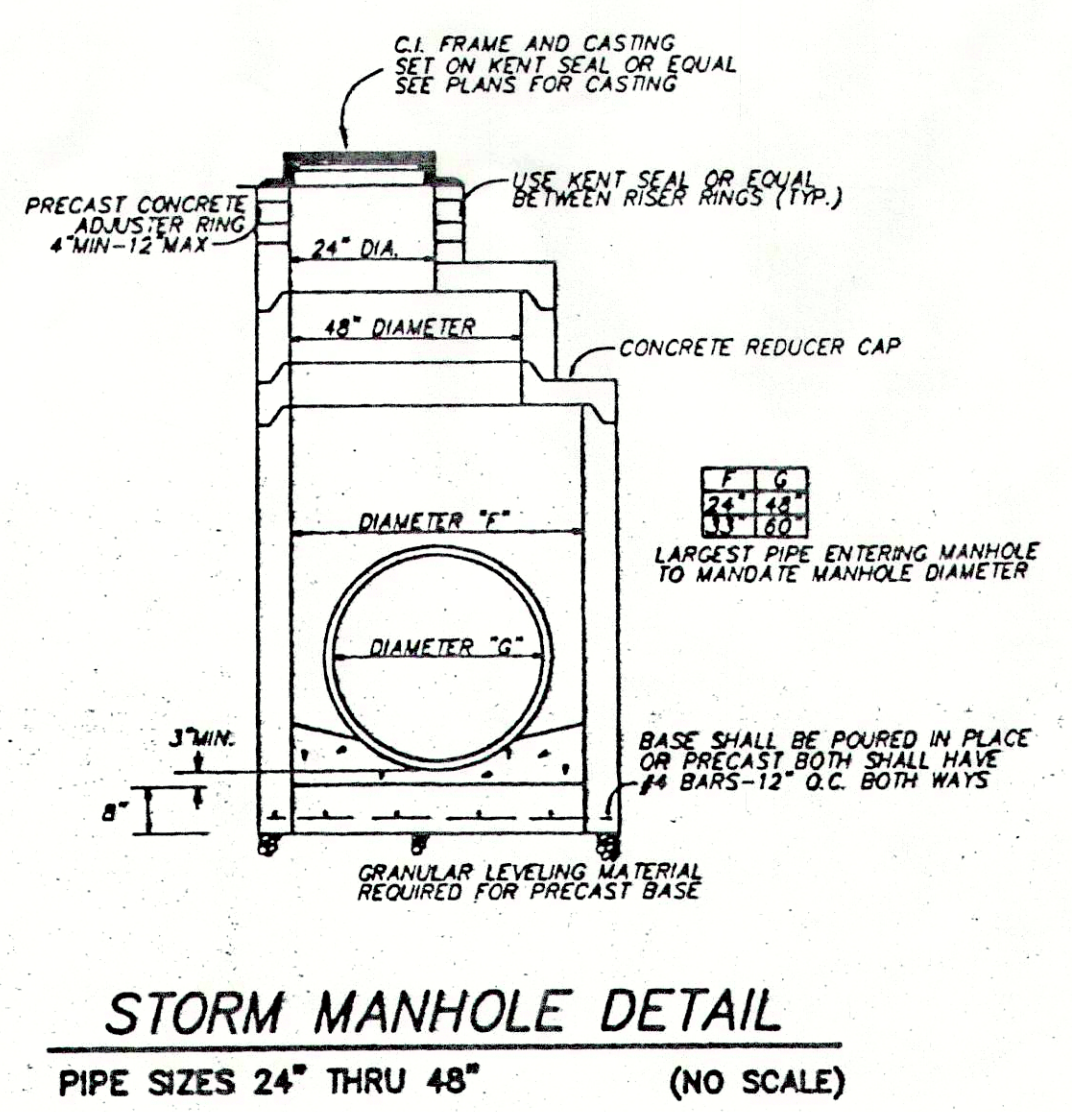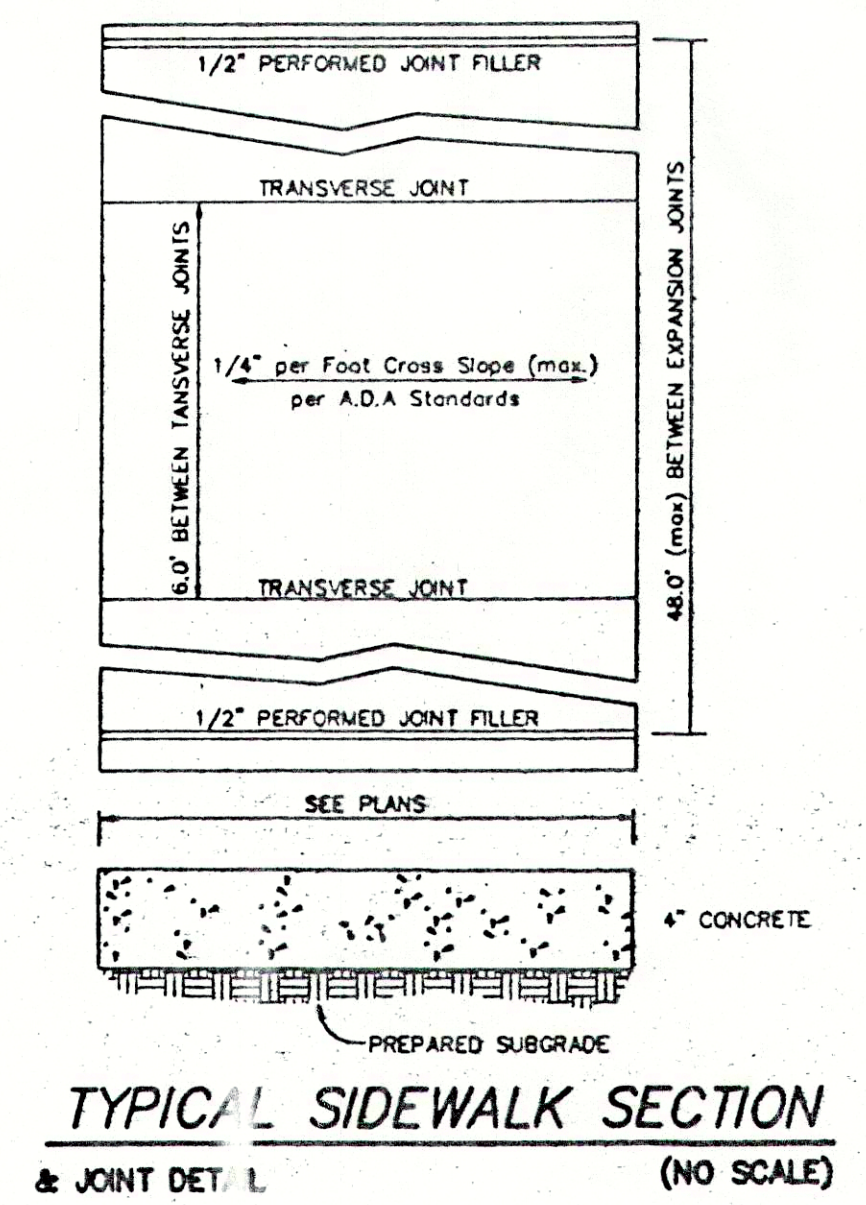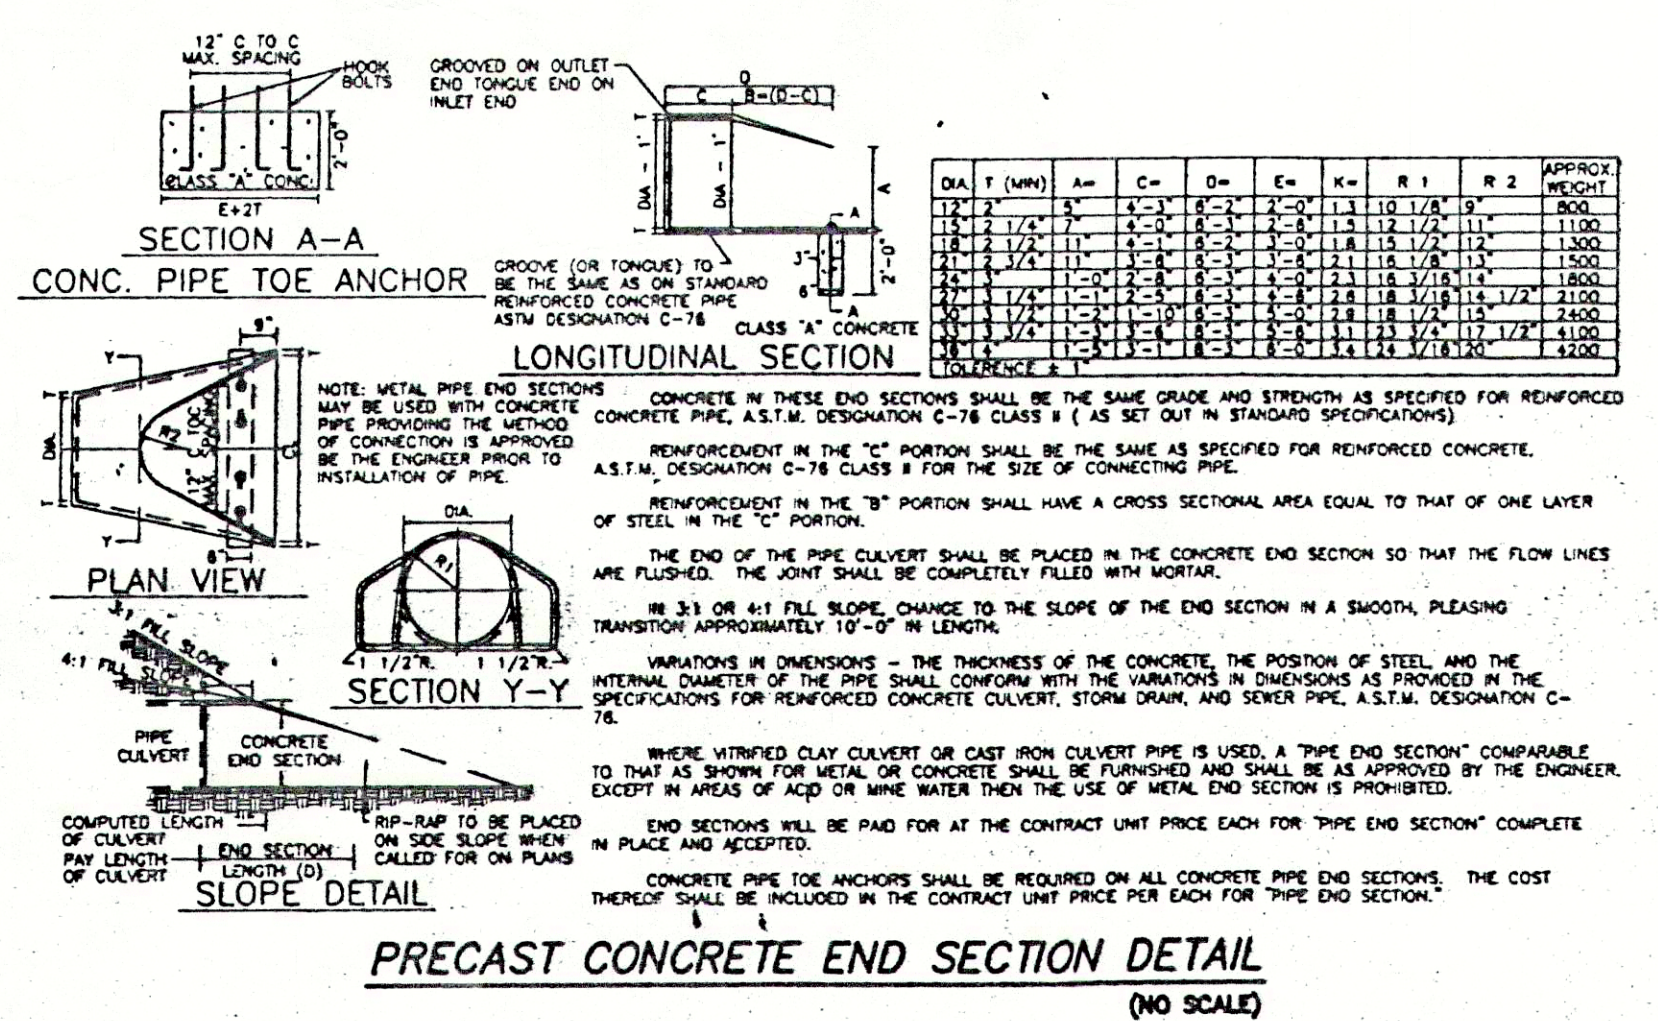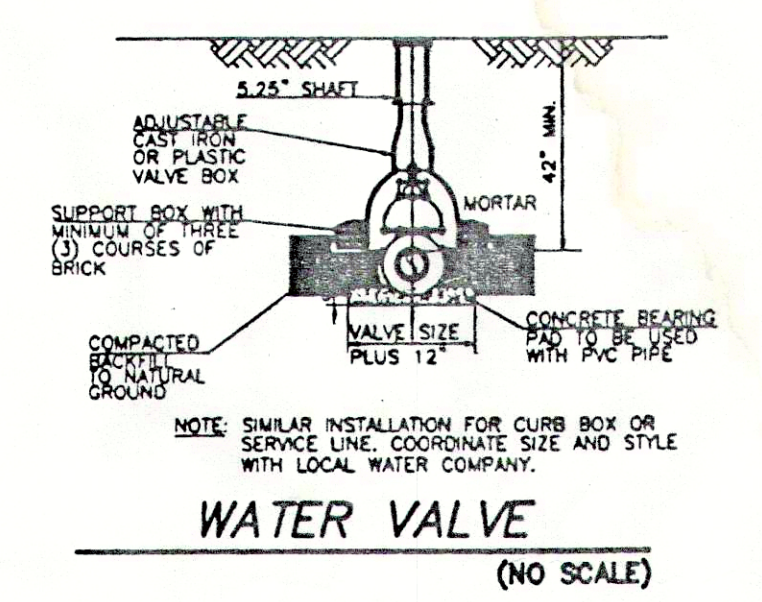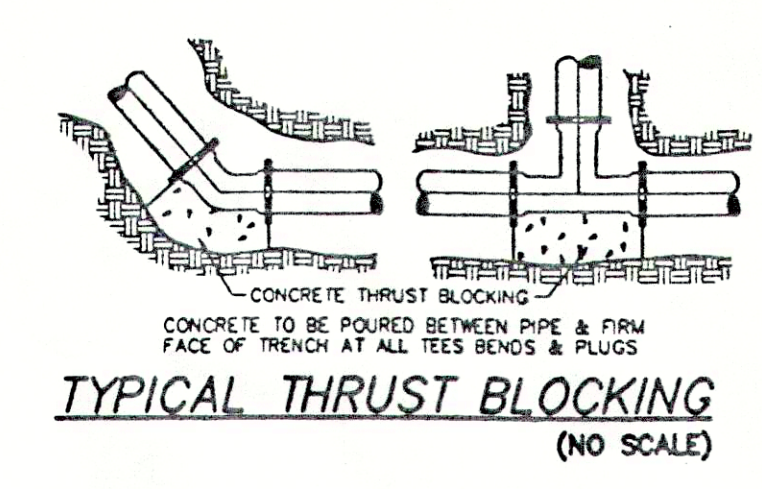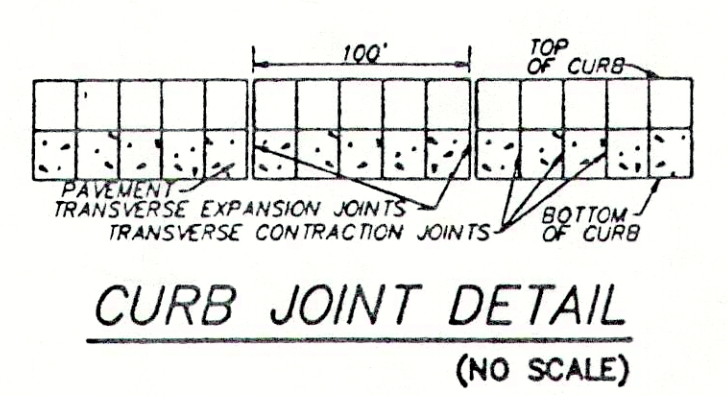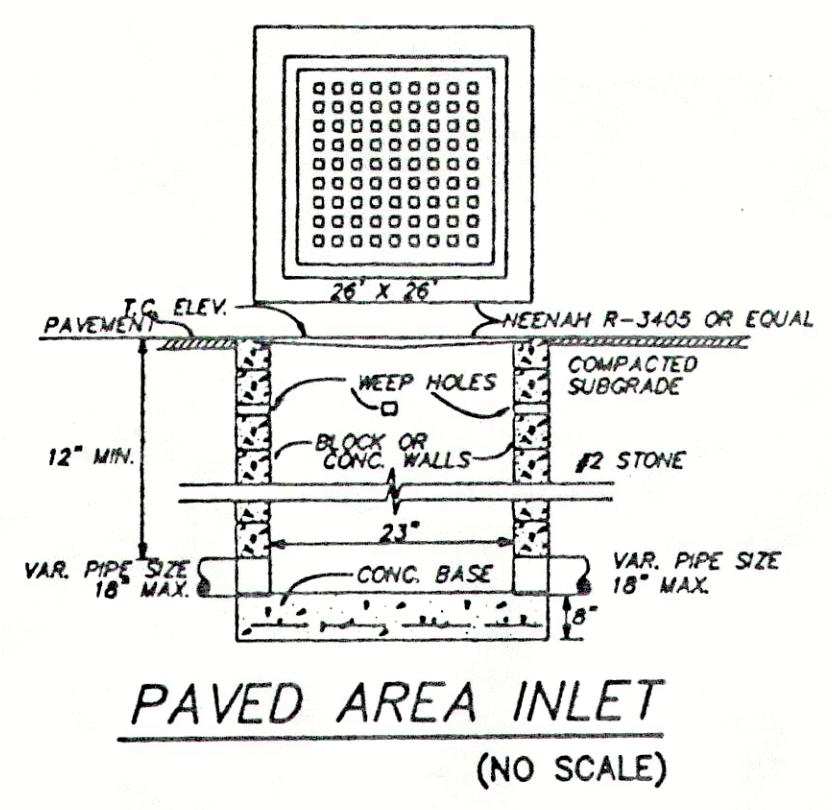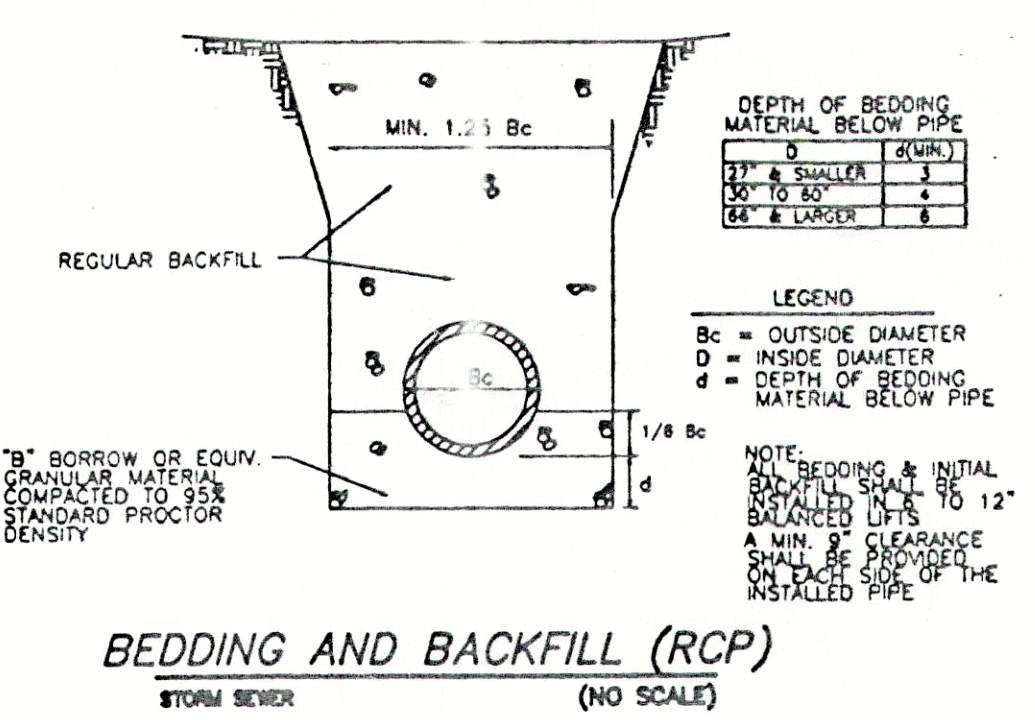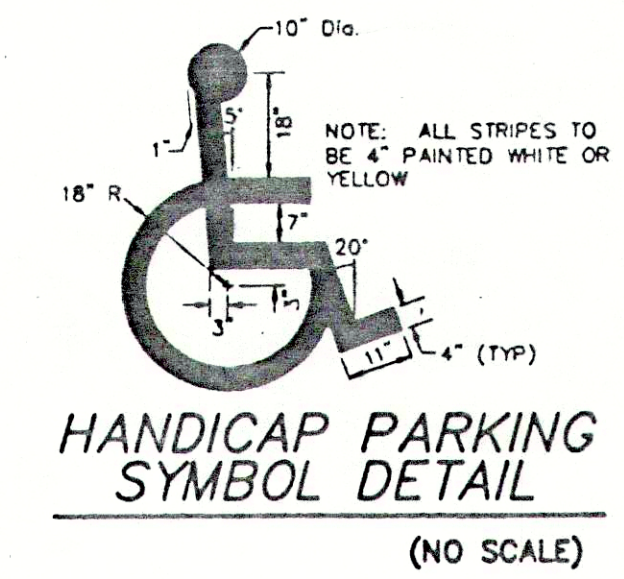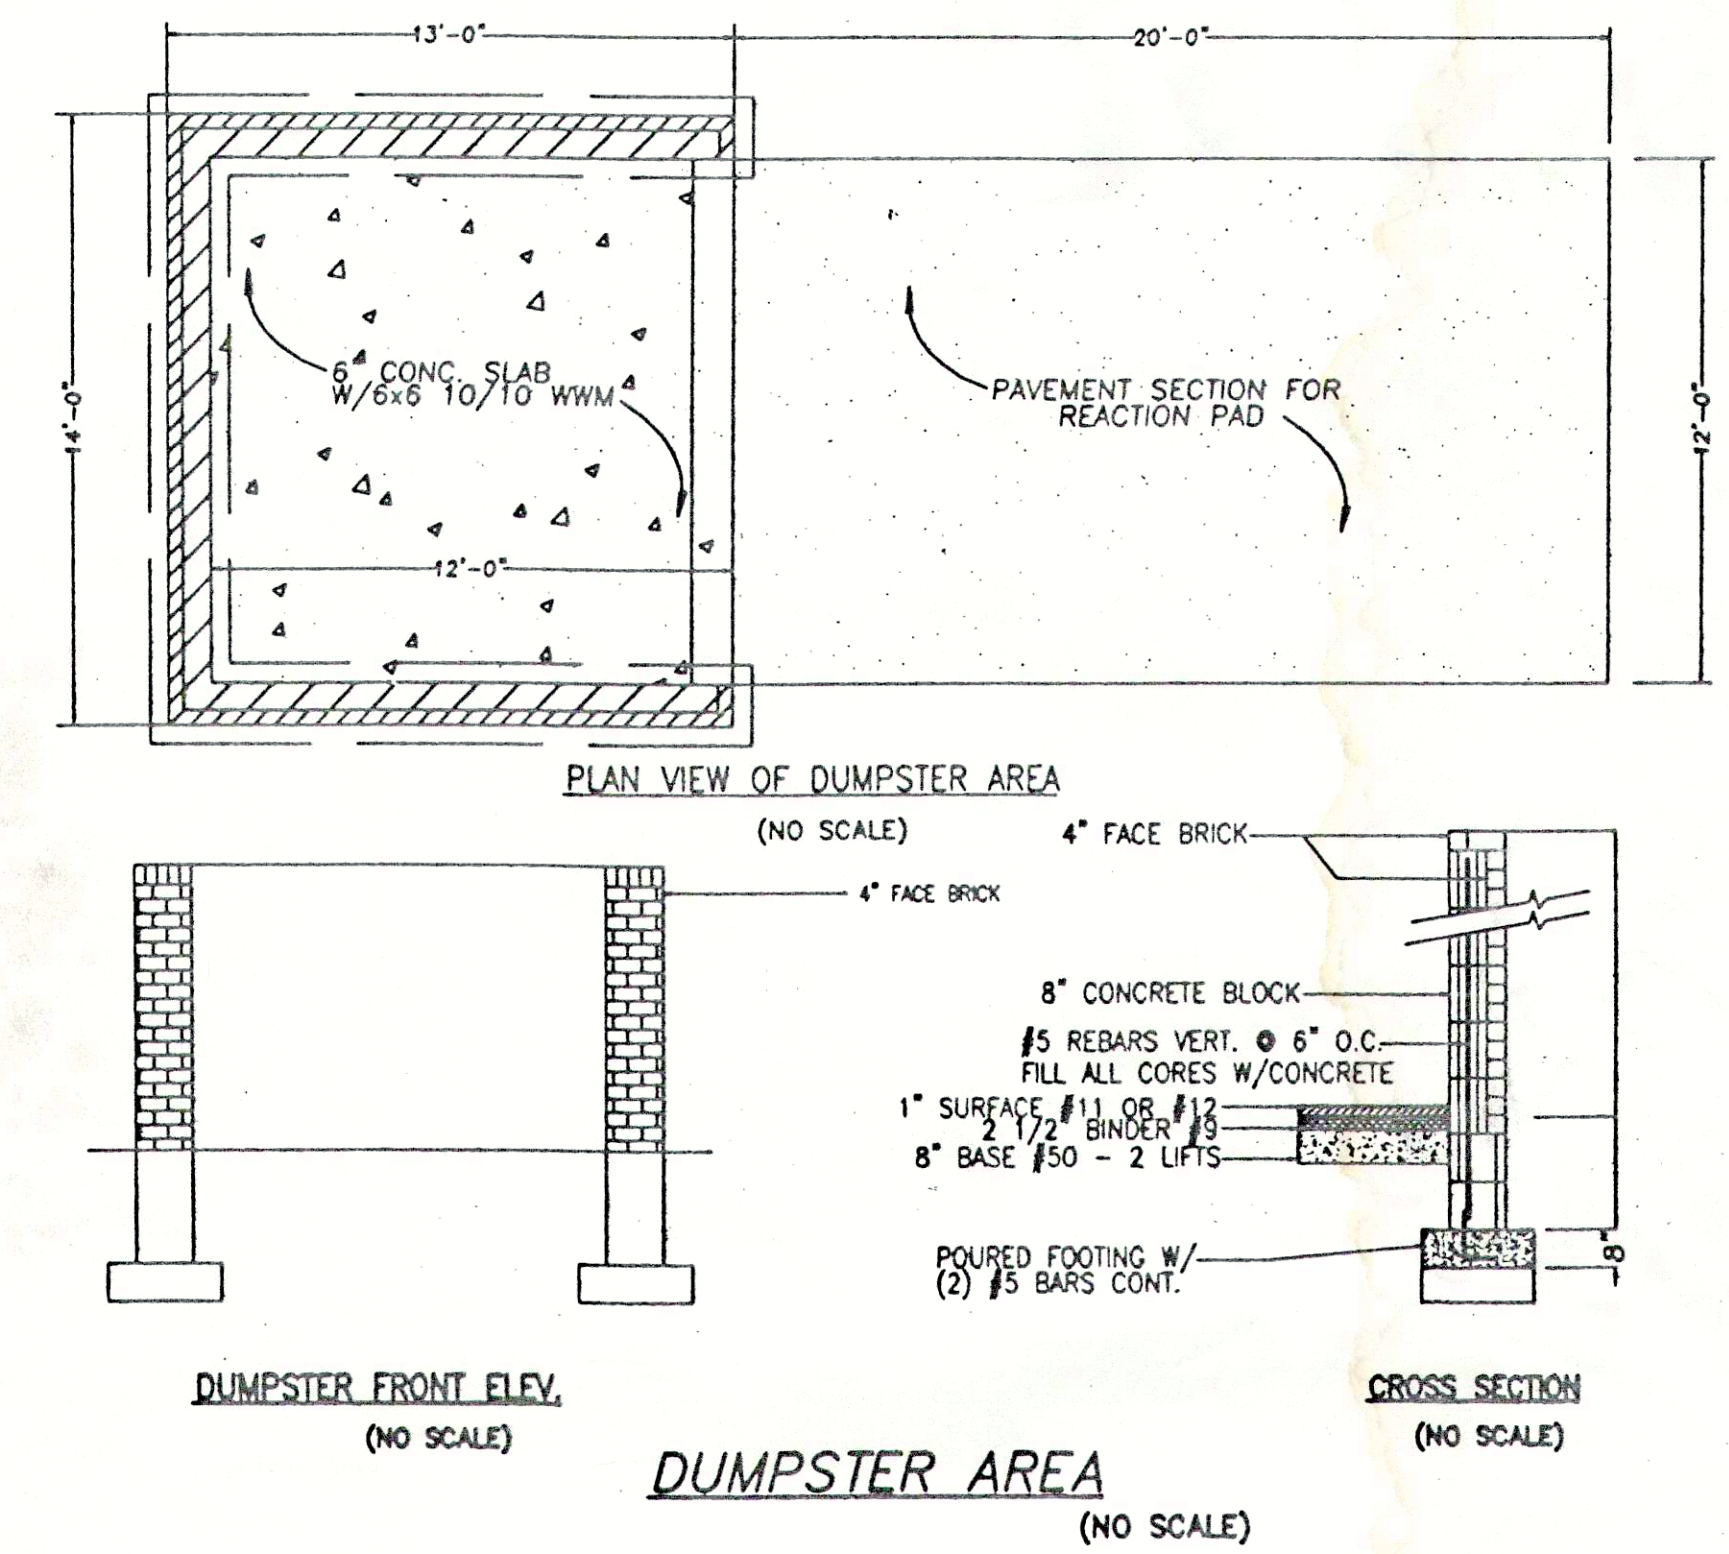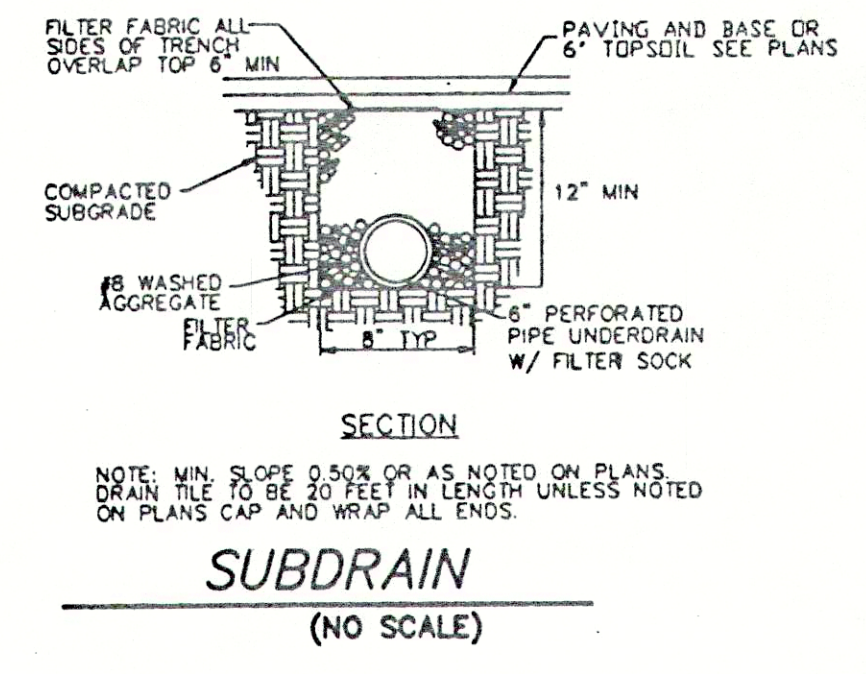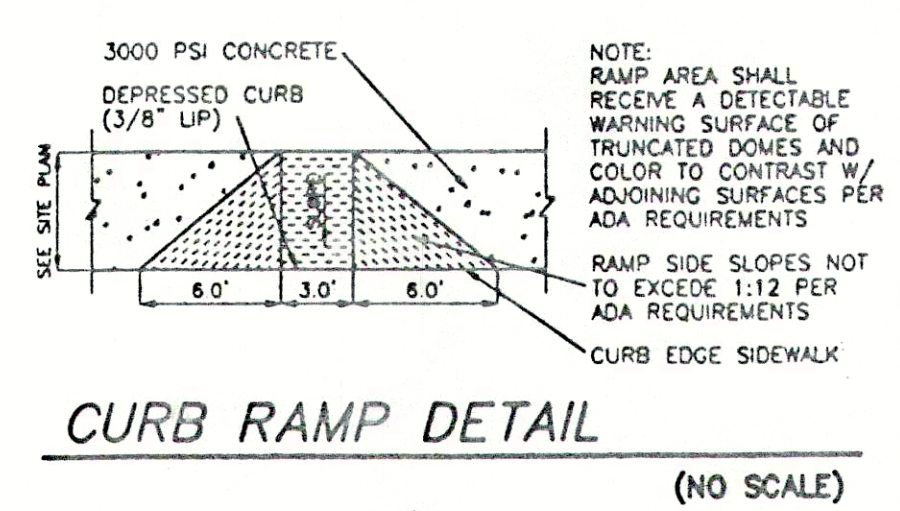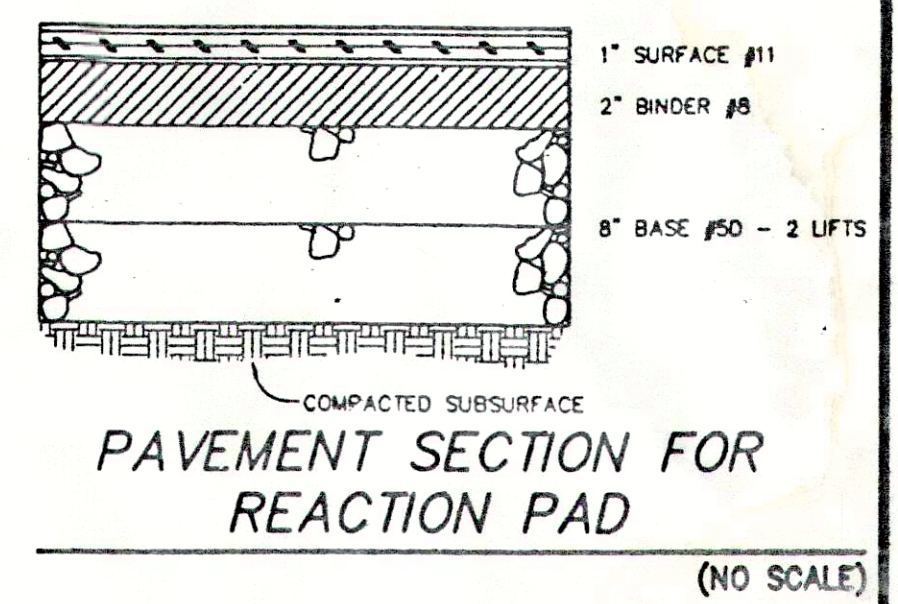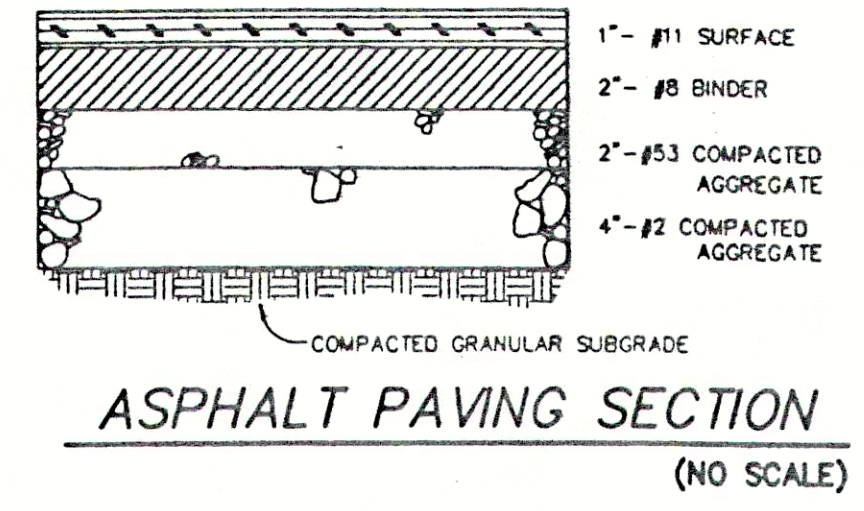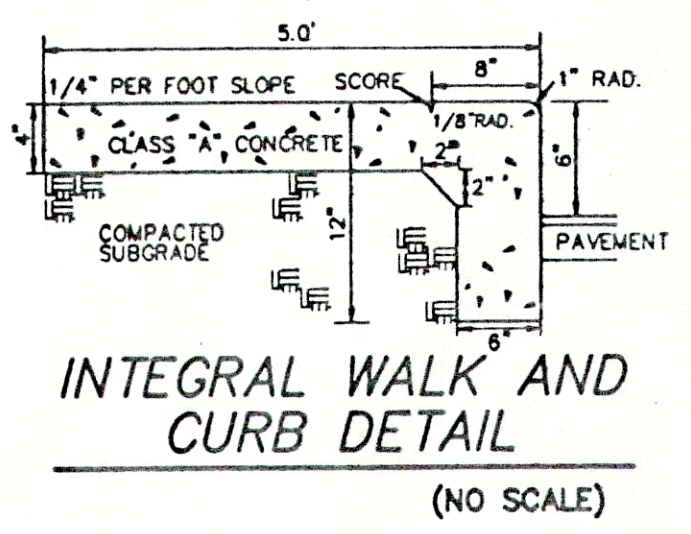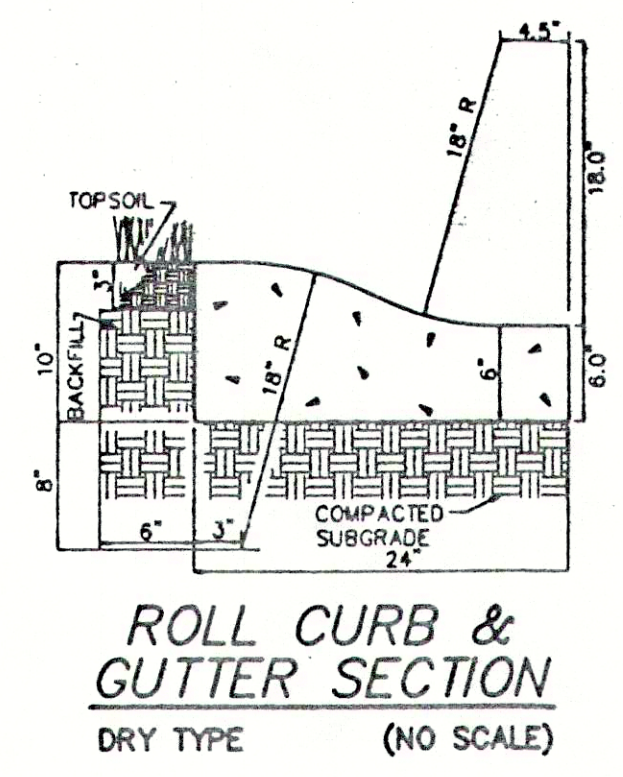

WEIHE ENGINEERS, INC.

10005 NORTH COLLEGE AVENUE
INDIANAPOLIS, INDIANA 46260
(317) 551-1111 FAX (317) 551-1100
TOLL-FREE (800) 455-4400

ALLAN H. WEIHE, P.E., L.S.
PRESIDENT
DANIEL L. WEIHE, L.S.
VICE PRESIDENT

CIVIL ENGINEERS • LAND SURVEYORS • LAND PLANNERS • LANDSCAPE ARCHITECTS

PROJECT NO. 98-0035
DATE 11/11/98
BY TTT
DATE 11/11/98
BY TTT
DATE 11/11/98
BY TTT

REGISTERED PROFESSIONAL ENGINEER
No. 8827
STATE OF INDIANA
ALLAN H. WEIHE, P.E. 8827


PENDLETON PLACE APARTMENTS

SHEEHAN CONSTRUCTION CO., INC.


SITE DETAILS

Part of the 16 1/4 Acre Subdiv. 18, Trp. 18 North, Range 7 East, Field Creek Twp., Hamilton County, Indiana


SHEET NO. **C5**

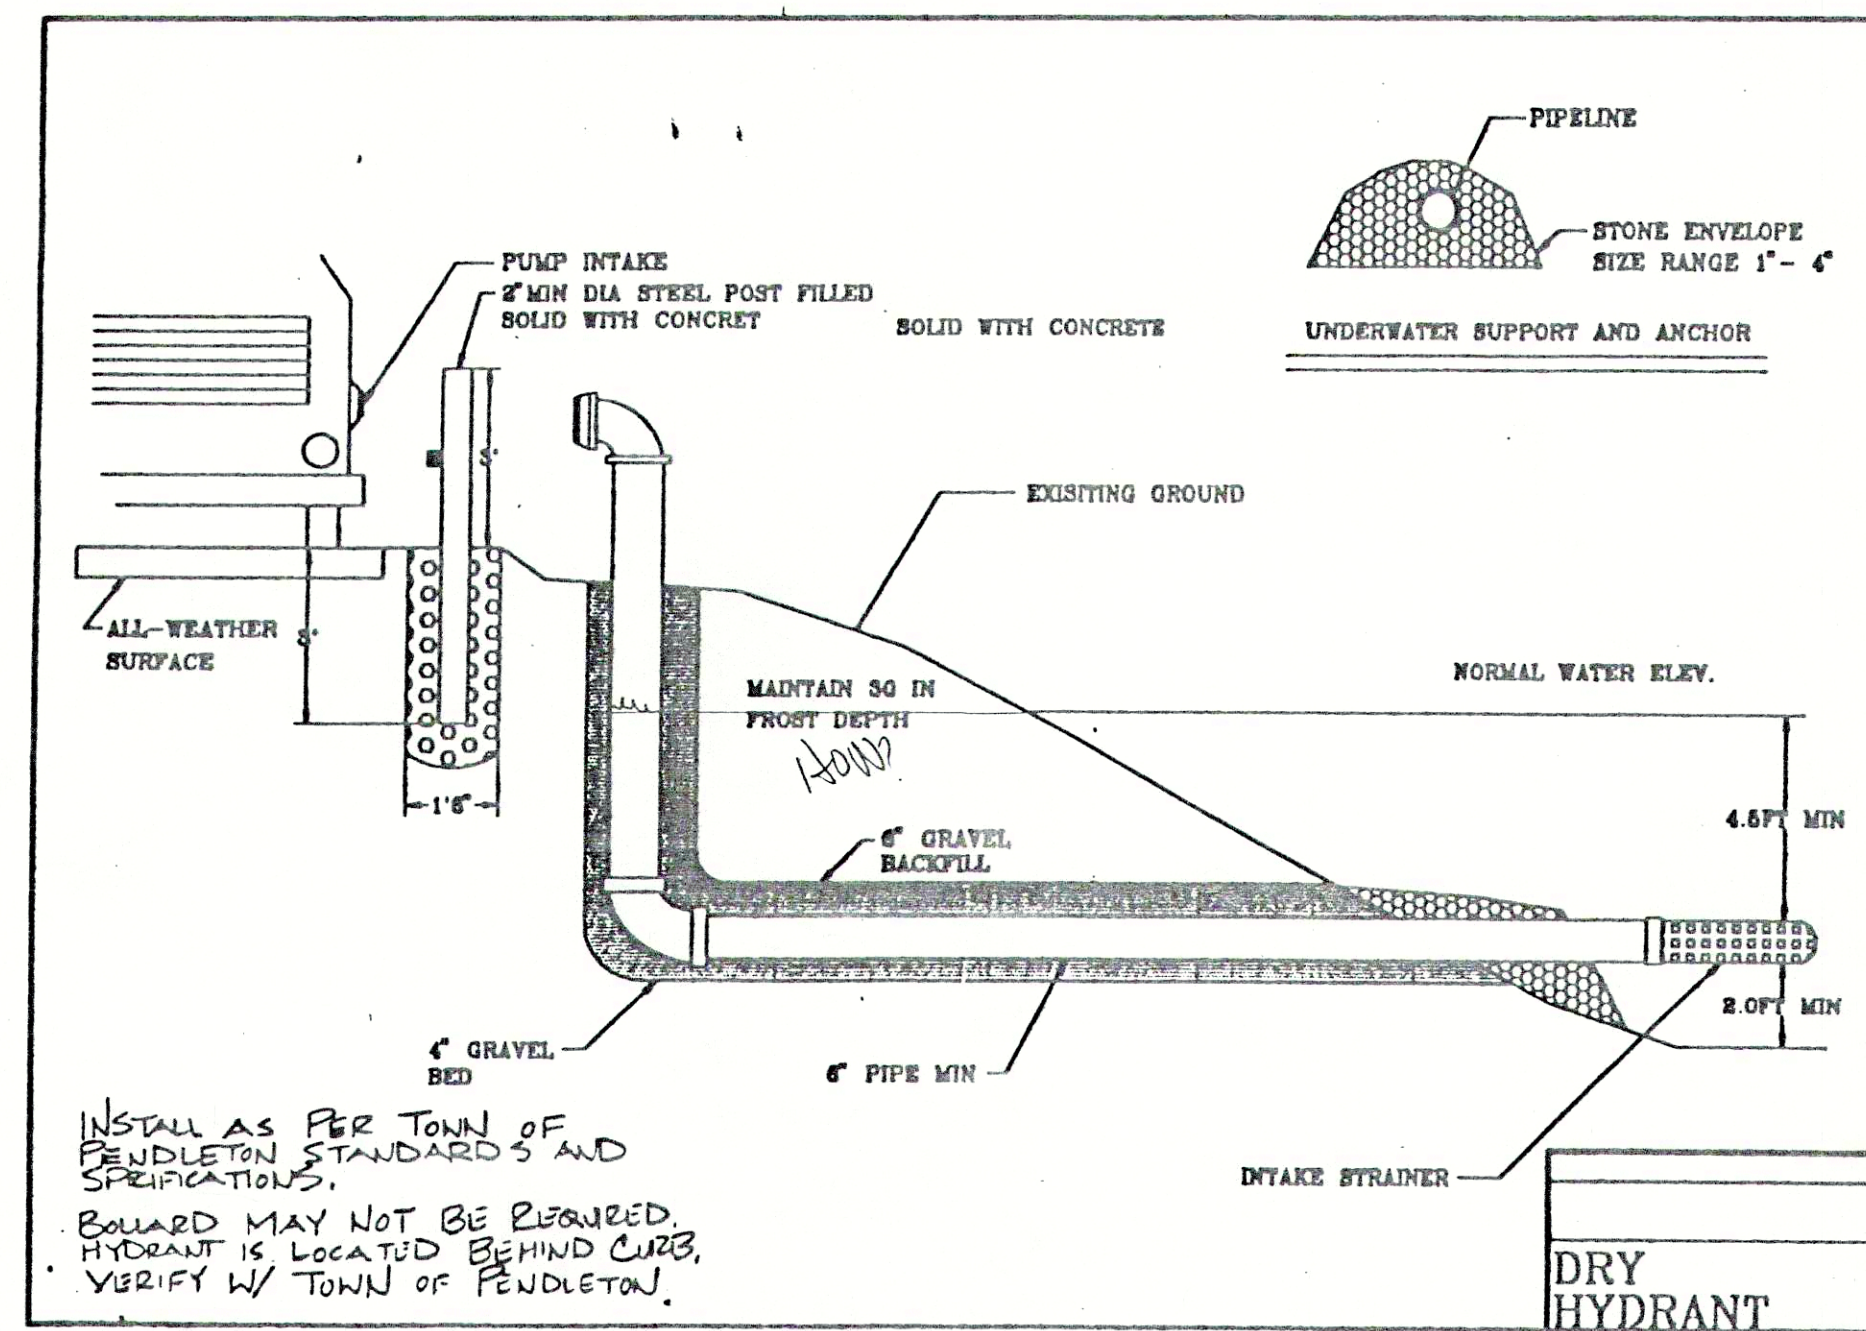


1 STORM SEWER/SANITARY SEWER CROSSING DETAIL
SCALE: N.T.S.

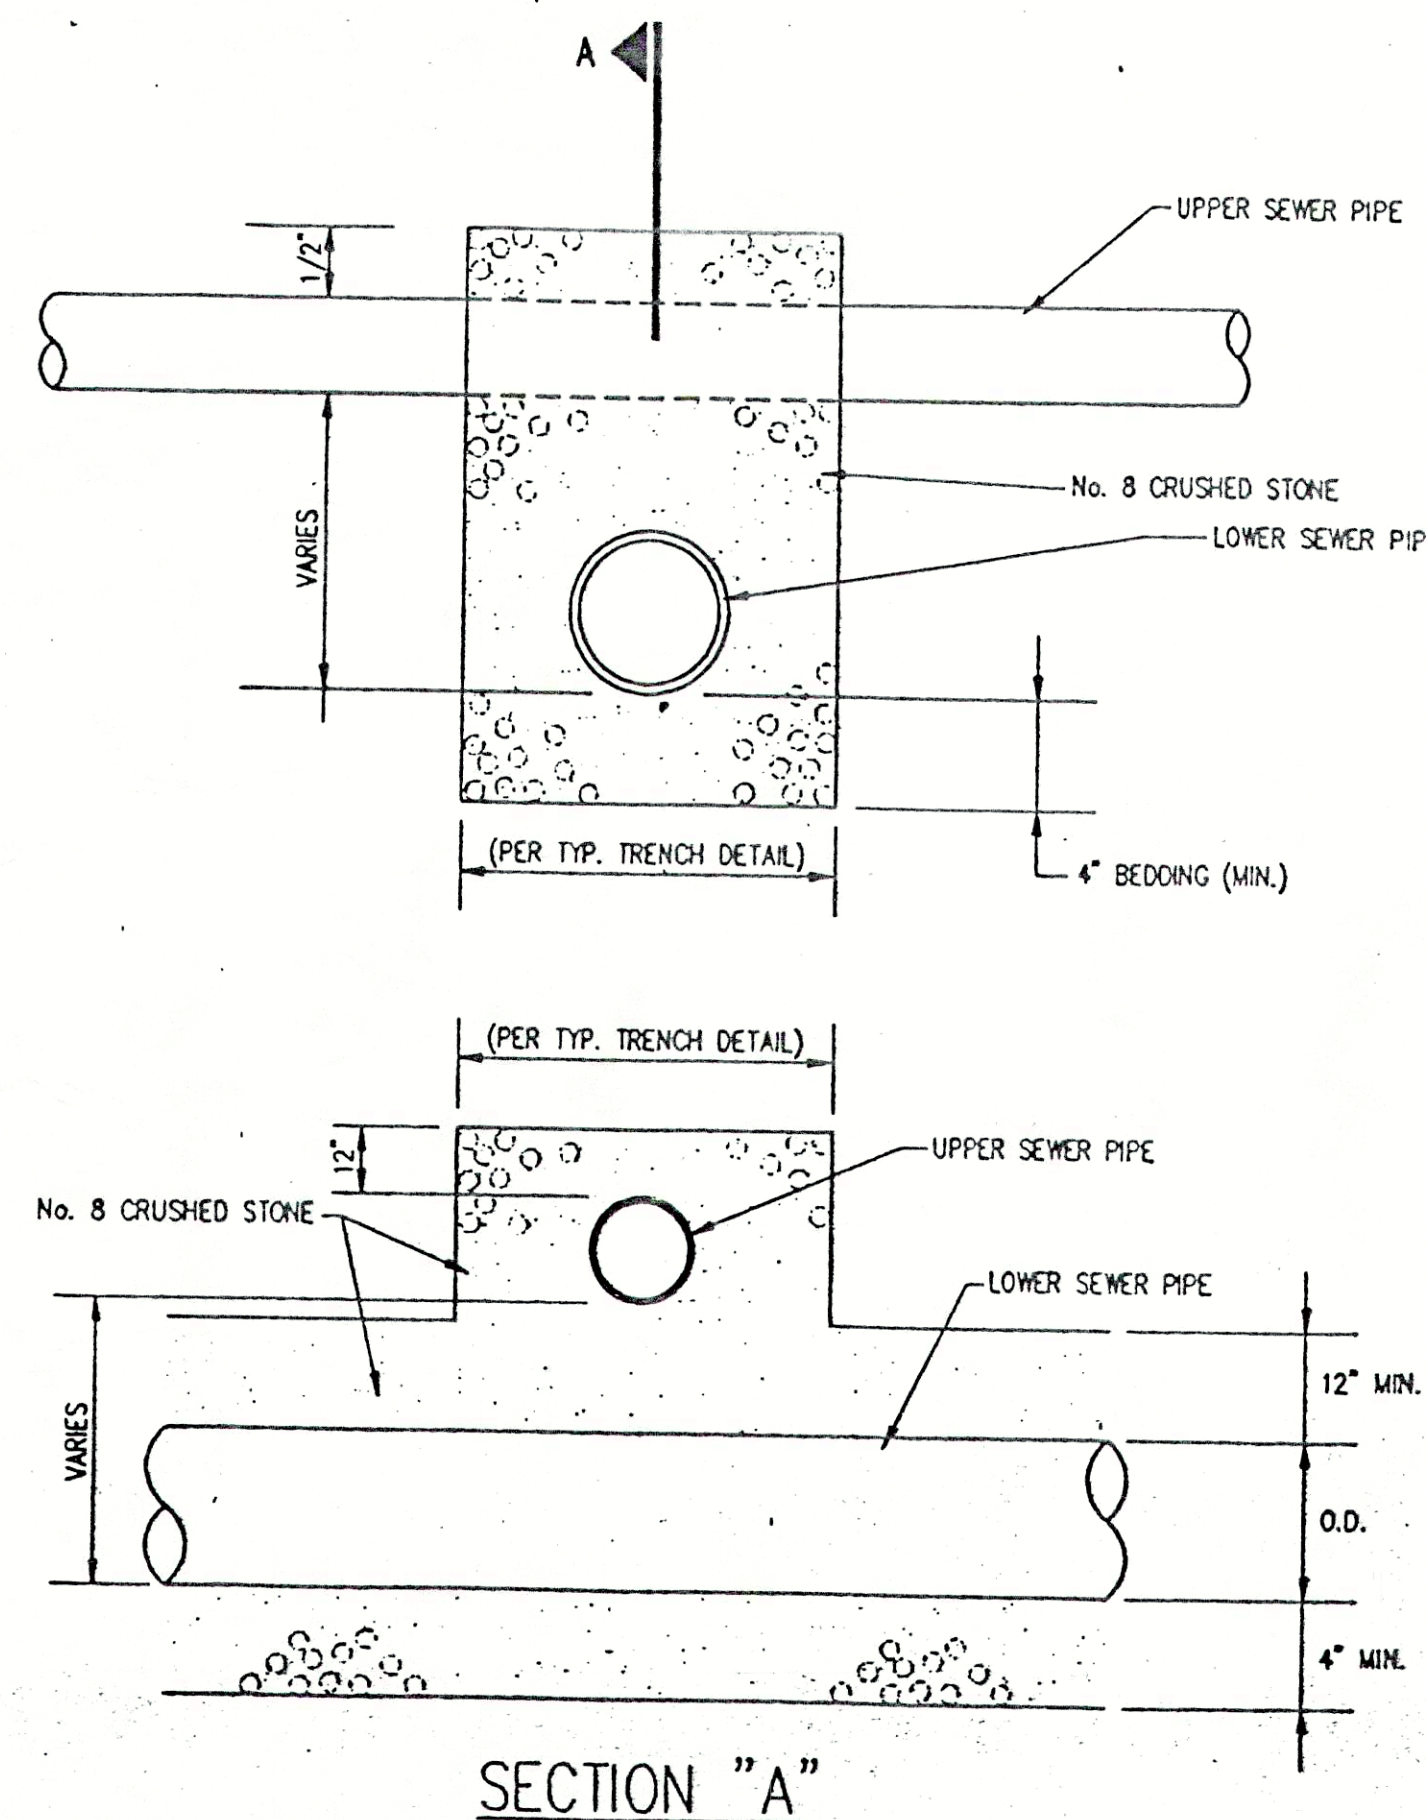


2 TYPICAL TRENCH AND PAVEMENT PATCH DETAIL
SCALE: N.T.S.

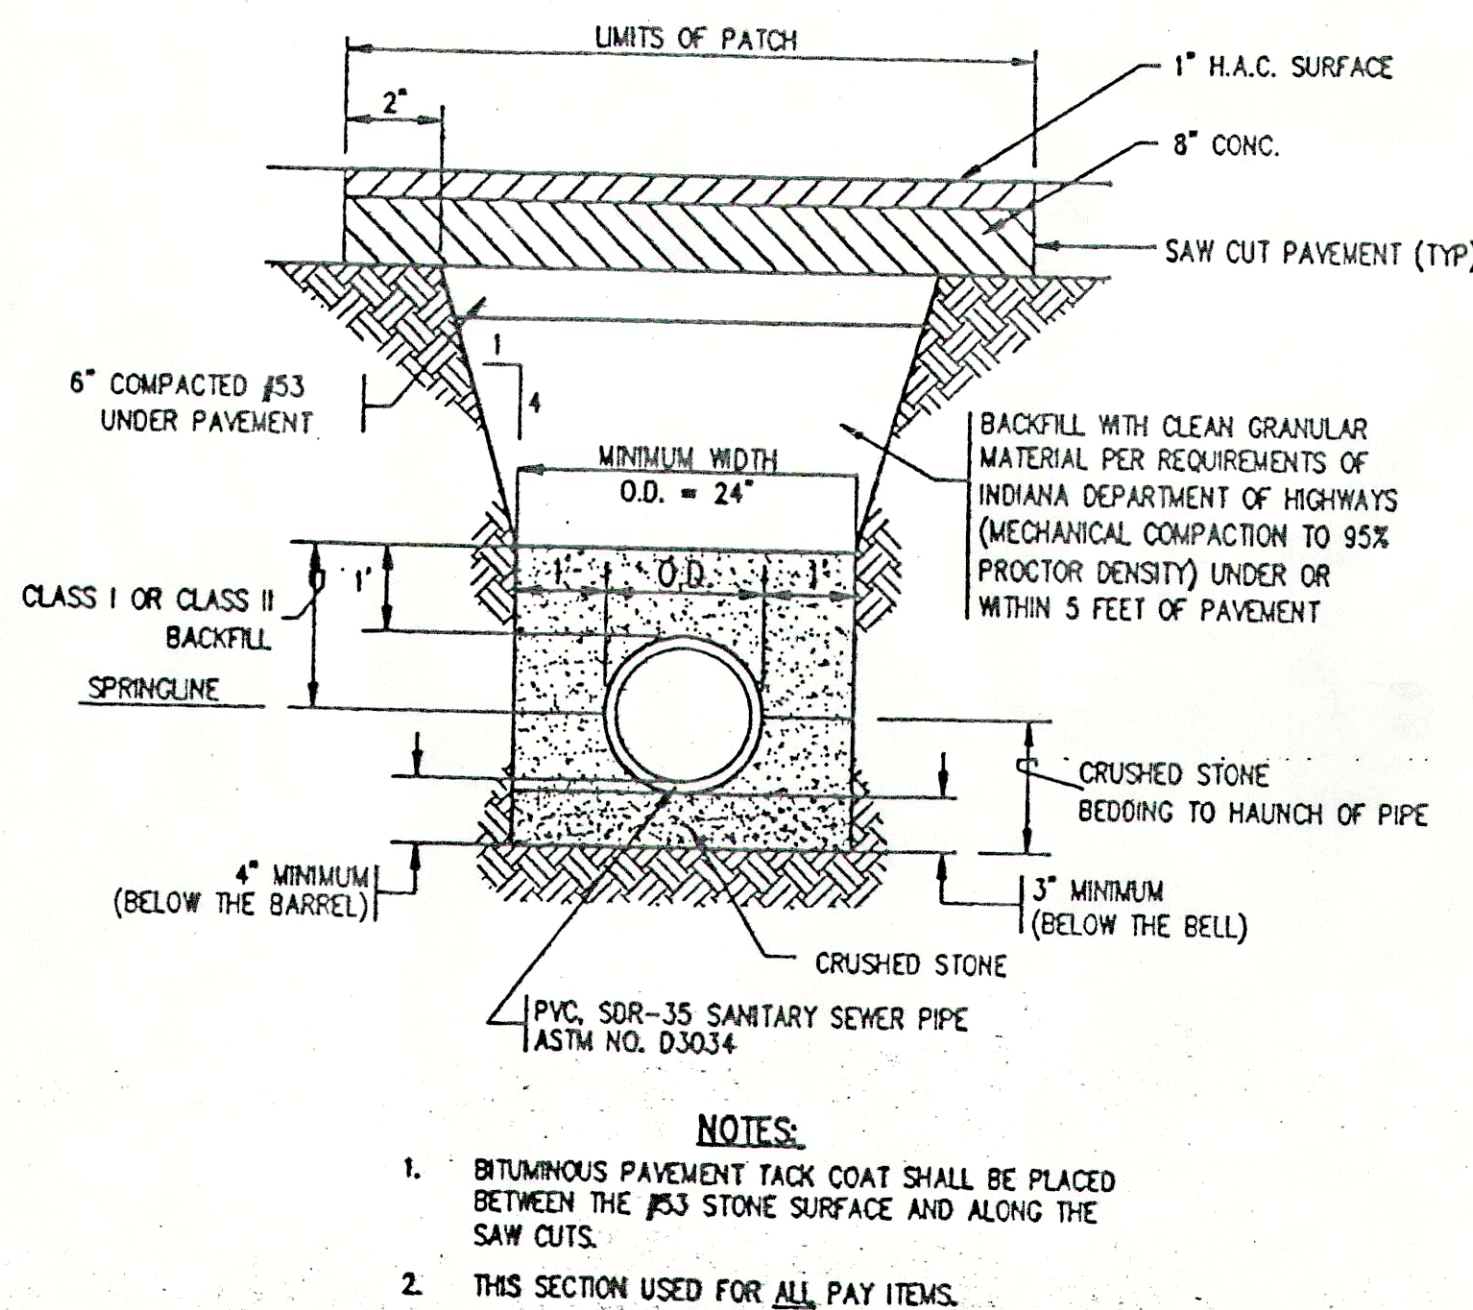


3 SANITARY MANHOLE
SCALE: N.T.S.

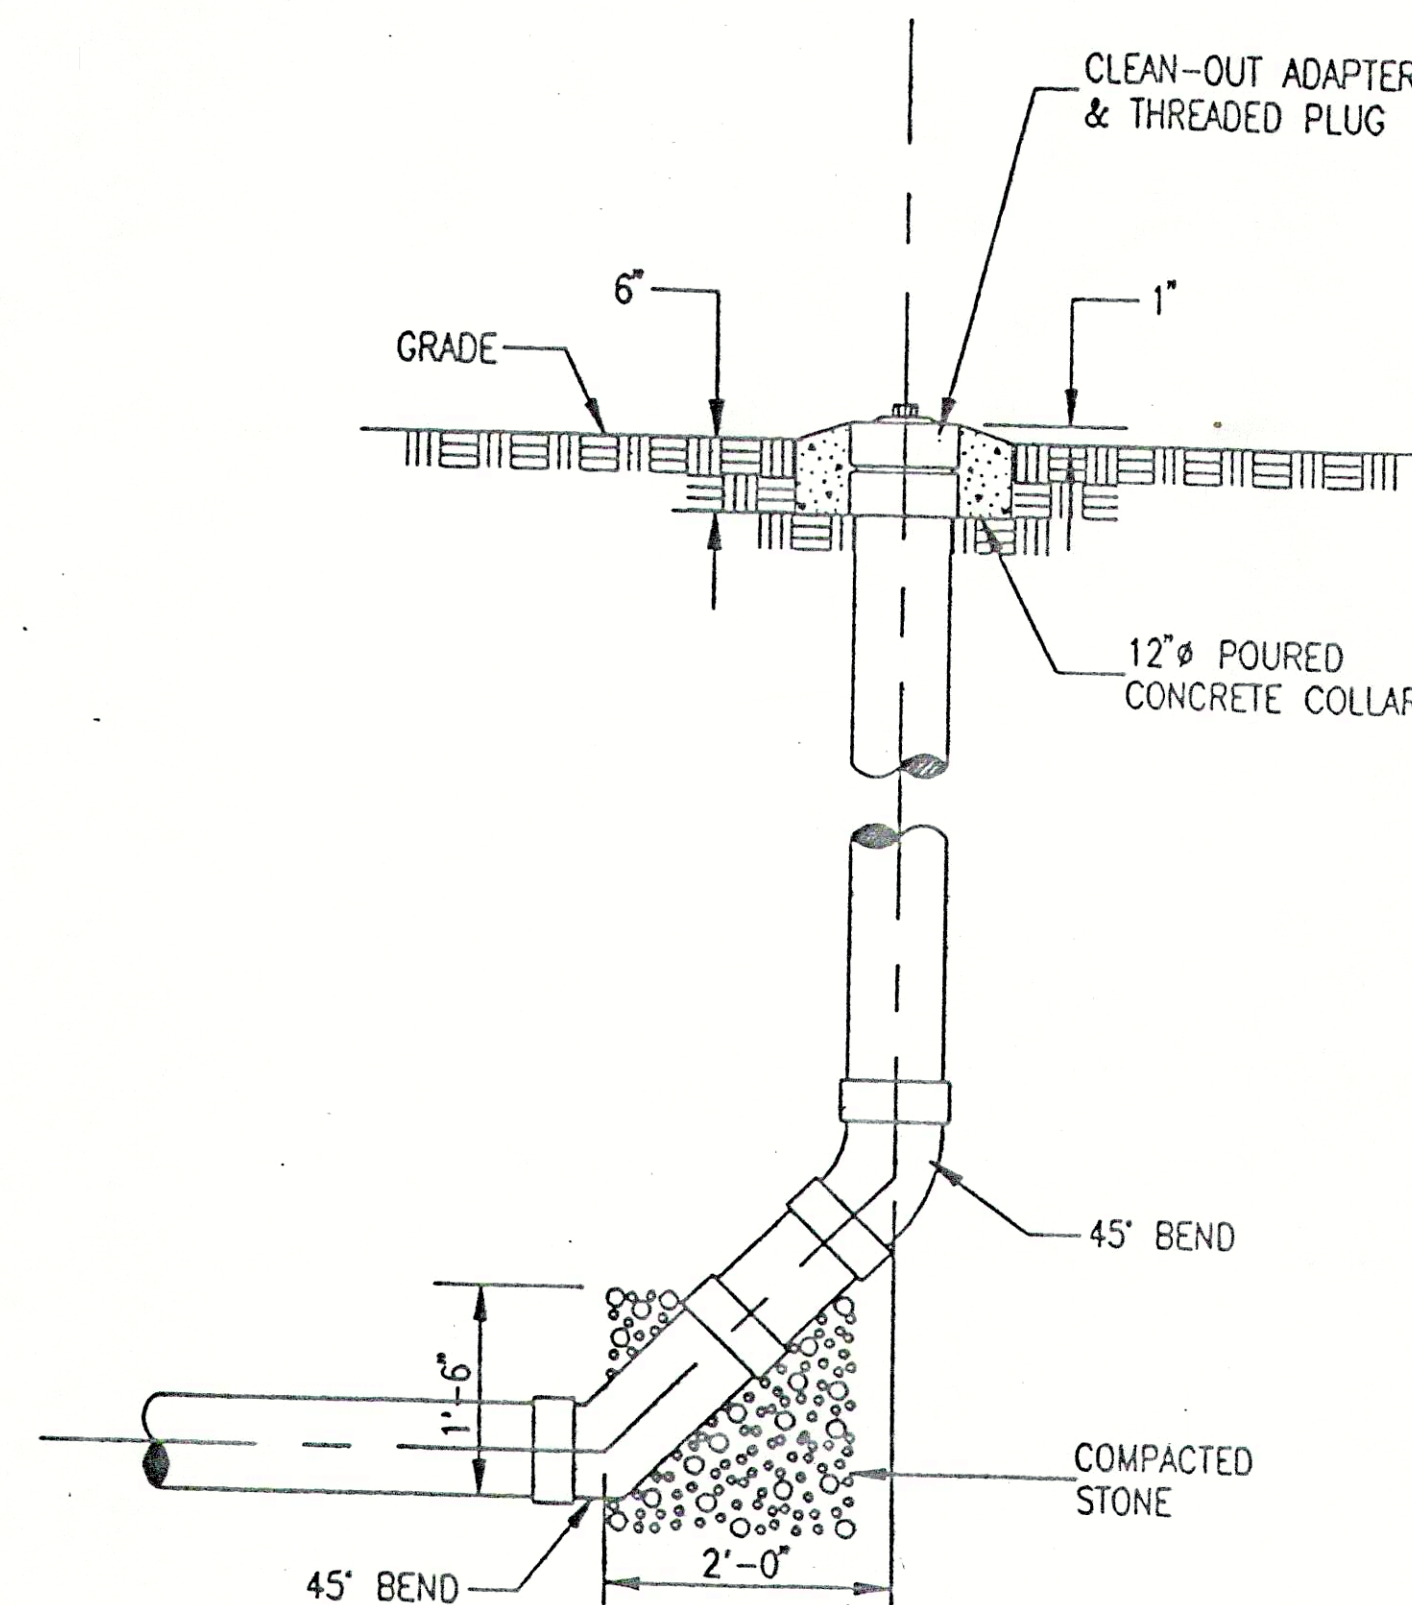

6 CLEANOUT - TYPE II
SCALE: CD18.DWG
DISK: CD1

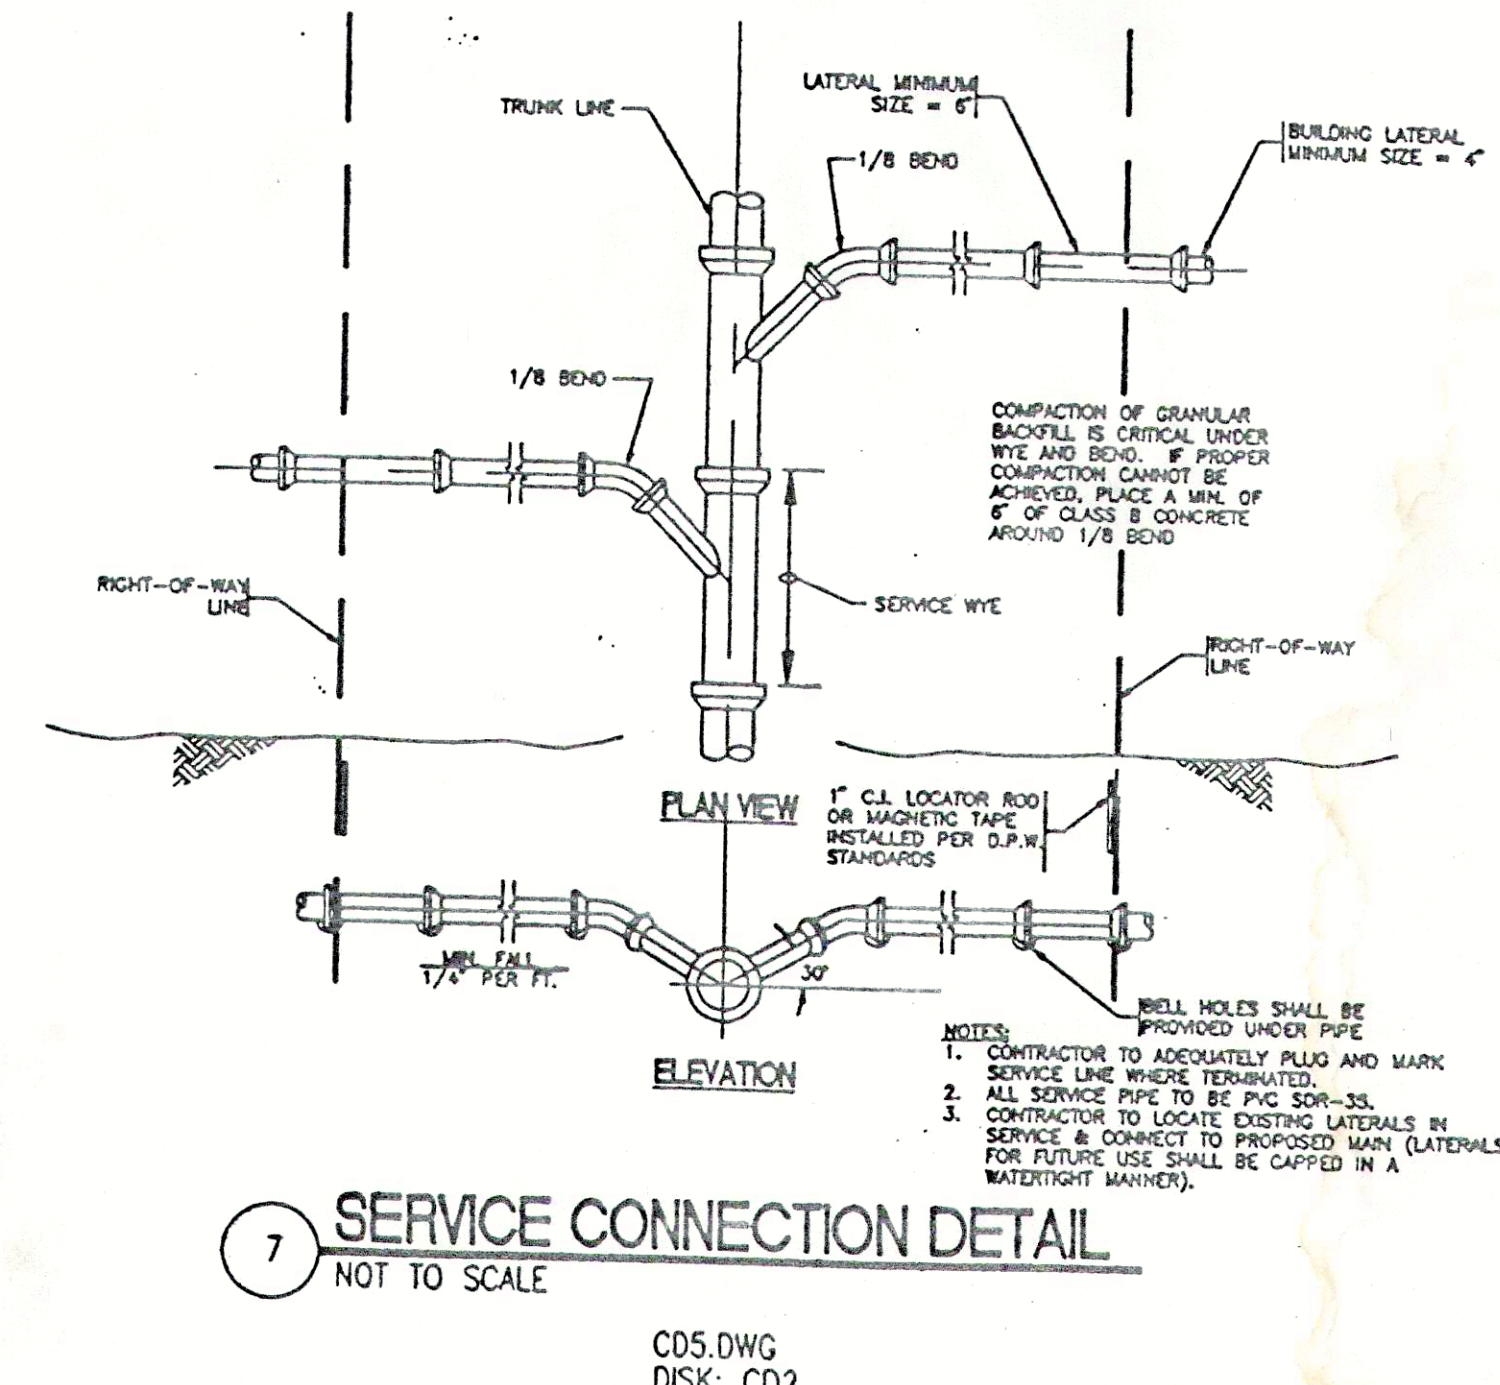

7 SERVICE CONNECTION DETAIL
NOT TO SCALE
CD5.DWG
DISK: CD2

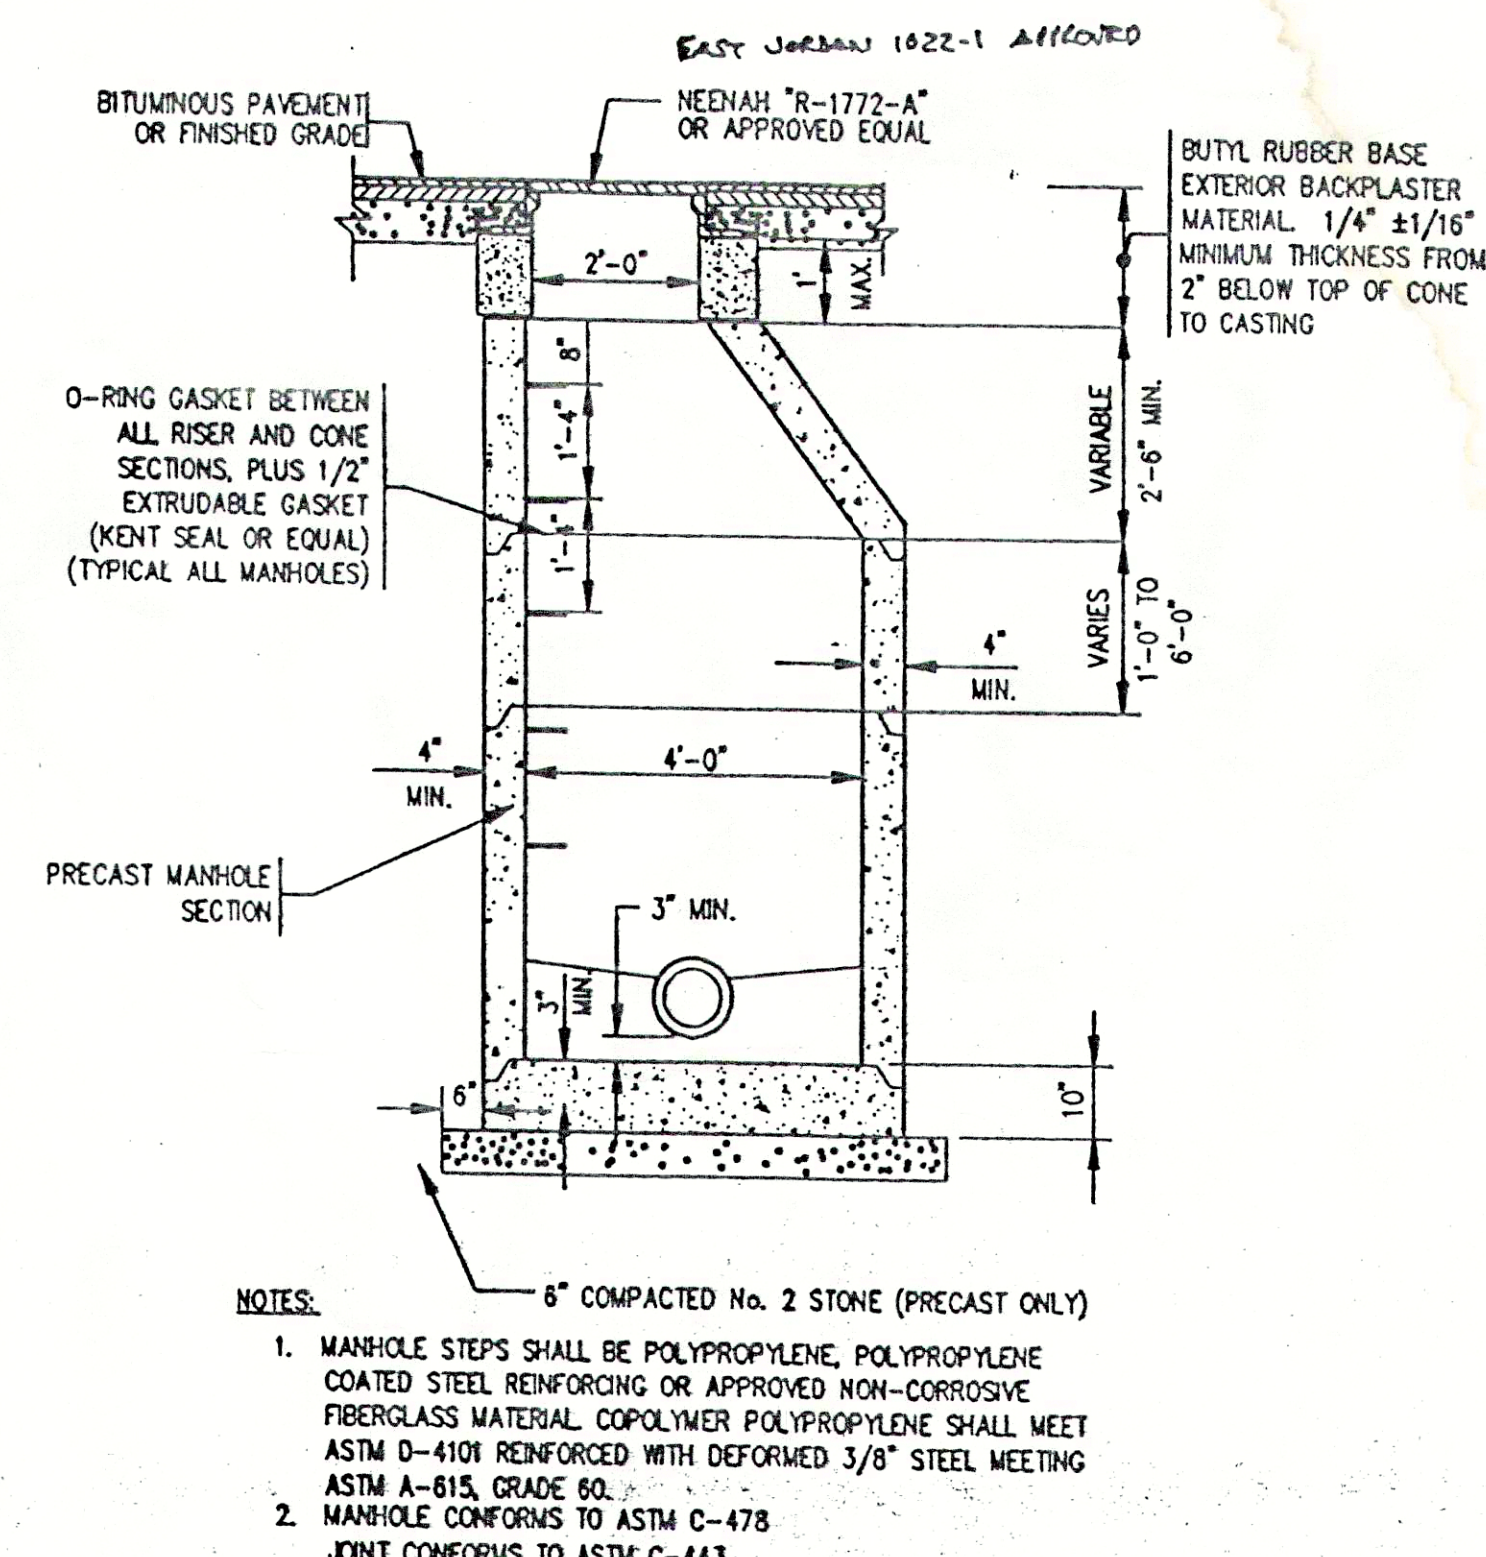

WEIHE ENGINEERS, INC.
ALLAN H. WEIHE, P.E., L.S.
PRESIDENT
MICHAEL L. DUBOY, L.S.
VICE - PRESIDENT
CIVIL ENGINEERS • LAND SURVEYORS • LAND PLANNERS • LANDSCAPE ARCHITECTS

10005 NORTH COLLEGE AVENUE
SUITE 100
INDIANAPOLIS, IN 46240
(317) 844-6611 FAX (317) 844-6611
TOLL-FREE (800) 458-6448

PROJECT NO.: 88-003
DATE: 11/11/88
BY: J. WEIHE
CHECKED BY: J. WEIHE
DATE: 11/11/88
PAGE: 11-11

ALLAN H. WEIHE
REGISTERED
No. 8827
STATE OF INDIANA
PROFESSIONAL ENGINEER
ALLAN H. WEIHE P.E. 8827

PENDLETON PLACE APARTMENTS
SHEHAN CONSTRUCTION CO., INC.
TOWN OF PENDLETON STANDARD DETAILS
Part of the 100% Submittal, 10, 11, 12, 2032,

PLAN KEY	BOTANICAL NAME	COMMON NAME	SIZE	QUANTITY	ROOT CONDITION		ON CENTER SPACING	SPECIAL INSTRUCTIONS
					BASE	CONT		
OGM	ACER RUBRUM "OCTOBER GLORY"	OCTOBER GLORY MAPLE	2" CALIPER	3	X		28' O.C.	
NM	ACER PLATANODES	NORWAY MAPLE	2" CALIPER	13	X		28' O.C.	
BP	PYRUS CALLERYANA "BRADFORD"	BRADFORD PEAR	2" CALIPER	26	X		28' O.C.	
BS	EUONYMUS ALATA "COMPACTA"	BURNING BUSH	18"-24" CALIPER	68	X		3' O.C.	
WY	TAXUS MEDIA "WARD"	WARD'S YEW	12" SPREAD	57		X	3' O.C.	
BAY	MYRTICA PENNSYLVANICA	WAYBERRY	15" SPREAD	19	X		2' O.C.	
MP	PINUS MUGO	MUGO PINE	15" HEIGHT	98		X	4' O.C.	
RJC	MALUS "RED JADE"	RED JADE CRAB	3/4"-1" CALIPER	18	X		2' O.C.	
NS	PICEA ABIES	NORWAY SPRUCE	6'-8' HEIGHT	73	X		4' O.C.	
AP	PINUS NIGRA	AUSTRIAN PINE	6'-8' HEIGHT	21	X		2' O.C.	
QFS	SPIREA BUNALDIA "GOLD FLAME"	GOLD FLAME SPICEA	18" SPREAD	36		X	0' O.C.	
SC	MALUS SARGENTII	SARGENT CRAB	3/4"-1" CALIPER	8	X		2' O.C.	
ROB	BERBERIS THUNBERGII "ROSEY GLOW"	ROSEY GLOW BARBERY	15" SPREAD	30		X	4' O.C.	
RSW	ACER RUBRUM "RED SUNSET"	RED SUNSET MAPLE	2" CALIPER	11	X		2' O.C.	

① LINE OF MULCH EDGE
② NOT USED

1. WORK SHOWN ON THIS SHEET SHALL BE DONE BY A LANDSCAPE CONTRACTOR WHO IS A MEMBER IN GOOD STANDINGS OF THE INDIANA ASSOCIATION OF NURSEYRMENT.
2. THE LANDSCAPE CONTRACTOR SHALL NOTIFY THE LANDSCAPE ARCHITECT IN WRITING BEFORE THE BID DATE OF ANY PLANTS THAT THEY FEEL MAY NOT SURVIVE IN LOCATIONS AS SHOWN ON THE PLAN.
3. REFER TO C1 FOR EROSION CONTROL.
4. ALL LANDSCAPING TO BE PLACED IN PHASE 1 WITH THE EXCEPTION OF BUILDING LANDSCAPING AROUND PHASE 2 BUILDINGS AND PHASE 2 BUMPSTEERS.
5. SOO ENDITE SITE - OPTION 500 BANK OF POND, FRONT AND REAR BUILDING AND SEED THE REMAINING SITE. (TEMPORARY SEED ALL EFFECTED AREAS OF PHASE 2)


PLANTS SHALL MEET OR EXCEED THE STANDARDS AS DESCRIBED IN ANSI Z60.1 (LATEST EDITION) PUBLISHED BY THE AMERICAN ASSOCIATION OF NURSERYMEN.

PLANTS SHALL BEAR A TAG SHOWING GENUS, SPECIES AND VARIETY.

IN CASE OF DISCREPANCIES BETWEEN THE PLAN AND THE PLANT SCHEDULE, THE PLAN SHALL DICTATE.

PLANTS SHALL BE CERTIFIED BY THE STATE OF INDIANA DEPARTMENT OF NATURAL RESOURCES AND FREE FROM DISEASE OR HAZARDOUS INSECTS.

1. IN CASE OF DISCREPANCIES BETWEEN THE PLAN AND THE PLANT SCHEDULE, THE PLAN SHALL DICTATE.
2. WORK SHOWN ON THIS SHEET SHALL BE DONE BY A CONTRACTOR WHO IS A MEMBER IN GOOD STANDING OF THE INDIANA ASSOCIATION OF NURSESMEN.
3. A COMMERCIAL GRADE PRE-EMERGENT HERBICIDE SHALL BE APPLIED TO TREE AND SHRUB BEDS AT RATES RECOMMENDED BY THE MANUFACTURER OF THE MULCHING.
4. NO PLANT MATERIAL SUBSTITUTIONS WILL BE ALLOWED AFTER THE BID DATE. IF PLANTS SPECIFIED ARE UNAVAILABLE, THE BIDDER SHALL NOTIFY THE ENGINEER BEFORE THE BID DATE IN WRITING.
5. PLANTS MAY BE INSPECTED AND TAGGED AT NURSERY OR BEFORE OPERATION BEGINS MOVING TO JOB SITE. PLANTS MAY ALSO BE INSPECTED ON THE JOB SITE. THE ENGINEER/OWNER RESERVES THE RIGHT TO APPROVE OR DISAPPROVE THE PLANTS ONCE THE PLANTS ARE ON THE JOB SITE.
6. PLANTS AND OTHER MATERIALS STORED AT THE JOB SITE WILL BE PLACED WHERE THEY WILL NOT CONFLICT WITH CONSTRUCTION OPERATIONS AND AS DIRECTED BY THE OWNER.
7. THE CONTRACTOR SHALL OBTAIN AND PAY FOR ALL NECESSARY PERMITS AND MAY BE REQUIRED FOR THEIR PORTION OF THE WORK.
8. PLANTS SHALL BE GUARANTEED FOR A PERIOD OF ONE (1) YEAR AFTER INSTALLATION AND FINAL INSPECTION BY THE OWNER. PLANTS THAT DIE OR ARE DAMAGED AT GUARANTEED PERIOD, PLANTS DETERMINED DEAD, UNDESIRABLY SICK OR BEING REPLACED AT NO ADDITIONAL COST TO THE OWNER.
9. THE CONTRACTOR SHALL NOTIFY THE ENGINEER IN WRITING BEFORE THE BID DATE OF ANY PLANTS THAT MAY NOT SURVIVE IN LOCATIONS AS SHOWN ON THE PLAN.

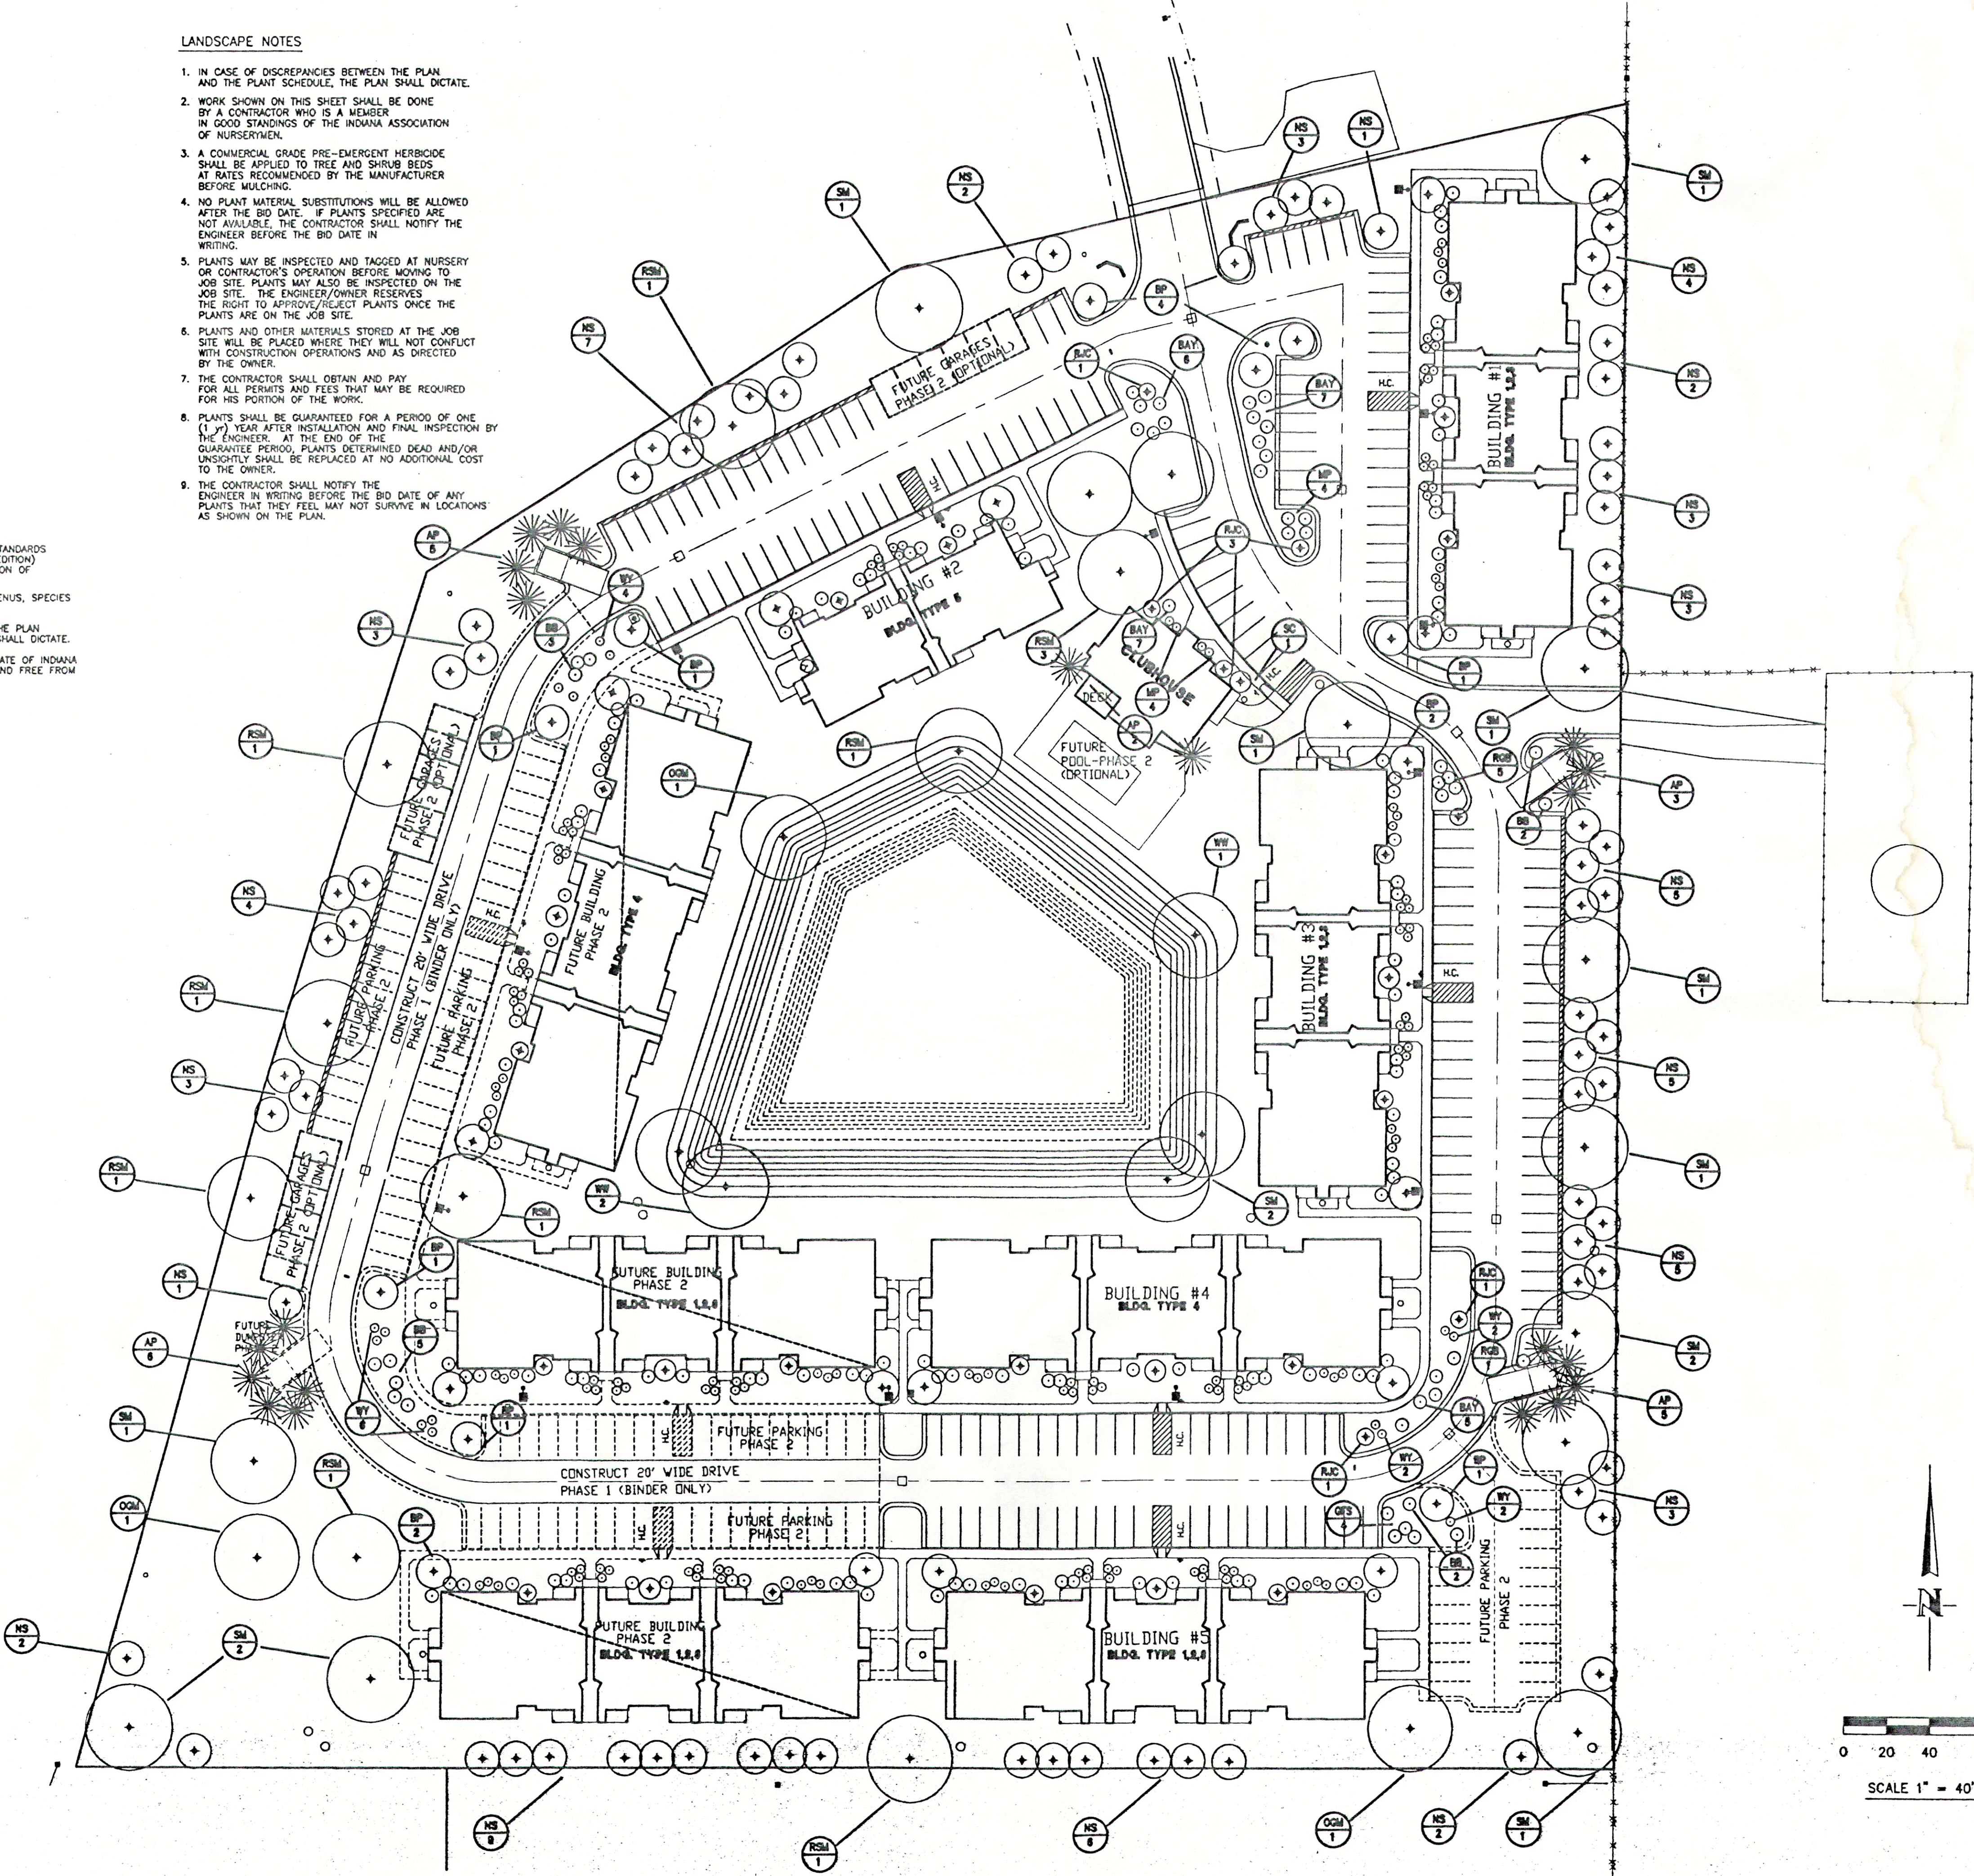

SCALE 1" = 40'

ALLAN H. WEHE, P.E., L.S.
PRESIDENT
MICHAEL L. DeBOY, L.S.
VICE - PRESIDENT
NDSCAPE ARCHITECTS

S • LAND P

A • LAND SURVEYOR

CIVIL ENGINEERS

2 MARCH 98

2	

PAGE 99-11

JD BOOKS 777



VEER

0047

County, Indiana



Credit Supp. Materials

1. Range 7 East, Felt.

NY 143

of the NE/4, Section

21

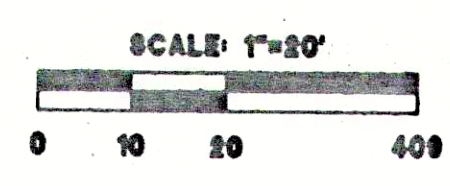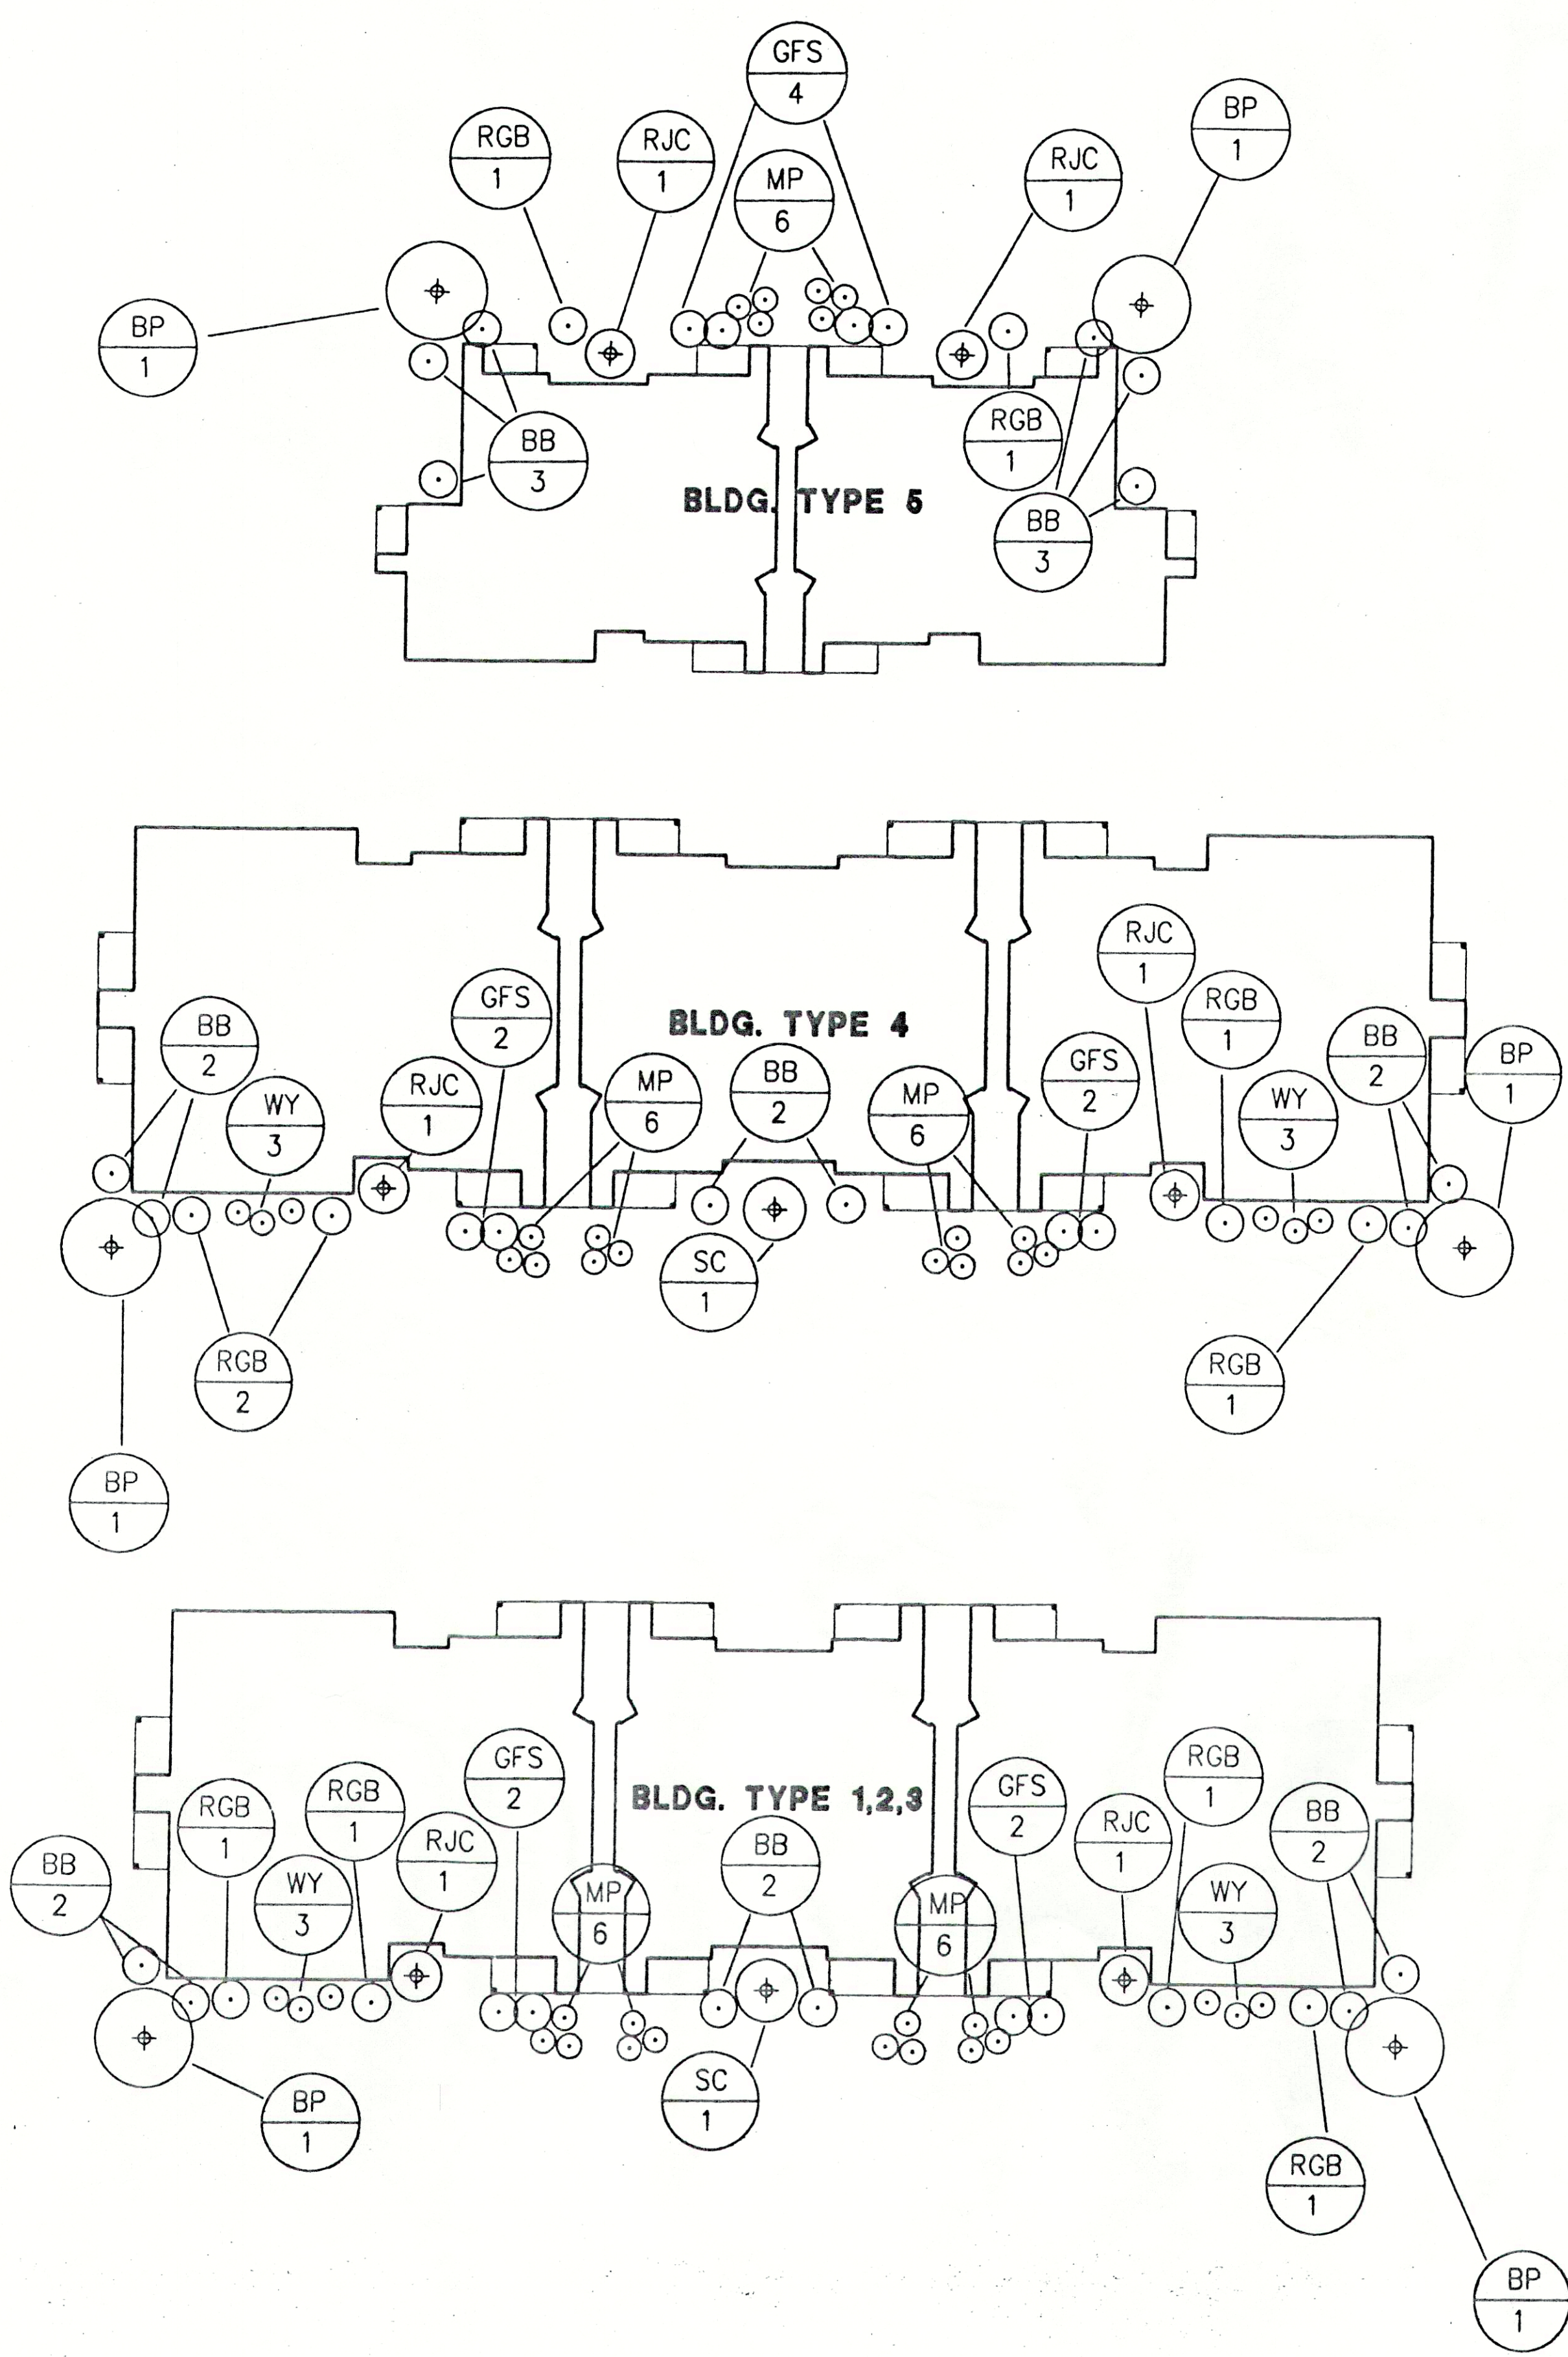

WEIHE ENGINEERS, INC.
 10005 NORTH COLLETT AVENUE
 SUITE 100
 DALLAS, TEXAS 75243
 (214) 343-6011 FAX (214) 343-6046
 TOLL-FREE (800) 452-8408

CIVIL ENGINEERS • LAND SURVEYORS • LAND PLANNERS • LANDSCAPE ARCHITECTS

PENDLETON PLACE APARTMENTS
 SHEEHAN CONSTRUCTION CO., INC.
TYPICAL BUILDING LANDSCAPE PLAN
 Part of the R/C, Section 16, Page 18 North, Range 7 East, Field, Quad Twp., Madison County, Indiana

PROJECT NO.: 90000000000000000000
 DATE: 11-17-77
 DRAWN BY: J. H. WEIHE
 CHECKED BY: J. H. WEIHE
 DATE: 11-17-77

FIELD BOOK: 777
 PAGE: 77-77
 DATE: 11-17-77

ALLAN H. WEIHE
 REGISTERED
 No. 8827
 STATE OF INDIANA
 PROFESSIONAL ENGINEER

PREPARED FOR: SHEEHAN CONSTRUCTION CO., INC.

SHEET NO. **C88**