





29.8
64.9
12.4

RECORD DRAWING
SANITARY, STORM SEWER, WATER LINE
November 14, 1990

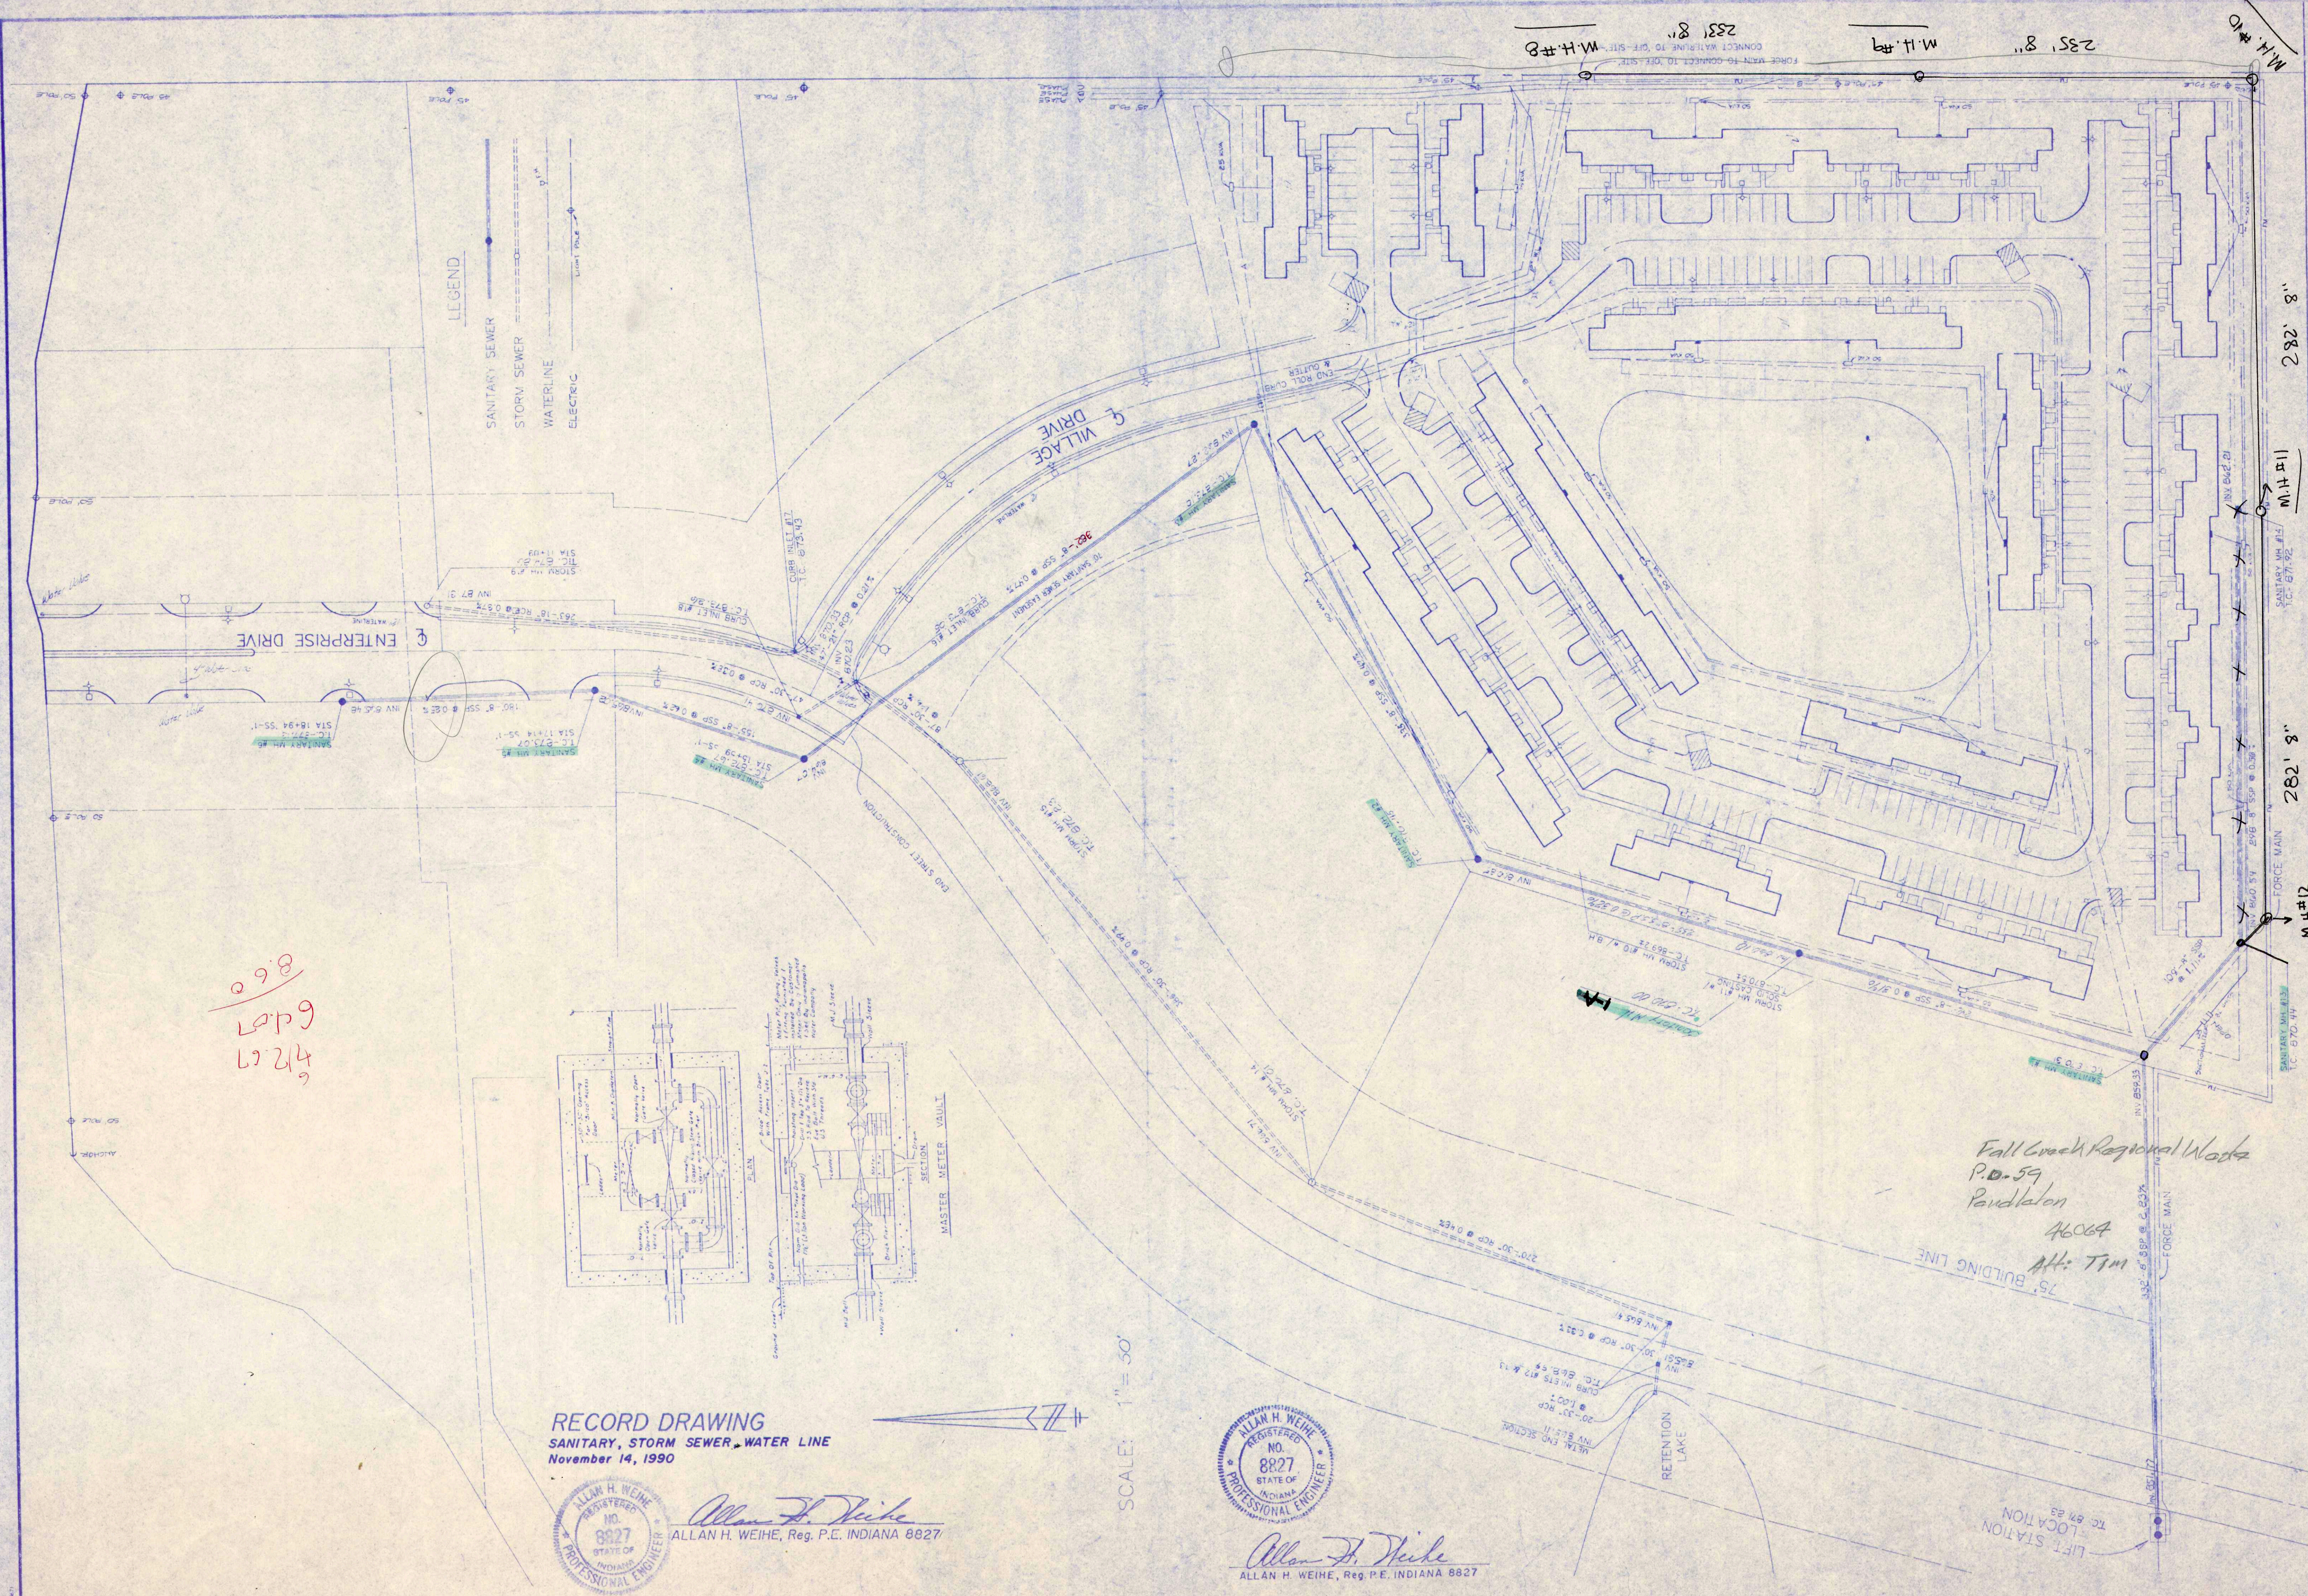

Allan H. Weihe
ALLAN H. WEIHE, Reg. P.E. INDIANA 8827

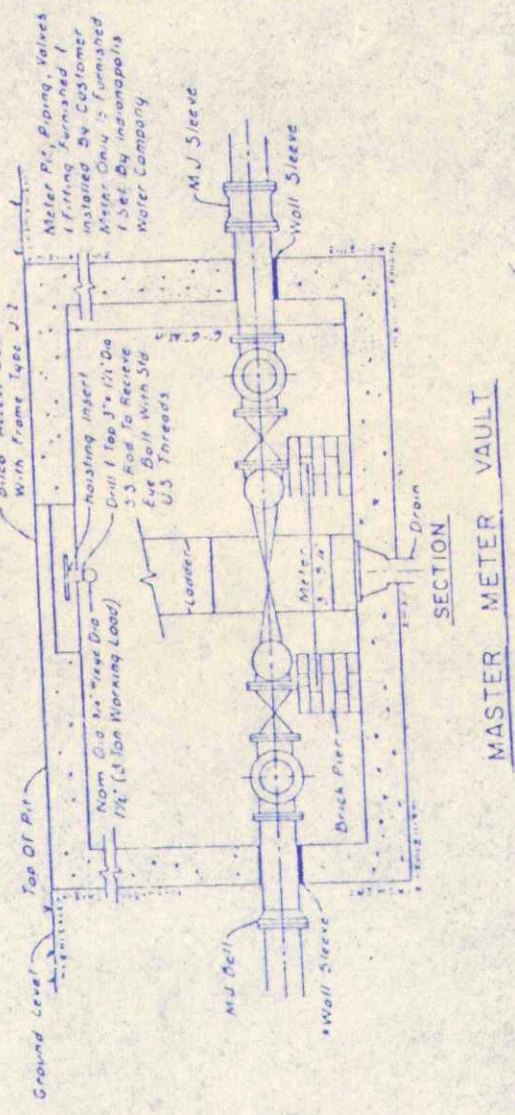

SCALE: 1"=50'



Allan H. Weihe
ALLAN H. WEIHE, Reg. P.E. INDIANA 8827

Fall Creek Regional Works
P.O. 59
Pendleton
46064
A.H. Weihe

LIFT STATION
LOCATION

DATE BY 07-148
DRAWN BY
CHECKED BY
DATE 11-17-90
PAGE 4

REVISIONS
1. 11-17-90
2. 11-17-90
3. 11-17-90

WEIHE ENGINEERS INC.
10505 NORTH COLLEGE AVENUE
INDIANAPOLIS, INDIANA 46280
(317) 846-6611

LAND PLANNERS
CIVIL ENGINEERS
LAND SURVEYORS

PREPARED FOR:
JULIE L. H.

UTILITIES PLAN - PENDLETON VILLAGE APARTMENTS

SHEET NO. 4

Not To Scale