

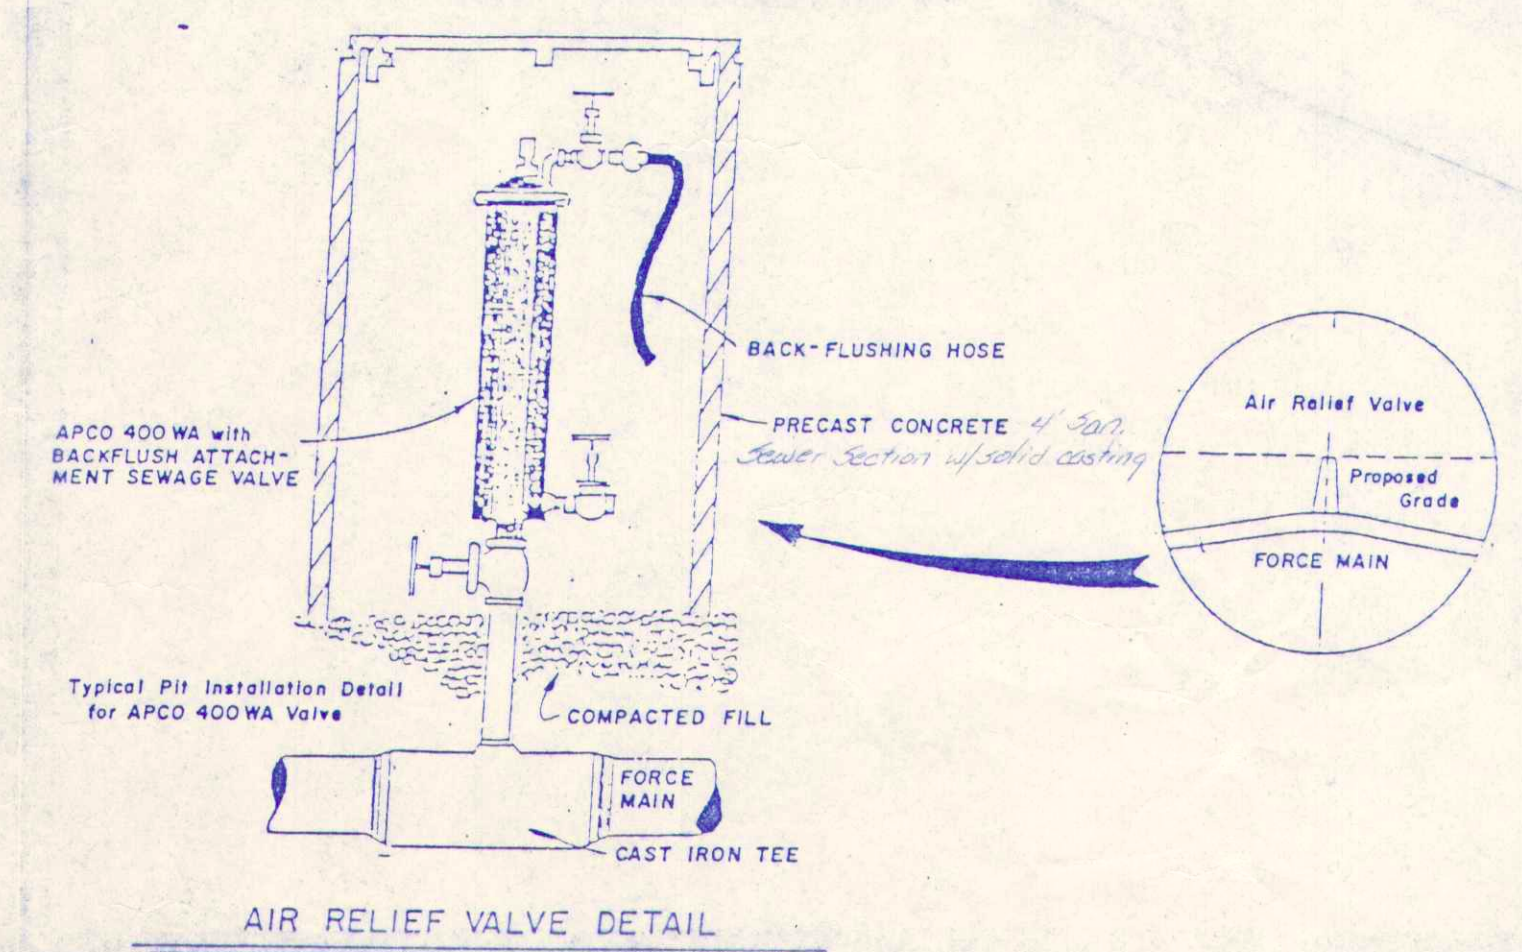


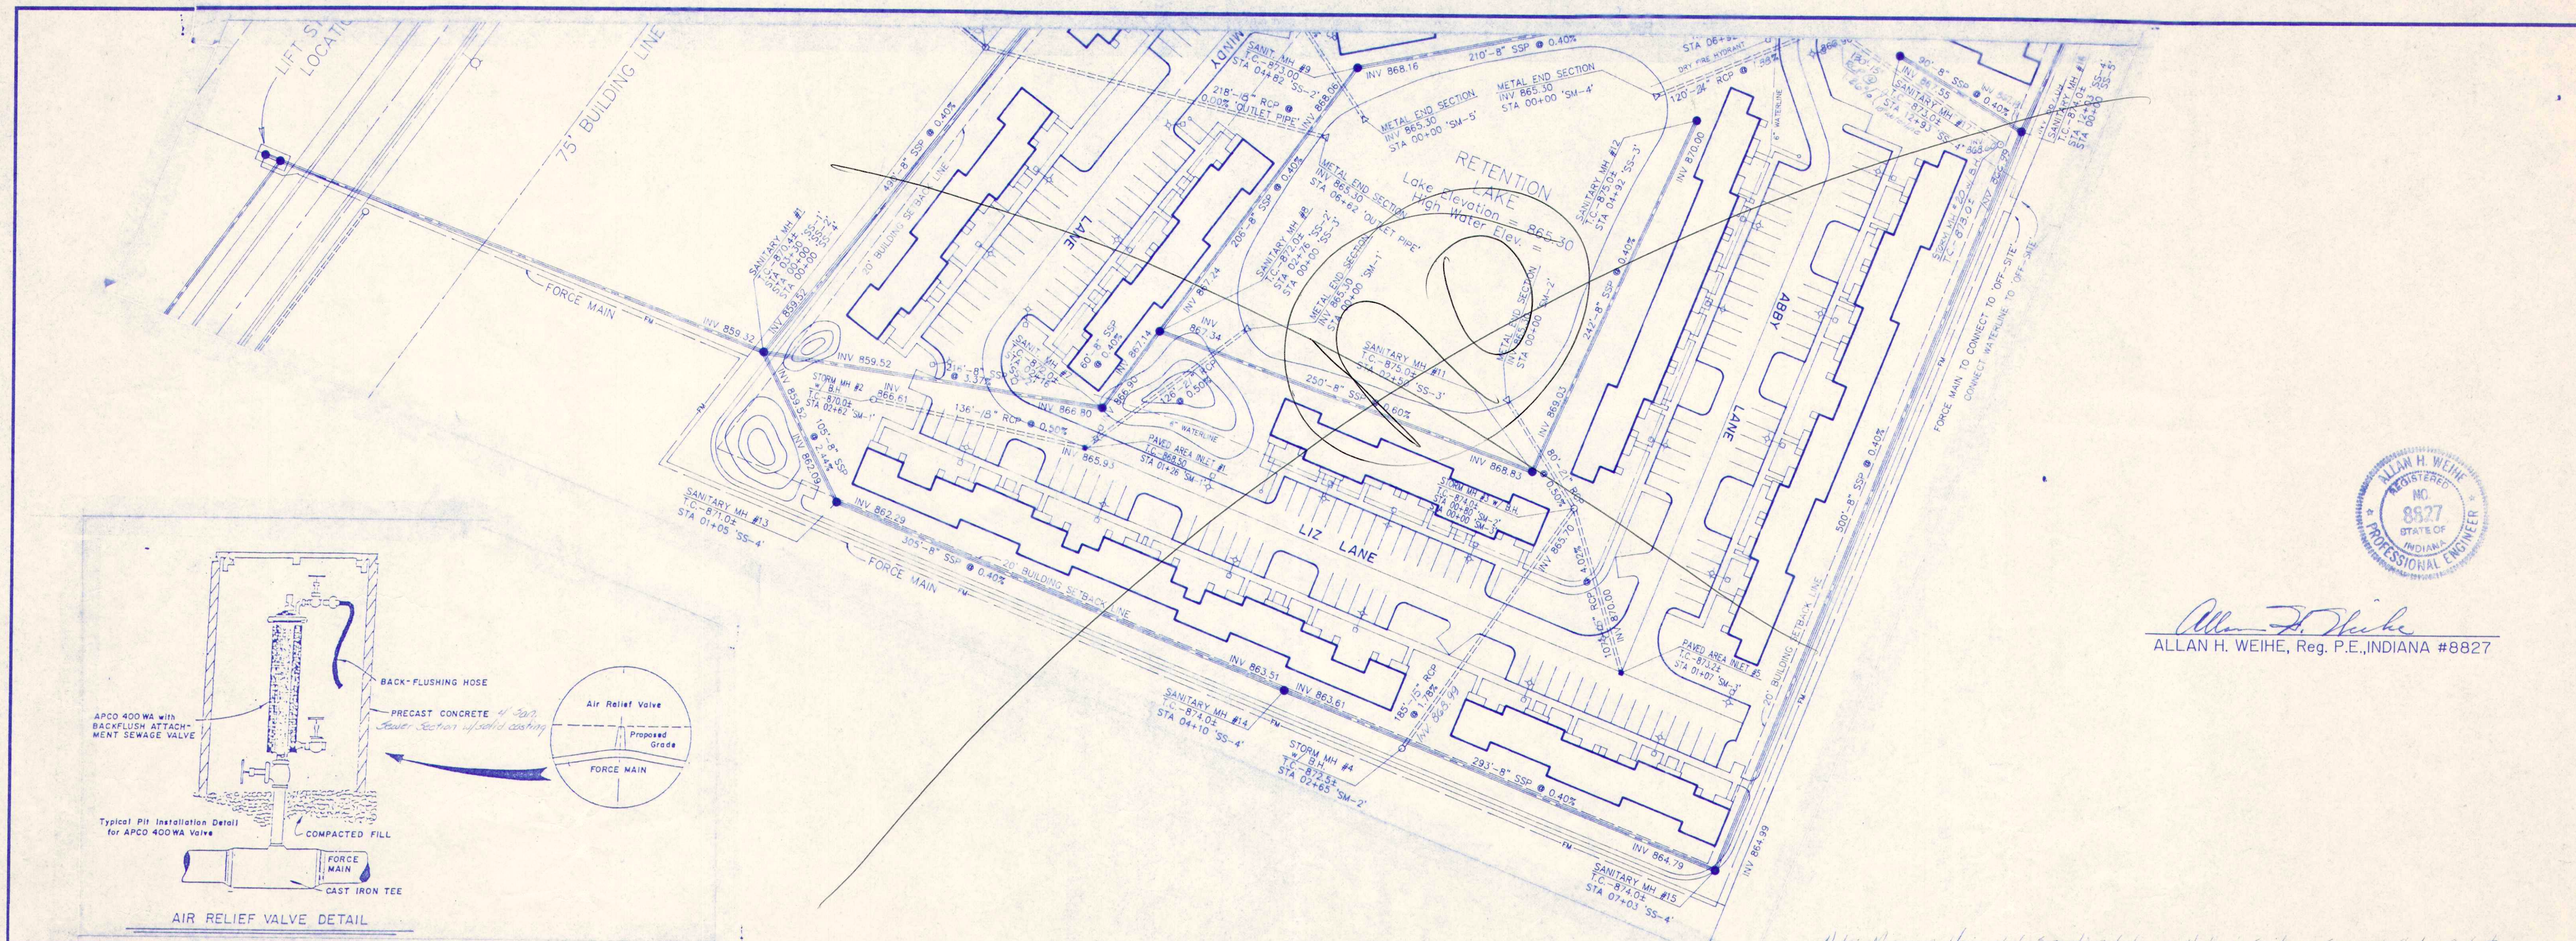

Allan H. Weihe
 ALLAN H. WEIHE, Reg. P.E., INDIANA #8827

Note: Minimum Horizontal Separation between Water & Sanitary Sewer shall be 10 feet

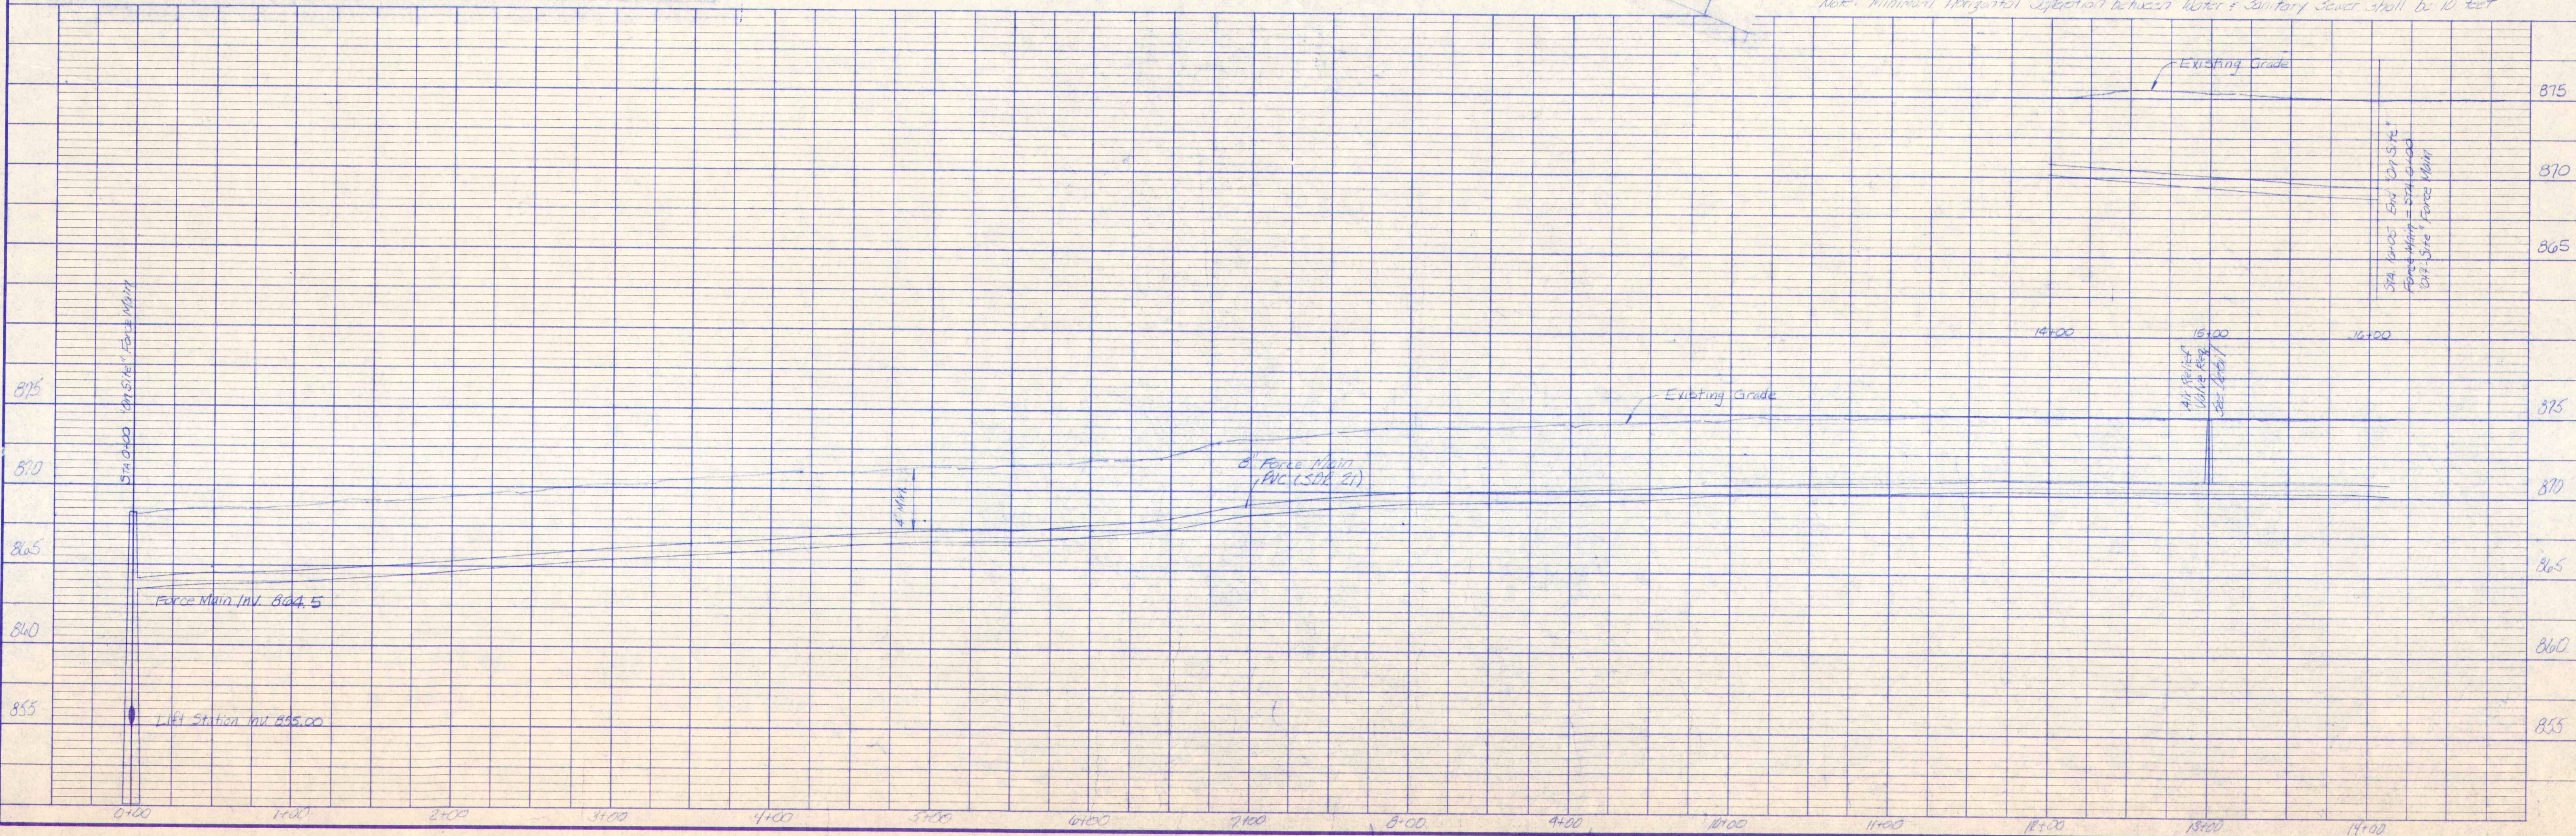

WEIHE ENGINEERS INC.
 10505 NORTH COLLEGE AVENUE
 INDIANAPOLIS, INDIANA 46280
 (317) 846-6611

ALLAN H. WEIHE, P.E., L.S.
 PRESIDENT

JOB NO. 89-143	DRAWN BY D.B.	CHECKED BY D.B.	DATE 1-12-90	PAGE 1	F.B.
-------------------	------------------	--------------------	-----------------	-----------	------

REVISIONS

1. 1-12-90 to 1-12-90
 Change the Force Main layout

Prepared For: Mr. Steve Paul

ON-SITE FORCE MAIN - PENDELTON

SHEET NO.

2

OF 3